♦ BM=851.06

TNH 113+46.60 W75TH ST / LYNDALE AVE

◆ BM=850.50

TNH 119+39.56 W74TH ST/ LYNDALE AVE

+ BM=852.05

146+38.92 W70TH ST/ LYNDALE AVE

♦ BM=851.22

TNH 172.02+65 W66TH ST / LYNDALE AVE

NOTE: EXISTING UTILITY INFORMATION SHOWN ON THIS PLAN HAS BEEN PROVIDED BY THE UTILITY OWNER. THE CONTRACTOR SHALL FIELD VERIFY EXACT LOCATIONS PRIOR TO COMMENCING CONSTRUCTION AS REQUIRED BY STATE LAW. NOTIFY GOPHER STATE ONE CALL, 1-800-252-1166 OR 651-454-0002.

THE SUBSURFACE UTILITY INFORMATION IN THIS PLAN IS UTILITY QUALITY LEVEL D. THIS UTILITY QUALITY LEVEL WAS DETERMINED ACCORDING TO THE GUIDELINES OF CI/ASCE 38-02, ENTITLED "STANDARD GUIDELINES FOR THE COLLECTION AND DEPICTION OF EXISTING SUBSURFACE UTILITY DATA."

S.A.P. 157-363-032

FROM 76TH STREET TO 66TH STREET

LYNDALE AVENUE DESIGN DESIGNATION

DESIGN DESIGNATION - TRAIL

Design Speed:	20 MPH		
Based On:	Stopping Sight Dista	ance	
Height Of Eye	4.5'	Height Of Object	0.0'
Design Speed N	lot Achieved At		
STA	TO STA	MPH	
STA	TO STA	MPH	
STA	TO STA	MPH	


CITY OF RICHFIELD

CONSTRUCTION PLANS FOR

LYNDALE AVENUE RECONSTRUCTION

CONSTRUCTION PLAN FOR: GRADING, AGGREGATE BASE, PLANT-MIXED BITUMINOUS SURFACE, CONCRETE CURB & GUTTER, RETAINING WALL, SANITARY SEWER, WATERMAIN, STORM SEWER, TRAFFIC SIGNALS, AND TURF RESTORATION

FEBRUARY, 2019

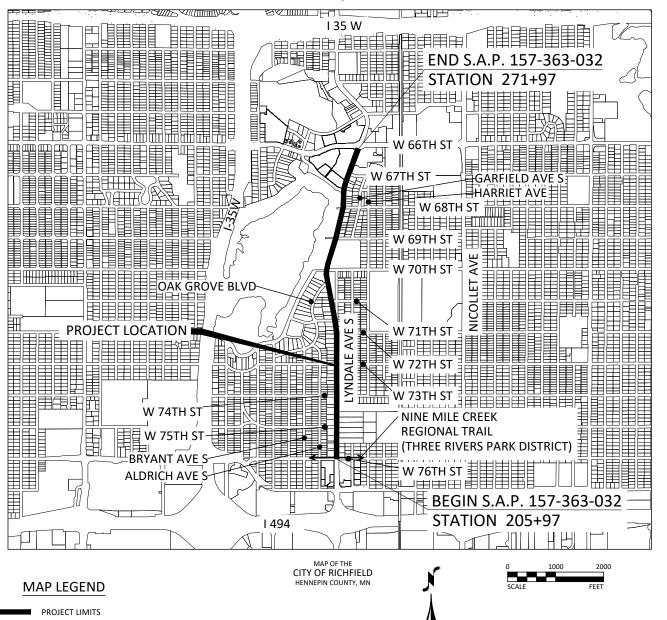

SHEET NUMBER	SHEET TITLE
GENERAL	
G0.01 - G0.03	TITLE SHEET, LEGEND, GENERAL NOTES
G1.01 - G1.04	STATEMENT OF ESTIMATED QUANTITIES
G2.01	GENERAL LAYOUT
CIVIL	
C0.01 - C0.06	EXISTING CONDITIONS, REMOVALS PLAN
C1.01 - C1.33	TYPICAL SECTIONS, TABLES, DETAILS, PHASING PLAN
C2.01 - C2.08	EROSION CONTROL PLAN, SWPPP
C4.01 - G4.09	SANITARY SEWER & WATER PLAN & PROFILE
C5.01 - C5.10	STORM SEWER PLAN & PROFILE
C6.01 - C6.29	STREET PLAN & PROFILE, INTERSECTION DETAILS
C7.01 - C7.61	SIGNING & STRIPING, SIGNALS, LIGHTING
C8.01 - C8.20	STANDARD DETAIL PLATES, STANDARD PLANS
C9.01 - C9.07	RETAINING WALLS
C9.08 - C9.27	CROSS SECTIONS
LANDSCAPE	
L1.01 - L2.07	LANDSCAPING PLAN
	THIS PLAN SET CONTAINS 232 SHEETS.

I HEREBY CERTIFY THAT THIS PLAN WAS PREPARED BY ME OR UNDER MY DIRECT SUPERVISION AND THAT I AM A DULY LICENSED PROFESSIONAL ENGINEER UNDER THE LAWS OF THE STATE OF MINNESOTA.

ENGR. Lim Lamb DATE 02/19/201
TIM LAMKIN JR LIC. NO. 47099

APPROVED ______DA

TITLE SHEET

APPROVED _____DATE______DATE______

DISTRICT STATE AID ENGINEER
REVIEWED FOR COMPLIANCE WITH STATE AID RULES

OBSERVER:



12224 NICOLLET AVENUE BURNSVILLE, MINNESOTA 55337 Phone: (952) 890-0509 Email: Burnsville@bolton-menk.com www.bolton-menk.com





SURVEY SYMBOLS **EXISTING TOPOGRAPHIC SYMBOLS** SIGN TRAFFIC ACCESS GRATE BENCH MARK LOCATION AIR CONDITION UNIT SIG SIGNAL CONTROL CABINET AC CONTROL POINT SOIL BORING MONUMENT IRON FOUND AUTO SPRINKLER CONNECTION SIREN ፟ CAST IRON MONUMENT BARRICADE PERMANENT B TELEPHONE BOOTH **EXISTING TOPOGRAPHIC LINES** 0 BASKETBALL POST TILE INLET -BENCH TILE OUTLET RETAINING WALL -B-FENCE BIRD FEEDER TILE RISER ___ x ___ FENCE-DECORATIVE (2) **BUSH-DECIDUOUS** TRAN TRANSFORMER-ELECTRIC **GUARD RAIL** CATCH BASIN RECTANGULAR CASTING TREE-CONIFEROUS TREE LINE **BUSH LINE** \bigcirc * CATCH BASIN CIRCULAR CASTING TREE-DEAD CURB STOP \odot TREE-DECIDUOUS **SURVEY LINES** (CO) CLEAN OUT TREE STUMP 9 CONTROLLED ACCESS CLVT CULVERT END TRAFFIC ARM BARRIER BOUNDARY DRINKING FOUNTAIN TRAFFIC SIGNAL CENTERLINE DOWN SPOUT TRASH CAN TRASH EXISTING EASEMENT LINE FILL PIPE U UTILITY MARKER PROPOSED EASEMENT LINE **EXISTING LOT LINE** FIRE HYDRANT \bowtie PROPOSED LOT LINE PIV FLAG POLE VALVE POST INDICATOR **EXISTING RIGHT-OF-WAY** FLARED END / APRON \bowtie VALVE VAULT PROPOSED RIGHT-OF-WAY SETBACK LINE \bigcirc FUEL PUMP VENT PIPE SECTION LINE GRILL WATER SPIGOT **EXISTING UTILITY LINES** GUY WIRE ANCHOR WELL H WETLAND DELINEATED MARKER HANDHOLE FORCEMAIN HANDICAP SPACE WETLAND SANITARY SEWER IRRIGATION SPRINKLER HEAD # YARD LIGHT SANITARY SERVICE IVB IRRIGATION VALVE BOX WW WET WELL STORM SEWER DRAIN TILE LIFT STATION CONTROL PANEL YARD HYDRANT _ | _ _ | _ _ | _ _ | _ _ | _ _ | _ _ | _ _ | WATERMAIN LS LIFT STATION WATER SERVICE MAILBOX PROPOSED TOPOGRAPHIC SYMBOLS PROPOSED UTILITY LINES MANHOLE-COMMUNICATION (C) E MANHOLE-ELECTRIC CLEANOUT FORCEMAIN **G** MANHOLE-GAS MANHOLE SANITARY SEWER SANITARY SERVICE \oplus MANHOLE-HEAT LIFT STATION STORM SEWER S MANHOLE-SANITARY SEWER STORM SEWER CIRCULAR CASTING 0 STORM SEWER DRAIN TILE MANHOLE-STORM SEWER D WATERMAIN STORM SEWER RECTANGULAR CASTING (U) WATER SERVICE MANHOLE-UTILITY STORM SEWER FLARED END / APRON \ PIPE CASING \bigcirc MANHOLE-WATER STORM SEWER OUTLET STRUCTURE M METER 0 STORM SEWER OVERFLOW STRUCTURE GRADING INFORMATION ORDER MICROPHONE **CURB BOX** PARKING METER FIRE HYDRANT ___952----**EXISTING CONTOUR MINOR** - 950 — PAVEMENT MARKING WATER VALVE **EXISTING CONTOUR MAJOR** -952—— C PEDESTAL-COMMUNICATION PROPOSED CONTOUR MINOR WATER REDUCER PROPOSED CONTOUR MAJOR Е PEDESTAL-ELECTRIC WATER BEND PROPOSED GRADING LIMITS / SLOPE LIMITS PEDESTRIAN PUSH BUTTON 円 × 953.53 × STA:5+67.19 WATER TEE PROPOSED SPOT ELEVATION RISE:RUN (SLOPE) 1.4 PICNIC TABLE \oplus WATER CROSS * POLE-LIGHT WATER SLEEVE HATCH PATTERNS POLE-UTILITY WATER CAP / PLUG POST RITUMINOUS RIP RAP * RAILROAD SIGNAL POLE DRAINAGE FLOW CONCRETE REGULATION STATION GAS SATELLITE DISH BURNSVILLE, MINNESOTA 55337

EXISTING PRIVATE UTILITY LINES

EXISTING UTILITY INFORMATION SHOWN ON THIS PLAN HAS BEEN PROVIDED BY THE UTILITY OWNER. THE CONTRACTOR SHALL FIELD VERIFY EXACT LOCATIONS PRIOR TO COMMENCING CONSTRUCTION AS REQUIRED BY STATE LAW. NOTIFY GOPHER STATE ONE CALL, 1-800-252-1166 OR

THE SUBSURFACE UTILITY INFORMATION IN THIS PLAN IS UTILITY QUALITY LEVEL D UNLESS OTHERWISE NOTED. THIS UTILITY LEVEL WAS DETERMINED ACCORDING TO THE GUIDELINES OF CI/ASCE 38-02, ENTITLED "STANDARD GUIDELINES FOR THE COLLECTION AND DEPICTION OF

— F —	— F ——— F	— F —	UNDERGROUND FIBER OPTIC
— Е —	— Е ——— Е	— Е —	UNDERGROUND ELECTRIC
—— G ——	— G ——— G	G	UNDERGROUND GAS
c	— c —— c	c	UNDERGROUND COMMUNICATION
——— OE —	—— OE —	— OE ——	OVERHEAD ELECTRIC
—— ос –	— ос —	— ос ——	OVERHEAD COMMUNICATION
ou -	—— ou —	ou	OVERHEAD UTILITY

UTILITIES IDENTIFIED WITH A QUALITY LEVEL OTHER THAN D

LINE TYPES FOLLOW THE FORMAT: UTILITY TYPE - QUALITY LEVEL UNDERGROUND GAS, QUALITY LEVEL A UTILITY QUALITY LEVEL (A,B,C,D) DEFINITIONS CAN BE FOUND IN CI/ASCE 38-02.

UTILITY QUALITY LEVELS:

LEVEL D - INFORMATION COMES SOLELY FROM EXISTING UTILITY RECORDS.

LEVEL C - SURVEYING ABOVE GROUND UTILITY FACILITIES, SUCH AS MANHOLES, VALVE BOXES, ETC; AND CORRELATING THIS INFORMATION WITH

LEVEL B - THE USE OF SURFACE GEOPHYSICAL TECHNIQUES TO DETERMINE THE EXISTENCE AND HORIZONTAL POSITION OF UNDERGROUND

LEVEL A - THE USE OF NONDESTRUCTIVE DIGGING EQUIPMENT AT HORIZONTAL AND VERTICAL POSITION OF UNDERGROUND UTILITIES, AS WELL AS THE TYPE, SIZE, CONDITION, MATERIAL, AND OTHER CHARACTERISTICS.

ABBREVIATIONS

Α	ALGEBRAIC DIFFERENCE	GRAV	GRAVEL	SAN	SANITARY SEWER
ADJ	ADJUST	GU	GUTTER	SCH	SCHEDULE
ALT	ALTERNATE	GV	GATE VALVE	SERV	SERVICE
B-B	BACK TO BACK	HDPE	HIGH DENSITY POLYETHYLENE	SHLD	SHOULDER
BIT	BITUMINOUS	HH	HANDHOLE	STA	STATION
BLDG	BUILDING	HP	HIGH POINT	STD	STANDARD
BMP	BEST MANAGEMENT PRACTICE	HWL	HIGH WATER LEVEL	STM	STORM SEWER
BR	BEGIN RADIUS	HYD	HYDRANT	TC	TOP OF CURB
BV	BUTTERFLY VALVE	1	INVERT	TCE	TEMPORARY CONSTRUCTION EASE
СВ	CATCH BASIN	K	CURVE COEFFICIENT	TEMP	TEMPORARY
C&G	CURB AND GUTTER	L	LENGTH	TNH	TOP NUT HYDRANT
CIP	CAST IRON PIPE	LO	LOWEST OPENING	TYP	TYPICAL
CIPP	CURED-IN-PLACE PIPE	LP	LOW POINT	VCP	VITRIFIED CLAY PIPE
CL	CENTER LINE	LT	LEFT	VERT	VERTICAL
CL.	CLASS	MH	MANHOLE	VPC	VERTICAL POINT OF CURVE
CMP	CORRUGATED METAL PIPE	MIN	MINIMUM	VPI	VERTICAL POINT OF INTERSECTION
C.O.	CHANGE ORDER	MR	MID RADIUS	VPT	VERTICAL POINT OF TANGENT
COMM	COMMUNICATION	NIC	NOT IN CONTRACT	WM	WATERMAIN
CON	CONCRETE	NMC	NON-METALLIC CONDUIT		
CSP	CORRUGATED STEEL PIPE	NTS	NOT TO SCALE		
CULV	CULVERT	NWL	NORMAL WATER LEVEL	AC	ACRES
DIA	DIAMETER	OHW	ORDINARY HIGH WATER LEVEL	CF	CUBIC FEET
DIP	DUCTILE IRON PIPE	PC	POINT OF CURVE	CV	COMPACTED VOLUME
DWY	DRIVEWAY	PCC	POINT OF COMPOUND CURVE	CY	CUBIC YARD
Е	EXTERNAL CURVE DISTANCE	PED	PEDESTRIAN, PEDESTAL	EA	EACH
EASE	EASEMENT	PERF	PERFORATED PIPE	EV	EXCAVATED VOLUME
ELEC	ELECTRIC	PERM	PERMANENT	LB	POUND
ELEV	ELEVATION	PI	POINT OF INTERSECTION	LF	LINEAR FEET
EOF	EMERGENCY OVERFLOW	PL	PROPERTY LINE	LS	LUMP SUM
ER	END RADIUS	PRC	POINT OF REVERSE CURVE	LV	LOOSE VOLUME
EX	EXISTING	PT	POINT OF TANGENT	SF	SQUARE FEET
FES	FLARED END SECTION	PVC	POLYVINYL CHLORIDE PIPE	SV	STOCKPILE VOLUME
F-F	FACE TO FACE	PVMT	PAVEMENT	SY	SQUARE YARD
FF	FINISHED FLOOR	R	RADIUS		
F&I	FURNISH AND INSTALL	RCP	REINFORCED CONCRETE PIPE		
FM	FORCEMAIN	RET	RETAINING		
FO	FIBER OPTIC	ROW	RIGHT-OF-WAY		
F.O.	FIELD ORDER	RSC	RIGID STEEL CONDUIT		
GRAN	GRANULAR	RT	RIGHT		





Phone: (952) 890-0509 www.bolton-menk.com



DESIGNED	NO.	REVISION	DATE	CITY OF DICUFFE D. MAINING OTA
ZP/TL/SL				CITY OF RICHFIELD, MINNESOTA
DRAWN				,
ZP/JW				S.A.P. 157-363-032, LYNDALE AVENUE RECONSTRUCTION
CHECKED	⊣			
TL/SL	ш			
CLIENT PROJ. NO.	1 1			LEGEND
T16114541				LEGEND

SHEET

-G0.02

GENERAL STAGING NOTES

- PROPOSED STAGING SHOWN IN THE PLANS IS INTENDED AS CONSTRAINTS WITHIN WHICH THE CONTRACTOR SHALL SCHEDULE AND COMPLETE WORK. THE CONTRACTOR MAY IMPLEMENT ADDITIONAL INTERIM STAGES. SUCH INTERIM STAGES SHALL BE DETERMINED AND IMPLEMENTED BY THE CONTRACTOR BASED ON THE CONTRACTOR'S RESOURCES, SCHEDULE, SPECIFIED WORK, AND INTERIM CONTRACT DEADLINES.
- THE CONTRACTOR SHALL BE RESPONSIBLE FOR THE PROGRESSION OF WORK AND SHALL SUBMIT A DETAILED SCHEDULE TO THE ENGINEER FOR REVIEW AND APPROVAL PRIOR TO COMMENCING WORK

GENERAL TRAFFIC CONTROL NOTES

- ACCESS TO PROPERTIES SHALL BE MAINTAINED AT ALL TIMES THROUGHOUT CONSTRUCTION. THE CONTRACTOR SHALL ALSO SUPPLY ACCESS TO AND FROM THE SITE FOR PRIVATE UTILITY IMPROVEMENTS/RELOCATIONS, AND AS OTHERWISE PROVIDED FOR IN THE SPECIAL PROVISIONS.
- THE CONTRACTOR SHALL MAINTAIN GARBAGE AND RECYCLING SERVICE AT ALL TIMES. THE CONTRACTOR SHALL BE RESPONSIBLE FOR PROVIDING ACCESS FOR GARBAGE TRUCKS. WHEN INFEASIBLE TO MAINTAIN SUCH ACCESS, THE CONTRACTOR SHALL COLLECT CONTAINERS, RELOCATE THEM TO A LOCATION WHERE SUITABLE ACCESS CAN BE PROVIDED, AND RETURN CONTAINERS IN GOOD WORKING CONDITION TO THE SAME PROPERTY FROM WHICH THEY WERE TAKEN. ALL CONTAINERS MUST BE LABELED WITH THE HOUSE ADDRESS PRIOR TO MOVING. COSTS FOR PROVIDING ACCESS OR HAULING CONTAINERS TO AN ACCESSIBLE LOCATION SHALL BE INCIDENTAL TO THE CONTRACT.
- THE 2018 EDITION OF THE MINNESOTA DEPARTMENT OF TRANSPORTATION "STANDARD SPECIFICATIONS FOR CONSTRUCTION" SHALL GOVERN. ALL TRAFFIC CONTROL DEVICES SHALL CONFORM AND BE INSTALLED IN ACCORDANCE WITH THE LATEST EDITION OF THE MINNESOTA MANUAL ON UNIFORM TRAFFIC CONTROL DEVICES (MN MUTCD) AND INCLUDING THE LATEST FIELD MANUAL FOR TEMPORARY TRAFFIC CONTROL ZONE LAYOUTS. TRAFFIC CONTROL NOT IN COMPLIANCE WITH MN MUTCD WILL BE SUBJECT TO VIOLATION IN ACCORDANCE WITH THE SPECIAL PROVISIONS.
- THE ITEM "TRAFFIC CONTROL" BID AS "LUMP SUM" SHALL INCLUDE ALL COSTS FOR PROVIDING TEMPORARY CONTROLS SPECIFIED IN THE PLAN AND OTHER TRAFFIC CONTROL REQUIRED PER THE MN MUTCD DUE TO THE CONTRACTORS OPERATIONS FOR COMPLETION OF THE PROJECT INCLUDING BUT NOT LIMITED TO, RECLAIMING & PAVING UNDER TRAFFIC, TEMPORARY ROAD CLOSURES IN FULL OR TO THRU TRAFFIC, TEMPORARY LANE CLOSURES, ADJUSTMENTS TO THE TRAFFIC CONTROL PLAN FOR LARGE AND SMALL SCALE STAGING OPERATIONS, AND NECESSARY DETOURS FOR MOTORISTS, BICYCLISTS, AND/OR PEDESTRIANS.THE AMOUNT BID SHALL ALSO INCLUDE SUFFICIENT TRAFFIC CONTROL FOR WARNING OF POTENTIAL HAZARDS DURING CONSTRUCTION INCLUDING BUT NOT LIMITED TO FLASHING BARRICADES AROUND EQUIPMENT AND OBSTRUCTIONS.

REMOVAL NOTES

- PRIOR TO REMOVALS REQUIRED FROSION CONTROL DEVICES ARE TO BE INSTALLED.
- SOIL BORINGS INDICATE BITUMINOUS ROADWAY OVER CONCRETE ROADWAY IN A NUMBER OF BORINGS. CONTRACTOR SHALL INCLUDE FOR COST FOR FULL-DEPTH REMOVAL OF PAVEMENT (BITUMINOUS & CONCRETE) IN LINIT PRICE BID FOR REMOVE PAVEMENT
- COORDINATE WITH UTILITY OWNER TO RELOCATE POWER AND LIGHT POLES, AND OTHER PRIVATE UTILITIES AS NECESSARY.
- ALL ADJACENT BITUMINOUS AND CONCRETE SURFACES SHALL BE CLEANLY SAWCUT PRIOR TO REMOVAL. REMOVALS SHALL BE LIMITED TO AREAS WITHIN THE DEFINED PROJECT LIMITS. RESTORATION OF AREAS
- OUTSIDE OF PROJECT LIMITS SHALL BE COMPLETED AT THE CONTRACTOR'S COST UNLESS OTHERWISE APPROVED
- WATER AND SANITARY SERVICE REMOVALS ARE NOT SHOWN. SERVICES WILL BE REMOVED AND REPLACED TO THE RIGHT OF WAY LINESS DIRECTED BY ENGINEER. CONTRACTOR IS RESPONSIBLE TO LOCATE THE EXISTING SEWER AND WATER SERVICES. SERVICE PIPE REMOVAL SHALL BE CONSIDERED INCIDENTAL TO CONSTRUCTION OF NEW SERVICE.
- CONTRACTOR SHALL FOLLOW ALL LOCAL, STATE, AND FEDERAL REGULATIONS IN DISPOSING OF MATERIALS REMOVED FROM THIS SITE.
- DRIVEWAY REMOVAL LIMITS SHOWN ON THE PLAN ARE APPROXIMATE. REMOVAL LIMITS SHALL BE DETERMINED IN THE FIELD BY THE ENGINEER.
- ANY TREES, SHRUBS, AND PLANTINGS TO BE REMOVED SHALL BE DESIGNATED IN ADVANCE BY THE
- CONTRACTOR SHALL PROTECT ALL ITEMS DESIGNATED FOR SALVAGE AND PROVIDE APPROPRIATE STORAGE UNTIL RE-INSTALLATION. ANY ITEMS DESIGNATED TO BE SALVAGED WHICH ARE DAMAGED SHALL BE REPLACED WITH NEW AT NO COST TO THE OWNER, REPAIR OF DAMAGED ITEMS SHALL NOT BE ALLOWED UNLESS APPROVED BY THE ENGINEER.
- 11. ANY LANDSCAPING MATERIALS WITHIN R.O.W. TO BE REMOVED SHALL BE DESIGNATED IN ADVANCE BY THE ENGINEER AND REMOVAL SHALL BE CONSIDERED INCIDENTAL.
- 12 ALL ITEMS NOT IDENTIFIED FOR REMOVAL SHALL BE PROTECTED DURING CONSTRUCTION
- 13. SEE PROJECT MANUAL FOR CONTRACTOR'S REQUIREMENTS TO PROVIDE TEMPORARY WATER SERVICE WITH AFFECTED USERS
- 14. TREES/SHRUBS/LANDSCAPING TO BE RELOCATED.
- SANITARY SEWER PIPE SHALL BE REMOVED FOLLOWING INSTALLATION OF NEW MAIN AND CONNECTION OF SERVICE LATERAL TO NEW MAIN. CONSTRUCTION WILL NEED TO BE STAGED SUCH THAT SERVICE TO ALL PROPERTIES REMAIN THROUGHOUT.

UTILITY CONSTRUCTION NOTES

- WATER AND SANITARY SERVICE LOCATIONS SHOWN ARE APPROXIMATE AND NOT ALL SERVICES MAY BE SHOWN. NEW SERVICES SHALL MATCH EXISTING SERVICE SIZE BUT MINIMUM SERVICE SIZE SHALL BE 1-INCH FOR WATER 2.
- AND 6-INCH FOR SANITARY. PROVIDE FITTINGS AND COUPLERS AS REQUIRED TO CONNECT TO EXISTING SERVICES.
- PLACE NEW CURB STOP AND BOX ON R.O.W. LINE OR AS DIRECTED BY ENGINEER
- ROUTING OF NEW SERVICE LINES AROUND TREES AND DRIVEWAYS AS DIRECTED BY ENGINEER SHALL BE CONSIDERED INCIDENTAL.
- SANITARY SEWER MAIN PIPE SHALL BE SDR-35 UNLESS OTHERWISE NOTED. SANITARY SEWER SERVICE PIPE SHALL BE SDR-26 AND WATER SERVICES SHALL BE COPPER TYPE "K".
- SANITARY SEWER SERVICE SHALL NOT BE DISRUPTED TO PROPERTIES. EXISTING SYSTEM, WITH A MAIN ON THE EAST AND WEST SIDE OF THE ROADWAY BEING REPLACED WITH A SIGNAL MAIN NEAR CENTERLINE CONTRACTOR SHALL COORDINATE AND STAGE WORK FOR REMOVAL ON EXISTING LINES AND INSTALL OF NEW SERVICES TO ACCOMMODATE CONTINUED SERVICE.
- CONTRACTOR SHALL LOCATE ALL EXISTING SANITARY AND WATER SERVICE CONNECTIONS AND CONSTRUCT NEW SERVICES TO THE R.O.W. LINE UNLESS DIRECTED BY THE ENGINEER.
- CONTRACTOR SHALL FIELD VERIFY THE SIZE, LOCATION, AND ELEVATION OF ALL SANITARY SEWER AND WATER SERVICES THAT ARE BEING REPLACED. (INCIDENTAL)
- MAINTAIN 10' MINIMUM HORIZONTAL SEPARATION OF WATERMAIN WITH SANITARY AND STORM SEWER MAINS, UNLESS OTHERWISE NOTED ON PLANS, WHERE INFEASIBLE, MAINTAIN 18" VERTICAL CLEARANCE,
- ALL CONNECTIONS TO EXISTING UTILITIES (WMN, SAN, STM, ETC.) SHALL BE FIELD VERIFIED FOR LOCATION AND FLEVATION (INCIDENTAL)
- 11. WATER AND SANITARY SERVICE PIPE SHALL BE REMOVED TO SERVICE INSTALLATION LIMITS. REMOVAL OF EXISTING SERVICE PIPES AND CURB STOPS SHALL BE CONSIDERED INCIDENTAL TO NEW SERVICE INSTALLATION. ABANDONED SERVICES WHERE NO NEW SERVICES ARE TO BE INSTALLED (DESIGNATED ON THE PLANS OR FIELD DETERMINED); SHALL HAVE THE EXISTING CURB STOP REMOVED AND BE CONSIDERED INCIDENTAL.
- EXISTING WATERMAIN DEPTHS AS SHOWN ARE APPROXIMATE. (FIELD VERIFY AS REQUIRED). 12.
- 13. REPLACE ALL WATER SERVICES BETWEEN NEW MAIN AND CURB BOX WITH NEW 1" TYPE K COPPER WATER SERVICE, UNLESS EXISTING IS GREATER THAN 1", THEN MATCH EXISTING SIZE.
- 14. A TEMPORARY WATER SERVICE PLAN SHALL BE SUBMITTED TO THE ENGINEER FOR APPROVAL 48 HOURS PRIOR TO PROPOSED TEMPORARY WATER SYSTEM INSTALLATION
- THE CONTRACTOR SHALL COORDINATE WATERMAIN WORK WITH THE FIRE DEPARTMENT AND THE CITY. THE CONTRACTOR WILL BE RESPONSIBLE FOR ARRANGING AND PROVIDING ANY REQUIRED WATERMAIN SHUT OFFS WITH THE CITY DURING CONSTRUCTION. ANY COSTS ASSOCIATED WITH WATERMAIN SHUTOFF WILL BE
- IT SHALL BE THE SOLE RESPONSIBILITY OF THE CONTRACTOR TO COORDINATE WITH UTILITY OWNERS TO RELOCATE AND PROTECT PRIVATE UTILITIES AS NECESSARY TO CONSTRUCT STREET AND UTILITIES.
- REFER TO PROJECT SPECIFICATIONS FOR STRUCTURE CASTING FRAME & COVER REQUIREMENTS. ALL FRAME & COVER DEVIATIONS SHALL BE INDICATED ON THE PLAN SHEETS.
- 18. A MINIMUM OF 24 HOURS AND MAXIMUM OF 48 HOURS NOTICE SHALL BE GIVEN TO ALL RESIDENTS AFFECTED BY THE TEMPORARY WATER OUTAGES. A MINIMUM OF 1 WEEK NOTICE OF ANY SERVICE INTERRUPTIONS (OF ANY TYPE) SHALL BE GIVEN TO ANY DAYCARE ON SITE.
- ADDITIONAL COMPENSATION WILL NOT BE GIVEN FOR WATERMAIN CONSTRUCTED AT EXTRA-DEPTH AS SHOWN
- 20. MAINTAIN A MINIMUM 7.5FT BURY FOR ALL WATERMAIN.
- COMMON EXCAVATION WILL BE CONSIDERED INCIDENTAL TO THE PIPE CONSTRUCTION IN ALL UTILITY TRENCH 21.
- PIPE BEDDING MATERIAL SHALL MEET MnDOT & CITY ENGINEERS ASSOCIATION OF MINNESOTA (CEAM) STANDARD SPECIFICATIONS AND ARE CONSIDERED INCIDENTAL TO THE PIPE INSTALLATION
- 23 BUILKHEADS SHALL BE INCIDENTAL LINLESS OTHERWISE NOTED ON PLANS

CONSTRUCTION NOTES

- SUITABLE GRADING MATERIAL ON THIS PROJECT SHALL CONSIST OF ALL SOILS ENCOUNTERED WITH THE EXCEPTION OF TOPSOIL, DEBRIS, ORGANIC MATERIAL, MUCK AND OTHER MATERIALS AS DETERMINED TO BE UNSUITABLE BY THE ENGINEER
- 2. EXCESS EXCAVATED AND UNSUITABLE MATERIALS SHALL BECOME THE PROPERTY OF THE CONTRACTOR AND SHALL BE DISPOSED OF IN ACCORDANCE WITH THE REQUIREMENTS OF MN/DOT SPEC 2105.
- THE AMOUNT BID FOR COMMON EXCAVATION SHALL INCLUDE ALL COSTS FOR REMOVAL AND DISPOSAL OF EXCESS EXCAVATED MATERIAL, UNSUITABLE MATERIAL, AND SALVAGING (AND TEMPORARILY STOCKPILING IF NECESSARY) SUITABLE RECLAIMED AGGREGATE BASE MATERIAL FOR REUSE AS AGGREGATE BASE ON THIS
- 4. SUBGRADE PREPARATION IN ACCORDANCE WITH MN/DOT SPEC 2112 SHALL BE CONSIDERED INCIDENTAL. IN AREAS OF FULL RECONSTRUCTION, SUBGRADE SHALL BE DEFINED AS THE EXISTING GROUND SURFACE LOCATED IMMEDIATELY BENEATH THE PROPOSED AGGREGATE BASE OR SAND SECTION AS SPECIFIED IN THE PLAN.
- SUBGRADE EXCAVATION AND CORRECTION SHALL BE APPLIED IF NECESSARY TO ACHIEVE SATISFACTORY SURFACES STABILITY AS DETERMINED BY THE ENGINEER. AREAS TO RECEIVE SUBGRADE EXCAVATION SHALL BE SPECIFIED BY THE ENGINEER IN THE FIELD FOLLOWING SUBGRADE PREPARATION AND A ROLL TEST. REPLACEMENT MATERIAL IN AREAS OF SUBGRADE PREPARATION SHALL SATISFY THE REQUIREMENTS OF STABILIZING AGGREGATE AS SPECIFIED IN THE SPECIAL PROVISIONS.
- WHERE A PROPOSED ROADWAY BEGINS OR TERMINATES AT AN EXISTING ROADWAY, PROVIDE A VERTICAL NOTCH TO THE BOTTOM OF THE AGGREGATE OR BITUMINOUS BASE AND A 20h:1V TAPER.
- PROVIDE 20h:1V TAPERS BETWEEN LONGITUDINAL CHANGES IN SUB-CUT DEPTHS, UNLESS OTHERWISE SPECIFIED IN THE FIELD BY THE ENGINEER.
- PROVIDE FOR A SAW-CUT WHERE PLACING NEW PAVEMENT IS INSTALLED ADJACENT TO EXISTING PAVEMENT.
- ALL MATERIALS TESTING SHALL BE ACCOMPLISHED IN ACCORDANCE WITH THE PROJECT SPECIFICATIONS.
- 10. ALL LISES OF THE WORD "INCIDENTAL" IN THESE CONSTRUCTION DOCUMENTS SHALL BE CONSTRUED TO MEAN INCIDENTAL WORK FOR WHICH NO DIRECT COMPENSATION SHALL BE MADE
- 11. ALL USES OF ABBREVIATION "TYP" IN THESE CONSTRUCTION DOCUMENTS SHALL BE CONSTRUED TO MEAN SIMILAR SYMBOLS/FEATURES SHALL BE TREATED WITH THE SAME NOTE.
- 12. ALL CASTINGS AND ADJUSTMENTS FOR NEW MANHOLES, CATCH BASINS, AND GATE VALVES SHALL BE INCLUDED IN THE PRICE BID FOR THAT RESPECTIVE ITEM.
- 13. COORDINATE WITH THE ENGINEER IN THE FIELD FOR LOCATION OF REPLACEMENT BOULEVARD TREES. PUBLIC WORKS STAFF WILL MEET WITH THE CONTRACTOR ON-SITE PRIOR TO ANY TREE PLANTING.
- 14. ALL ADJUSTMENTS FOR NEW MANHOLES (SPECIAL) SHALL BE INCLUDED IN THE PRICE BID FOR THAT RESPECTIVE

NOTE: EXISTING UTILITY INFORMATION SHOWN ON THIS PLAN HAS BEEN PROVIDED BY THE UTILITY OWNER. THE CONTRACTOR SHALL FIELD VERIFY EXACT LOCATIONS PRIOR TO COMMENCING CONSTRUCTION AS REQUIRED BY STATE LAW. NOTIFY GOPHER STATE ONE-CALL 1-800-252-1166 OR 651-454-0002

THE SUBSURFACE UTILITY INFORMATION IN THIS PLAN IS UTILITY QUALITY LEVEL C. THIS UTILITY QUALITY LEVEL WAS DETERMINED ACCORDING TO THE GUIDELINES OF CI/ASCE 38-02, ENTITLED "STANDARD GUIDELINES FOR THE COLLECTION AND DEPICTION OF **EXISTING SUBSURFACE UTILITY DATA."**





BURNSVILLE, MINNESOTA 55337 Phone: (952) 890-0509 www.bolton-menk.com



7	DES
Phold	DR
A DUCKE	CHI
Irban Hometown	CLII

		STA	TEMENT	OF ESTIMAT	ED QUANTI	TIES			
ITEM NO.	ITEM	NOTES	UNIT	TOTAL ESTIMATED QUANTITY	ROADWAY	STORM SEWER	SANITARY SEWER	WATERMAIN	LANDSCAPE
2011.601	VIBRATION MONITORING		LUMP SUM	1	0.2	0.2	0.2	0.2	0.2
2021.501	MOBILIZATION		LUMP SUM	1	0.2	0.2	0.2	0.2	0.2
2031.502	FIELD OFFICE TYPE D		EACH	1	1.0				
2101.524	CLEARING		TREE	89	89				
2101.524	GRUBBING		TREE	89	89				
2102.503	PAVEMENT MARKING REMOVAL		LIN FT	1700	1700				
2104.502	REMOVE MISCELLANEOUS STRUCTURES		EACH	3	3				
2104.502	REMOVE LIGHTING UNIT		EACH	42	42				
2104.502	REMOVE CONCRETE STRUCTURE		EACH	11 5	11				
2104.502 2104.502	REMOVE MASONRY WALL REMOVE PLANTER		EACH EACH	1	5 1				
2104.502	REMOVE PLANTER REMOVE MANHOLE		EACH	37	'		37		
2104.502	REMOVE GATE VALVE & BOX		EACH	47				47	
2104.502	REMOVE DRAINAGE STRUCTURE		EACH	85	85				
2104.502	REMOVE SIGN		EACH	70	70				
2104.502	REMOVE SIGNAL SYSTEM	(7)	EACH	2	2				
2104.502 2104.502	REMOVE LIGHT FOUNDATION		EACH EACH	42	42	 		18	
2104.502	SALVAGE HYDRANT SALVAGE SIGN TYPE SPECIAL		EACH	12	12			18	
2104.502	SALVAGE BICYCLE RACK		EACH	4	4				
2104.503	SAWING CONCRETE PAVEMENT (FULL DEPTH)		LIN FT	935	935				
2104.503	SAWING BITUMINOUS PAVEMENT (FULL DEPTH)		LIN FT	2890	2890				
2104.503	REMOVE WATERMAIN		LIN FT	8635				8635	
2104.503	REMOVE SEWER PIPE (STORM)		LIN FT	4460	4460				
2104.503	REMOVE SEWER PIPE (SANITARY)		LIN FT	10500			10500		
2104.503 2104.503	REMOVE CURB AND GUTTER		LIN FT	17257 183	17257 183				
2104.503	REMOVE RETAINING WALL REMOVE FENCE		LIN FT	2020	2020				
2104.503	REMOVE CABLES		LIN FT	37677	37677				
2104.503	REMOVE NON-METALLIC CONDUIT		LIN FT	12559	12559				
2104.503	SALVAGE FENCE		LIN FT	125	125				
2104.504	REMOVE CONCRETE DRIVEWAY PAVEMENT		SQ YD	2552	2552				
2104.504	REMOVE PAVEMENT (STREET)		SQ YD	41000	41000				
2104.504	REMOVE BITUMINOUS DRIVEWAY PAVEMENT		SQ YD	4718	4718				
2104.518	REMOVE CONCRETE SIDEWALK		SQ FT	<u>A</u> (71650	71650				
2104.518 2104.601	REMOVE CONCRETE MEDIAN SALVAGE IRRIGATION EQUIPMENT		SQ FT LUMP SUM	994	1				
2104.603	ABANDON PIPE SEWER		LIN FT	520	·		520		
	7.B. N. BONT II E GEWEN								
2105.507	STRUCTURAL SOIL BORROW (CV)		CU YD	80					80
					√ △				
2106.507	EXCAVATION - COMMON (P)	(P)	CU YD	12500	12500				
2106.507	COMMON EMBANKMENT (CV) (P)	(P)	CU YD	1200	1200				
2402 040	· · · · · · · · · · · · · · · · · · ·	<u>~~</u>				\\\\\\\\\\\\\\\\\\\\\\\\\\\\\\\\\\\\\\	<u> </u>		· · · · · · · · · · · · · · · · · · ·
2123.610 2123.610	1.5 CU YD BACKHOE STREET SWEEPER (WITH PICKUP BROOM)		HOUR	40	500	10	20	10	~~~~
2120.010	STALL OWLL EX (WITH FIGNOR BROOM)		TIOUR	300	300				
2130.523	WATER		MGAL	150	150				
		A							
2211.507	AGGREGATE BASE CLASS 5 (CV) (P)	{(P)}	CU YD	12200	12200				
									
2301.504	CONCRETE PAVEMENT 7.0"		SQ YD	960	960				
2301.602	DRILL AND GROUT DOWEL BAR (EPOXY COATED)	(5)	EACH SQ YD	1217 286	1217 286				
2301.604 2301.604	CONCRETE PAVEMENT 8.0" SPECIAL 1 CONCRETE PAVEMENT 8.0" SPECIAL 2	(5)	SQ YD SQ YD	562	562				
2301.004	SSTATE FOR ENDING OF EGIAL 2	(0)	30(1)		002			+	
2360.504	TYPE SP 12.5 WEAR COURSE MIX (3,C) 3.0" THICK (TRAIL)		SQ YD	3707	3707				
2360.504	TYPE SP 12.5 WEAR COURSE MIX (3,C) 3.0" THICK (DRIVEWAY)		SQ YD	2189	2189				
2360.509	TYPE SP 12.5 NON WEAR COURSE MIX (3,B)		TON	3188	3188				
2360.509	TYPE SP 12.5 WEARING COURSE MIX (3,C)		TON	6376	6376				
2411.507	STRUCTURE EXCAVATION CLASS U		CU YD	2667	2667				
2411.607 2411.618	CONCRETE STEPS		CU YD	5	5				
	PREFABRICATED MODULAR BLOCK WALL	1	SQ FT	7372	7372	1		1	

NOTES:

(P) PLAN QUANTITY

(5) CONCRETE SHALL BE DARK GREY IN COLOR. SEE SPECIAL PROVISIONS. (6) CONCRETE SHALL BE RED IN COLOR. SEE SPECIAL PROVISIONS.

(7) FOR REMOVAL OF SIGNAL SYSTEMS AT LYNDALE AVE/70TH ST AND LYNDALE AVE/67TH ST.

TIM LAMKIN JR.

BOLTON & MENK 12224 NICOLLET AVENUE BURNSVILLE, MINNESOTA 55337 Phone: (952) 890-0509 Email: Burnsville@bolton-menk.com www.bolton-menk.com



DESIGNED	NO.	REVISION	DATE
ZP/TL/SL	1	Λ	03/15/19
DRAWN	2	A	03/25/19
ZP/JW	4	4	03/28/19
CHECKED	H-		,,
TL/SL	-		
CLIENT PROJ. NO.	_		

G1.01R

	STATEMENT OF ESTIMATED QUANTITIES									
ITEM NO.	ITEM	NOTES	UNIT	TOTAL ESTIMATED QUANTITY	ROADWAY	STORM SEWER	SANITARY SEWER	WATERMAIN	LANDSCAPE	
2451.607	STRUCTURAL BACKFILL (CV)		CU YD	2389	2389					
2502.602	4" TP PIPE DRAIN CLEANOUT		EACH	4		4				
2503.503	12" RC PIPE SEWER CLASS V		LIN FT	<u>A</u> 2148	$\sim\sim$	2148				
2503.503	15" RC PIPE SEWER CLASS V		LIN FT	1920		1920				
2503.503	18" RC PIPE SEWER CLASS V		LIN FT	291		291				
2503.503	21" RC PIPE SEWER CLASS III		LIN FT	483		483				
2503.503	24" RC PIPE SEWER CLASS III		LIN FT	604		604				
2503.503	27" RC PIPE SEWER CLASS III		LIN FT	33		33				
2503.503 2503.503	30" RC PIPE SEWER CLASS III		LIN FT	174 108		174 108				
2503.503	48" RC PIPE SEWER CLASS III 12" PVC PIPE SEWER (C900)		LIN FT	20		20				
2503.503	16" PVC PIPE SEWER (C900)		LIN FT	25		25				
2503.503	24" PVC PIPE SEWER (C900)		LIN FT	20		20				
2503.602	CONNECT TO EXISTING STORM SEWER		EACH	18		18				
2503.602	CONNECT TO EXISTING DRAINAGE STRUCTURE		EACH	6		6				
2503.602	CONNECT TO EXISTING SANITARY SEWER		EACH	10			10			
2504.602	CONNECT TO EXISTING SANITARY SEWER (CORE DRILL)		EACH	1			1			
2503.602	CONNECT TO EXISTING SANITARY SEWER SERVICE		EACH	117			117			
2503.602	8"X6" PVC WYE (SDR 26)		EACH	5			5			
2503.602	10"X6" PVC WYE (SDR 26)		EACH	4			4			
2503.602 2503.603	12"X6" PVC WYE (SDR 26) 4" PVC PIPE SEWER (SDR 26)		EACH LIN FT	89 40			89 40			
2503.603	6" PVC PIPE SEWER (SDR 26)		LIN FT	5200			5200			
2503.603	8" PVC PIPE SEWER (SDR 35)		LIN FT	704			704			
2503.603	10" PVC PIPE SEWER (SDR 35)		LIN FT	720			720			
2503.603	12" PVC PIPE SEWER (SDR 35)		LIN FT	5285			5285			
2503.603	16" STEEL CASING PIPE		LIN FT	16		16				
2503.603	24" STEEL CASING PIPE		LIN FT	20		20				
2503.603	30" STEEL CASING PIPE		LIN FT	16		16				
2504.601	TEMPORARY WATER SERVICE		LUMP SUM	1				1		
2504.601	INSTALL IRRIGATION EQUIPMENT		LUMP SUM	1				1		
2504.602	CONNECT TO EXISTING WATERMAIN		EACH	9				9		
2504.602	CONNECT TO EXISTING WATER SERVICE (1")		EACH	87				87		
2504.602	CONNECT TO EXISTING WATER SERVICE (1 1/2")		EACH	1				1		
2504.602	CONNECT TO EXISTING WATER SERVICE (2")		EACH	7				7		
2504.602	CONNECT TO EXISTING WATER SERVICE (4")		EACH	5				5		
2504.602	CONNECT TO EXISTING WATER SERVICE (6")		EACH	4				4		
2504.602	INSTALL HYDRANT		EACH	16				16		
2504.602	1" CORPORATION STOP		EACH	87				87		
2504.602	1 1/2" CORPORATION STOP		EACH	1 7				1 7		
2504.602 2504.602	2" CORPORATION STOP		EACH EACH	7 5				7 5		
2504.602	4" GATE VALVE & BOX		EACH	21				21		
2504.602	6" GATE VALVE & BOX 8" GATE VALVE & BOX		EACH	6				6		
2504.602	12" GATE VALVE & BOX		EACH	17				17		
2504.602	16" GATE VALVE & BOX		EACH	1				1		
2504.602	1" CURB STOP & BOX		EACH	87				87		
2504.602	1 1/2" CURB STOP & BOX		EACH	1				1		
2504.602	2" CURB STOP & BOX		EACH	7				7		
2504.603	1" TYPE K COPPER WATER SERVICE		LIN FT	3700				3700		
2504.603	1 1/2" TYPE K COPPER WATER SERVICE		LIN FT	30			-	30		
2504.603	2" TYPE K COPPER WATER SERVICE		LIN FT	150				150		
2504.603	4" WATERMAIN DUCTILE IRON CL 52		LIN FT	225				225		
2504.603	6" WATERMAIN DUCTILE IRON CL 52		LIN FT	816				816		
2504.603	8" WATERMAIN DUCTILE IRON CL 52		LIN FT	362				362		
2504.603	12" WATERMAIN DUCTILE IRON CL 52		LIN FT	6576				6576		
2504.604 2504.608	4" INSULATION		SQ YD	200 4700				200		
∠304.008	DUCTILE IRON FITTINGS		POUND	4700				4700		

I HEREBY CERTIFY THAT THIS PLAN, SPECIFICATION, OR REPORT WAS PREPARED BY MORE OF THE PROPERTY OF THE PROPERTY





	DESIGNED	NO.	REVISION	DATE	Г
	ZP/TL/SL	1	Λ	03/15/19	
1	DRAWN	2	Δ	03/25/19	H
6	ZP/JW				
~	CHECKED				H
O. Pri	TL/SL				
	CLIENT PROJ. NO.				
	T16114541				

STATEMENT OF ESTIMATED QUANTITIES									
ITEM N	O. ITEM	NOTES	UNIT	TOTAL ESTIMATED QUANTITY	ROADWAY	STORM SEWER	SANITARY SEWER	WATERMAIN	LANDSCAPE
2506.50	2 CASTING ASSEMBLY (SANITARY)		EACH	29			29		
2506.50	2 CONSTRUCT DRAINAGE STRUCTURE DESIGN SPECIAL (2'X3')		EACH	47		47			
2506.50	2 CONSTRUCT DRAINAGE STRUCTURE DESIGN H		EACH	2		2			
2506.50	2 CASTING ASSEMBLY (STORM MH)		EACH	₫ 28		28			
2506.50	2 CASTING ASSEMBLY (STORM CB)		EACH	71		71			
2506.50	2 ADJUST FRAME & RING CASTING		EACH	12		12			
2506.50	3 CONSTRUCT DRAINAGE STRUCTURE DESIGN 48-4020		LIN FT	217.3		217.3			
2506.50	3 CONSTRUCT DRAINAGE STRUCTURE DESIGN 60-4020		LIN FT	24.3		24.3			
2506.50	3 CONSTRUCT DRAINAGE STRUCTURE DESIGN 72-4020		LIN FT	88.7		88.7			
2506.60	3 CONSTRUCT SANITARY SEWER MANHOLE (48" DIA)		LIN FT	320.9			320.9		
				Δ					
2521.51	8 4" CONCRETE WALK		SQ FT	52492	52492				
2521.51		(5)	SQ FT	12308	12308				
2521.51	8 4" CONCRETE WALK SPECIAL 2	(6)	SQ FT	8163	8163				
2521.51	8 6" CONCRETE WALK	1	SQ FT	10744	10744				
2521.51		(5)	SQ FT	61	61	+			
	C CONTROL TO MERCON EDITION TO	(-7		Δ					
2531.50	3 CONCRETE CURB & GUTTER DESIGN B612	1	LIN FT	3500	3500	+		+	
2531.50			LIN FT	4130	4130				
2531.50			LIN FT	11710	11710				
		$\rightarrow \sim$	LIN FT	2270	2270		\\\\	~~~	~~~
2531.50 2531.50			LINFT	275	275				~~~~
2531.50			LINFT	56	56				
2531.50			LIN FT	25	25				
2531.50			LIN FT	25	25				
2531.50	` '		LIN FT	55	55				
2531.50			LIN FT	79	79				
2531.50			SQ YD	1500	1500				
2531.50	4 6" CONCRETE DRIVEWAY PAVEMENT SPECIAL 1	(5)	SQ YD	15	15				
2531.50	4 8" CONCRETE DRIVEWAY PAVEMENT		SQ YD	714	714				
2531.50	4 8" CONCRETE DRIVEWAY PAVEMENT SPECIAL 1	(5)	SQ YD	233	233				
2531.60	3 CONCRETE SILL		LIN FT	971	971				
2531.60	4 7" CONCRETE VALLEY GUTTER		SQ YD	123	123				
2531.61	8 TRUNCATED DOMES		SQ FT	1736	1736				
2540.60	2 ENTRANCE MONUMENT 1		EACH	1					1
2540.60	2 ENTRANCE MONUMENT 2		EACH	1					1
2540.60	2 BICYCLE RACK	(4)	EACH	4	4				
						· · · · · · · · · · · · · · · · · · ·		· · · · · ·	· · · · · · ·
2545.50	2 LIGHTING UNIT TYPE SPECIAL 1		EACH	28	28				
2545.50			EACH	36	36	1			
2545.50			EACH	64	64	1			
2545.50			LIN FT	12670	12670	+		+	
2545.50			LIN FT	26030	26030	+			
2545.50			LIN FT	13015	13015				
				1		+		+	
2550.60	2 FIBER OPTIC SPLICE/PATCH PANEL		EACH	2	2	+ +			
2550.60			EACH	2	2	+		+	
2550.60			EACH	1	1	+			
2550.60			LIN FT	800	800	+		+	
∠550.60	3 PRE-TERMINATED/ARMORED FIBER OPTIC CABLE		LINFI	000	600				
0500 50	2 PORTARI E RREGART COMO DA SERVER DES COMO		LINITT	2000	2000				
2533.50		-	LINFT	2000	2000	+			
2533.50	3 RELOCATE PORT PRECAST CONC BAR DES 8337		LIN FT	4000	4000				
	_				_				
2557.60			LIN FT	260	260				
2557.60	3 CHAIN LINK SAFETY FENCE		LIN FT	1350	1350				

NOTES:

- (4) FOR INSTALLATION OF SALVAGED BICYCLE RACKS.
- (5) CONCRETE SHALL BE DARK GREY IN COLOR. SEE SPECIAL PROVISIONS.
- (6) CONCRETE SHALL BE RED IN COLOR. SEE SPECIAL PROVISIONS.

TIM LAMKIN JR.





7)
./	held
	Hometown
UFDAL	

G1.03R

			STA	TEMENT	OF ESTIMAT	ED QUANTI	TIES			
ITEM	ИNO.	ITEM	NOTES	UNIT	TOTAL ESTIMATED QUANTITY	ROADWAY	STORM SEWER	SANITARY SEWER	WATERMAIN	LANDSCAPE
2563	3.601	TRAFFIC CONTROL		LUMP SUM	1	0.2	0.2	0.2	0.2	0.2
2563	3.601	ALTERNATE PEDESTRIAN ROUTE		LUMP SUM	0000	0.2	0.2	0.2	0.2	0.2
2563	3.602	RAISED PAVEMENT MARKER		ĚACH	70	70	Ť.		T . V . V . V . V .	
2563	3.613	PORTABLE CHANGEABLE MESSAGE SIGN		UDAY	400	400.0				
2563	3.618	CONSTRUCTION SIGN-SPECIAL		SQ FT	1000	1000.0				
	4.502	OBJECT MARKER TYPE X4-2		EACH	25	25				
_	4.502	OBJECT MARKER TYPE X4-4		EACH	24	24				
	4.518	SIGN PANELS TYPE C		SQ FT	765	765				
	4.518	SIGN PANELS TYPE SPECIAL		SQ FT	217	217				
2564	4.602	INSTALL SIGN TYPE SPECIAL		EACH	12	12				
2565	5.501	EMERGENCY VEHICLE PREEMPTION SYSTEM A		LUMP SUM	1	1				
	5.501	EMERGENCY VEHICLE PREEMPTION SYSTEM B	\triangle	LUMP SUM	1	1				
	5.516	TRAFFIC CONTROL SIGNAL SYSTEM A	(8)	SYSTEM	1	1				
	5.516	TRAFFIC CONTROL SIGNAL SYSTEM A	(8)	SYSTEM	1	1			1	
	5.616	PEDESTRIAN CROSSWALK FLASHER SYSTEM A		SYSTEM	1	1				
	5.616	PEDESTRIAN CROSSWALK FLASHER SYSTEM A PEDESTRIAN CROSSWALK FLASHER SYSTEM B		SYSTEM	1	1			1	
	5.616	PEDESTRIAN CROSSWALK FLASHER SYSTEM C		SYSTEM	1	1			+	
	5.616	PEDESTRIAN CROSSWALK FLASHER STSTEM C		SYSTEM	1	1			1	
_	5.616	PEDESTRIAN CROSSWALK FLASHER SYSTEM B		SYSTEM	1	1				
	5.616	PEDESTRIAN CROSSWALK FLASHER SYSTEM F		SYSTEM	1	1			+	
	5.616	PEDESTRIAN CROSSWALK FLASHER SYSTEM G		SYSTEM	1	1			+	
		T EBEGINAL ON GOOD MEETER OF OTHER OF OTHER OF			·					
2571	1.524	TRANSPLANT TREE		TREE	6					6
-	1.524	CONIFEROUS TREE 6' HT. B&B		TREE	5					5
	1.524	DECIDUOUS TREE 2.5" CAL B&B		TREE	178					178
	1.524	ORNAMENTAL TREE 2" CAL B&B		TREE	2					2
2571	1.525	CONIFEROUS SHRUB 3' HT. B&B		SHRB	14	\sim	\sim	$\sim\sim$		14
	1.525	DECIDUOUS SHRUB NO 5 CONTAINER		SHRB (187					187
2571	1.527	PERENNIAL 1 GAL CONTAINER		PLT (3179					3179
2571	1.602	TREE GRATE & FRAMES		EACH	$\sim_{6}\sim$		 		\longrightarrow	
2573	3.502	STORM DRAIN INLET PROTECTION		EACH	129	129				
2573	3.503	SILT FENCE, TYPE MS		LIN FT	1950	1950				
2574	4.507	COMMON TOPSOIL BORROW		CU YD	675					675
2574	4.507	BOULEVARD TOPSOIL BORROW		CU YD	680					680
2575	5.504	SODDING TYPE LAWN		SQ YD	13050	13050				
2575	5.504	HYDROMULCH (SEED MIX 36-711)		SQ YD	1279	1279				
2575	5.507	MULCH MATERIAL TYPE 6		CU YD	120	120				
2575	5.607	LANDSCAPE ROCK		CU YD	130					130
	2.503	4" SOLID LINE PAINT		LIN FT	566	566				
	2.503	4" SOLID LINE MULTI-COMPONENT GROUND IN (WR)		LIN FT	13100	13100				
	2.503	8" SOLID LINE MULTI-COMPONENT GROUND IN (WR)		LIN FT	10520	10520				
	2.503	24" SOLID LINE MULTI-COMPONENT GROUND IN (WR)		LIN FT	160	160				
	2.503	4" BROKEN LINE MULTI-COMPONENT GROUND IN (WR)	(1)	LIN FT	620	620				
	2.503	4" DOTTED LINE MULTI-COMPONENT GROUND IN (WR)	(2)	LIN FT	24	24				
	2.503	8" DOTTED LINE MULTI-COMPONENT GROUND IN (WR)	(2)	LIN FT	24	24				
	2.503	12" DOTTED LINE MULTI-COMPONENT GROUND IN (WR)	(3)	LIN FT	104	104				
	2.503	4" DOUBLE SOLID LINE MULTI-COMPONENT GROUND IN (WR)		LIN FT	2475	2475				
	2.503	4" SOLID LINE PREFORM TAPE GROUND IN (WR) CONTRAST		LIN FT	881	881				
	2.503	8" SOLID LINE PREFORM TAPE GROUND IN (WR) CONTRAST		LIN FT	1382	1382				
	2.503	4" DOTTED LINE PREFORM TAPE GROUND IN (WR) CONTRAST	(2)	LIN FT	52	52				
	2.503	8" DOTTED LINE PREFORM TAPE GROUND IN (WR) CONTRAST	(2)	LIN FT	52	52				
	2.503	12" SOLID LINE PREFORM THERMO GROUND IN		LIN FT	3070	3070				
	2.503	24" SOLID LINE PREFORM THERMO GROUND IN		LIN FT	146	146				
	2.518	PAVEMENT MESSAGE PREFORM THEREMOPLASTIC GROUND IN		SQ FT	1099	1099				
2582	2.518	CROSSWALK PREFORM THERMOPLASTIC GROUND IN		SQ FT	756	756				

- (1) LENGTH DOES NOT INCLUDE GAPS. BROKEN LINE STRIPE IS 10' STRIPE WITH A 40' GAP.
- (2) LENGTH DOES NOT INCLUDE GAPS. DOTTED LINE STRIPE IS 2' STRIPE WITH A 6' GAP.
- (3) LENGTH DOES NOT INCLUDE GAPS. DOTTED ROUNDABOUT LINE STRIPE IS 3' STRIPE WITH A 3' GAP.

 (8) ITEM INCLUDES REMOVAL OF EXISTING SIGNAL SYSTEM.


TIM LAMKIN JR.





12224 NICOLLET AVENUE BURNSVILLE, MINNESOTA 55337 Phone: (952) 890-0509 Email: Burnsville@bolton-menk.com www.bolton-menk.com


The Urban Hometown


DESIGNED	NO.	REVISION	DATE	
ZP/TL/SL	1	Δ	03/15/19	
DRAWN	2	Δ	03/25/19	
ZP/JW				
TL/SL				
TL/JL				1
CLIENT PROJ. NO.				
T16114541				

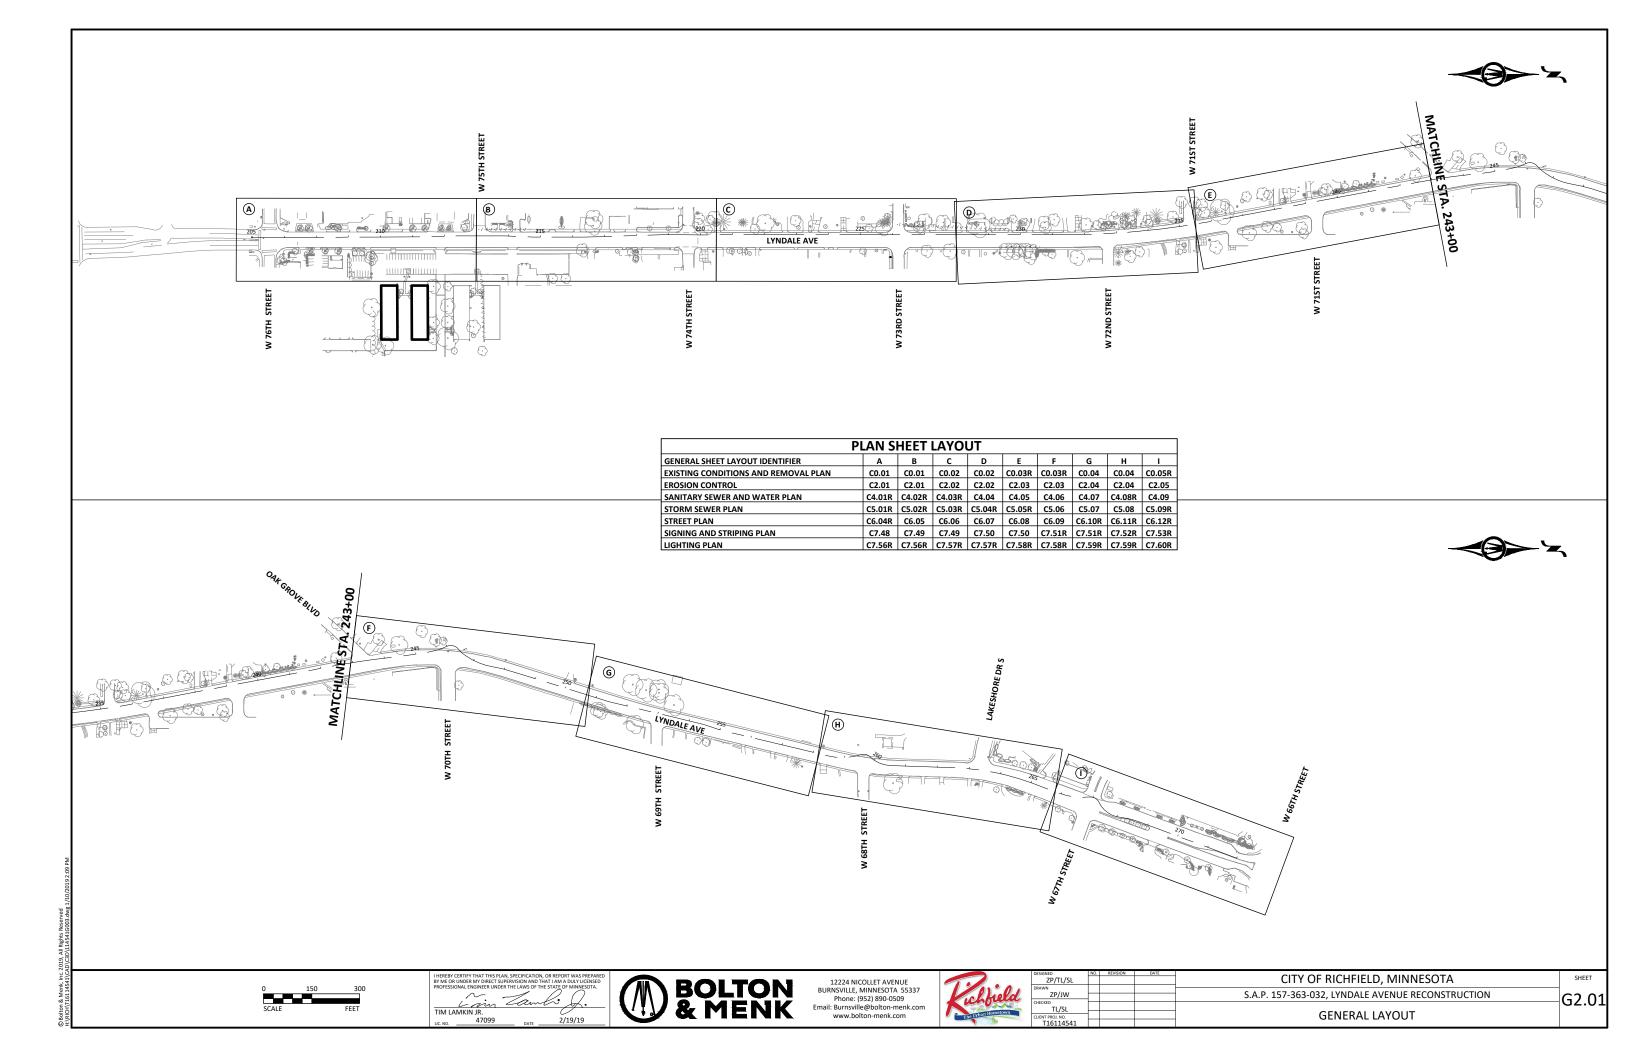


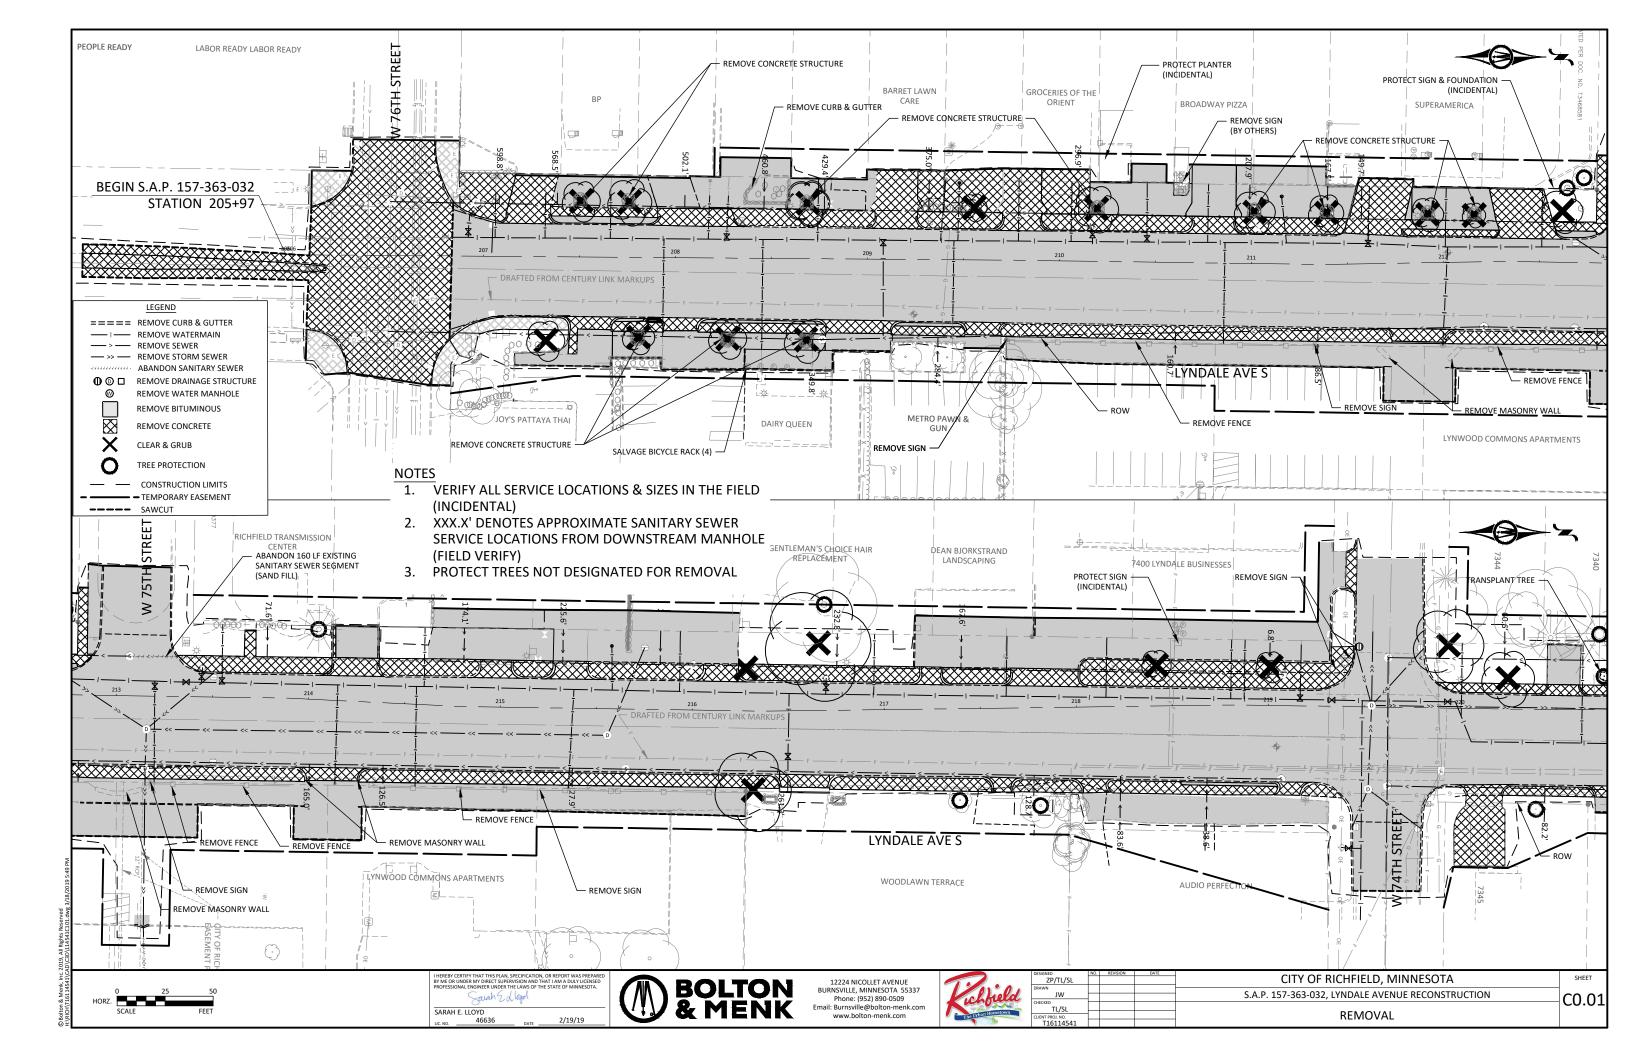


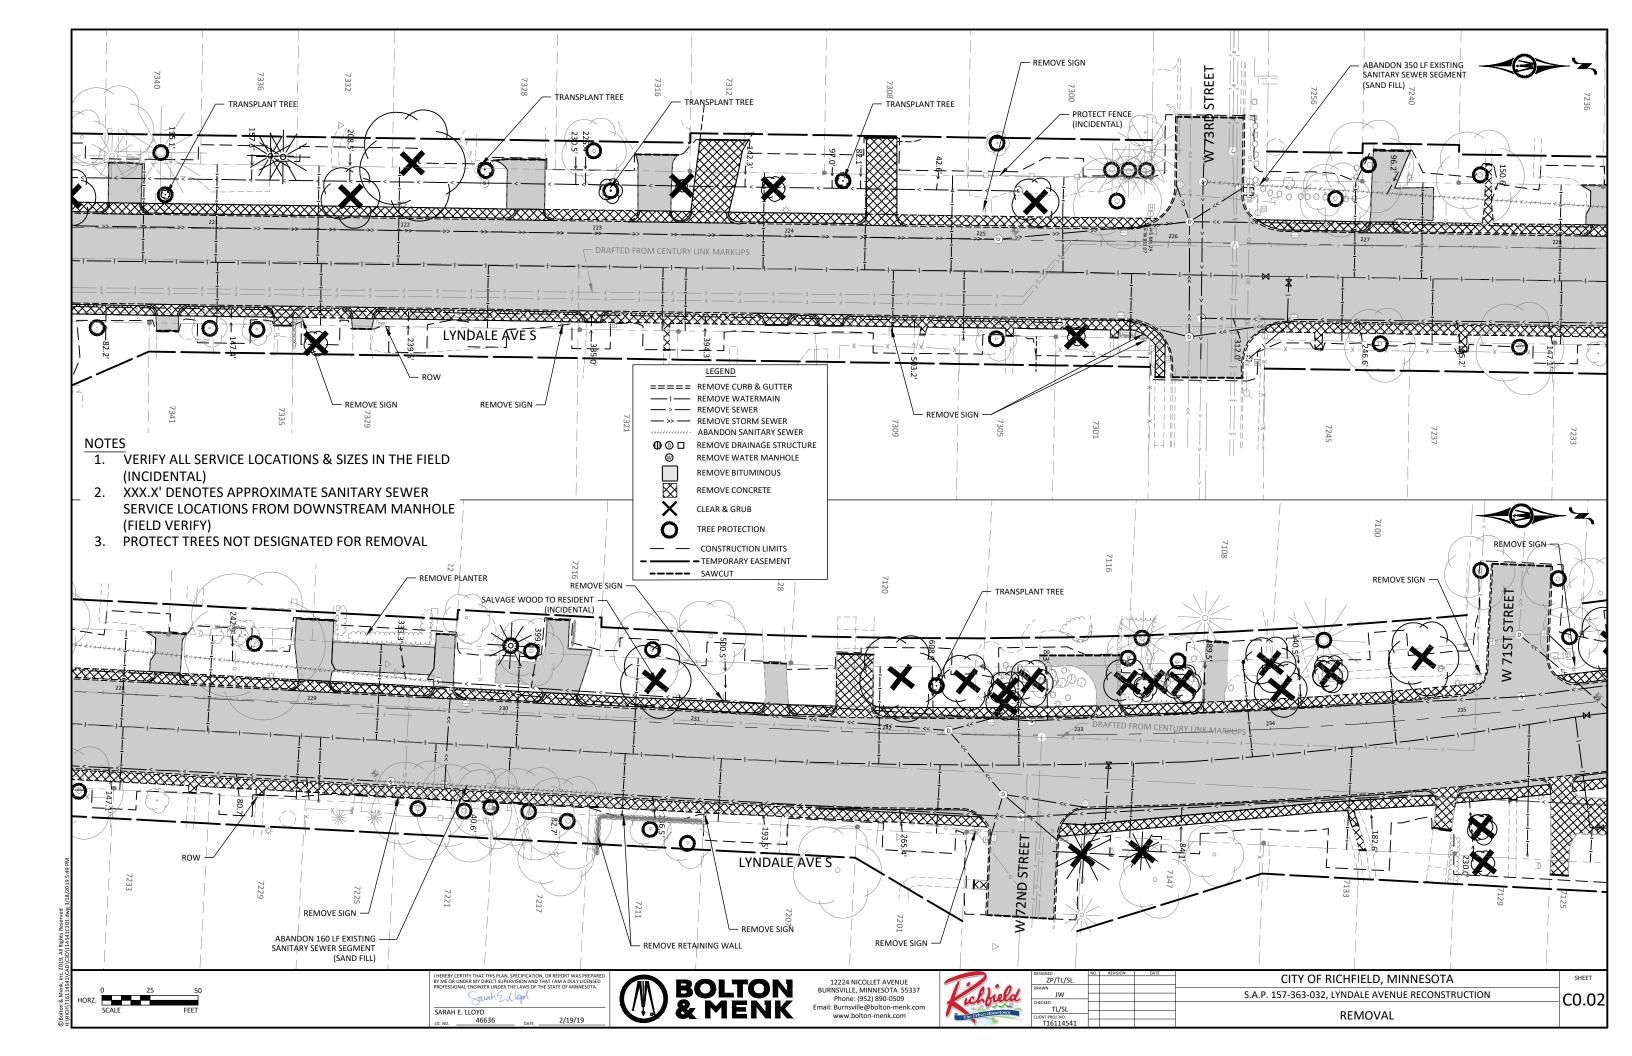

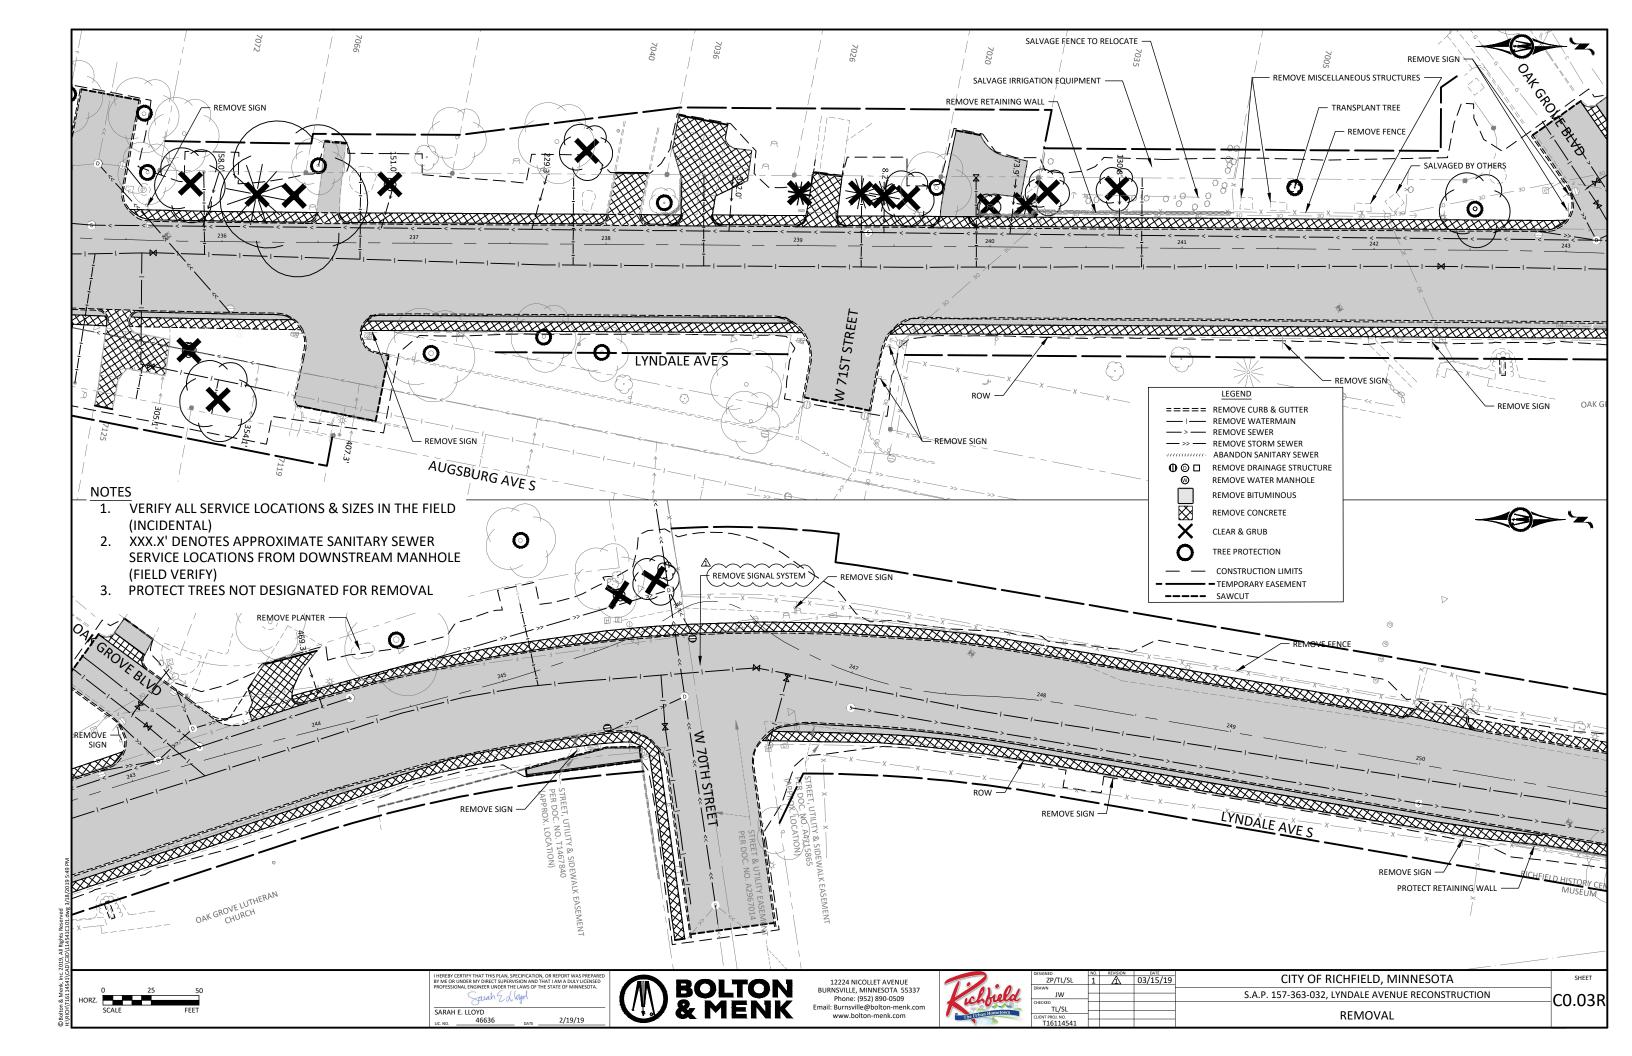

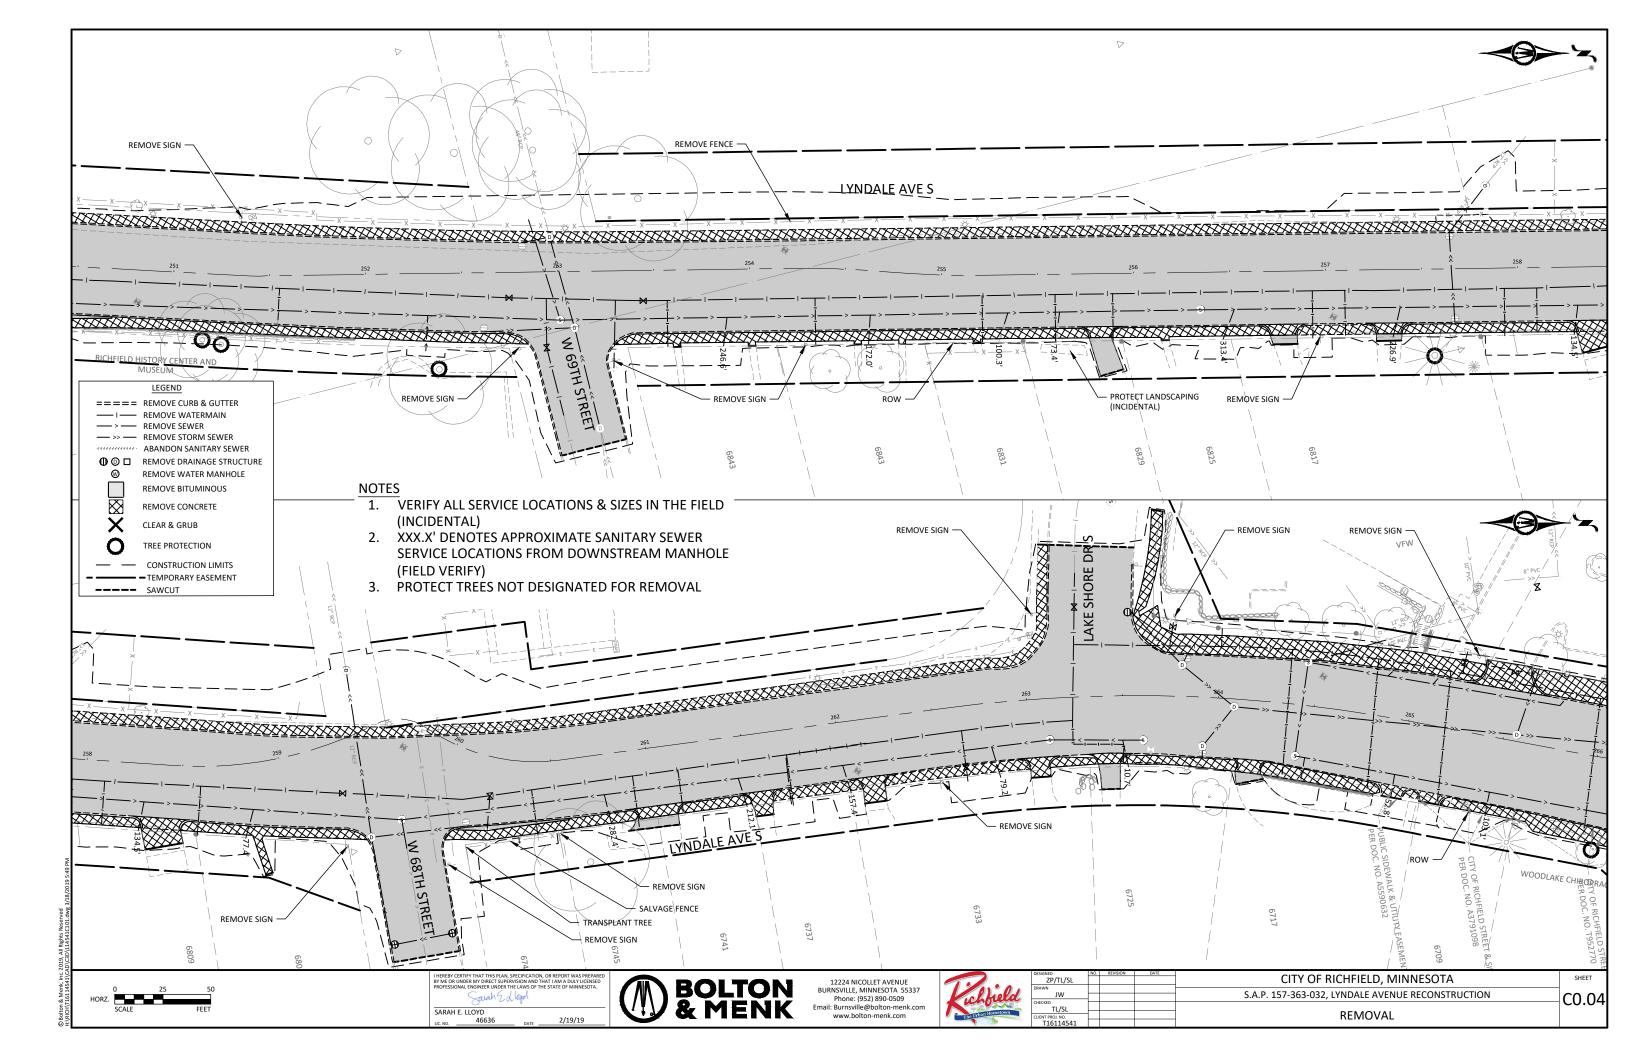


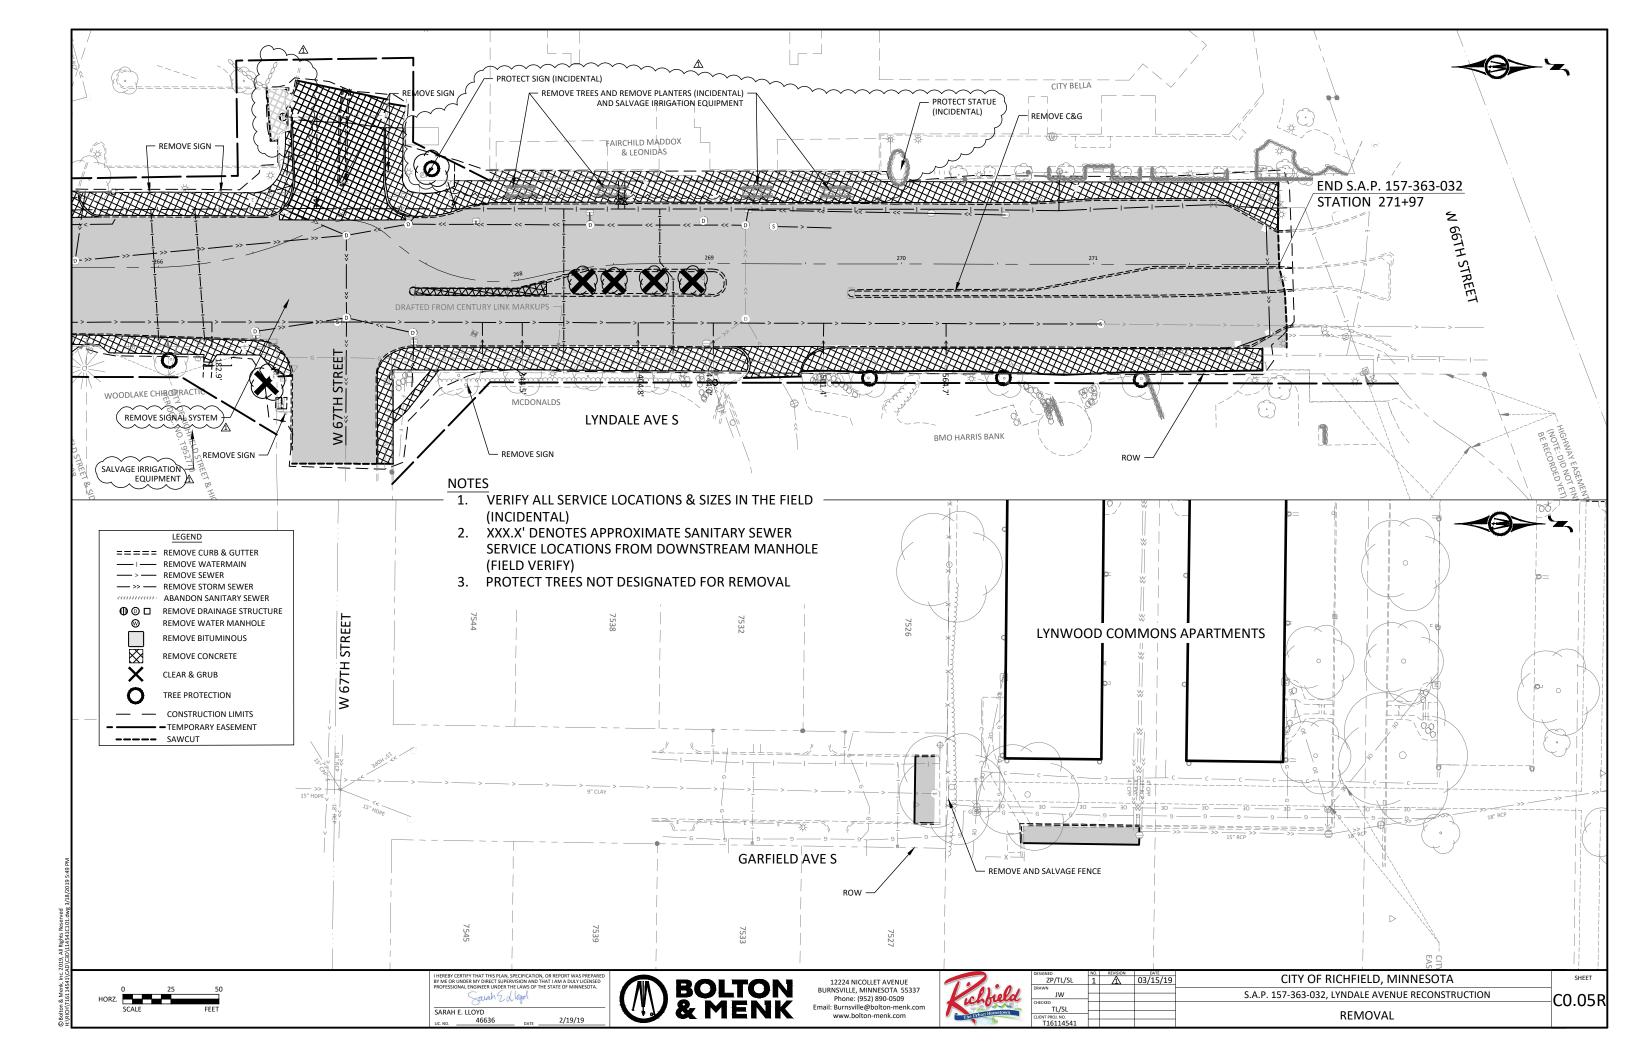

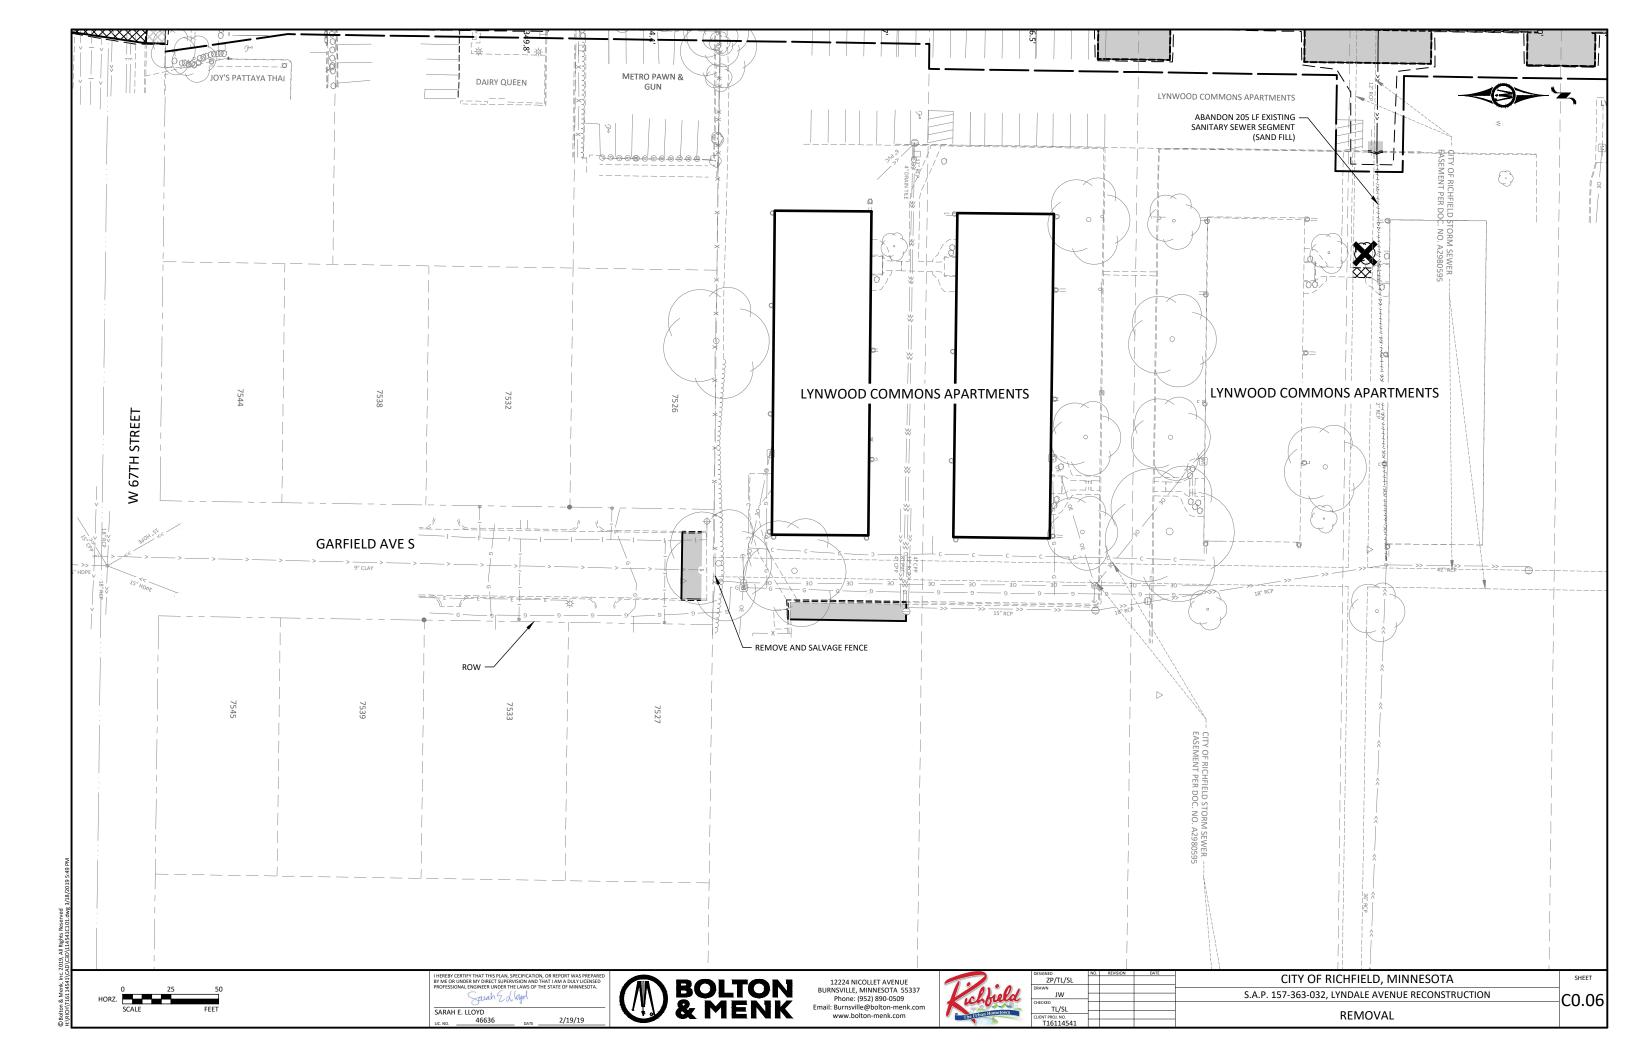


EXISTING TYPICAL SECTION - LYNDALE AVE

76TH - LAKESHORE DR

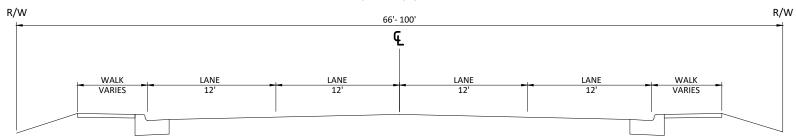

EXISTING TYPICAL SECTION - LYNDALE AVE

LAKESHORE DR - 66TH

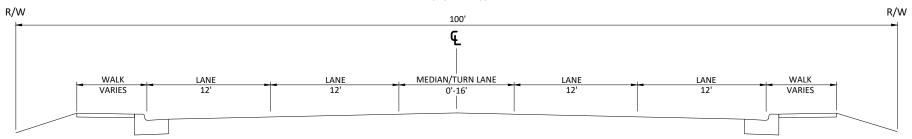

BORING	BITUMINOUS	CONCRETE
	DEPTH	DEPTH
STA.	(INCHES)	(INCHES)
267+00	2.75	7.00
264+00	2.75	8.75
262+00	13.50	
259+50	13.00	
256+50	12.50	
254+00	12.50	
251+75	14.00	
247+50	12.00	
241+50	11.50	
235+50	12.00	
229+25	12.50	
225+50	12.00	
219+00		8.00
211+50		7.00
209+00		7.75

NOTES:

SEE SOIL BORING REPORT FOR EXISTING PAVEMENT DEPTHS. DEPTHS ARE APPROXIMATE. VARIANCE IN PAVEMENT THICKNESS WILL NOT BE COMPENSATED AND IS INCIDENTAL.









DESIGNED	NO.	REVISION	DATE	CITY OF RICHFIELD, MINNESOTA
ZP ZNP /SL				CITT OF RICHFIELD, WIINNESOTA
ZIRIVITEV				S.A.P. 157-363-032, LYNDALE AVENUE RECONSTRUCTION
CHECKED				3.A.F. 137-303-032, ETINDALE AVEINGE RECONSTRUCTION
TUISL				
CLIENT PROJ. NO.				TYPICAL SECTION
T16114541				16/12/32/31/31/

C1.01

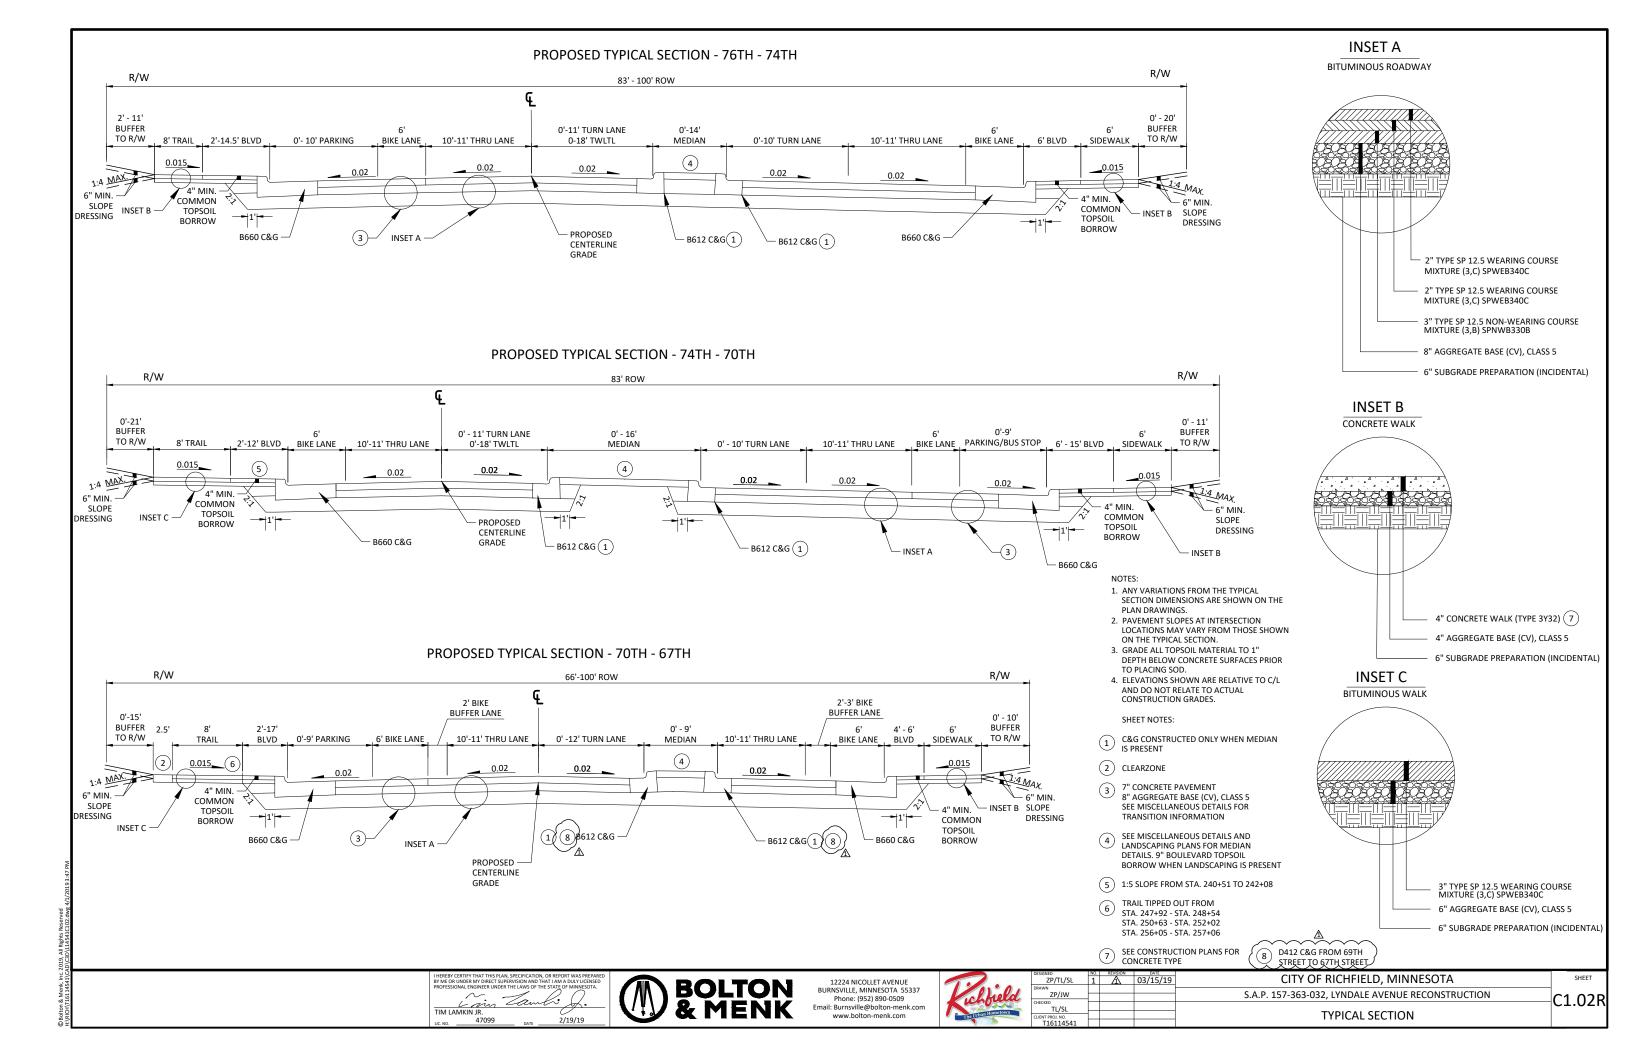

PROPOSED TYPICAL SECTION -67TH - 66TH

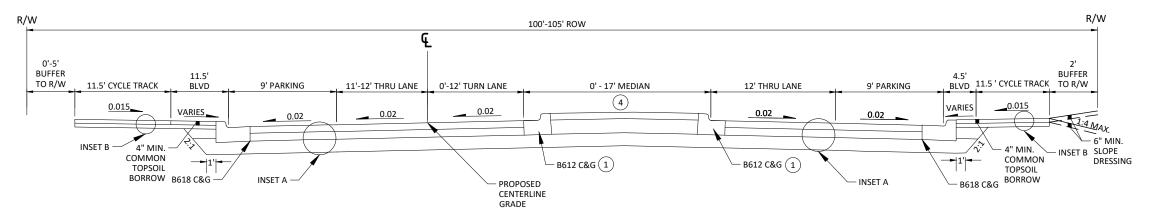


NOTES:


- 1. ANY VARIATIONS FROM THE TYPICAL SECTION DIMENSIONS ARE SHOWN ON THE PLAN DRAWINGS.
- PAVEMENT SLOPES AT INTERSECTION
 LOCATIONS MAY VARY FROM THOSE SHOWN ON THE TYPICAL SECTION.
- 3. GRADE ALL TOPSOIL MATERIAL TO 1" DEPTH BELOW CONCRETE SURFACES PRIOR
- TO PLACING SOD.

 4. ELEVATIONS SHOWN ARE RELATIVE TO C/L AND DO NOT RELATE TO ACTUAL CONSTRUCTION GRADES.

SHEET NOTES:

- C&G CONSTRUCTED ONLY WHEN MEDIAN IS PRESENT
- SEE MISCELLANEOUS DETAILS AND LANDSCAPING PLANS FOR MEDIAN DETAILS.
 9" BOULEVARD TOPSOIL BORROW WHEN LANDSCAPING IS PRESENT

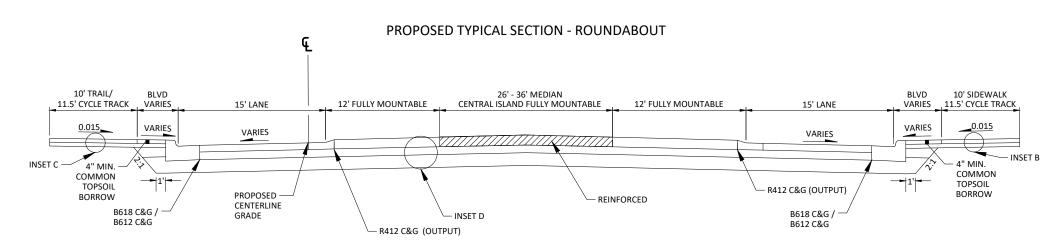

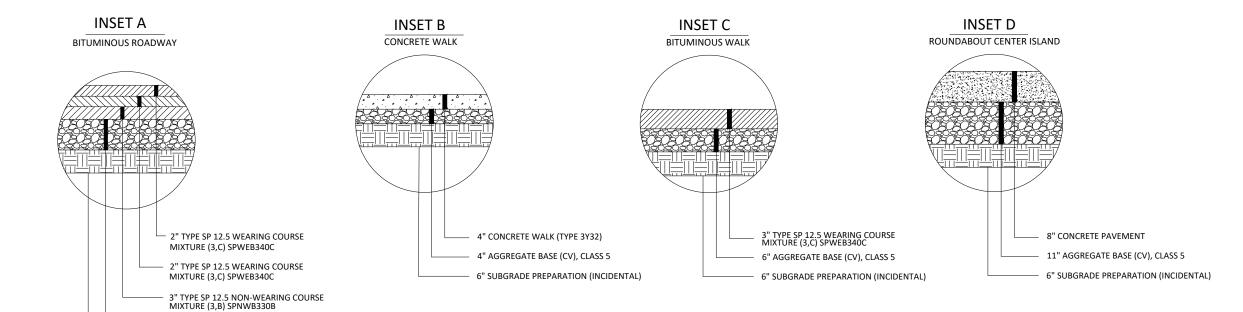

8" AGGREGATE BASE (CV), CLASS 5 6" SUBGRADE PREPARATION (INCIDENTAL)





	2000
	La
9	
	The Urban Hometown
-	1110

ZP ZNP /SL				
RAWN .				
ZIRIKINEV				
HECKED				
TII/ISL				
JENT PROJ. NO.				
T1C11AEA1	1	l	1	

C1.03

														5/0)RM SE	WER 1	ABLE																
										STRUCT	URES					CASTINGS					PIPE		_					CONNEC	т	DF	RAINS TO		
STRUCT ID	T. ROADWAY	STA	OFFSET	LT/RT	PROPOSED RIM	EFFLUENT INVERT ELEV.	STRUCT. BUILD	SPECIAL 2' X 3' CB	DESIGN H	48" 4020	48" 4022	60" 4020	72" 4020	F&I R-3067-V CASTING	F&I R-4340-B CASTING	F&I R-3067-C CASTING	F&I R-1733 CASTING	F&I R-2534 CASTING	12" STM PIPE	12" C900 PIPE	15" STM PIPE	18" STM PIPE	21" STM PIPE	24" STM PIPE	STM	STM S	STM S	TORM S	TO EX STORM PIPE	STRUCT. NO	PIPE GRADE	INVERT ELEV	NOTI
			(FT)		(ELEV)	(FT)	(LF)	(EA)	(EA)	(EA)	(EA)	(EA)	(EA)	(EA)	(EA)	(EA)	(EA)	(EA)	(LF)	(LF)	(LF)	(LF)	(LF)	(LF)	(LF)	(LF) (I	LF)	(EA)	(EA)		(%)		
EXCB1		106+31.64'	64.21	LT	844.78	841.11	3.66																									$\overline{}$	
EXMH2A EXMH 2	_	106+33.52' 106+56.57'	37.94 40.16	RT RT	845.67 846.59	841.67 841.09	4.00 5.50																									$\overline{}$	
EXMH 1	_	106+56.89'	38.74	LT	846.67	841.77	4.90		<u> </u>																							\Box	
EXCB2	LYMDALE	106+75.30'	52.98	LT	844.76	841.09	3.66						$\overline{}$																				
CB 2B	_	106+96+99	3.05	RT	847.00	841.81	5.19	1	-					1					23											CBMH 2A	0.50%	841.70	eg
CB 2A CB 1A	LYNDALE	107+01.45 107+03.25	25.26 32.34	RT LT	847.08 846.71	841.60 842 _a 00	5.48 4 _a 71	1			1			1					47 47									1		EXMH2 EXMH1	1.06% 0.50%	843.58 842.02	-
OR 2C		108+19.10	22.30		847.06	642.23	4.83				1								117		^	_	_		<u> </u>	A .				CBMH 2A	0.54%	841.60	$\overline{}$
CB 2D	LYNDALE	108+42.11	33.40	LT	847.26	843.26	4.00	1						1					62	\sim										CRMH 2C	0.70%	943.26	
CBMH 30	_		344.91	RT	849.27	845.62	3.64	1						1					112									1		EXMH 30	5.23%	839.74	
CB 30A EXMH 30		109+62.33 110+74.51'	312.55 350.72	RT RT	849.11 844.53	846.04 839.54	3.07 4.99	1	+					1					32										-	CBMH 30	1.00%	847.72	
CB 3B	LYNDALE	112+54.41	27.67	LT	846.69	843.30	3.39	1	1					1							49									СВМНЗА	0.45%	842.98	
CB 3A	LYNDALE	112+54.41	21.67	RT	846.77	842.98	3.79	1						1							61									MH3	0.50%	842.67	
CB 3G		142+95.46	50.48	RI	046.25	842.25	4.00		> ~	~			~~	<u>_</u>	~~		1	~~	20											МНЗН	1.99%	841.85	_
MH 3H MH 3	LYNDALE	113+15.61' 113+15.69'	50.14 25.74	RT RT	846.03 846.42	841.50 841.72	4.53 4.70			1		1					1	, ,		1	•	24	•	_	* *					MH 3H	0.50%	841.60	~
CB 3/\	LYNDALE	118+25.46	50.19	+	816.11	841.94	4.17	A 1 A		_ ^				A 1 A																MH 3H	2.13%	841.90	
СВМН 30	C LYNDALE	113+69.62	21.92	RT	846.72	843.23	3.49				1			1				~~	10		\sim						7	$\overline{}$		MHSH	2.16%	641.85	<u> </u>
CB 3D		113+69.67	27.67	LT	847.09	843.58	3.51	1	1					1			1				50									CBMH 3C	0.50%	843.33	
STMH 3E CB 3F	E LYNDALE LYNDALE	115+74.94' 115+78.02	21.33 59.99	RT LT	847.83 847.00	844.09 844.41	3.74 2.59		1	1				1							205 81									CBMH 3C STMH 3E	0.37%	843.33 844.09	
CB 4K	LYNDALE	119+04.79	31.67	LT	846.06	842.06	4.00		<u> </u>		1			1							34									CBMH 4J	0.74%	841.81	
CB 4F	LYNDALE	119+04.98	7.02	LT	847.05	842.66	4.39	1						1					25											CB 4K	2.01%	842.16	
CBMH 4		119+30.89	53.80	LT	847.05	841.71	5.34				1			1							15									CBMH 4I	0.98%	841.81	
CBMH 4I		119+45.33	45.41 54.97	RT LT	845.50 845.79	841.10 841.47	4.40	1	-					1							35									CBMH 4C STMH 4H	0.51%	840.92 841.57	
STMH 4F		119+45.36 119+53.96'	55.19	LT	845.84	840.71	4.32 5.13	1	1			1		1			1				9		26						1	CBMH 4G	1.03% 0.87%	840.48	
CBMH 40	_	119+80.36	45.28	RT	845.76	840.82	4.94				1			1							29									CBMH 4B	0.51%	840.67	
CBMH 40		119+80.42	56.40	LT	845.76	840.38	5.38				1			1										37						CBMH 4	0.54%	840.18	
CBMH 4E		120.08.67 120+07.49	31.92 17.67	LT RT	846.52 846.16	840.08 840.57	6.44 5.59		-	1			1	1			1				32			101						CBMH 5I	0.70%	839.37 840.41	
CBMH 4		120+08.03	7.01	LT	846.65	840.31	6.34				1			1							25									CBMH 4	0.50%	840.18	
CBMH 5	_	121+09.84'	32.10	LT	847.15	839.27	7.88				1			1										315						СВМН 5Н	0.59%	837.40	
CBMH 5		124+25.02'		-	047.04	937,30	9.74					~		~~	\sim	\sim	\sim		\sim		\sim			151	\sim	\		\sim	\sim			830.25	
CB 5B	LYNDALE 5 LYNDALE	125+73.76 125+76.05	18.67 32.25	RT	845.90 646.90	840.00 936.15	5.90	1			A. <i>J</i>								38						٠,٠			_		MH 5A	0.50%	839.81	_
CBMH 5	_	126+02.13'	61.13	LT	846.69	842.34	4.35	1					_	1					34											STMA 5	0.50%	842.17	
STMH 5		120-08.47	27.91	- CT	846.23	833:00	13 23		\				~	~	~		~	~~	~	~	~				→					~~	~~	\	
MH 5A	LYNDALE		32.17	RT	846.07	833.10	12.97						1				1									-	60		1	STMH 5		 	
CB 5F	LYNDALE		33.42	\ <u>\</u>	846.61 846.49	842.60	4.01				1				~~				-53	\sim		\sim	59		\sim	γ			$\overline{}$	STMA 5	1.00%	842.44 836.41	<u> </u>
CB 5D		126+67.66' 126+67.72	9.67	LT RT	845.77	837.00 841.27	9.49 4.50	1			1			1					43				29							CBMH 5C	0.49%	841.06	
CBMH 6		128+39.02'	32.92	LT	846.61	839.16	7.45				1			1																CBMH 5C	0.50%	838.30	
CBMH 60		132+30.72'	13.73	RT	846.10	841.77	4.33				1			1					25											CBMH 6C	0.94%	841.53	
CBMH 60		132+34.49	11.48	LT	846.60	841.43	5.17	-			1			1						\vdash	19		201							CBMH 6B	0.89%	841.32	
CBMH 68		132+32.08' 132+54.57'	30.75 38.70	LT RT	846.35 847.06	841.22 842.05	5.13 5.01	1				1		1					35				391		+	+				CBMH 6A CBMH 6D	0.50%	839.26 841.77	
CBMH 6	_	132+88.14'	40.37	RT	846.92	842.30	4.62	1						1					36											CBMH 6G		842.12	
CB 6H	LYNDALE	133+15.95	4.81	LT	847.05	843.05	4.00				1			1								32								CBMH 6I	0.50%	841.64	
CBMH 60		133+17.19'	19.40	RT	846.58	842.79	3.79			-	1			1								24			\perp					CB H	0.50%	841.90	
CBMH 6	LYNDALE LYNDALE	132+95.86 135+21.78	29.94 58.95	LT	846.63 848.99	841.64 844.98	4.99	1_	-		1			11					15			63								CBMH 6B	0.50% 2.00%	841.32 944.98	
MH 7	LYNDALE	135+36.61'	56.71	LT	848.67	843.58	5.09			1							1					~			<u> </u>				1	<u>vv</u>		<u> </u>	_
CBMH7A	_	135+50.57'	54.59	LT	848.98	843.66	5.32	1						1					14											MH 7	0.50%	843.58	
CBMH 70		135+61.94'	21.12	RT	849.50	844.00	5.50	1	-					1	4	-			77						+				_	CBMH 7A	0.50%	843.66	
MH 7A	-	135+53.96	76.31 29.40	RT	849.00	844.28 845.19	4.72								1				56										1	CBMH 7C	0.50%	844.00	
CBMH 8		140+19.48	4.51	LT	850.05	846.05	4.00	1						1					25				\exists		\top				T	CBMH 8E	3.12%	845.28	
CB 8D	_	142+65.95	20.17	RT	848.40	844.40	4.00	1						1					26											CBMH 8C	0.50%	844.27	
CBMH 88	_	142+65.95	29.42	LT	848.75	843.85	4.90			1				1					89	\sqcup										CBMH 8A	0.50%	843.41	
CBMH 80		142+65.95' 142+92.05'	5.42 65.18	LT LT	848.91 848.97	844.17 844.93	4.74 4.04	1		-				1					24 36	\vdash					+	_	_			CBMH 8F	0.93%	843.95 844.72	
CBMH 8		142+92.05	65.47	LT	848.75	844.62	4.04	1						1					45											CB 8A	2.68%	843.41	
CB 8A	LYNDALE	143+54.46	28.62	LT	848.75	843.31	5.44						1	1	1				t		168					-				CBMH 9A	0.65%	842.22	

Boton & Menk, Inc. 2019, All Rights Reserved RICH\T16114541\CAD\C3D\114541C110.dwg 5/16/20:

TIM LAMKIN JR.

10. NO. 47099

DATE 2/19/19



12224 NICOLLET AVENUE BURNSVILLE, MINNESOTA 55337 Phone: (952) 890-0509 Email: Burnsville@bolton-menk.com www.bolton-menk.com

0)0.1
ich melal
The Urban Hometown

ESIGNED	NO.	REVISION	DATE	
ZP/TL/SL	5	5	05/10/2019	
RAWN	7	\triangle	05/16/2019	Н
ZP/JW				
HECKED	\vdash			
TL/SL				
LIENT PROJ. NO.	1			
TAGALAS.	-			

CITY OF RICHFIELD, MINNESOTA

S.A.P. 157-363-032, LYNDALE AVENUE RECONSTRUCTION

STORM TABLE TABULATION

C1.04R

SHEET


STORM SEWER TABLE

										STRUCTU	JRES			CASTINGS			>	5		PIP	E						CONN	ECT	DF	RAINS TO			
STRUCT.	ROADWAY	STA	OFFSET	LT/RT	PROPOSED RIM	EFFLUENT INVERT ELEV.	STRUCT. BUILD	SPECIAL 2' X 3' CB	DESIGN H	48" 4020	48" 4022	60" 4020	72" 4020	F&I R-3067-V CASTING	F&I R-4340-B CASTING	F&I R-3067-C CASTING	F&I R-1733 CASTING	F&I R-2534 CASTING	12" STM PIPE	12" C900 PIPE	15" STM PIPE	18" STM PIPE	21" STM PIPE	24" STM PIPE	27" STM PIPE	30" STM PIPE	48" STM PIPE	TO EX STORM STRUCT.	TO EX STORM PIPE	STRUCT. NO	PIPE GRADE	INVERT ELEV	NOTES
			(FT)		(ELEV)	(FT)	(LF)	(EA)	(EA)	(EA)	(EA)	(EA)	(EA)	(EA)	(EA)	(EA)	(EA)	(EA)	(LF)	(LF)	(LF)	(LF)	(LF)	(LF)	(LF)	(LF)	(LF)	(EA)	(EA)		(%)		
																	(
CBMH 9A	LYNDALE	145+18.38'	25.85	LT	847.75	842.12	5.63	1									1	>			79								1	STMH 9	0.50%	841.72	
CB 9D	LYNDALE	145+18.92	10.88	RT	847.49	843.49	4.00	1						1					15											CBMH 9C	0.50%	843.42	
CBMH 9C	LYNDALE	145+20.21'	3.53	LT	847.71	843.32	4.39	1						1			(1	8											CBMH 9B	0.50%	843.28	
CBMH 9B	LYNDALE	145+20.59'	12.19	LT	848.01	843.18	4.83	1						1			\ \ \ \ \ \ \ \ \ \ \ \ \ \ \ \ \ \ \	\	14											CBMH 9A	0.50%	843.11	
STMH 9	LYNDALE	145+88.53'	55.38	LT	848.52	837.96	10.56						1				1 (<u> </u>	K														
EXSTMH 9	LYNDALE	146+05.22'	118.06	RT	847.00	840.04	6.96	<u> </u>									(1	/							174		1		STMH 9	0.48%	839.20	
CB 10B	LYNDALE	149+64.18	17.70	RT	846.03	842.52	3.51	1						1			\rightarrow	>	<u> </u>		35									CB 10A	0.60%	842.30	
CBMH 10A	LYNDALE	149+64.26	17.64	LT	846.04	842.20	3.84	.		1				1			(K		311									MH 10	0.60%	840.33	
CB 10F	LYNDALE	152+41.68	22.92	RT	845.54	841.54	4.00	1						1			(1	48										_	MH 10E	2.42%	840.39	
MH 10	LYNDALE	152+76.85'	23.75	LT	846.13	825.94	20.19	1	-				1	1			$ \rangle$		H) —								48		1	MH 10E	0.10%	826.00	-
MH 10E	LYNDALE	152+89.29'	23.62	RT	845.86	825.99	19.87	1	-				1				- (1	K											EXMH 10-1	0.13%	826.07	-
EXMH 10-1	LYNDALE	153+01.97'	76.10	RT	844.35	825.99	18.36	 	-								1	1) 		7.0							1			0.000	040	-
CB 10C	LYNDALE	153+47.23	23.42	LT	845.38	840.79	4.59	1						1			\ \ \\\\\\\\\\\\\\\\\\\\\\\\\\\\\\\\\\		1		70									MH 10	0.60%	840.37	
CBMH 10D		153+47.28'	23.92	RT	845.14	841.13	4.01	1						1			(48									CB 10C	0.50%	840.89	
CB 11C	LYNDALE	157.64.52	4.11	RT	845.16	840.88	4.28	1						1			7	>	L)		23									CB 11A	1.00%	840.65	
CB 11D	LYNDALE	157.64.54	23.45	RT	844.76	841.27	3.49	1						1			\	-	Κ		19									CB 11C	1.00%	841.08	
MH 11	LYNDALE	157+64.46'	44.19	LT	842.90	828.60	14.30			1				1			1 (1				
CB 11A	LYNDALE	157+64.49	18.89	LT	844.65	840.55	4.10	1						1			/	>	L)—	25										MH 11	8.85%	838.31	
MH 12C	LYNDALE	159+14.39'	56.12	LT	842.07	830.00	12.07							1			\	<u> </u>	K										1				
MH 12B	LYNDALE	159+16.83	43.32	LT	846.67	830.63	16.04							1			(1	 	20										MH 12C	4.59%	829.71	
STMH 12A	LYNDALE	159+29.58'	30.52	RT	845.67	839.74	5.93			1							1		<u> </u>			75							1	MH 12B	1.00%	838.86	
CB 12B	LYNDALE	159+39.65	86.17	RT	844.79	840.39	4.40	1						1			— (K		57									STMH 12A	0.97%	839.84	
CB 12C	LYNDALE	159+70.19	80.67	RT	844.83	840.83	4.00	1						1				1) 05		34									CB 12B	0.71%	840.59	
CB 12E	LYNDALE	160+47.13	18.69	LT	845.83	841.83	4.00	1						1			\rightarrow		35											CBMH 12D STMH 12A	1.00%	841.48	
CBMH 12D CB 13C	LYNDALE LYNDALE	160+48.09' 163+29.87	16.07	RT LT	846.19 848.48	841.38 844.77	4.81 3.71	1			1			1			(122 235											CBMH13A	1.26% 0.50%	839.84 843.59	
			25.15											1			(1															
CB 13B	LYNDALE	165+61.15	16.09	RT	849.38	845.38	4.00	1			- 1			1					34		100									CBMH 13A	0.50%	845.21	
CBMH 13A CB 13H	LYNDALE	165±61,19' 166+36,21	17.50 82.98	LT LT	849.43 848.70	843.49 844.96	5.93 3.74	$+ \sim$	\sim	1	\rightarrow	\sim	\sim	\\\\\\\\\\\\\\\\\\\\\\\\\\\\\\\\\\\\\\	\sim	\sim	\sim	1	49		108	\sim	\sim	STMH 13 CBMH 13G	0.50%	842.95 844.71	\sim						
STMH 13D1	LYNDALE	166+69.17	87.79	₩.	850.29	842.13	8.15			\\																$\overline{}$				CBIVIT 13G		044.71	
STMH 13D1	LYNDALE	166+69.37'	21.43	LT	850.51	842.82	7.69	-		1							1 /	\	Κ		40								1				
STMH 13D	LYNDALE	166+69.45'	21.45	RT	850.60	842.61	7.09	-		1							1 (\leftarrow		66									STMH13D1	0.72%	842.13	
CBMH 13G	LYNDALE	166+89.27'	83.29	LT	848.89	844.46	4.43	1		1				1			1	}	55		00									CBMH 13F	0.72%	844.35	
CBMH 13F	LYNDALE	167+03.50'	29.67	LT	849.80	843.00	6.80	1			1			1			<u> </u>		33		35								1	STMH 13	0.50%	842.82	
CB 13E	LYNDALE	167+03.50	35.58	RT	850.03	846.00	4.03	-			1			'			(37		33								1	STMH 13D	2.00%	845.26	
CBMH 13I	LYNDALE	167+96.34'	27.54	LT	849.37	843.41	5.96	1		1	'						1 /	}	93								-+		1	CBMH 13F	0.44%	843.00	
CB 13K	LYNDALE	168.31.60	31.75	RT	848.64	844.64	4.00	1		1							1 (<u> </u>	33		59								1	CBMH 13J		844.14	
CB 13K	LYNDALE	168+31.65'	26.84	LT	848.48	843.64	4.84	+ '		1				1			 	+	 		15				-+					CBMH 13F	0.66%	843.69	
CBMH 13L	LYNDALE	168+77.33	26.56	LT	848.62	843.87	4.84	+		1				1			$ \rangle$	 	46		13				-+				1	CBMH 13J	0.50%	843.70	
STMH 13M	LYNDALE	168+77.40'	26.56	RT	848.62 848.96	843.87	4.75	+	-	1				1			1	+	40	1									2	CBMH 13J	0.50%	843.70	-
CBMH 14A	LYNDALE		31.46	RT	847.68	843.76	+	1		1				1			 	+	 			123			-+				- 4	EXCB 14	0.50%	843.00	
CBMH 14A CB 14B	LYNDALE	170+26.02' 170+26.06	26.46	LT		843.76	3.92 3.52	1	-	-				1			 	 	\rightarrow	1	57	123						1		CBMH 14A	0.62%	843.00	-
	LYNDALE		20.55	D.T.	847.72			 									L (+	1		57							1		CDIVIT 14A	0.00%	043.00	1
		_ (() () ()	- 24 55	400	847.68	843.00	4.68				P -				\sim \sim			×		\sim					-			\sim	_		1	1 1	1







DESIGNED	NO.	REVISION	DATE	
ZP/TL/SL	1	Δ	03/15/19	
DRAWN	5	S	05/10/2019	
ZP/JW				
CHECKED	\vdash			
TL/SL	_			
CLIENT PROJ. NO.				
T1611/5/11				

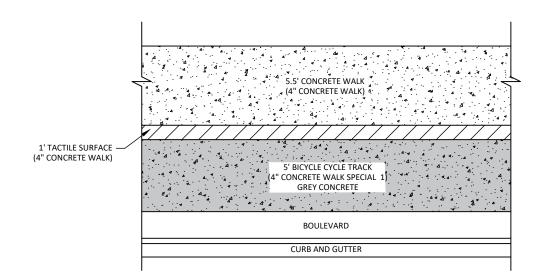


CYCLE TRACK DETAIL

NOT TO SCALE

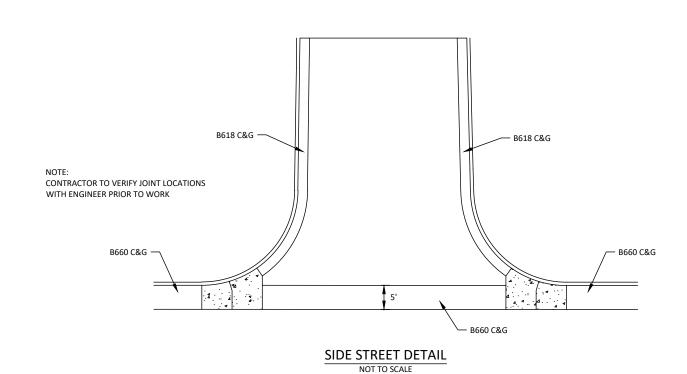

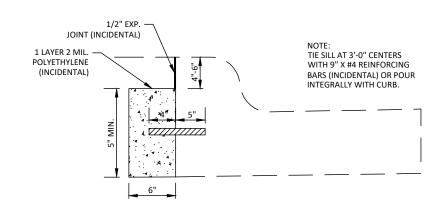

CONCRETE SILL DETAIL

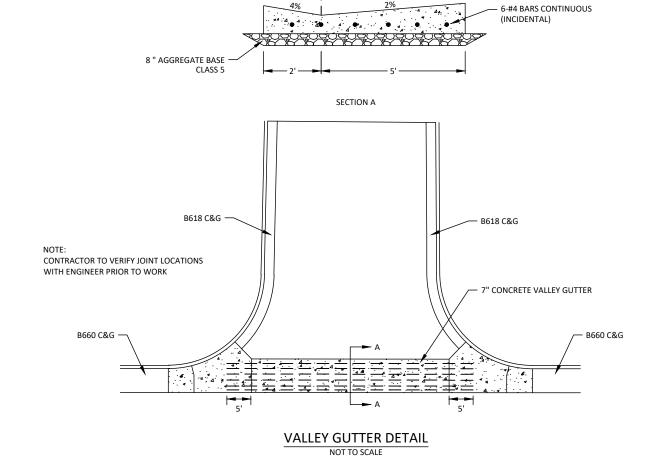






12224 NICOLLET AVENUE
BURNSVILLE, MINNESOTA 55337
Phone: (952) 890-0509
Email: Burnsville@bolton-menk.com
www.bolton-menk.com




DESIGNED	NO.	REVISION	DATE	OUT / OF BLOUELE B. AMAINES OF A
ZP/TL/SL				CITY OF RICHFIELD, MINNESOTA
DRAWN				
ZP/JW	-			S.A.P. 157-363-032. LYNDALE AVENUE RECONSTRUCTION
CHECKED	┶			0 157 555 552, E1115/12271 E1152 112501151115511511
TL/SL				
IL/3L	-			MAICCELL ANICOLIC DETAIL C
CLIENT PROJ. NO.				MISCELLANEOUS DETAILS
T1C11AFA1	1 =			


C1.06

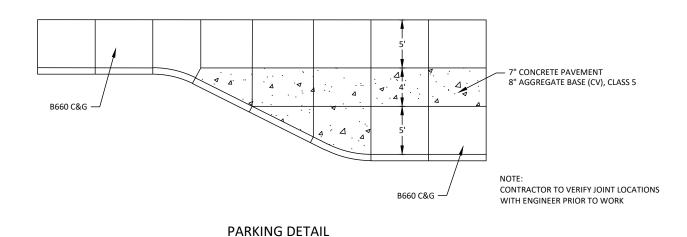

NOT TO SCALE

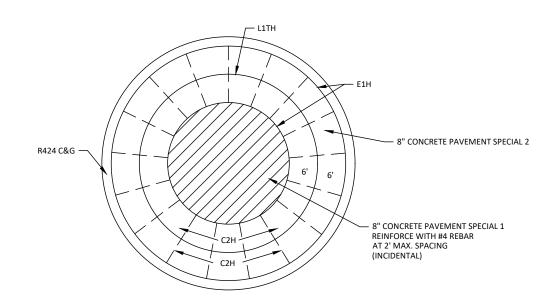

ROUNDABOUT ISLAND JOINTING DETAIL 8" NON-REINFORCED CONCRETE PAVEMENT NOT TO SCALE

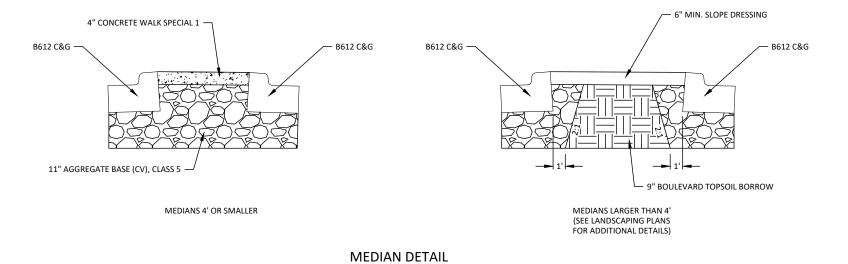

NOT TO SCALE

HEREBY CERTIFY THAT THIS PLAN, SPECIFICATION, OR REPORT WAS PREPARED BY ME OR UNDER MY DIRECT SUPERVISION AND THAT I AM A DULY LICENSED PROFESSIONAL ENGINEER UNDER THE LAWS OF THE STATE OF MINNESOTA.

TIM LAMKIN JR.


UC. NO. 47099 DATE 2/19/19






ESIGNED	NO.	REVISION	DATE	OITY OF DIGUESE
ZP/TL/SL				CITY OF RICHFIEL
RAWN				C A B 457 000 000 IVAIDALE
ZP/JW				S.A.P. 157-363-032, LYNDALE /
HECKED				
TL/SL	Н			14166511 1116
LIENT PROJ. NO.				MISCELLANEO
T16114541				

CONCRETE DRIVEWAY INSET

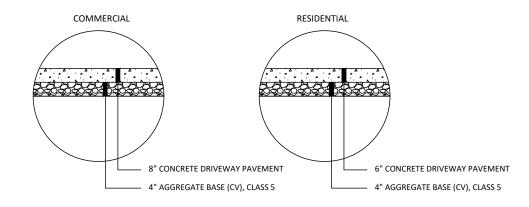

BITUMINOUS DRIVEWAY INSET

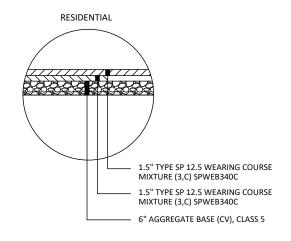

				DRI	VEWA	TAB	ULATI	ON (2)	_				
STATION	SIDE	CURB TYPE	E1	E2	L1	S1	E3	L2	S2	E4	L3	S3	E5	EXISTING
(1)	0122	001.5 1115			FT	ે લ		FT	용	1	FT	%	1 -	ે
]	LYNDALE	AVE S.	В.			I			1	
207+25	LEFT	DW CURB TYPE 2	846.80	846.97	3.33	12.1	847.37	8.0	1.5	847.49	4.5	11.3	848.00	3.9
207+56	RIGHT	DW CURB STANDARD	846.79	846.87	5.33	9.7	847.39	6.0	1.5	847.48	13	9.4	848.70	9.5
208+03	RIGHT	DW CURB STANDARD	847.00	847.08	5.33	9.7	847.60	6.0	1.5	847.69	13.5	9.9	849.02	7.8
208+11	LEFT	DW CURB TYPE 2	847.15	847.32	3.33	12.1	847.72	8.0	1.5	847.84	4.5	9.1	848.25	4.7
208+98	RIGHT	DW CURB STANDARD	847.47	847.55	5.33	9.7	848.07	6.0	1.5	848.16	8	6.2	848.66	8.6
209+15	LEFT	DW CURB TYPE 2	847.55	847.72	4.33	9.8	848.14	8.0	1.5	848.26	7.5	13.7	849.29	5.3
209+60	RIGHT	DW CURB STANDARD	847.71	847.79	5.33	9.7	848.31	6.0	1.5	848.4	7	2.6	848.58	6.5
209+80	LEFT	DW CURB TYPE 2	847.80	847.97	4.33	9.8	848.39	8.0	1.5	848.51	8	2.1	848.68	1.8
210+80	LEFT	DW CURB STANDARD	847.57	847.65	5.33	9.7	848.17	8.0	1.5	848.29	12	4.1	848.78	4.6
211+69	LEFT	DW CURB TYPE 2	847.08	847.25	13.33	4.5	847.85	8.0	1.5	847.97	6	7.5	848.42	3.2
214+24	LEFT	DW CURB STANDARD	847.31	847.39	5.33	9.7	847.91	8.0	1.5	848.03	9	4.2	848.41	5.3
215+36	LEFT	DW CURB STANDARD	847.54	847.62	5.33	9.7	848.14	8.0	1.5	848.26	21	-2.7	847.70	-2.0
216+15	LEFT	DW CURB STANDARD	847.37	847.45	5.33	9.7	847.97	8.0	1.5	848.09	21	-1.4	847.79	-0.5
216+58	RIGHT	DW CURB STANDARD	846.93	847.01	5.33	9.7	847.53	8.0	1.5	847.65	3	6.0	847.83	2.0
217+84	LEFT	DW CURB STANDARD	846.54	846.62	5.33	9.7	847.14	8.0	1.5	847.26	17	6.2	848.32	5.7
219+81	RIGHT	DW CURB STANDARD	845.77	845.85	25	9.0	848.11	-	-	-	-	-	-	-
220+17	RIGHT	DW CURB STANDARD	846.21	846.29	5.33	9.7	846.81	6.0	1.5	846.9	17	6.9	848.07	5.5
220+76	RIGHT	DW CURB STANDARD	846.59	846.67	6.33	8.5	847.21	6.0	1.5	847.3	7	8.4	847.89	7.3
221+37	RIGHT	DW CURB STANDARD	846.98	847.06	8.1	7.1	847.64	6.0	1.5	847.73	3	5.0	847.88	6.2
221+78	RIGHT	DW CURB STANDARD	847.25	847.33	7.25	7.8	847.90	6.0	1.5	847.99	6.5	5.5	848.35	12.2
222+62	LEFT	DW CURB STANDARD	847.77	847.85	5.33	9.7	848.37	8.0	1.5	848.49	8	0.7	848.55	1.9
223+30	LEFT	DW CURB STANDARD	847.49	847.57	5.33	9.7	848.09	8.0	1.5	848.21	11	3.0	848.54	3.2
223+63	LEFT	DW CURB STANDARD	847.33	847.41	5.33	9.7	847.93	8.0	1.5	848.05	19	5.1	849.02	3.2
224+48	LEFT	DW CURB STANDARD	846.91	846.99	5.33	9.7	847.51	8.0	1.5	847.63	21	4.8	848.64	3.5
227+10	LEFT	DW CURB STANDARD	846.03	846.11	8.33	5.5	846.57	8.0	1.5	846.69	16	7.1	847.82	5.4
228+24	LEFT	DW CURB TYPE 2	846.54	846.71	3.33	12.1	847.11	6.0	1.5	847.2	7	3.0	847.41	1.8
229+01	LEFT	DW CURB TYPE 2	846.91	847.08	3.33	12.1	847.48	6.0	1.5	847.57	18	1.4	847.83	2.2
229+68	LEFT	DW CURB STANDARD	847.11	847.19	5.33	9.7	847.71	8.0	1.5	847.83	10	1.4	847.97	2.5
230+31	LEFT	DW CURB STANDARD	847.12	847.20	5.33	9.7	847.72	8.0	1.5	847.84	20.5	0.0	847.85	0.5
231+33	LEFT	DW CURB STANDARD	846.74	846.82	5.33	9.7	847.34	8.0	1.5	847.46	4	-1.0	847.42	-2.0
231+82	LEFT	DW CURB STANDARD	846.50	846.58	5.33	9.7	847.10	8.0	1.5	847.22	10.5	7.3	847.99	-0.5
233+14	LEFT	DW CURB STANDARD	846.91	846.99	5.33	9.7	847.51	8.0	1.5	847.63	11	5.3	848.21	-1.5
233+72	LEFT	DW CURB STANDARD	847.52	847.60	5.33	9.7	848.12	8.0	1.5	848.24	16.7	4.4	848.97	1.2
234+86	RIGHT	DW CURB STANDARD	848.30	848.38	5.33	9.7	848.90	6.0	1.5	848.99	9	5.9	849.52	2.3
235+47	RIGHT	DW CURB STANDARD	848.99	849.07	5.33	9.7	849.59	6.0	1.5	849.68	25	-2.4	849.09	0.4
235+47	RIGHT		IN DRIVE				INTO EXIS			849.02	7	3.4	849.26	1 2 0
236+57	LEFT	DW CURB STANDARD	850.35	850.43	5.33	9.7	850.95	8.0	1.5	851.07	6.5	10.9	851.78	2.0
238+12	LEFT	DW CURB STANDARD	850.75	850.83	5.33	9.7	851.35	8.0	1.5	851.47	6.5	1.7	851.58	4.5
238+49	LEFT LEFT	DW CURB STANDARD DW CURB STANDARD	850.67	850.75 850.46	5.33	9.7	851.27	8.0	1.5	851.39	7	2.0		3.0
239+15	LEFT	DW CURB STANDARD	850.38	850.46	5.33	9.7	850.98	8.0	1.5	851.1 850.77	29	2.0	851.24 851.47	3.0
243+84	LEFT	DW CURB STANDARD	850.05	848.26	5.33	9.7	850.65	8.0	1.5	850.77	8	7.4	849.53	
255+83	RIGHT	DW CURB TYPE 2	848.18		7.33	7.6	848.82	8.0 6.0	1.5	848.94	17.5	1.4	849.53	3.2
256+78	RIGHT	DW CURB TYPE 2	845.67 845.20	845.84	3.33	12.1	846.24 845.77	6.0	1.5	845.86	3	3.0	845.95	12.5
257+33	RIGHT	DW CURB TYPE 2	844.94	845.11	3.33	12.1	845.51	6.0	1.5	845.6	1.5	4.0	845.66	
258+41	RIGHT	DW CURB TYPE 2	844.89	845.06	3.33	12.1	845.46	6.0	1.5	845.55	5	9.6	846.03	9.2
261+01	RIGHT	DW CURB TYPE 2	846.02	846.19	3.33	12.1	846.59	6.0	1.5	846.68	4	-4.8	846.49	-1.3
261+57	RIGHT	DW CURB TYPE 2	846.65	846.82	3.33	12.1	847.22	6.0	1.5	847.31	6	-5.0	847.01	1.3
262+15	RIGHT	DW CURB TYPE 2	847.31	847.48	3.33	12.1	847.88	6.0	1.5	847.97	6	1.7	848.07	-0.5
263+05	RIGHT	DW CURB TYPE 2	848.30	848.47	3.33	12.1	848.87	6.0	1.5	848.96	3	2.0	849.02	3.2
263+43	RIGHT	DW CURB TYPE 2	848.72	848.89	3.33	12.1	849.29	6.0	1.5	849.38	11.5	10.1	850.54	10.2
264+18	RIGHT	DW CURB TYPE 2	849.54	849.71	3.33	12.1	850.11	6.0	1.5	850.2	5	2.2	850.31	7.5
264+98	RIGHT	DW CURB TYPE 2	849.84	850.01	3.33	12.1	850.41	6.0	1.5	850.5	5	1.6	850.58	4.6
265+18	RIGHT	DW CURB TYPE 2	849.72	849.89	3.33	12.1	850.29	6.0	1.5	850.38	5	4.6	850.61	7.2
265+47	LEFT	DW CURB STANDARD	849.61	849.69	7.33	7.6	850.25	10.0	1.5	850.4	5	-6.0	850.10	0.5
	RIGHT	DW CURB TYPE 2	848.42	848.59	3.83	12.1	849.05	11.5	1.5	849.222	2	5.4	849.33	2.2
269+34			* 10 . 12		0.00		313.03			5	-	~	3.3.33	

- (1) STATION VALUE AT CENTERLINE OF DRIVEWAY
- (2) SEE MISCELLANEOUS DETAILS








DESIGNED	NO.	REVISION	DATE	CITY OF BIGUETE B. MAININESCOTA
ZP/TL/SL				CITY OF RICHFIELD, MINNESOTA
DRAWN				6 4 5 457 669 699 1/4/5 4/5/4/5 5/5/6/4/5 5/5/6/4/5
ZP/JW				S.A.P. 157-363-032, LYNDALE AVENUE RECONSTRUCTION
CHECKED				
TL/SL	_			ANGCELL ANEQUIC DETAILS
CLIENT PROJ. NO.				MISCELLANEOUS DETAILS
T16114541				

TACTILE SURFACE DETAILS


(NOT TO SCALE)

PERSPECTIVE VIEW

PLAN VIEW

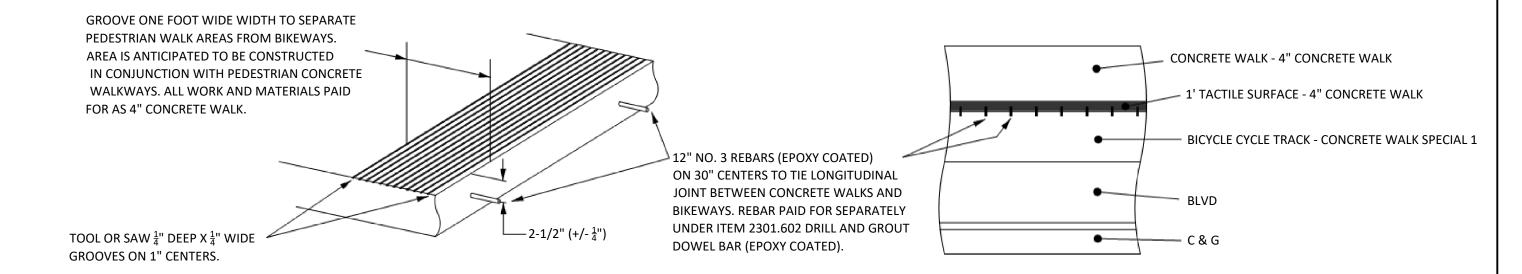


MEDIAN DETAIL

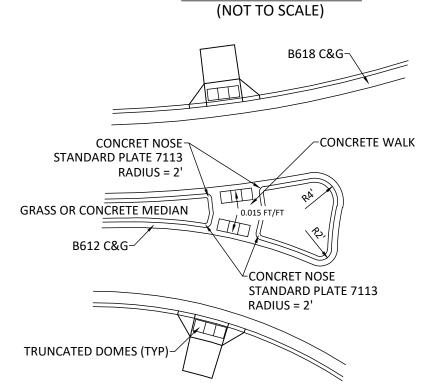





DESIGNED	NO.	REVISION	DATE	CITY OF RICHFIELD, MINNESOTA	SHEET
ZAP DRAWN	_			CITY OF RICHFIELD, MINNESOTA	SHEET
KME	_			S.A.P. 157-363-032, LYNDALE AVENUE RECONSTRUCTION	
CHECKED	ऻ_			·	(C1.09)
TL	_			MISCELLANEOUS	
CLIENT PROJ. NO.				DETAILS	
T16114541				DETAILS	

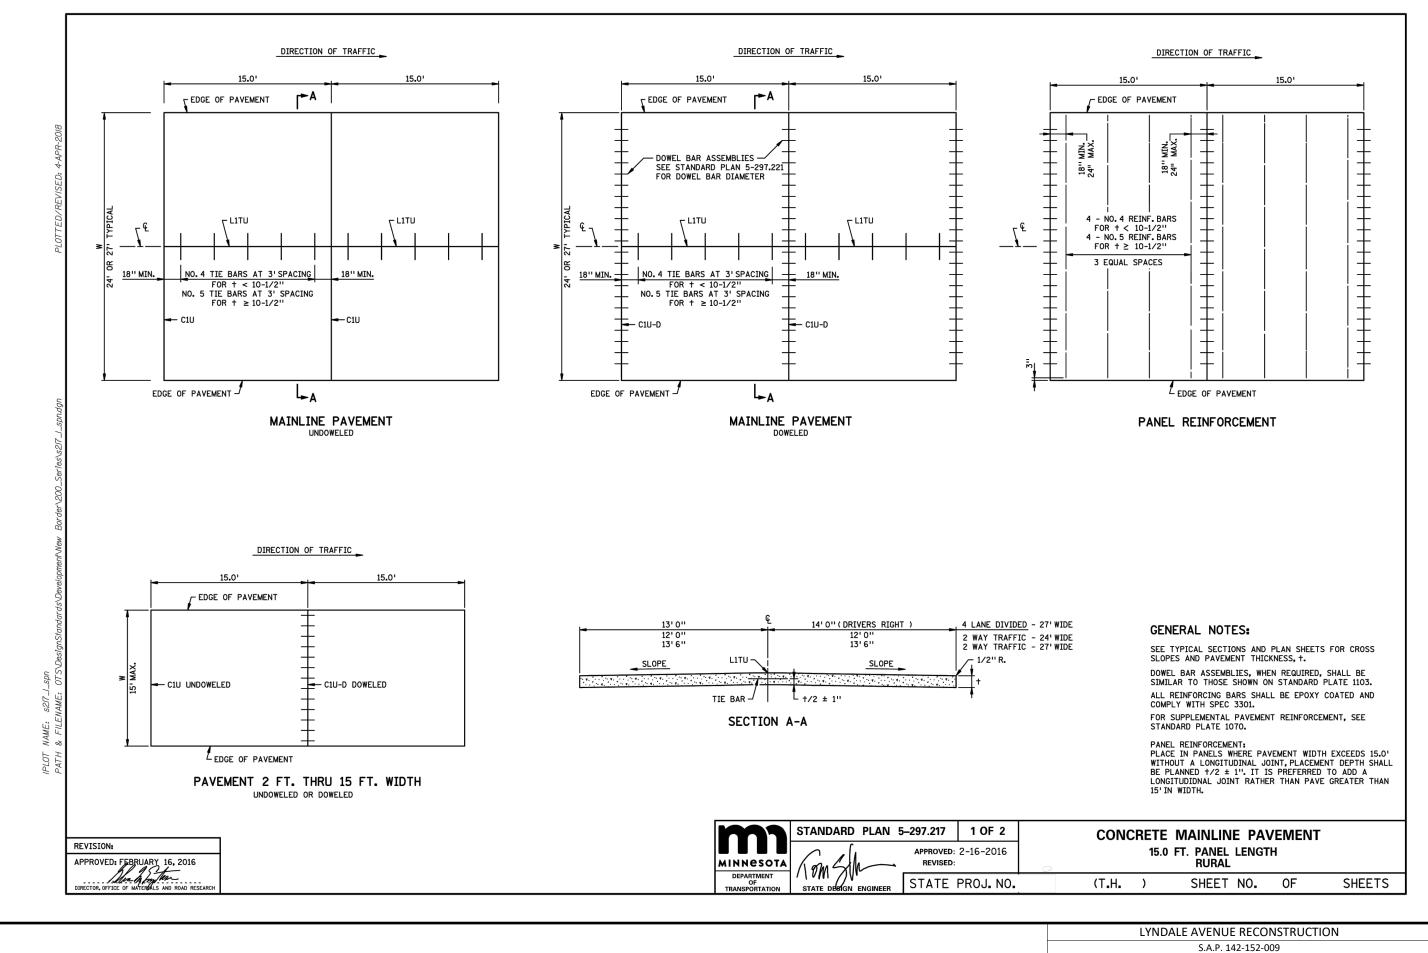

C1.10 MISCELLANEOUS

DETAILS

DIRECTION OF TRAFFIC _ 15.0' 15.01 r►B FEDGE OF PAVEMENT T L1TU, L2KTU, OR L2TU T L1TU, L2KTU, OR L2TU NO. 4 TIE BARS AT 3' SPACING FOR t < 10-1/2"
NO. 5 TIE BARS AT 3' SPACING FOR † ≥ 10-1/2" ┌ L1TU ┌ L1TU — DOWEL BAR ASSEMBLIES — SEE STANDARD PLAN 5-297.221
FOR DOWEL BAR DIAMETER EDGE OF PAVEMENT JMAINLINE PAVEMENT WITH INSIDE CONCRETE SHOULDER DOWELED 14'O"(DRIVERS RIGHT) CONCRETE SHOULDER 12' 0'' 13' 6'' 12' 0'' 13' 6'' L1TU. L1TU -SLOPE SLOPE OR L2TU L +/2 ± 1" SECTION B-B GENERAL NOTES: SEE TYPICAL SECTIONS AND PLAN SHEETS FOR CROSS SLOPES AND PAVEMENT THICKNESS, +.

DOWEL BAR ASSEMBLIES, WHEN REQUIRED, SHALL BE SIMILAR TO THOSE SHOWN ON STANDARD PLATE 1103. ALL REINFORCING BARS SHALL BE EPOXY COATED AND COMPLY WITH SPEC. 3301.

FOR SUPPLEMENTAL PAVEMENT REINFORCEMENT, SEE STANDARD PLATE 1070.

① CONTACT THE CONCRETE ENGINEER TO DISCUSS WHETHER TIE BARS AND SAWED JOINTS ARE NEEDED BASED ON CONCRETE SHOULDER WIDTH AND DEPTH.

4 LANE DIVIDED - 27' WIDE

2 WAY TRAFFIC - 24' WIDE 2 WAY TRAFFIC - 27' WIDE


∕- 1/2" R.

15.0' 15.0 EDGE OF PAVEMENT NO. 4 TIE BARS AT 3'SPACING FOR t < 10-1/2" NO. 5 TIE BARS AT 3' SPACING L2KTU OR L2TU ← L2KTU OR L2TU — DOWEL BAR ASSEMBLIES — SEE STANDARD PLAN 5-297.221 FOR DOWEL BAR DIAMETER C1U-D C1U-D EDGE OF PAVEMENT J


DIRECTION OF TRAFFIC _

MAINLINE PAVEMENT URBAN

DOWELED

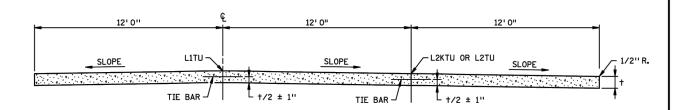

SECTION C-C

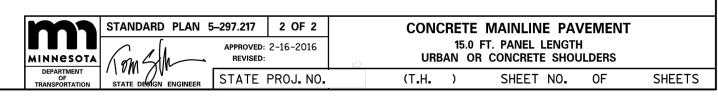


REVISION: APPROVED: FEBRUARY 16, 2016

Min. A for fer.

DIRECTOR, OFFICE OF MATERIALS AND ROAD RESE.

> LYNDALE AVENUE RECONSTRUCTION S.A.P. 142-152-009 C1.11 MISCELLANEOUS **DETAILS**

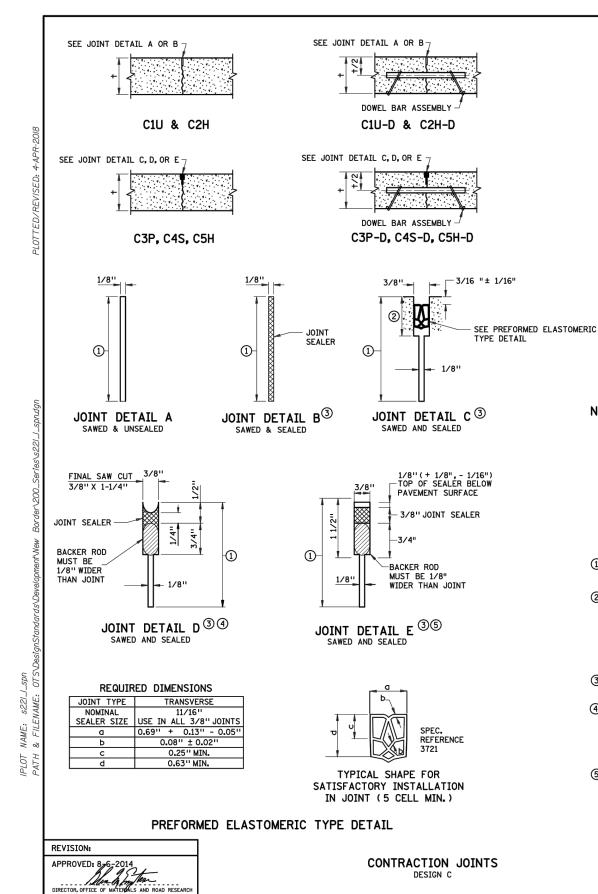

CONTRACTION JOINT REFERENCE. DETAIL & SEALER SPEC. TABLE

JOINT RE WITHOUT DOWELS	FERENCE WITH DOWELS	JOINT DETAIL	JOINT SEALER SPEC.	JOINT WIDTH
			UNICEALED	1 /011
C1U	C1U-D	A	UNSEALED	1/8"
C2H	C2H-D	В	3725	1/8"
C3P	C3P-D	С	3721	3/8"
C4S	C4S-D	D	3722	3/8"
C5H	C5H-D	E	3725	3/8"
NO. = U = H = P = S =	LEGEN CONTRACT JOINT REF UNSEALED HOT POUR PREFORME SILICONE DOWEL BA	TON JOIN FERENCE -	EXAMP T — C2H-C	

DOWEL BAR DIAMETER TABLE

PAVEMENT THICKNESS †	DOWEL BAR DIAMETER			
LESS THAN 6"	NONE			
6" - 6 1/2"	1" OR NONE			
7" - 7 1/2"	1"			
8" - 10"	1 1/4"			
10 1/2" AND GREATER	1 1/2"			

NOTES:

SEE STANDARD PLATE 1103 FOR DOWEL BAR ASSEMBLY.

SEE STANDARD PLATE 1150 FOR CONSTRUCTION OF HEADER JOINTS.


JOINT WIDTH TOLERANCE IS + 1/16" TO - 1/32"

FURNISH AND INSTALL ALL JOINT SEALER IN ACCORDANCE WITH THE MANUFACTURER'S RECOMMENDATIONS. SEE STANDARD PLANS 5-297.217 AND 5-297.219,

FOR CONCRETE MAINLINE/RAMP PAVEMENT. SEE PAVING LAYOUTS IN THE PLANS FOR JOINT

CLASS DESIGNATION TO BE USED AND SPECIAL REINFORCEMENT REQUIRED.


- ① JOINT DEPTH SHALL BE: FOR CONCRETE OVERLAYS 1/3 THE PAVEMENT THICKNESS FOR CONCRETE PAVEMENT 1/4 THE PAVEMENT THICKNESS
- ②SEE CONTRACTION JOINT SEALER DETAIL. WHEN USING PREFORMED JOINT SEALER, THE DEPTH SHALL BE 1/4" MORE THAN THE PREFORMED SEALER, WHEN COMPRESSED. TO FIT THE JOINT DESIGN WIDTH. "a" DIMENSION SHALL APPLY AT ANY POINT THROUGHOUT "c" DEPTH. SHARP INTERNAL CORNERS WILL NOT BE PERMITTED. ALL CORNERS SHALL BE PROVIDED WITH SUITABLE FILLET.
- (3) WHEN SEALING, THE JOINT FACES SHALL BE CLEANED AND DRIED BY SANDBLASTING AND AIR BLASTING.
- (4) PRIOR TO SEALING THE JOINT, A 1/2" DIA. CLOSED CELL BACKER ROD SHALL BE PLACED SUCH THAT THE TOP OF THE BACKER ROD IS 1/2"BELOW THE SURFACE OF THE PAVEMENT. NON SELF-LEVELING SILICONE SHALL BE TOOLED INTO THE JOINT MAINTAINING A SEAL AND BEAD THICKNESS OF 1/4".
- (5) PRIOR TO SEALING THE JOINT, A 1/2" DIA. CLOSED CELL BACKER ROD CAPABLE OF WITHSTANDING SEALANT TEMPERATURES OF 400 DEGREES F. SHALL BE PLACED 1/2" BELOW THE TOP OF PAVEMENT.

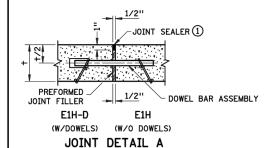



EXPANSION JOINT REFERENCE. DETAIL & SEALER SPEC. TABLE

JOINT RE	FERENCE	JOINT	JOINT	JOINT
WITHOUT DOWELS	WITH DOWELS	DETAIL	SEALER SPEC.	WIDTH
E1H	E1H-D	Α	3725	1/2"
E2H	E2H-D	В	3725	1"
E4H		С	3725	2"
	E4H-D	D	3725	2"
E8H		STANDARD PLAN 5- 297.229	3725	4"



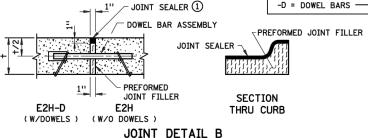


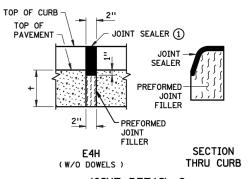

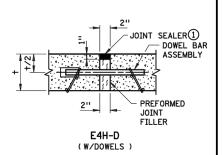

JOINT DETAIL D

JOINT DETAIL C

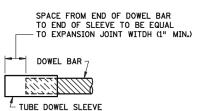

NOTES:

PREFORMED JOINT FILLER MATERIAL, SPEC. 3702.

FOR DOWEL BAR ASSEMBLY, SEE STANDARD PLATE 1103.

1 JOINT SEALER SPEC, 3725. THE JOINT FACES SHALL BE CLEANED AND DRIED BY SANDBLASTING AND AIR BLASTING. TOP OF SEALER, FLUSH TO 1/8" BELOW TOP OF PAVEMENT SURFACE, MAKE TOP OF SEALER FOR CURB SECTION D JOINTS FLUSH WITH SURFACE ±1/8".

1 OF 2

STANDARD PLAN 5-297.221

DOWEL BAR


SLEEVE DETAIL

PAVEMENT JOINTS

CONTRACTION (DESIGN C) AND EXPANSION (DESIGN E)

APPROVED: 8-6-2014 MINNESOTA REVISED: lutytu STATE PROJ. NO. (T.H. SHEET NO. 0F SHEETS STATE DESIGN ENGINEER

> LYNDALE AVENUE RECONSTRUCTION S.A.P. 142-152-009 C1.12 **MISCELLANEOUS DETAILS**

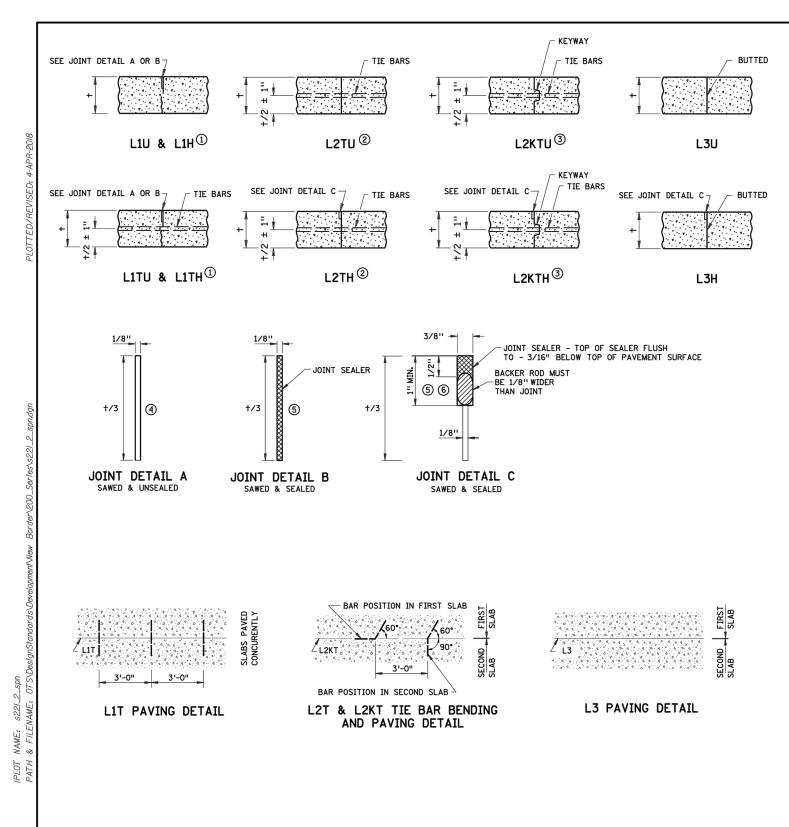


TIEBAR TABLE

PAVEMENT THICKNESS	TIEBAR SIZE	LENGTH
< 10-1/2"	NO. 4	30"
≥10-1/2"	NO. 5	36"
ALL THICKNESS WHEN TYING TO CURB AND GUTTER	NO. 4	30"

THE TIE BAR SPACING FOR ALL L2T AND L2KT JOINTS SHALL BE 3'-O" CENTER TO CENTER AND BENT 60° AS SHOWN, EXCEPT WHEN NOTED OTHERWISE IN THE PLANS.

TIE BARS IN THE L2T AND L2KT JOINTS SHALL BE THE SAME SIZE AND LENGTH AS USED FOR THE LIT JOINTS, WHEN TYING PAVEMENT TO PAVEMENT. TIE BARS IN THE L2KT JOINTS SHALL BE NO. 4 X 2' - 6", WHEN TYING CURB & GUTTER TO PAVEMENT.

ALL TIE BARS SHALL BE EPOXY COATED AND COMPLY WITH SPEC. 3301.

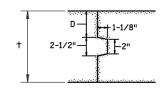

PAVEMENT KEYWAY DETAIL

KEYWAY DIMENSION TABLE

+	D
PAVEMENT THICKNESS	(TOLERANCE ± 1/4")
< 7"	NO KEYWAY
7" T0 7-1/2"	3"
8" TO 10"	4"
≥ 10-1/2"	5"

KEYWAY (1-1/8" \times 2" \times 2-1/2") MAY BE FORMED WITH MOLD OR METAL FORM. OTHER APPROVED KEYWAY SHAPES GIVING EQUIVALENT CONSTRUCTION FEATURES MAY BE USED WITH APPROVAL OF THE ENGINEER.

LONGITUDINAL JOINT REFERENCE, DETAIL & SEALER SPECIFICATION TABLE

J	OINT REFE	RENCE	JOINT	JOINT	JOINT	
WITHOUT TIE BARS	WITH TIE BARS	WITH KEYWAY & TIE BARS	DETAIL	SEALER SPEC	WIDTH	
L1U	L1TU		Α	UNSEALED	1/8"	
L1H	L1TH		В	3725	1/8"	
	L2TU	L2KTU	NONE	UNSEALED		
	L2TH	L2KTH	С	3725	3/8"	
L3U			NONE	UNSEALED		
L3H			С	3725	3/8"	

LEGEND	EXAMPLE
L = LONGITUDINAL JOINT	— L2KTH
NO. = JOINT REFERENCE	1111
1 = PAVED CONSTRUCTION JOINT	
2 = TIED/KEYED CONSTRUCTION JOINT	
3 = BUTTED CONSTRUCTION JOINT ☐	
K = KEYWAY	———————————————————————————————————————
T = TIE BARS	
U = UNSEALED	
H = HOT POURED —	

NOTES:

NORMALLY, TIED PAVEMENT WIDTHS SHALL NOT EXCEED FOUR LANES, EXCEPT BRIDGE APPROACH PANELS AND PAVEMENT TAPERS.

JOINT WIDTH TOLERANCE IS + 1/16 IN. TO - 1/32 IN.

FURNISH AND INSTALL ALL JOINT SEALER IN ACCORDANCE WITH THE MANUFACTURER'S RECOMMENDATIONS.

TIED/KEYED AND BUTTED CONSTRUCTION JOINTS SHALL BE UNSEALED EXCEPT AS OTHERWISE NOTED IN THE PLAN OR REQUIRED BY THE ENGINEER.

SEE STANDARD PLANS 5-297.217 AND 5-297.219 FOR CONCRETE MAINLINE AND RAMP PAVEMENT.

SEE PAVING LAYOUTS IN THE PLANS FOR JOINT CLASS DESIGNATIONS TO BE USED AND SPECIAL REINFORCEMENT REQUIRED.

WHEN CURB AND GUTTER IS PLACED ADJACENT TO CONCRETE MAINLINE, THE TIEBARS SHALL BE PLACED A MINIMUM OF 2" ABOVE THE CURB AND GUTTER GRADE.

- 1 SEE THE LONGITUDINAL JOINT REFERENCE, DETAIL & SEALER SPECIFICATION TABLE TO DETERMINE JOINT DETAIL.
- ② CONCRETE PAVEMENTS LESS THAN 7" SHALL USE L2TU AND L2TH JOINTS UNLESS OTHERWISE ALLOWED BY THE ENGINEER.
- (3) CONCRETE PAVEMENTS GREATER THAN OR EQUAL TO 7" SHALL USE L2KTU AND L2KTH JOINTS UNLESS OTHERWISE ALLOWED BY
- 4 THE JOINT FACES SHALL BE CLEANED WITH WATER DURING THE SAW CUTTING OPERATION OR BY WATER BLASTING AFTER SAWING.
- (5) THE JOINT FACES SHALL BE CLEANED AND DRIED BY SANDBLASTING AND AIR BLASTING.
- (6) PRIOR TO SEALING THE JOINT, A 1/2" DIAMETER CLOSED CELL BACKER ROD CAPABLE OF WITHSTANDING SEALANT TEMPERATURES OF 400 DEGREES F. SHALL BE PLACED 1/2" BELOW THE TOP OF THE PAVEMENT.

PAVEMENT JOINTS



STANDARD PLAN 5-297.221 STATE DESIGN ENGINEER

2 OF 2 APPROVED: 8-6-2014 REVISED:

STATE PROJ. NO.

(T.H.

LONGITUDINAL (DESIGN L) SHEET NO.

SHEETS

LYNDALE AVENUE RECONSTRUCTION S.A.P. 142-152-009 C1.13 **MISCELLANEOUS DETAILS**


OF

REVISION:

APPROVED: 8-6-2014


Min-la my few


DIRECTOR, OFFICE OF MATERIALS AND ROAD RESEAR

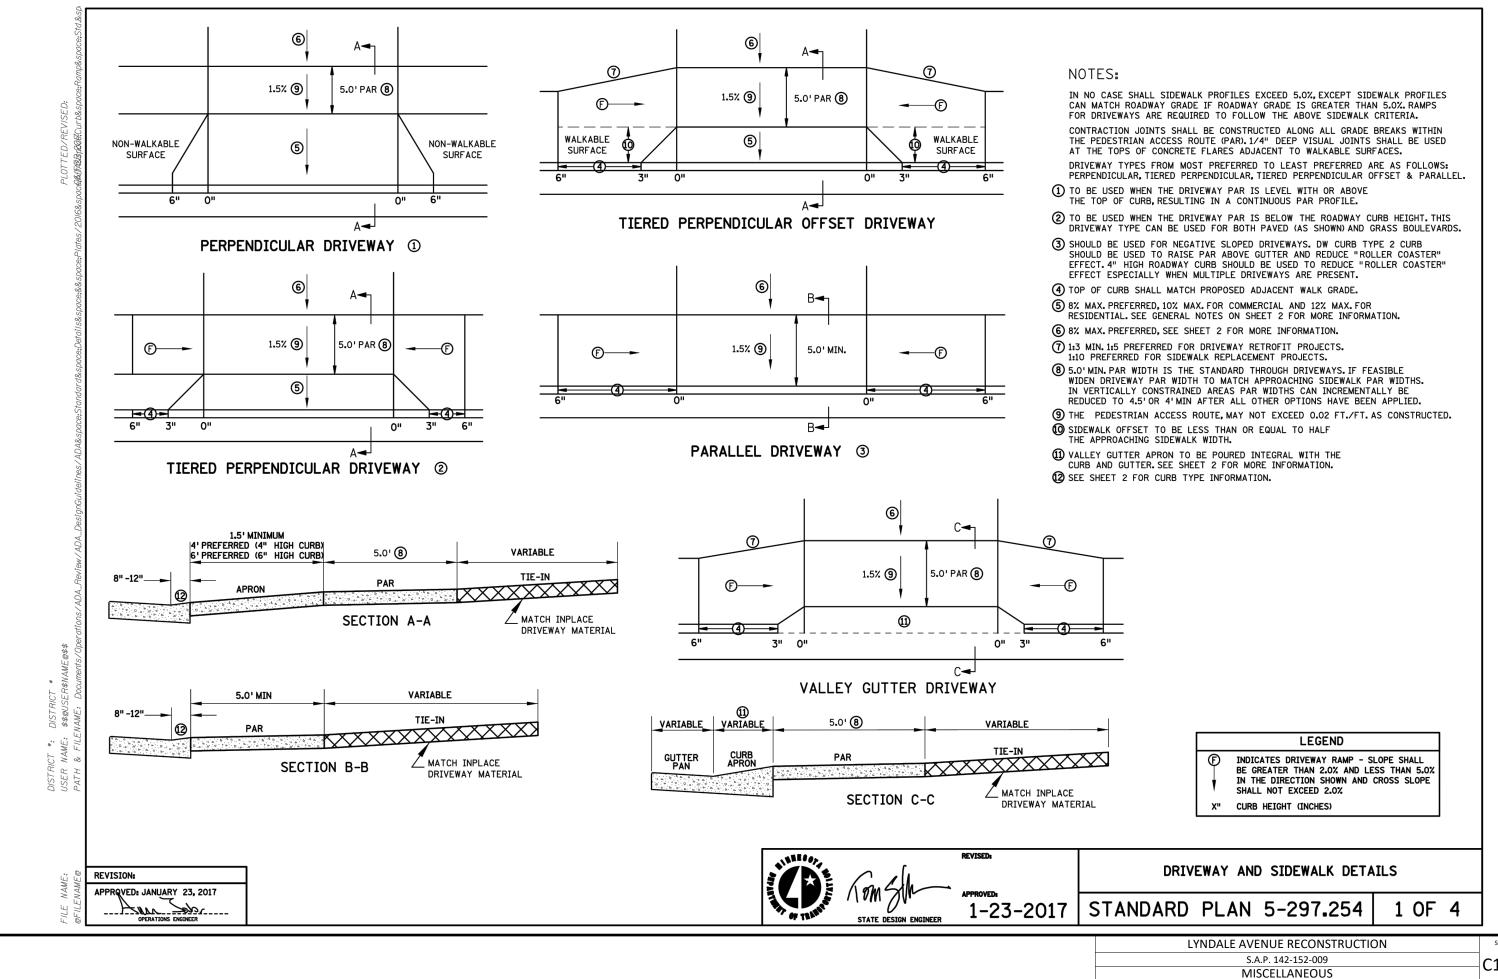

DETAILS

C1.14

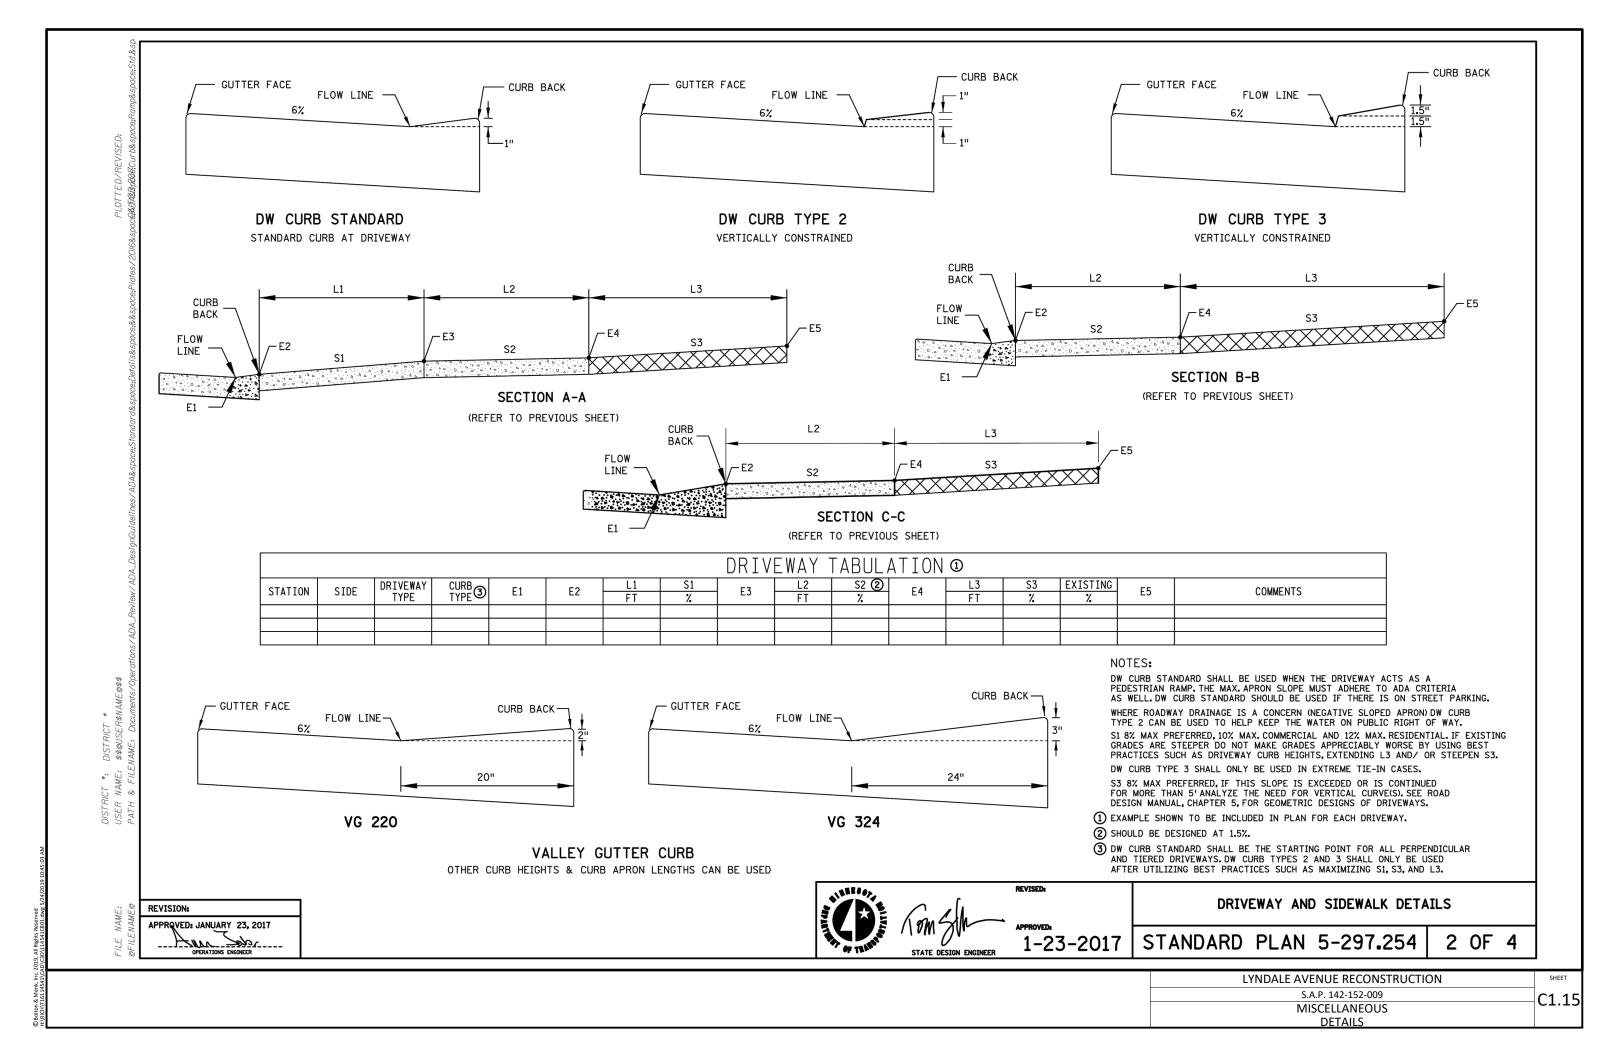

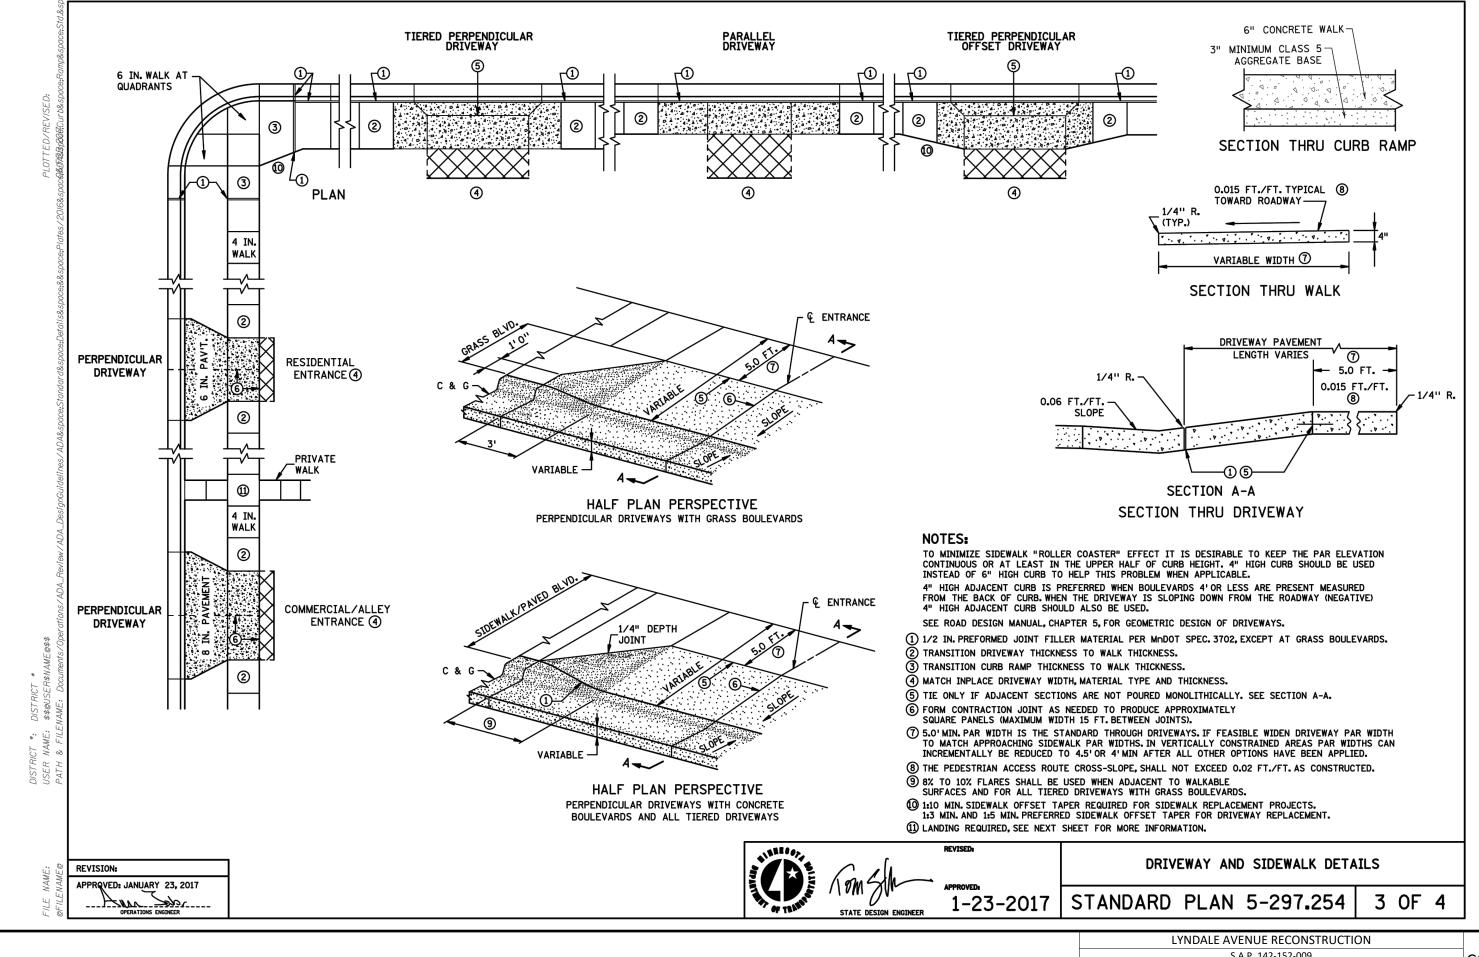


LYNDALE AVENUE RECONSTRUCTION

S.A.P. 142-152-009

MISCELLANEOUS
DETAILS


SHEET

C1.16

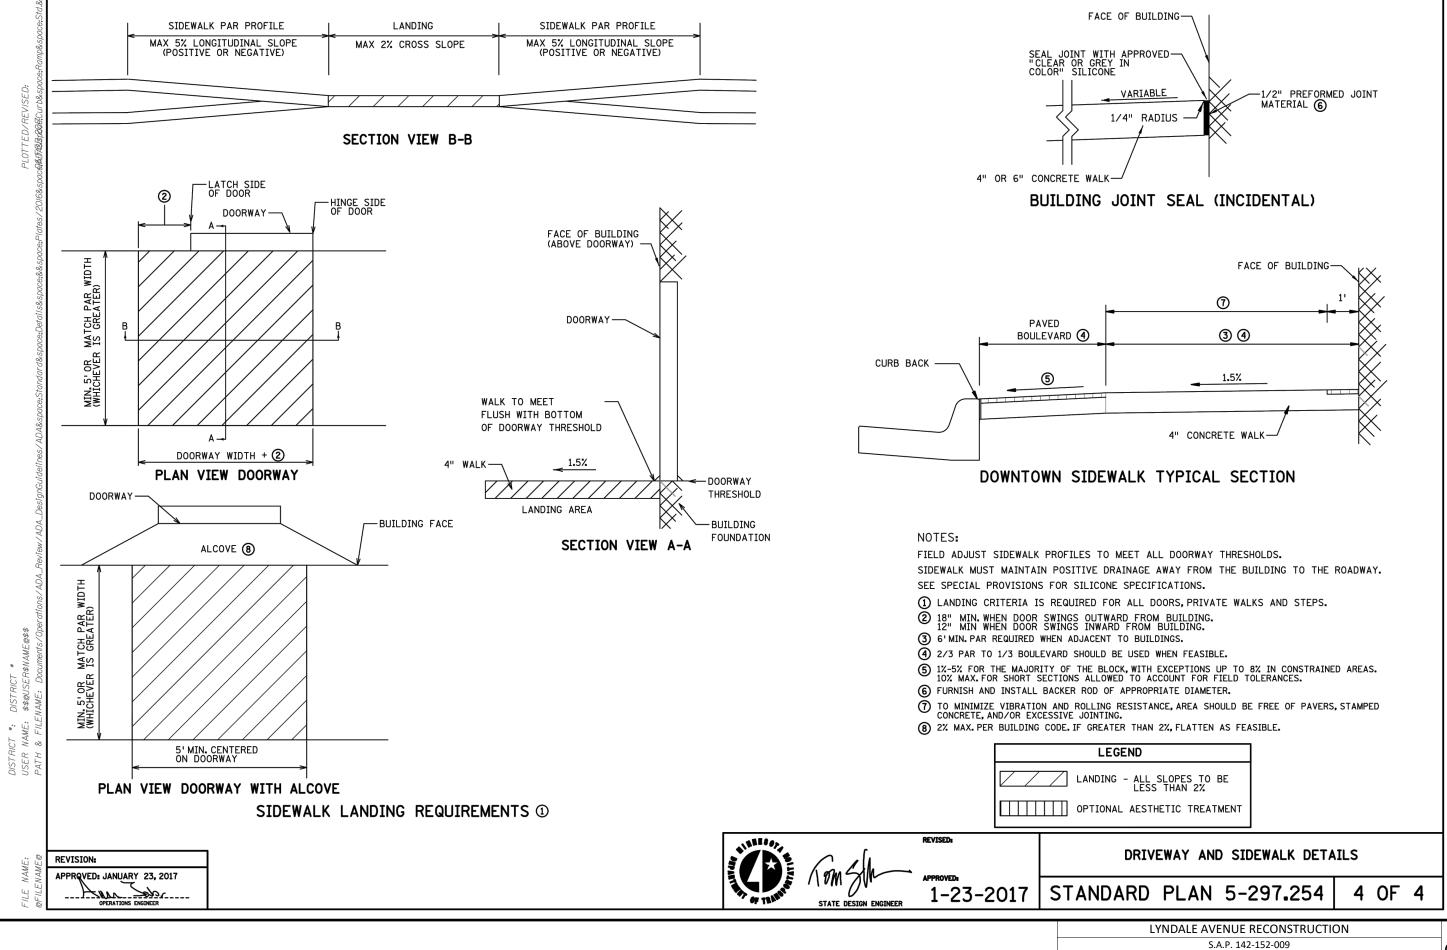

____C1.17

MISCELLANEOUS DETAILS

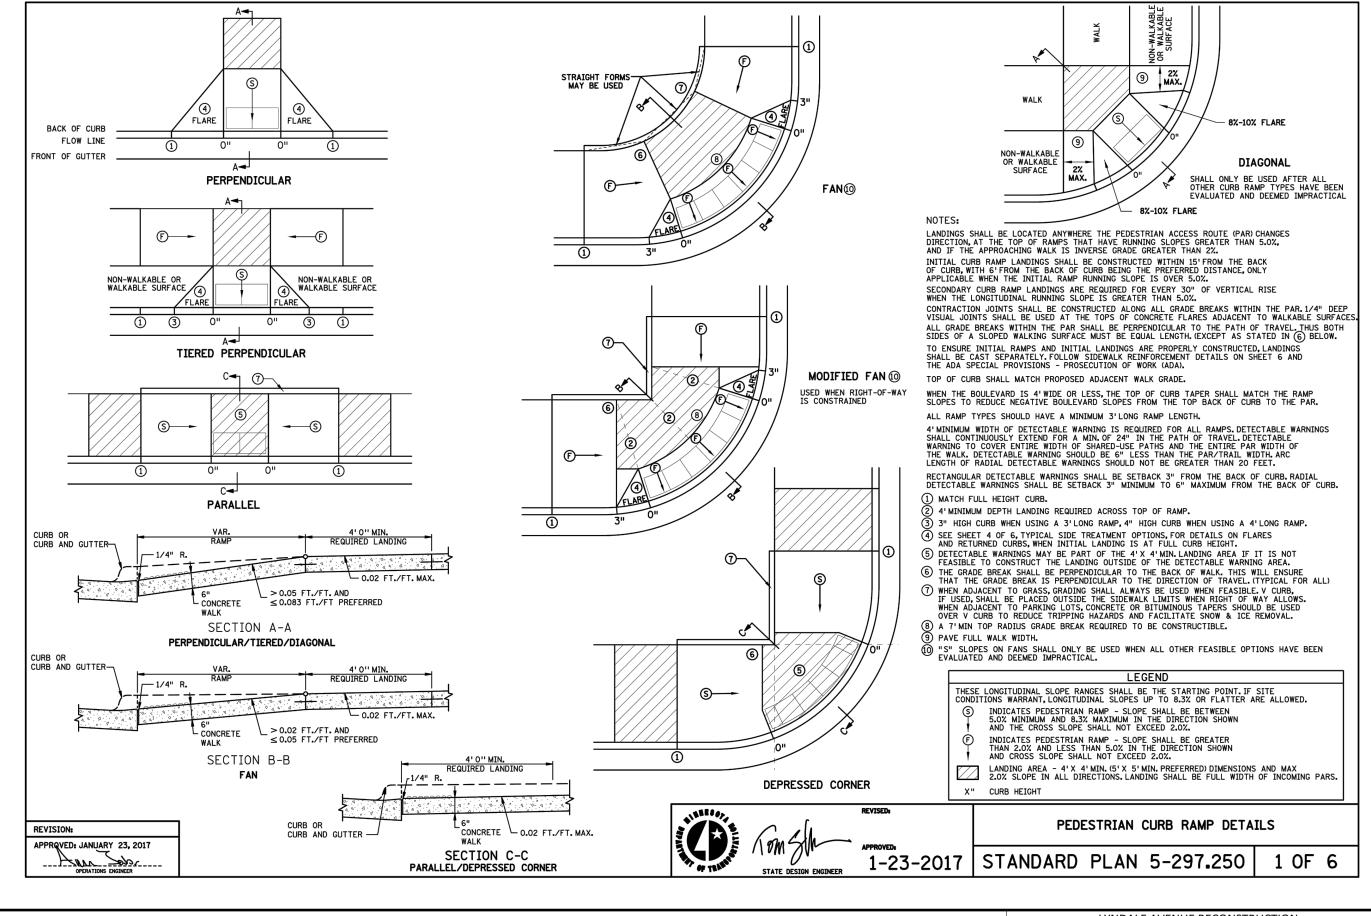

LYNDALE AVENUE RECONSTRUCTION


S.A.P. 142-152-009

MISCELLANEOUS
DETAILS

SHEET

C1.18

© Bolton & Menk, Inc. 2019, All Rights Reserver

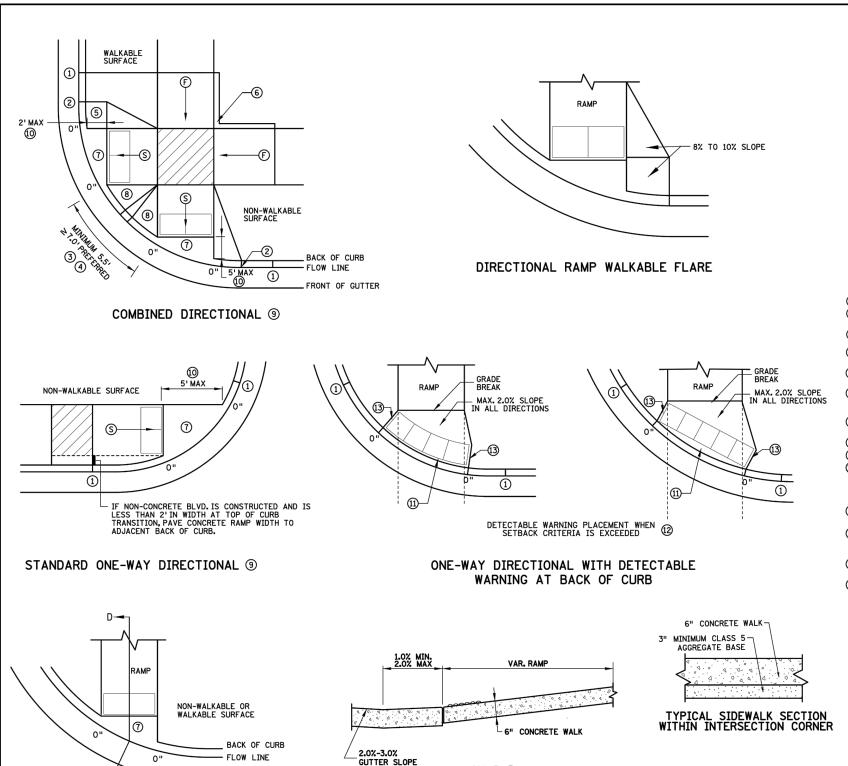

SECTION D-D

FRONT OF GUTTER

CURB FOR DIRECTIONAL RAMPS (9)

LANDINGS SHALL BE LOCATED ANYWHERE THE PEDESTRIAN ACCESS ROUTE (PAR) CHANGES DIRECTION, AT THE TOP OF RAMPS THAT HAVE RUNNING SLOPES GREATER THAN 5.0%, AND IF THE APPROACHING WALK IS INVERSE GRADE.

INITIAL CURB RAMP LANDINGS SHALL BE CONSTRUCTED WITHIN 15'FROM THE BACK OF CURB, WITH 6'FROM THE BACK OF CURB BEING THE PREFERRED DISTANCE, ONLY APPLICABLE WHEN THE INITIAL RAMP RUNNING SLOPE IS OVER 5.0%.

SECONDARY CURB RAMP LANDINGS ARE REQUIRED FOR EVERY 30" OF VERTICAL RISE WHEN THE LONGITUDINAL SLOPE IS GREATER THAN 5.0%.

CONTRACTION JOINTS SHALL BE CONSTRUCTED ALONG ALL GRADE BREAKS WITHIN THE PAR. 1/4" DEEP VISUAL JOINTS SHALL BE USED AT THE TOP GRADE BREAK OF CONCRETE FLARES ADJACENT TO WALKABLE SURFACES.

ALL GRADE BREAKS WITHIN THE PAR SHALL BE PERPENDICULAR TO THE PATH OF TRAVEL. THUS BOTH SIDES OF A SLOPED WALKING SURFACE MUST BE EQUAL LENGTH.

TO ENSURE INITIAL RAMPS AND INITIAL LANDINGS ARE PROPERLY CONSTRUCTED, LANDINGS SHALL BE CAST SEPARATELY. FOLLOW SIDEWALK REINFORCEMENT DETAILS ON SHEET 6 AND THE ADA SPECIAL PROVISION (PROSECUTION OF WORK).

TOP OF CURB SHALL MATCH PROPOSED ADJACENT WALK GRADE.

WHEN THE BOULEVARD IS 4'WIDE OR LESS, THE TOP OF CURB TAPER SHALL MATCH THE RAMP SLOPES TO REDUCE NEGATIVE BOULEVARD SLOPES FROM THE TOP BACK OF CURB TO THE PAR.

ALL RAMP TYPES SHOULD HAVE A MINIMUM 3'LONG RAMP LENGTH.

4'MINIMUM WIDTH OF DETECTABLE WARNING IS REQUIRED FOR ALL RAMPS. DETECTABLE WARNINGS SHALL CONTINUOUSLY EXTEND FOR A MIN. OF 24" IN THE PATH OF TRAVEL. DETECTABLE WARNING TO COVER ENTIRE WIDTH OF SHARED-USE PATH AND THE ENTIRE PAR WIDTH OF THE WALK. DETECTABLE WARNING SHOULD BE 6" LESS THAN THE PAR/PATH WIDTH. ARC LENGTH OF RADIAL DETECTABLE WARNINGS SHOULD NOT BE GREATER THAN 20 FEET.

RADIAL DETECTABLE WARNINGS SHALL BE SETBACK 3" MINIMUM TO 6" MAXIMUM FROM THE BACK OF CURB. SEE NOTES \bigodot & \bigodot FOR INFORMATION REGARDING RECTANGULAR DETECTABLE WARNING PLACEMENT.

- 1 MATCH FULL CURB HEIGHT.
- 3" HIGH CURB WHEN USING A 3'LONG RAMP 4" HIGH CURB WHEN USING A 4'LONG RAMP.
- (3) 3" MINIMUM CURB HEIGHT (5.5' MIN. DISTANCE REQUIRED BETWEEN DOMES)
 4" PREFERRED (7' MIN. DISTANCE REQUIRED BETWEEN DOMES).
- 4 THE "BUMP" IN BETWEEN THE RAMPS SHOULD NOT BE IN THE PATH OF TRAVEL FOR COMBINED DIRECTIONAL RAMPS. IF THIS OCCURS MODIFY THE RAMP LOCATION OR SWITCH RAMP TO A FAN/DEPRESSED CORNER.
- (5) WHEN USING CONCRETE PAVED FLARES ON THE OUTSIDE OF DIRECTIONAL RAMPS, AND ADJACENT TO A WALKABLE SURFACE, DIRECTIONAL RAMP FLARES SHOULD BE USED. SEE THE DETAIL ON THIS SHEET.
- (6) GRADING SHALL ALWAYS BE USED WHEN FEASIBLE. V CURB, IF USED, SHALL BE PLACED OUTSIDE THE SIDEWALK LIMITS WHEN RIGHT OF WAY ALLOWS. WHEN ADJACENT TO PARKING LOTS, CONCRETE OR BITUMINOUS TAPERS SHOULD BE USED OVER V CURB TO REDUCE TRIPPING HAZARDS AND FACILITATE SNOW & ICE REMOVAL.
- \bigcirc MAX. 2.0% SLOPE IN ALL DIRECTIONS IN FRONT OF GRADE BREAK AND DRAIN TO FLOW LINE. SHALL BE CONSTRUCTED INTEGRAL WITH CURB AND GUTTER.
- (8) 8% TO 10% WALKABLE FLARE.
- (9) PLACE DOMES AT THE BACK OF CURB WHEN ALLOWABLE SETBACK CRITERIA IS EXCEEDED.
- (I) FRONT EDGE OF DETECTABLE WARNING SHALL BE SET BACK 2' MAXIMUM WHEN ADJACENT TO WALKABLE SURFACE, AND 5' MAXIMUM WHEN ADJACENT TO NON-WALKABLE SURFACE WITH ONE CORNER SET 3" FROM BACK OF CURB. A WALKABLE SURFACE IS DEFINED AS A PAVED SURFACE ADJACENT TO A CURB RAMP WITHOUT RAISED OBSTACLES THAT COULD MISTAKENLY BE TRAVERSED BY A USER WHO IS VISUALLY
- (1) RECTANGULAR DETECTABLE WARNINGS MAY BE SETBACK UP TO 9" FROM THE BACK OF CURB WITH CORNERS SET 3" FROM BACK OF CURB. IF 9" SETBACK IS EXCEEDED USE RADIAL DETECTABLE WARNINGS.
- (2) FOR DIRECTIONAL RAMPS WITH THE DETECTABLE WARNINGS PLACED AT THE BACK OF CURB, THE DETECTABLE WARNINGS SHALL COVER THE ENTIRE WIDTH OF THE WALK/PATH. THIS ENSURES A DETECTABLE EDGE AND HELPS ELIMINATE THE CURB TAPER OBSTRUCTING THE PATH OF PEDESTRIAN TRAVEL.
- (3) THE CONCRETE WALK SHALL BE FORMED AND CONSTRUCTED PERPENDICULAR TO THE BACK OF CURB. MAINTAIN 3" BETWEEN EDGE OF DOMES AND EDGE OF CONCRETE.
- (4) TO BE USED FOR ALL DIRECTIONAL RAMPS, EXCEPT WHERE DOMES ARE PLACED ALONG THE BACK OF CURB.

LEGEND

THESE LONGITUDINAL SLOPE RANGES SHALL BE THE STARTING POINT. IF SITE CONDITIONS WARRANT, LONGITUDINAL SLOPES UP TO 8.3% OR FLATTER ARE ALLOWED.

- INDICATES PEDESTRIAN RAMP SLOPE SHALL BE BETWEEN 5.0% MINIMUM AND 8.3% MAXIMUM IN THE DIRECTION SHOWN AND THE CROSS SLOPE SHALL NOT EXCEED 2.0%.
- INDICATES PEDESTRIAN RAMP SLOPE SHALL BE GREATER THAN 2.0% AND LESS THAN 5.0% IN THE DIRECTION SHOWN AND CROSS SLOPE SHALL NOT EXCEED 2.0%.
- LANDING AREA 4'X 4'MIN. (5'X 5'MIN. PREFERRED) DIMENSIONS AND MAX 2.0% SLOPE IN ALL DIRECTIONS. LANDING SHALL BE FULL WIDTH OF INCOMING PARS.

X" CURB HEIGHT



PEDESTRIAN CURB RAMP DETAILS

STANDARD PLAN 5-297.250 2 OF 6

> LYNDALE AVENUE RECONSTRUCTION S.A.P. 142-152-009

> > MISCELLANEOUS **DETAILS**


C1.19

REVISION:


APPRQVED: JANUARY 23, 2017

-sut

Zelor.

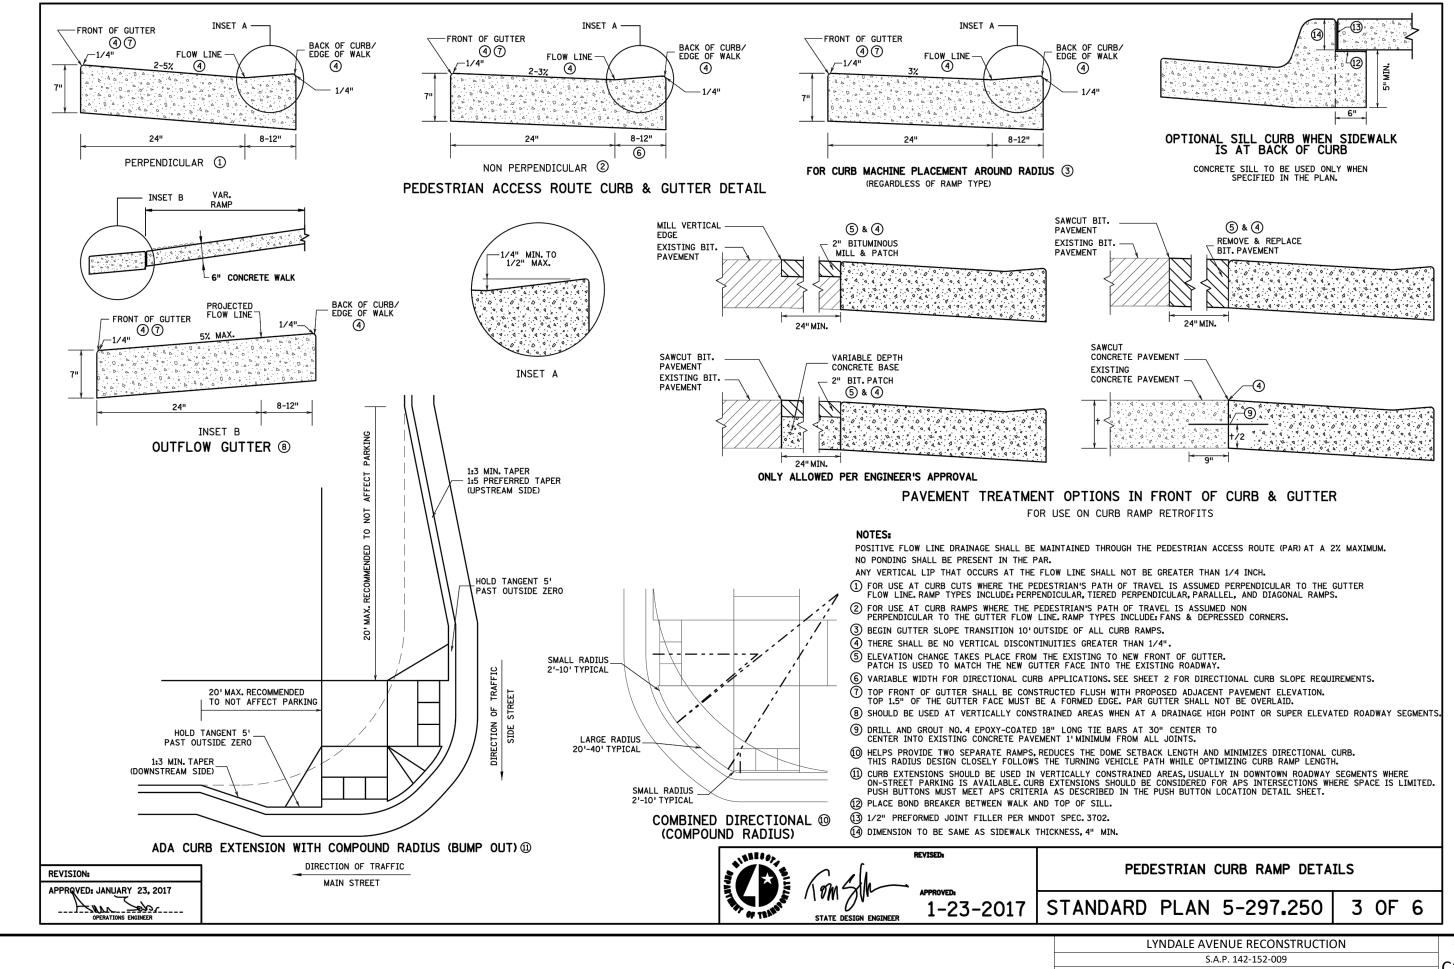



C1.20 MISCELLANEOUS DETAILS

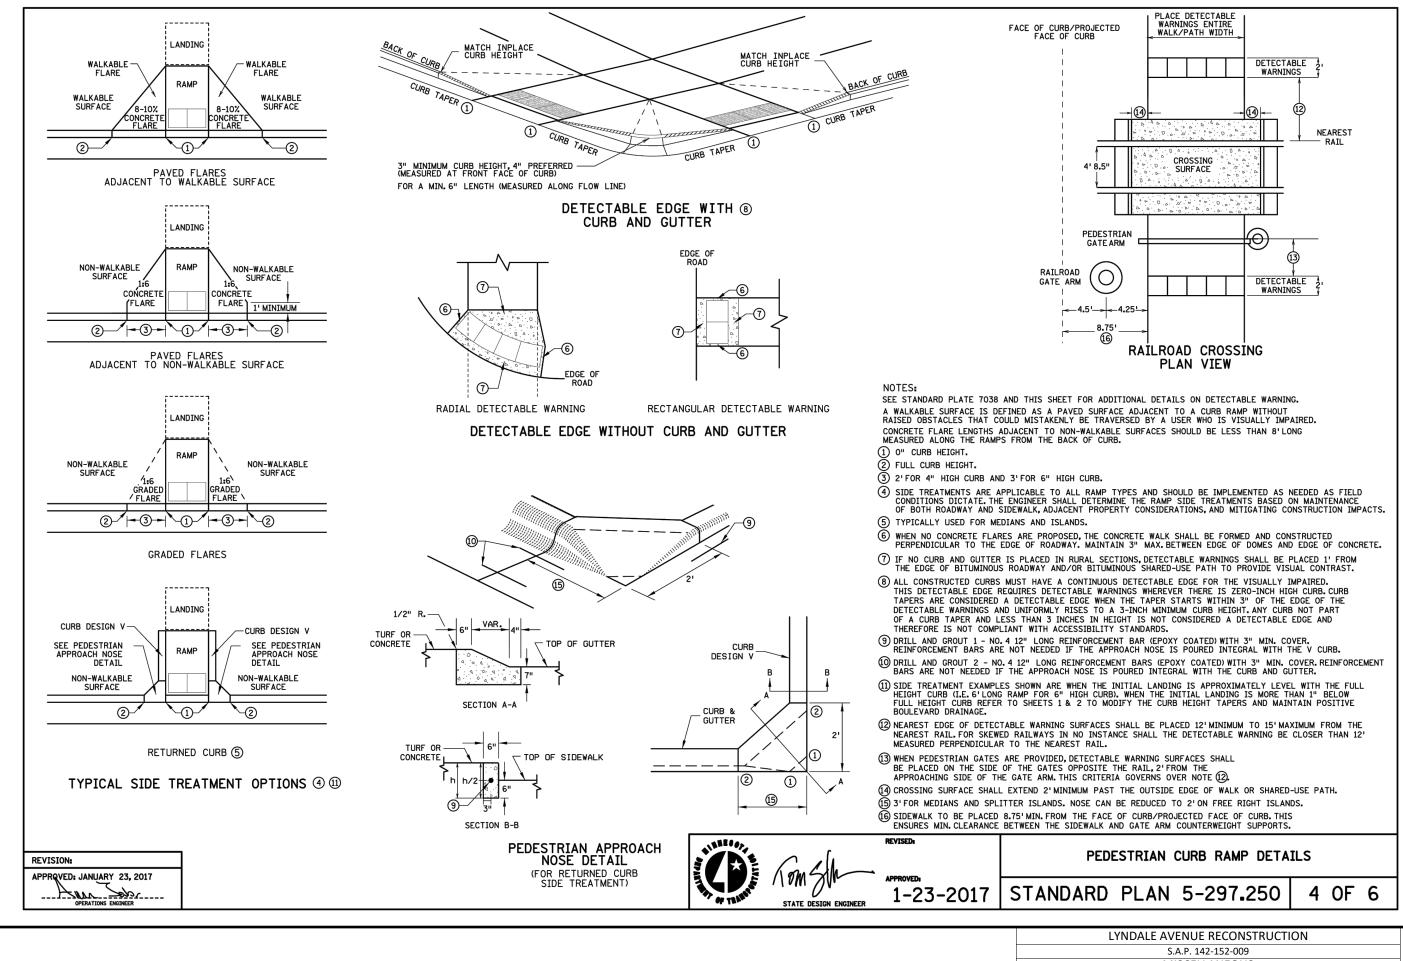

© Bolton & Menk, Inc. 2019, All Rights Reserved H:\RICH\T16114541\CAD\C3D\1145410801.dwg

S.A.P. 142-152-009
MISCELLANEOUS
DETAILS
C1.21

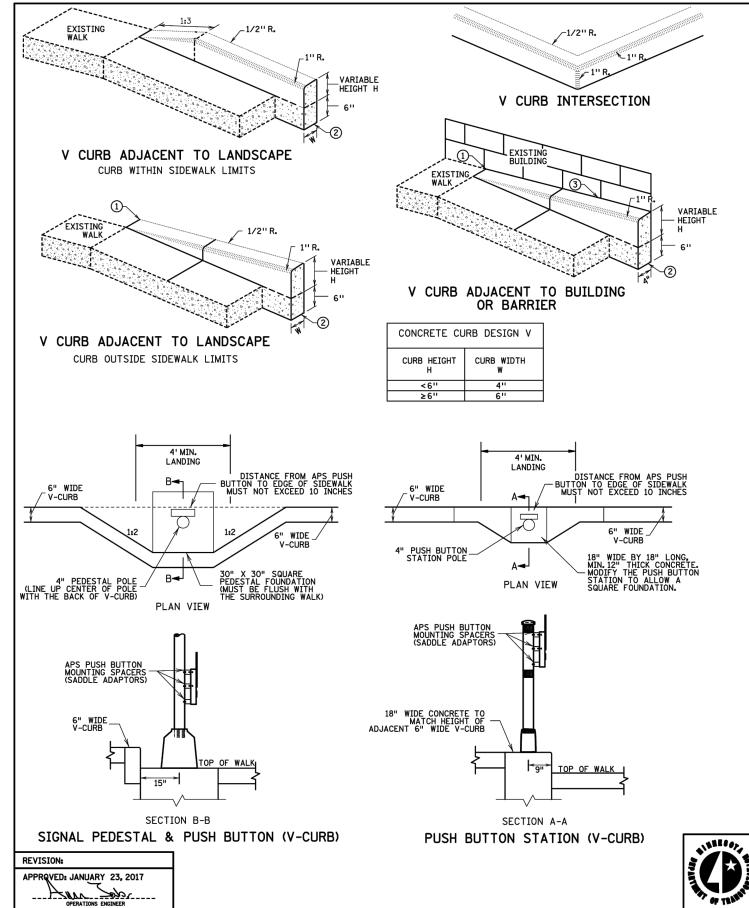

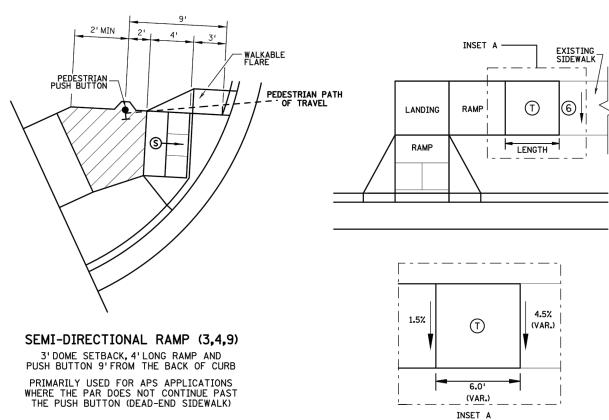

NOTES:

A WALKABLE FLARE IS AN 8-10% CONCRETE FLARE THAT IS REQUIRED WHEN THE FLARE IS ADJACENT TO A WALKABLE SURFACE, OR WHEN THE PEDESTRIAN PATH OF TRAVEL OF A PUSH BUTTON TRAVERSES THE FLARE.

ALL V CURB CONTRACTION JOINTS SHALL MATCH CONCRETE WALK JOINTS.

WHERE RIGHT-OF-WAY ALLOWS, USE OF V CURB SHOULD BE MINIMIZED. GRADING ADJACENT TURF OR SLOPING ADJACENT PAVEMENT IS PREFERRED.

V CURB SHALL BE PLACED OUTSIDE THE SIDEWALK LIMITS WHEN RIGHT OF WAY ALLOWS. V CURB NEXT TO BUILDING SHALL BE A 4" WIDTH AND SHALL MATCH PREVIOUS TOP

- V CURB NEXT TO BUILDING SHALL BE A 4" WIDTH AND SHALL MATCH PREVIOUS TOP OF SIDEWALK ELEVATIONS.
- ① END TAPERS AT TRANSITION SECTION SHALL MATCH INPLACE SIDEWALK GRADES.
- 2 ALL V CURB SHALL MATCH BOTTOM OF ADJACENT WALK.
- (3) EDGE BETWEEN NEW V CURB AND INPLACE STRUCTURE SHALL BE SEALED AND BOND BREAKER SHALL BE USED BETWEEN EXISTING STRUCTURE AND PLACED V-CURB.
- 4 THE MAX. RATE OF CROSS SLOPE TRANSITIONING IS 1'LINEAR FOOT OF SIDEWALK PER HALF PERCENT CROSS SLOPE. WHEN PAR WIDTH IS GREATER THAN 6'OR THE RUNNING SLOPE IS GREATER THAN 5%, DOUBLE THE CALCULATED TRANSITION LENGTH.
- (5) TRANSITION PANELS ARE TO ONLY BE USED AFTER THE RAMP, OR IF NEEDED, LANDING ARE AT THE FULL CURB HEIGHT (TYPICAL SECTION).
- (6) EXISTING CROSS SLOPE GREATER THAN 2.0%.

LEGEND

THESE LONGITUDINAL SLOPE RANGES SHALL BE THE STARTING POINT. IF SITE CONDITIONS WARRANT, LONGITUDINAL SLOPES UP TO 8.3% OR FLATTER ARE ALLOWED.

- S INDICATES PEDESTRIAN RAMP SLOPE SHALL BE BETWEEN 5.0% MINIMUM AND 8.3% MAXIMUM IN THE DIRECTION SHOWN AND THE CROSS SLOPE SHALL NOT EXCEED 2.0%.
- LANDING AREA 4' X 4' MIN. (5' X 5' MIN. PREFERRED) DIMENSIONS AND MAX
 2.0% SLOPE IN ALL DIRECTIONS. LANDING SHALL BE FULL WIDTH OF INCOMING PARS.

 TRANSLITION PANEL (S) TO BE USED FOR TRANSLITIONING THE CROSS-SLOPE OF A
 - TRANSITION PANEL(S) TO BE USED FOR TRANSITIONING THE CROSS-SLOPE OF A RAMP TO THE EXISTING WALK CROSS-SLOPE RATE OF TRANSITION SHOULD BE 0.5% PER 1 LINEAR FOOT OF WALK. SEE THIS SHEET FOR ADDITIONAL INFORMATION.



1-23-2017

REVISED:

PEDESTRIAN CURB RAMP DETAILS

TRANSITION PANEL 45

STANDARD PLAN 5-297.250


5 OF 6

LYNDALE AVENUE RECONSTRUCTION

S.A.P. 142-152-009

MISCELLANEOUS

DETAILS

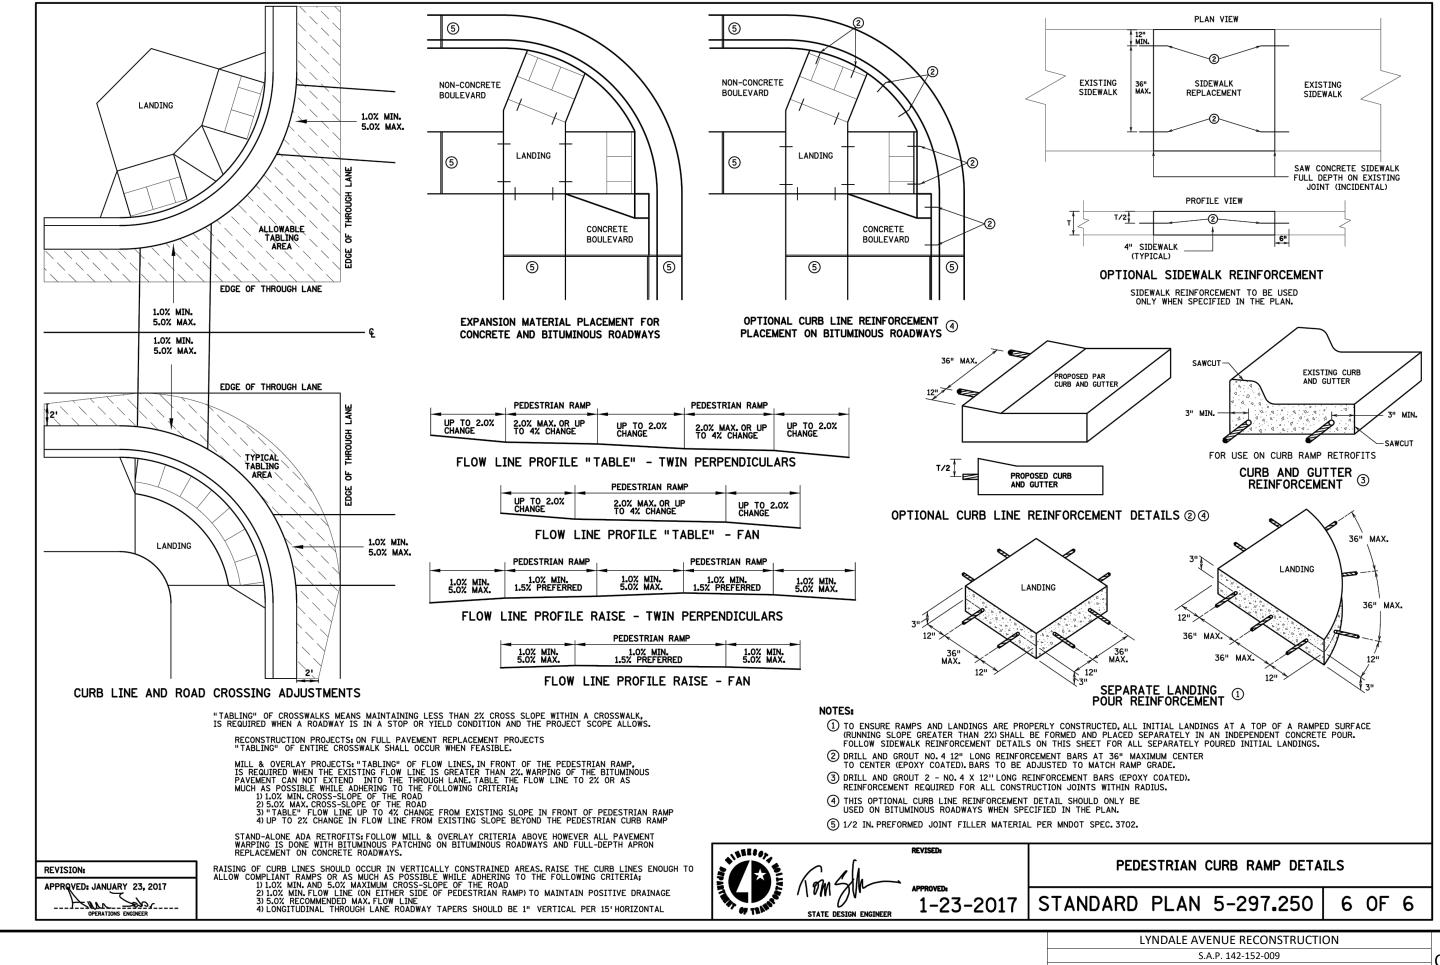

© Bolton & Menk, Inc. 2019, All Rights Reserved H:\RICH\T16114541\CAD\C3D\114541C801.dwg

S.A.P. 142-152-009
MISCELLANEOUS
DETAILS

MISCELLANEOUS

GENERAL STAGING NOTES

- CONSTRUCT ROADWAY PAVEMENT TO WITHIN 2" OF FINISHED GRADE, SIDEWALKS, TEMPORARY PAVEMENT MARKINGS, PERMANENT SIGNAGE, AND TURF ESTABLISHMENT IN EACH STAGE SEQUENTIALLY AS SHOWN IN THE STAGING PLANS.
- 2 ROADWAY REMOVALS MAY BEGIN IN SUBSEQUENT STAGES ONCE UTILITY WORK IS COMPLETED IN THE CURRENT STAGE
- UTILITY WORK MAY BEGIN IN SUBSEQUENT STAGES ONCE THE COMPACTED AGGREGATE BASE IS INSTALLED IN THE CURRENT STAGE
- IT IS ANTICIPATED THAT WORK WILL OCCUR ON MULTIPLE STAGES AT THE SAME TIME. SPECIAL ATTENTION MUST BE PAID TO OVERALL CORRIDOR ACCESS AND INTERSECTION CLOSURES.
- COMPLETE FINAL WEARING COLIRSE AND PERMANENT PAVEMENT MARKING INSTALLATION WITHIN THE PROJECT LIMITS ONCE ALL STAGES HAVE BEEN COMPLETED AS DESCRIBED IN NOTE 1 OF THE GENERAL STAGING NOTES.
- ALL CONSTRUCTION STAGING SHOWN ARE CONCEPTUAL STAGES FOR POTENTIAL STAGING OPTIONS. THE CONTRACTOR SHALL BE RESPONSIBLE FOR THE PROGRESSION OF WORK AND SHALL SUBMIT A DETAILED STAGING PLAN TO THE ENGINEER FOR REVIEW AND APPROVAL A MINIMUM OF 14 CALENDAR DAYS PRIOR TO BEGINNING THE WORK
- THE CONTRACTOR WILL BE REQUIRED TO MAKE SURE ANY ALTERNATE STAGING PLAN MEETS THE GENERAL TRAFFIC CONDITIONS LISTED IN THESE STAGING PLANS AND THE SPECIAL PROVISIONS.
- TEMPORARY ENTRANCES OR TEMPORARY TRAFFIC LANES SHALL BE CONSTRUCTED OUT OF EXISTING PAVEMENT OR COMPACTED GRAVEL SURFACING. NEW TEMPORARY BITUMINOUS PAVEMENT MAY BE USED WITH APPROVAL FROM THE ENGINEER, OR MAY BE REQUIRED AT THE DISCRETION OF THE ENGINEER. ANY APPROVED OR DIRECTED TEMPORARY BITUMINOUS PAVEMENT INSTALLATIONS WILL BE PAID FOR BY THE TON FOR THE MIX TYPE(S) USED. ANY MAINTENANCE ACTIVITIES OF TEMPORARY GRAVEL ENTRANCES AND TRAFFIC LANES WILL BE CONSIDERED INCIDENTAL, WITH EXCEPTION TO THE APPLICATION OF WATER FOR DUST CONTROL
- IN CONSTRAINED AREAS WHERE CONSTRUCTION IS REQUIRED TO BE DONE UNDER TRAFFIC, THE CONTRACTOR MAY UTILIZE A ONE WAY FLAGGING OPERATION DURING DAYTIME WORKING HOURS WITH APPROVAL FROM THE ENGINEER. ALL TRAFFIC SHALL RETURN TO A 2-LANE CONFIGURATION AT THE END OF EACH DAY.
- THE CONTRACTOR SHALL ENSURE THAT AT LEAST ONE TPAR (TEMPORARY PEDESTRIAN ACCESS ROUTE) MEETING MN MUTCD REQUIREMENTS IS PROVIDED AT ALL TIMES. ONE PEDESTRIAN ACCESS POINT SHALL BE MAINTAINED TO EACH BUSINESS AT ALL TIMES. THE CONTRACTOR SHALL SUBMIT A TPAR PLAN TO THE ENGINEER FOR REVIEW A MINIMUM OF 7 CALENDAR DAYS PRIOR TO INSTALLING TPARS. ALL TPARS MUST BE APPROVED BY THE ENGINEER. ALL COSTS ASSOCIATED WITH ESTABLISHING AND MAINTAINING A TPAR SHALL BE INCLUDED IN THE 2563.601 - ALTERNATE PEDESTRIAN ROUTE ITEM.
- SANITARY SEWER, WATERMAIN, STORM SEWER, AND RETAINING WALLS ARE ANTICIPATED TO BE THE DRIVING FACTORS IN THE STAGING AND SCHEDULE. THE CONTRACTOR SHALL PROVIDE A DETAILED SCHEDULE A MINIMUM OF 14 DAYS PRIOR TO BEGINNING THE WORK IDENTIFYING HOW THESE FACILITIES WILL BE CONSTRUCTED WHILE MAINTAINING SERVICE. INCLUDING PLACEMENT TESTING, AND REMOVAL OF TEMPORARY WATER SYSTEMS. IT IS ANTICIPATED THAT THE CONTRACTOR WILL NEED TO HAVE MULTIPLE CREWS FOR EACH ACTIVITY ONSITE TO MEET THE PROJECT MILESTONES DESIGNATED IN THE SPECIAL PROVISIONS.
- ANY WORK THAT IS WITHIN A PERMANENT OF TEMPORARY EASEMENT THAT HAS NOT BEEN SECURED AT THE TIME OF CONSTRUCTION SHALL BE EXCLUDED FROM THE CONTRACT TIME REQUIREMENTS LISTED IN THE PLANS AND SPECIFICATIONS. THE CONTRACTOR WILL RECEIVE NO ADDITIONAL COMPENSATION FOR REMOBILIZING TO AN AREA TO COMPLETE WORK AFTER THE EASEMENT HAS BEEN OBTAINED
- 13. ANY CONFLICTS BETWEEN THESE STAGING NOTES, OTHER PORTIONS OF THE PLAN, AND THE PROPOSAL WILL BE RESOLVED AT THE DISCRETION OF THE ENGINEER.
- THE CONTRACTOR IS RESPONSIBLE FOR COODINATING WITH PRIVATE UTILITY COMPANIES ON RELOCATION NEEDS SHOWN IN THE PLAN, THE CONTRACTOR WILL BE SOLELY RESPONSIBLE FOR COORDINATING WORK SCHEDULES WITH PRIVATE LITHLITY COMPANIES

GENERAL TRAFFIC CONTROL NOTES

- ACCESS TO RESIDENCES & BUSINESSES SHALL BE MAINTAINED AT ALL TIMES THROUGHOUT CONSTRUCTION. THE CONTRACTOR SHALL ALSO SUPPLY ACCESS TO AND FROM THE SITE FOR CONCURRENT CONSTRUCTION PROJECTS, PRIVATE UTILITY RELOCATIONS, MAIL DELIVERY, GARBAGE PICK-UP, AND AS OTHERWISE PROVIDED FOR IN THE SPECIAL PROVISIONS (SEE SECTIONS 1404, 1505, 1507, 1707, AND 1803 OF THE SPECIAL PROVISIONS). LEAVE OPENINGS IN CONCRETE BARRIERS AND UTILIZE ACCESS ROADS WITHIN CONSTRUCTION AREAS TO MAINTAIN ACCESS AS NEEDED.
- IT SHALL BE THE CONTRACTOR'S RESPONSIBILITY TO COORDINATE TRAFFIC CONTROL CONFIGURATIONS WITH PROPERTY OWNERS TO ENSURE TURNING MOVEMENTS AND ACCESS POINTS PROVIDE SUFFICIENT CLEARANCE AND ARE AVAILABLE FOR TRUCK TRAFFIC AND DELIVERIES. IF A BUSINESS HAS MORE THAN ONE ENTRANCE, THE CONTRACTOR WILL BE ALLOWED TO CLOSE ONE ENTRANCE AT A TIME IF THE CONTRACTOR RECEIVES WRITTEN CONSENT FROM ALL BUSINESSES OPERATIONS OUT OF THE ENTRANCE AND THE ENGINEER, IF APPROVAL IS NOT GRANTED. THE CONTRACTOR SHALL COMPLETE WORK AT THE ENTRANCES IN STAGES.
- IN-PLACE SIGNING MUST BE MAINTAINED OR TEMPORARILY RELOCATED FOR CONSTRUCTION ACTIVITIES.
- FIELD CONDITIONS MAY REQUIRE MODIFICATIONS TO THIS LAYOUT AS DEEMED NECESSARY BY THE ENGINEER. 4.
- CONTRACTOR SHALL PLACE ALL SIGNS TO ALLOW ACCESS TO PROPERTIES IN AND NEAR PROJECT AREA
- THE STAGING PLANS DO NOT SHOW ALL TRAFFIC CONTROL DEVICES NEEDED TO PERFORM THE WORK. QUANTITIES FOR TRAFFIC CONTROL DEVICES ARE APPROXIMATE AND ARE SHOWN FOR INFORMATION ONLY. THE ITEM "TRAFFIC CONTROL" BID AS "LUMP SUM" COVERS ALL DEVICES SHOWN ON THE PLAN SHEETS AND OTHER SETUPS REQUIRED BY THE CONTRACTORS OPERATIONS SUCH AS, BUT NOT LIMITED TO, MILLING & PAVING UNDER TRAFFIC, TEMPORARY ROAD CLOSURES, TEMPORARY LANE CLOSURES, CONSTRUCTION UNDER TRAFFIC, ADJUSTMENTS TO THE TRAFFIC CONTROL PLAN FOR CONSTRUCTION OPERATIONS, STAGED UTILITY INSTALLATION, STAGED ROADWAY CONSTRUCTION, TRANSITIONING TRAFFIC FROM ONE STAGE TO ANOTHER, AND PAVEMENT MARKING INSTALLATION
- THE CURRENT EDITION OF THE MINNESOTA DEPARTMENT OF TRANSPORTATION "STANDARD SPECIFICATIONS FOR CONSTRUCTION" SHALL GOVERN. ALL TRAFFIC CONTROL DEVICES SHALL CONFORM AND BE INSTALLED IN ACCORDANCE WITH THE LATEST EDITION OF THE MINNESOTA MANUAL ON UNIFORM TRAFFIC CONTROL DEVICES (MN MUTCD) AND INCLUDING THE LATEST FIELD MANUAL FOR TEMPORARY TRAFFIC CONTROL ZONE LAYOUTS. TRAFFIC CONTROL NOT IN COMPLIANCE WITH MN MUTCD WILL BE SUBJECT TO VIOLATION IN ACCORDANCE WITH THE SPECIAL PROVISIONS
- SIX (6) ADDITIONAL "ROAD CLOSED TO THRU TRAFFIC" BARRICADE ASSEMBLIES WITH FLASHERS, TEN (10) ADDITIONAL TYPE III BARRICADES, AND TWENTY (20) ADDITIONAL BARRELS SHALL BE AVAILABLE FOR USE BY THE PROJECT ENGINEER AT HIS DISCRETION AND SHALL BE INCLUDED IN THE PRICE BID FOR TRAFFIC CONTROL
- PLACE G20-X2 7 DAYS IN ADVANCE OF CLOSURE, PLACE "FOLLOW DETOUR" PANELS ON G20-X2 ONCE CLOSURE BEGINS.
- LONGITUDINAL DROP OFFS SHALL BE SIGNED AS SHOWN IN THE "TEMPORARY TRAFFIC CONTROL ZONE LAYOUTS" FIELD MANUAL 10. UNLESS OTHERWISE REQUIRED BY THE MN MUTCD
- CONTRACTOR SHALL COVER ALL CONFLICTING EXISTING SIGNS AND OBLITERATE ANY CONFLICTING PAVEMENT MARKINGS. 11.
- ALL PERMANENT SIGNING SHALL BE PLACED BEFORE SECTIONS OF ROADWAYS ARE OPEN TO TRAFFIC, OR PROVIDE TEMPORARY 12. SIGNING AT THE CONTRACTOR'S EXPENSE UNTIL THE FINAL SIGNING IS PLACED.
- MAINTAIN EAST-WEST ACCESS THROUGH SIDE STREET INTERSECTIONS FOLLOWING INSTALLATION OF AGGREGATE BASE WHENEVER 13. POSSIBLE

STAGING NARRATIVE

STAGE 1

LOCATION: LYNDALE AVENUE FROM 76TH STREET (SOUTH PROJECT LIMIT) TO SOUTH OF 73RD STREET

WORK COMPLETED UNDER THIS STAGE: ALL WORK IN THE STAGE 1 AREA

- STAGE 1 HAS BEEN DIVIDED INTO FOUR SUB STAGES. STAGING AND TRAFFIC CONTROL INFORMATION CAN BE FOUND ON SHEETS C1.28-C1.30
 IT IS ANTICIPATED THAT STAGE 1 AND STAGE 2 CONSTRUCTION WILL OCCUR AT THE SAME TIME
- IF THE CONTRACTOR ELECTS TO RECLAIM THE EXISTING PAVEMENT, THE CONTRACTOR WILL BE ALLOWED TO RECLAIM STAGE 1 AND 2 CONCURRENTLY.
- THE WEARING COURSE PAVEMENT FOR STAGE 1 AND STAGE 2 CAN BE PLACED CONCURRENTLY.
- MAINTAIN ACCESS TO BUSINESSES AND RESIDENCES AT ALL TIMES
- THE 76TH STREET INTERSECTION MUST REMAIN OPEN WITH AT LEAST ONE LANE IN ALL DIRECTIONS AT ALL TIMES. ANY REQUIRED SIGNAL HEAD ADJUSTMENTS SHALL BE AN INCIDENTAL EXPENSE, AND THE CONTRACTOR SHALL BE RESPONSIBLE WITH COORDINATING SIGNAL ADJUSTMENTS WITH THE SIGNAL OWNERS
- THE CONTRACTOR SHALL SUBMIT A STAGING LAYOUT FOR CONSTRUCTING STAGE 1D UNDER TRAFFIC A MINIMUM OF 14 CALENDAR DAYS PRIOR TO INSTALLING TRAFFIC CONTROL
- THE 74TH STREET INTERSECTION MUST BE OPEN TO TRAFFIC FOR USE IN MAINTAINING THE DETOUR ROUTES PROVIDED IN THE DETOUR PLAN PRIOR TO CLOSING THE PORTION OF STAGE 1 FROM 73RD STREET TO 74TH STREET
- SPECIAL CARE SHALL BE GIVEN TO ENSURING BUSINESS ACCESS IS MAINTAINED WITHIN COMMERCIAL AREAS IN STAGE 1 AND STAGE 4. THIS MAY REQUIRE INSTALLATION OF 4" THICK TEMPORARY BITUMINOUS PAVEMENT ENTRANCES AS NEEDED AT THE DISCRETION OF THE ENGINEER. TEMPORARY BITUMINOUS PAVEMENT ENTRANCES WILL BE PAID BY THE TON FOR THE MIX TYPE(S) USED
- CONSTRUCT MEDIAN ON SOUTH END OF SUB STAGE 1A IN CONJUNCTION WITH SUB STAGES 1B & 1C TO ACCOMMODATE TRAFFIC LANE TAPERS REQUIRED DURING SUB STAGE 1B & 1C CONSTRUCTION

STAGE 2

LOCATION: LYNDALE AVENUE FROM SOUTH OF 73RD STREET TO SOUTH OF 70TH STREET

WORK COMPLETED UNDER THIS STAGE: ALL WORK IN THE STAGE 2 AREA

- IF THE CONTRACTOR ELECTS TO RECLAIM THE EXISTING PAVEMENT, THE CONTRACTOR WILL BE ALLOWED TO RECLAIM STAGE 1 AND 2 CONCURRENTLY.
 THE WEARING COURSE PAVEMENT FOR STAGE 1 AND STAGE 2 CAN BE PLACED CONCURRENTLY.
- STAGE 2 CONSTRUCTION IS ASSUMED TO OCCUR UNDER A FULL CLOSURE OF LYNDALE AVENUE WITHIN THE STAGE 2 LIMITS
- THE CONTRACTOR SHALL RESTORE TWO-WAY TRAFFIC TO ONE BLOCK PORTIONS OF LYNDALE AVENUE AS THEY BECOME AVAILABLE FOLLOWING INSTALLATION OF BASE COURSE PAVEMENT. TRAFFIC CONTROL MODIFICATIONS REQUIRED TO OPEN PORTIONS OF LYNDALE AVENUE ARE TO BE INCLUDED IN THE TRAFFIC CONTROL LUMP SUM.
- THE ENGINEER RESERVES THE RIGHT TO REQUIRE THE INSTALLATION OF LOCAL DETOUR SIGNAGE AND PAVEMENT MARKINGS AS NEEDED DURING STAGE 2 CONSTRUCTION. SIGNAGE AND PAVEMENT MARKINGS REQUIRED UNDER THIS PROVISION WILL BE PAID USING THE CONSTRUCTION SIGNING ITEM AND THE PAVEMENT MARKING ITEMS CORRESPONDING TO THE TYPE OF MARKING INSTALLED
- A 4-WAY STOP TRAFFIC CONTROL SETUP SHALL BE INSTALLED AT 73RD AVENUE AT ALL TIMES WHILE THE SIGNAL SYSTEM IS NON-OPERATIONAL AND THE INTERSECTION IS OPEN TO TRAFFIC
- THE CONTRACTOR SHALL BE RESPONSIBLE FOR COORDINATING WITH RICHFIELD SCHOOL DISTRICT AND THE ACADEMY OF HOLY ANGELS TO ENSURE ACCESS IS MAINTAINED FOR SCHOOL BUS TRAFFIC AT

STAGE 3

LOCATION: LYNDALE AVENUE FROM SOUTH OF 70TH STREET TO NORTH OF LAKESHORE DRIVE

WORK COMPLETED UNDER THIS STAGE: ALL WORK IN THE STAGE 3 AREA, ROUNDABOUTS AT 70TH AND 68TH STREETS.

- STAGE 3 HAS BEEN DIVIDED INTO TWO SUB STAGES. STAGING AND TRAFFIC CONTROL INFORMATION CAN BE FOUND ON SHEET C1.25.
- COMPLETE CONSTRUCTION OF STAGE 1 AND STAGE 2 ROADWAY PAVEMENT TO WITHIN 2" OF FINISHED GRADE, AND REOPEN STAGE 1 AND STAGE 2 TO TRAFFIC BEFORE BEGINNING CONSTRUCTION ON STAGE 3 AND STAGE 4
- BEGIN CONSTRUCTION WITH SUB STAGE 3A AND END WITH SUB STAGE 3B
- IT IS ANTICIPATED THAT STAGE 3 AND STAGE 4 CONSTRUCTION WILL OCCUR AT THE SAME TIME.
- STAGE 3 INCLUDES THE INSTALLATION OF LARGE RETAINING WALL ALONG THE WEST SIDE OF LYNDALE AVENUE. THE CONTRACTOR SHALL DUE IT'S DUE DILIGENCE IN COORDINATING MATERIAL PROCUREMENT TIMELINES TO MEET THE STAGING PROVISIONS AND CONTRACT MILESTONES.
- THE WEARING COURSE PAVEMENT FOR STAGE 3 AND STAGE 4 CAN BE COMPLETED CONCURRENTLY.
- RESTORE SUB STAGE 3A TO A GRAVEL SURFACE AND MAINTAIN TWO WAY TRAFFIC AND ACCESS AT LAKESHORE DRIVE AND 68TH STREET PRIOR TO RESTRICTING TRAFFIC ON SUB STAGE 3B
- THE LAKESHORE DRIVE AND LYNDALE AVENUE INTERSECTION MUST REMAIN OPEN TO TRAFFIC AT ALL TIMES WITH EXCEPTION TO A ONE TIME ONE WEEK CLOSURE. THE CONTRACTOR SHALL SUBMIT A TRAFFIC CONTROL LAYOUT OF A PROPOSED DETOUR ROUTE TO THE ENGINEER FOR REVIEW AND APPROVAL A MINIMUM OF 14 DAYS PRIOR TO STARTING THE CLOSURE.
- THE CONTRACTOR SHALL RESTORE TWO-WAY TRAFFIC TO ONE BLOCK PORTIONS OF LYNDALE AVENUE AS THEY BECOME AVAILABLE FOLLOWING INSTALLATION OF BASE COURSE PAVEMENT. TRAFFIC CONTROL MODIFICATIONS REQUIRED TO OPEN PORTIONS OF LYNDALE AVENUE ARE TO BE INCLUDED IN THE TRAFFIC CONTROL LUMP SUM.

STAGE 4

LOCATION: LYNDALE AVENUE FROM NORTH OF LAKESHORE DRIVE TO 66TH STREET (NORTH PROJECT LIMIT)

WORK COMPLETED UNDER THIS STAGE: ALL WORK IN THE STAGE 4 AREA, ROUNDABOUT AT 67TH STREET

- IT IS ANTICIPATED THAT STAGE 3 AND STAGE 4 CONSTRUCTION WILL OCCUR AT THE SAME TIME.
- STAGE 4 HAS BEEN DIVIDED INTO THREE SUB STAGES. STAGING AND TRAFFIC CONTROL INFORMATION CAN BE FOUND ON SHEETS C1.31-C1.33
- THE WEARING COURSE PAVEMENT FOR STAGE 3 AND STAGE 4 CAN BE COMPLETED CONCURRENTLY.
- MAINTAIN ACCESS TO BUSINESSES AND RESIDENCES AT ALL TIMES
- SPECIAL CARE SHALL BE GIVEN TO ENSURING BUSINESS ACCESS IS MAINTAINED WITHIN COMMERCIAL AREAS IN STAGE 1 AND STAGE 4. THIS MAY REQUIRE INSTALLATION OF 4" THICK TEMPORARY BITUMINOUS PAVEMENT ENTRANCES AS NEEDED AT THE DISCRETION OF THE ENGINEER. TEMPORARY BITUMINOUS PAVEMENT ENTRANCES WILL BE PAID BY THE TON FOR THE MIX TYPE(S) USED PEDESTRIAN ACCESS SHALL BE MAINTAINED TO BUSINESS ENTRANCES AT ALL TIMES
- THE LAKESHORE DRIVE AND LYNDALE AVENUE INTERSECTION MUST REMAIN OPEN TO TRAFFIC AT ALL TIMES WITH EXCEPTION TO A ONE TIME ONE WEEK CLOSURE. THE CONTRACTOR SHALL SUBMIT A TRAFFIC CONTROL LAYOUT OF A PROPOSED DETOUR ROUTE TO THE ENGINEER FOR REVIEW AND APPROVAL A MINIMUM OF 14 DAYS PRIOR TO STARTING THE CLOSURE
- TWO-WAY ACCESS TO 67TH STREET WITH ONE 11' WIDE MINIMUM LANE IN EACH DIRECTION MUST BE MAINTAINED ON LYNDALE AVENUE AT ALL TIMES. CONSTRUCT TRAFFIC LANES IN ACCORDANCE WITH THE GENERAL STAGING NOTES
- ONE TWO-DAY WEEKEND CLOSURE OF THE 67TH STREET AND LYNDALE AVENUE INTERSECTION WILL BE ALLOWED. THE CONTRACTOR SHALL PROVIDE NOTICE TO THE ENGINEER A MINIMUM OF 14 DAYS
- STAGE 4 SHALL BE LIMITED TO 30 CALENDAR DAYS AS DESCRIBED IN THE SPECIAL PROVISIONS
 IT IS ANTICIPATED THAT WORK WILL BE OCCURRING ON A SEPARATE PROJECT ON 66TH STREET DURING THE LYNDALE RECONSTRUCTION PROJECT. THE CONTRACTOR MUST COORDINATE TRAFFIC CONTROL AND ACCESS IMPACTS WITH THE 66TH STREET PROJECT CONTRACTOR. NO ADDITIONAL COMPENSATION WILL BE MADE FOR THESE COORDINATION EFFORTS OR ANY REQUIRED TRAFFIC CONTROL MODIFICATIONS REQUIRED





12224 NICOLLET AVENUE BURNSVILLE, MINNESOTA 55337 Phone: (952) 890-0509 www.bolton-menk.com




	DE
OLiold	DI
nounc	а
ban Hometown	CI


	DESIGNEI Z
Od.	DRAWN
own	CHECKED
	CLIENT PI


	DESIGNED
	ZP/
1	DRAWN
	ZP.
~	CHECKED
	TL
	CLIENT PROJ.

CITY OF RICHFIELD. MINNESOTA S.A.P. 157-363-032, LYNDALE AVENUE RECONSTRUCTION

STAGING NOTES

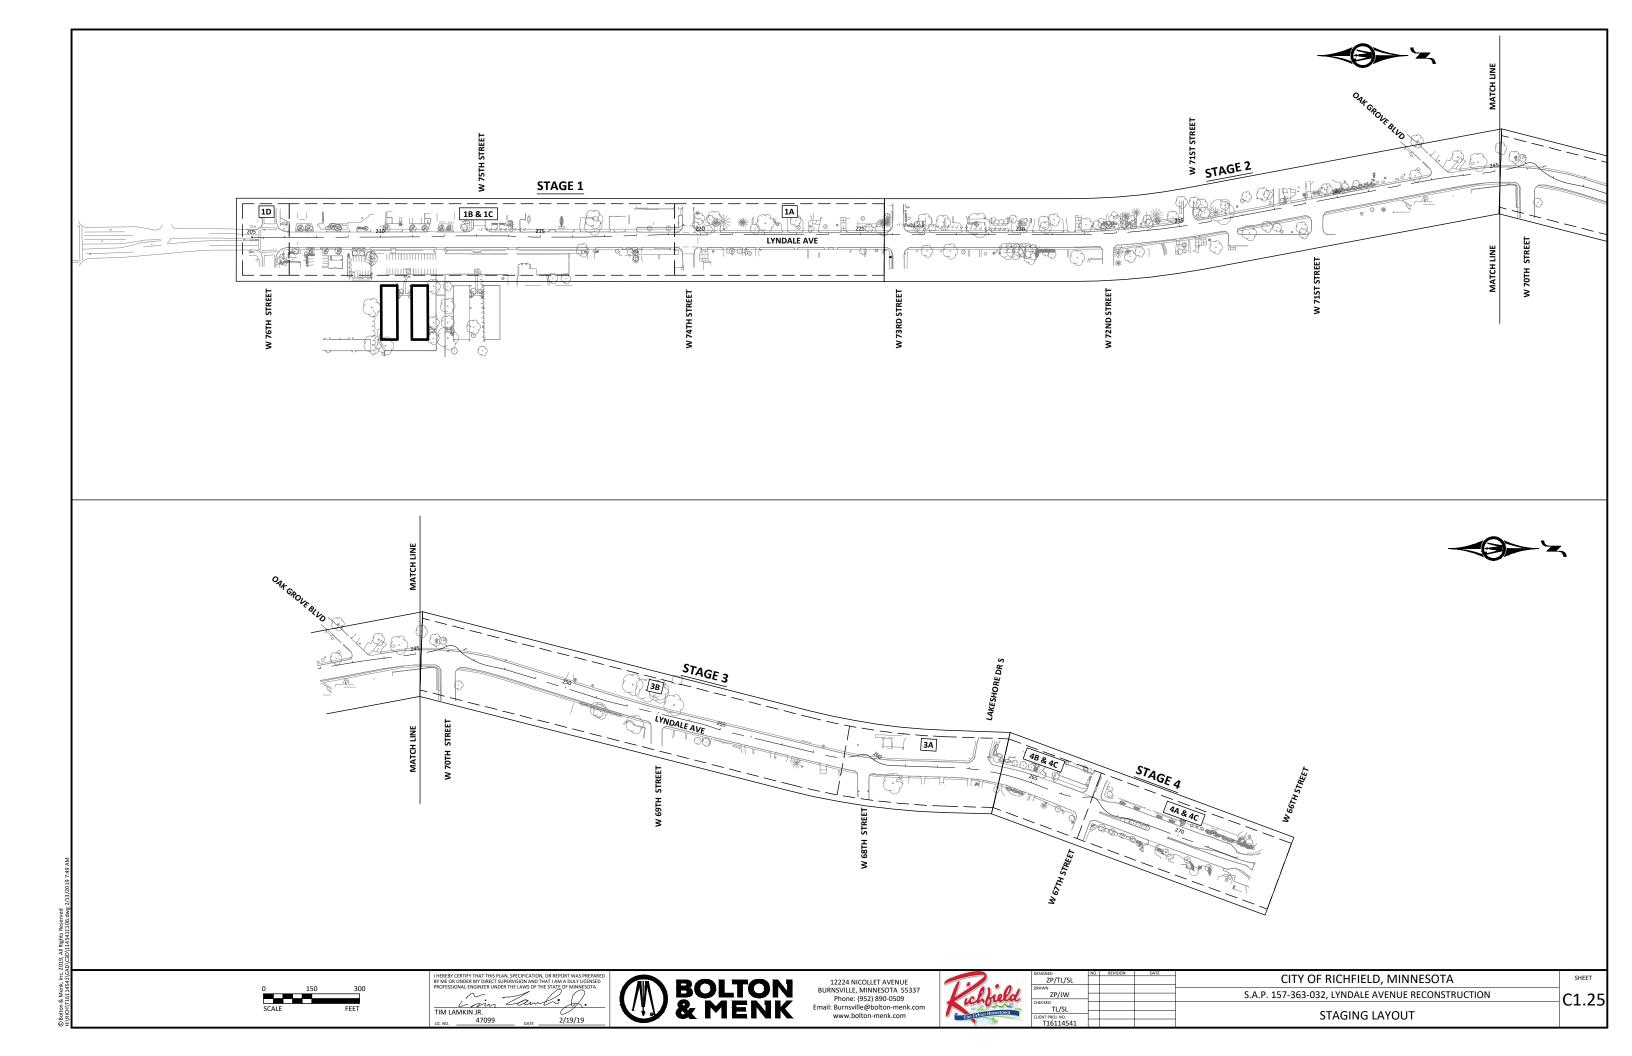

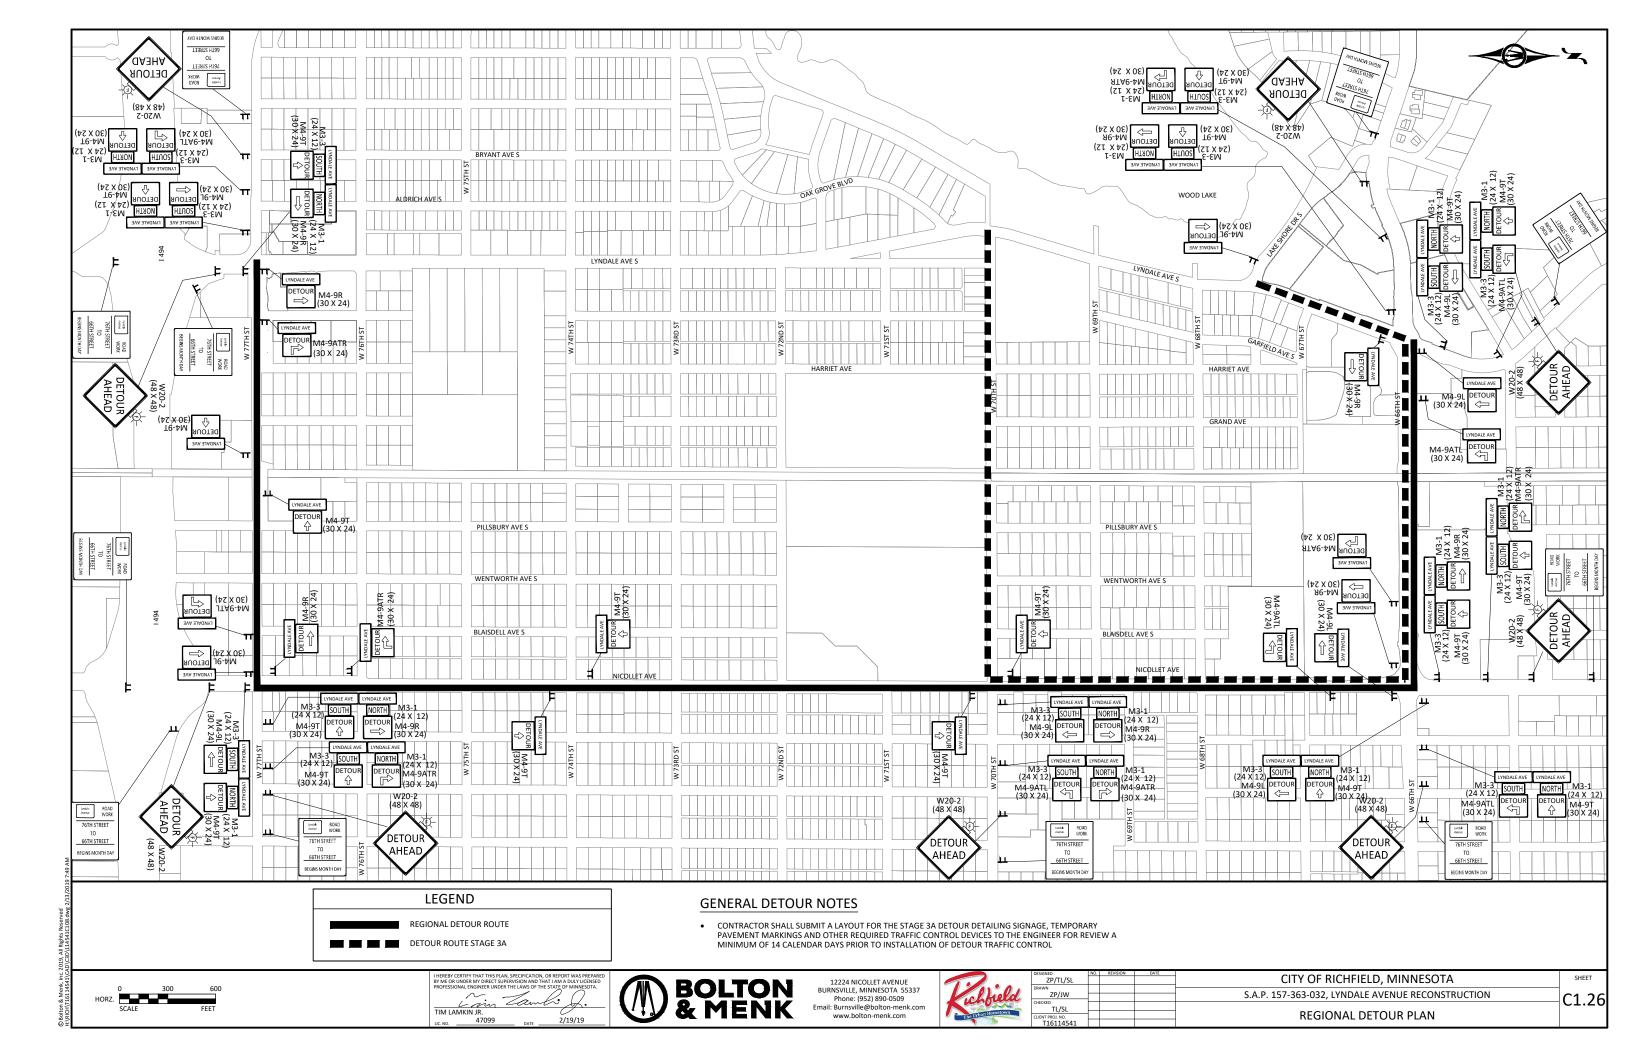

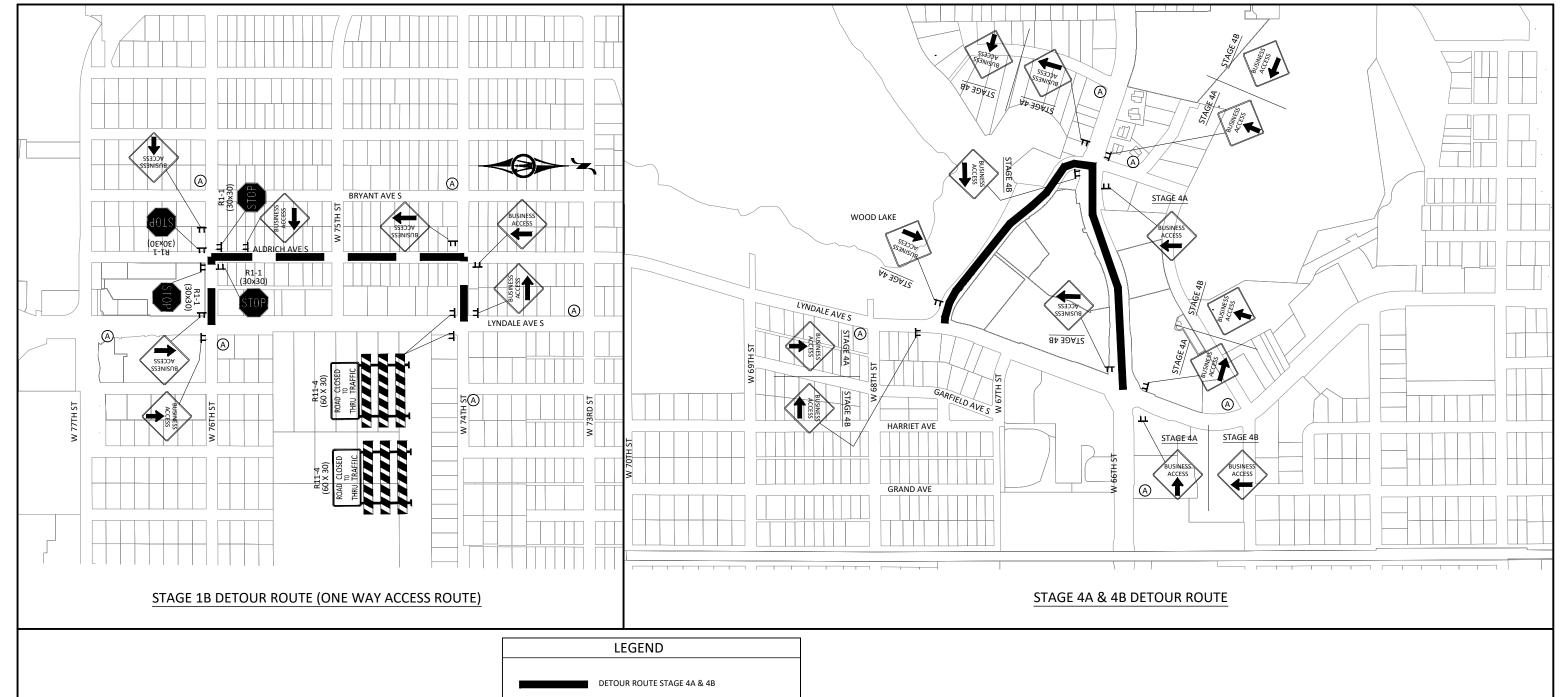

DETOUR ROUTE STAGE 1B (ONE WAY STAGE)

A PORTABLE CHANGEABLE MESSAGE SIGN













D	NO.	REVISION	DATE	
P/TL/SL				
(
ZP/JW				
TL/SL				
ROJ. NO.				
6114541				


CITY OF RICHFIELD, MINNESOTA S.A.P. 157-363-032, LYNDALE AVENUE RECONSTRUCTION C1.27 LOCAL DETOUR PLAN

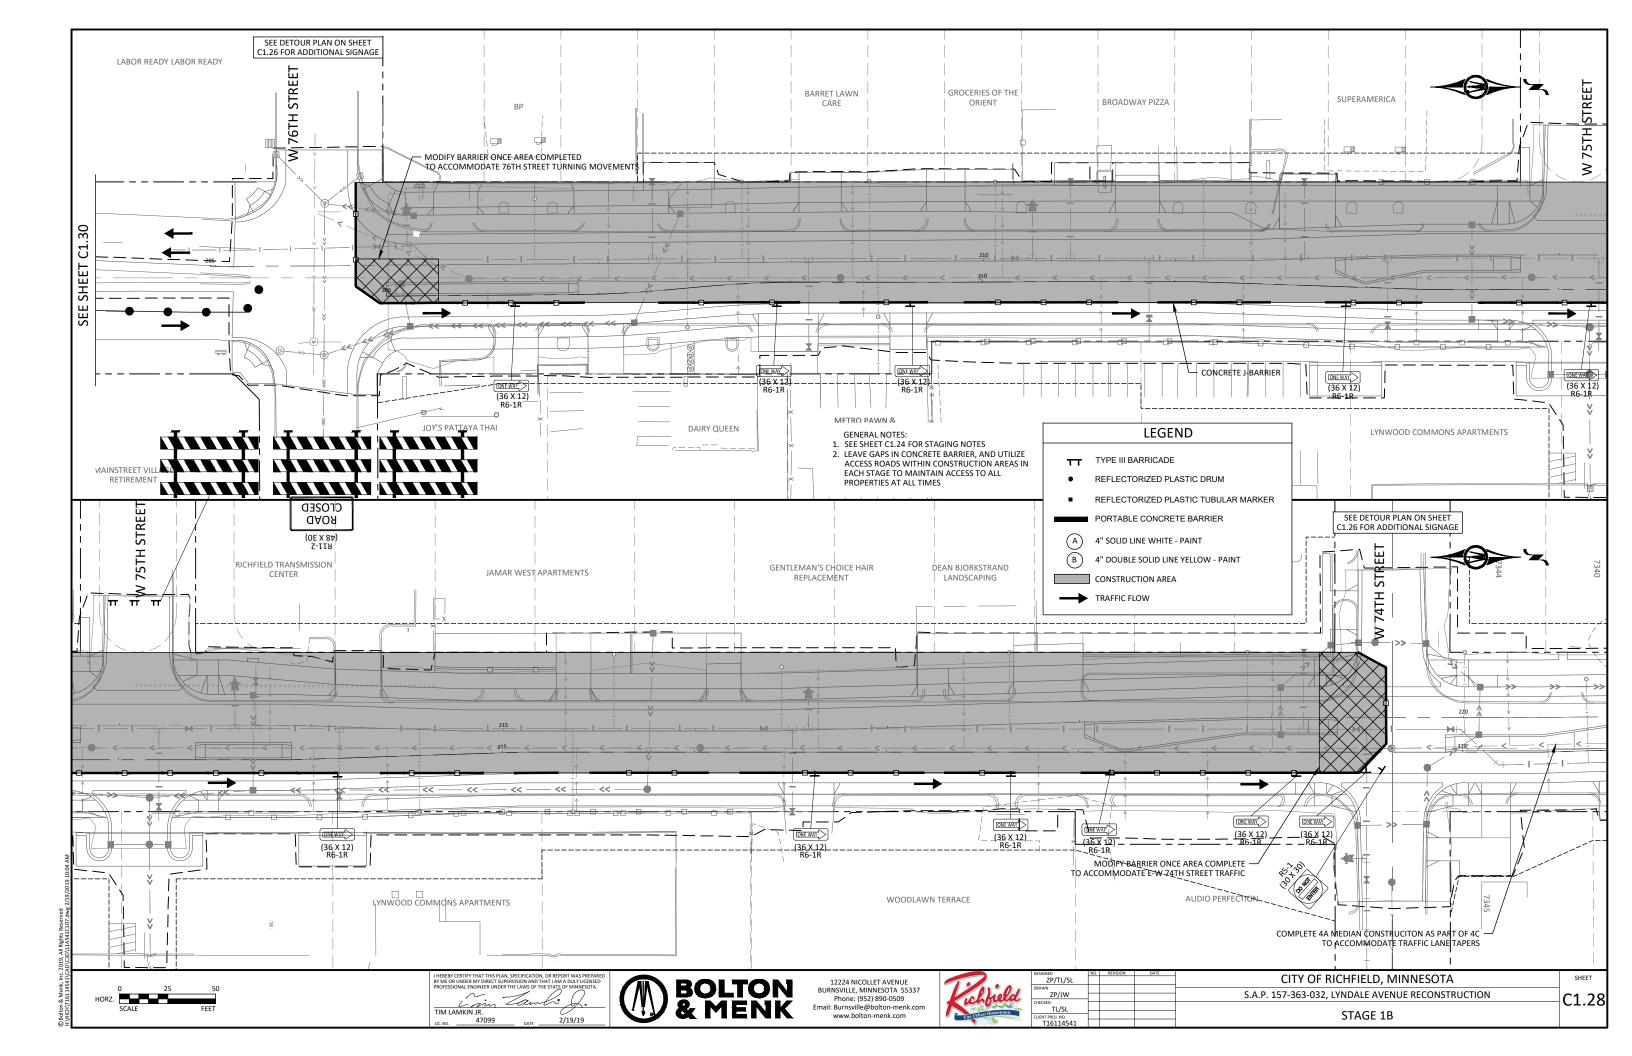


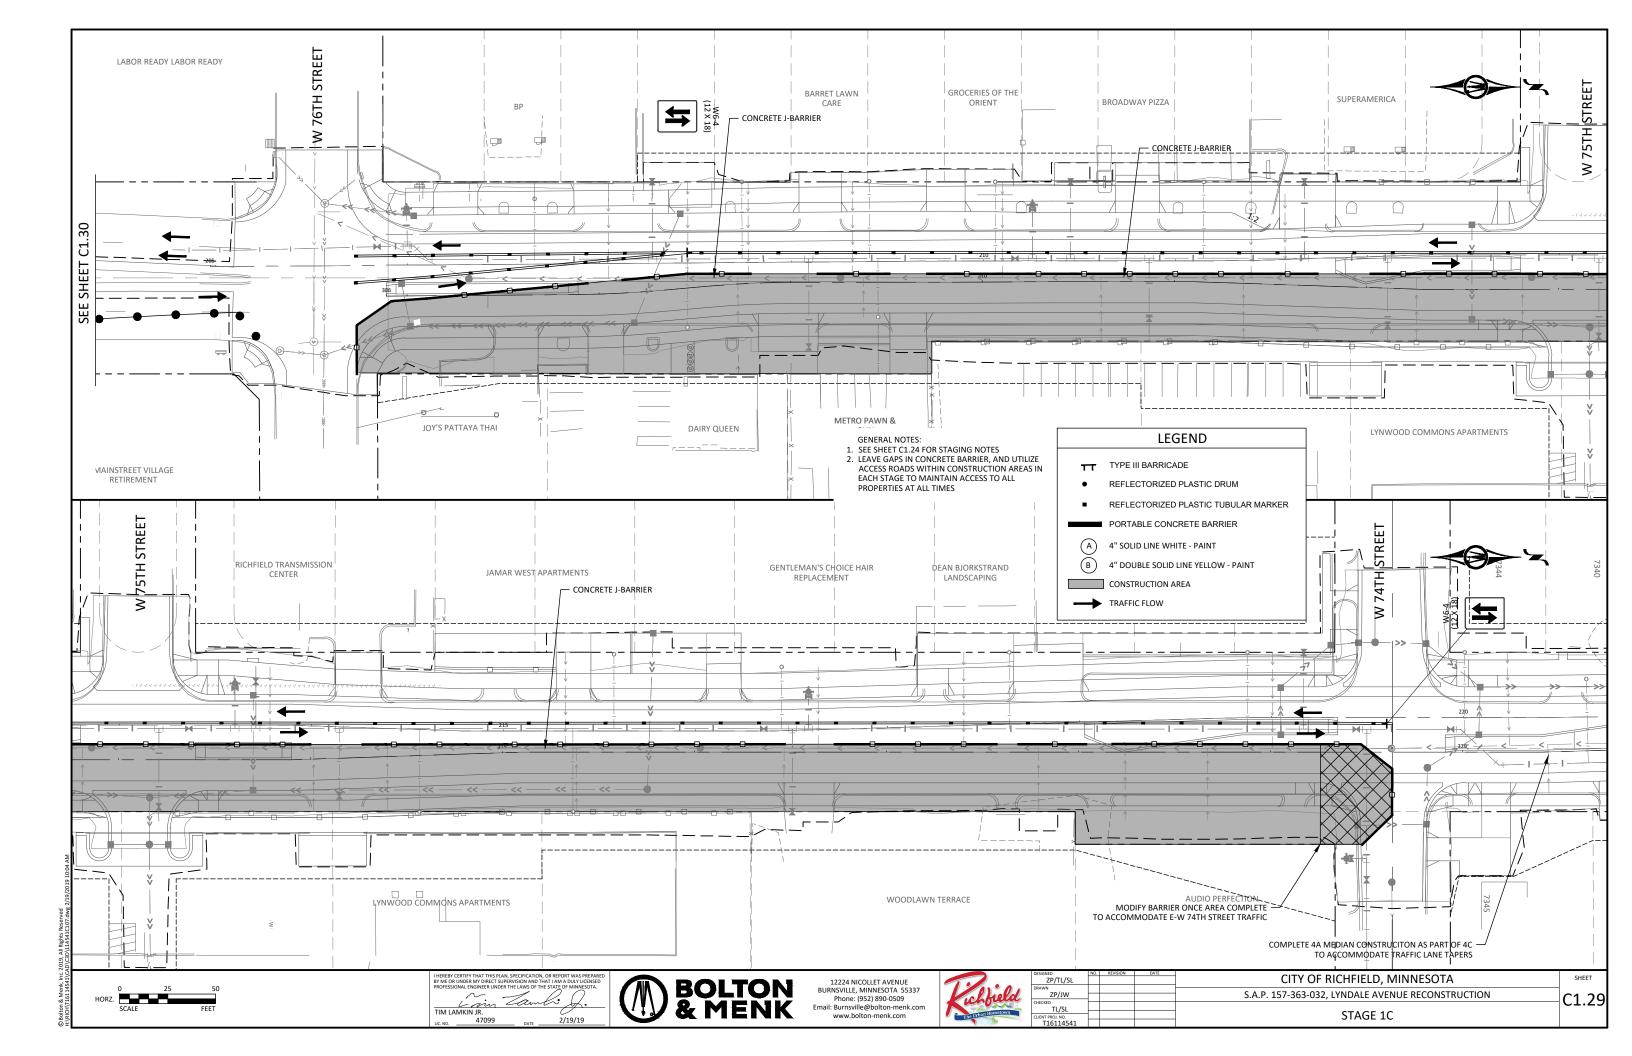


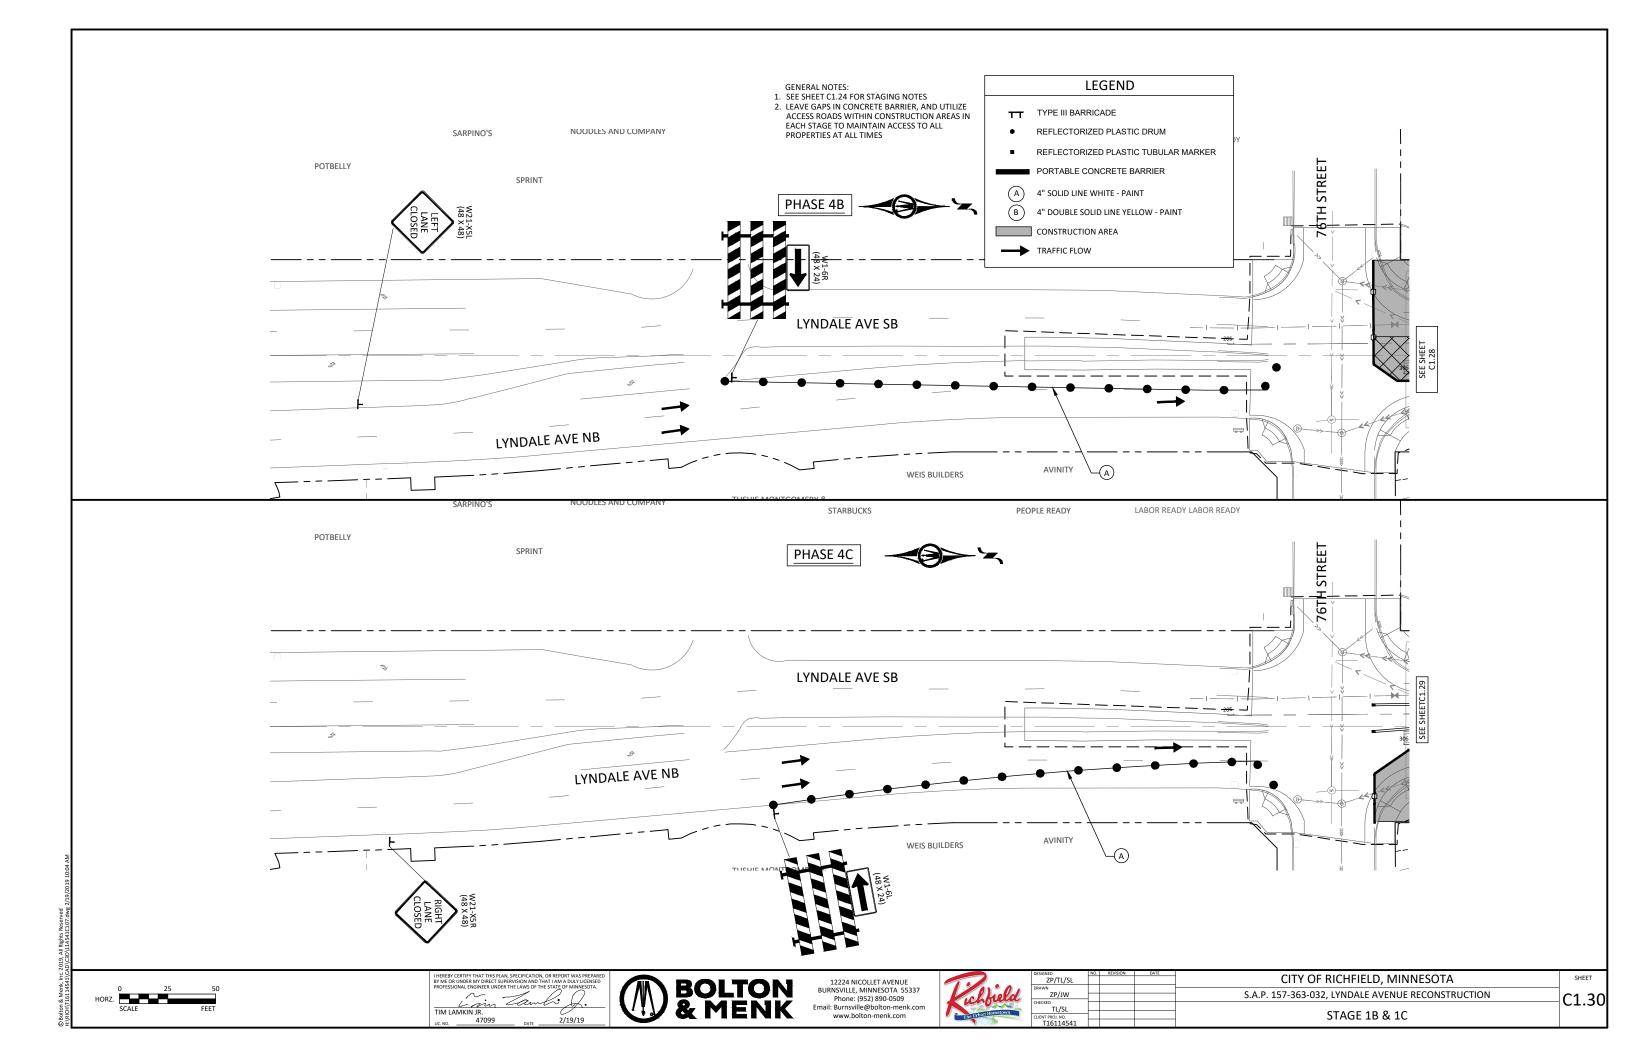


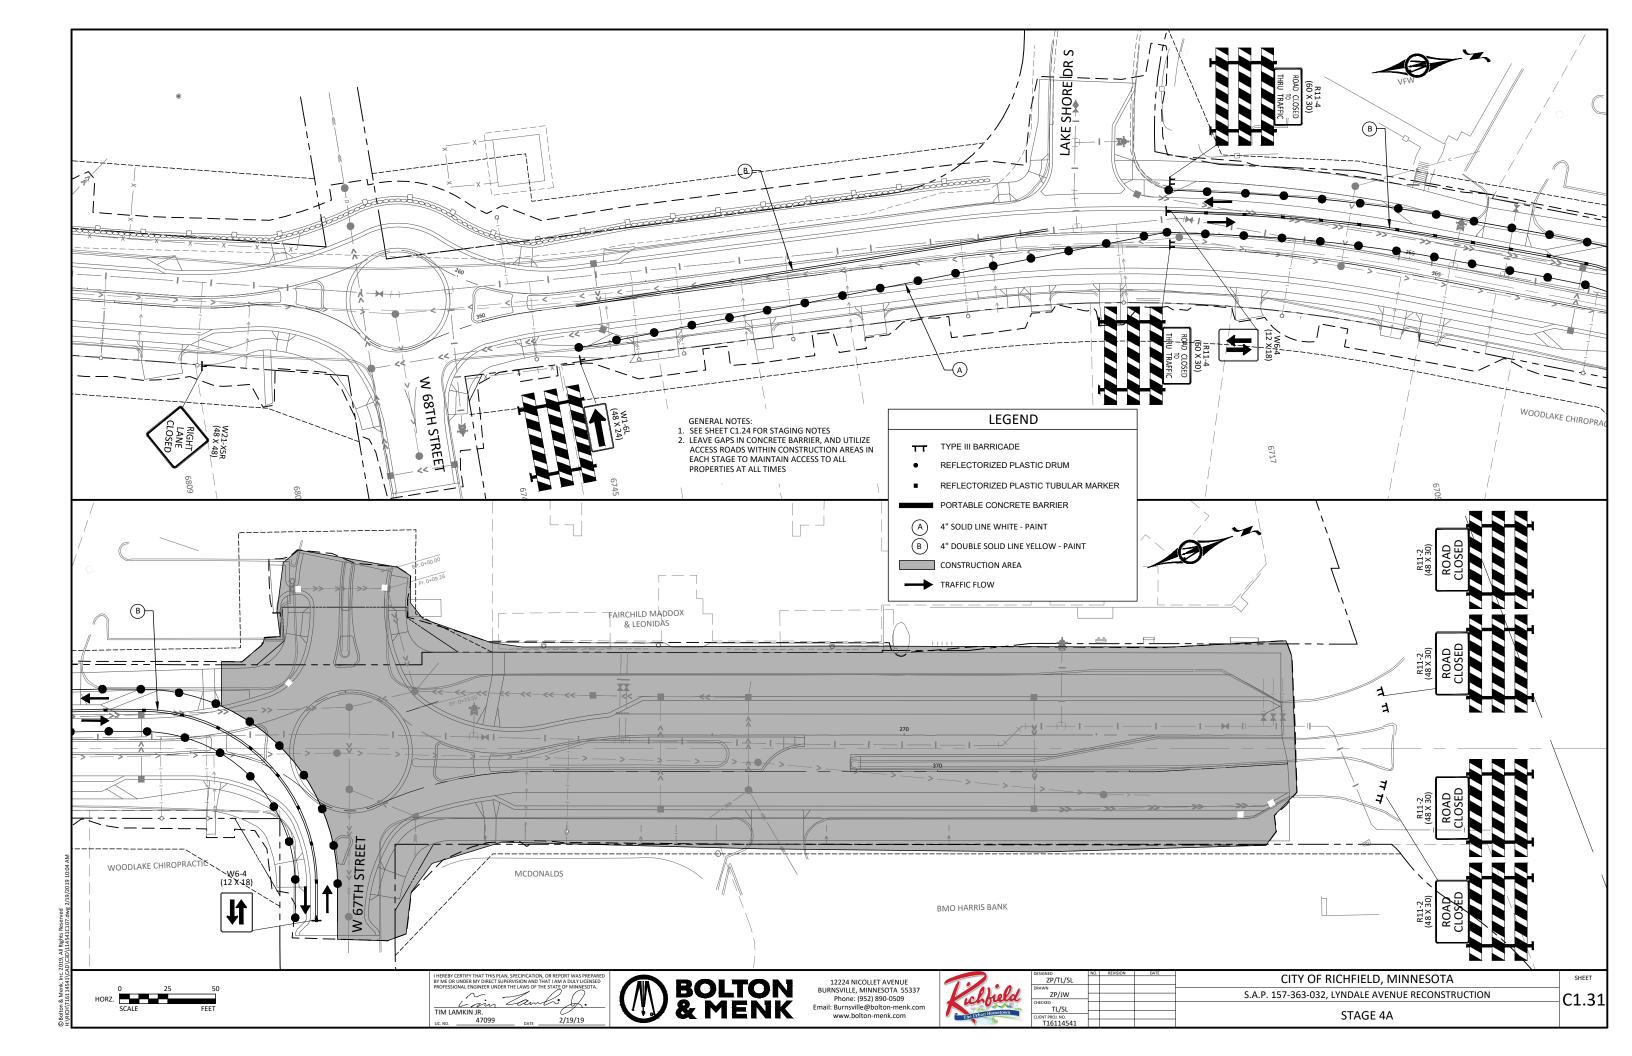


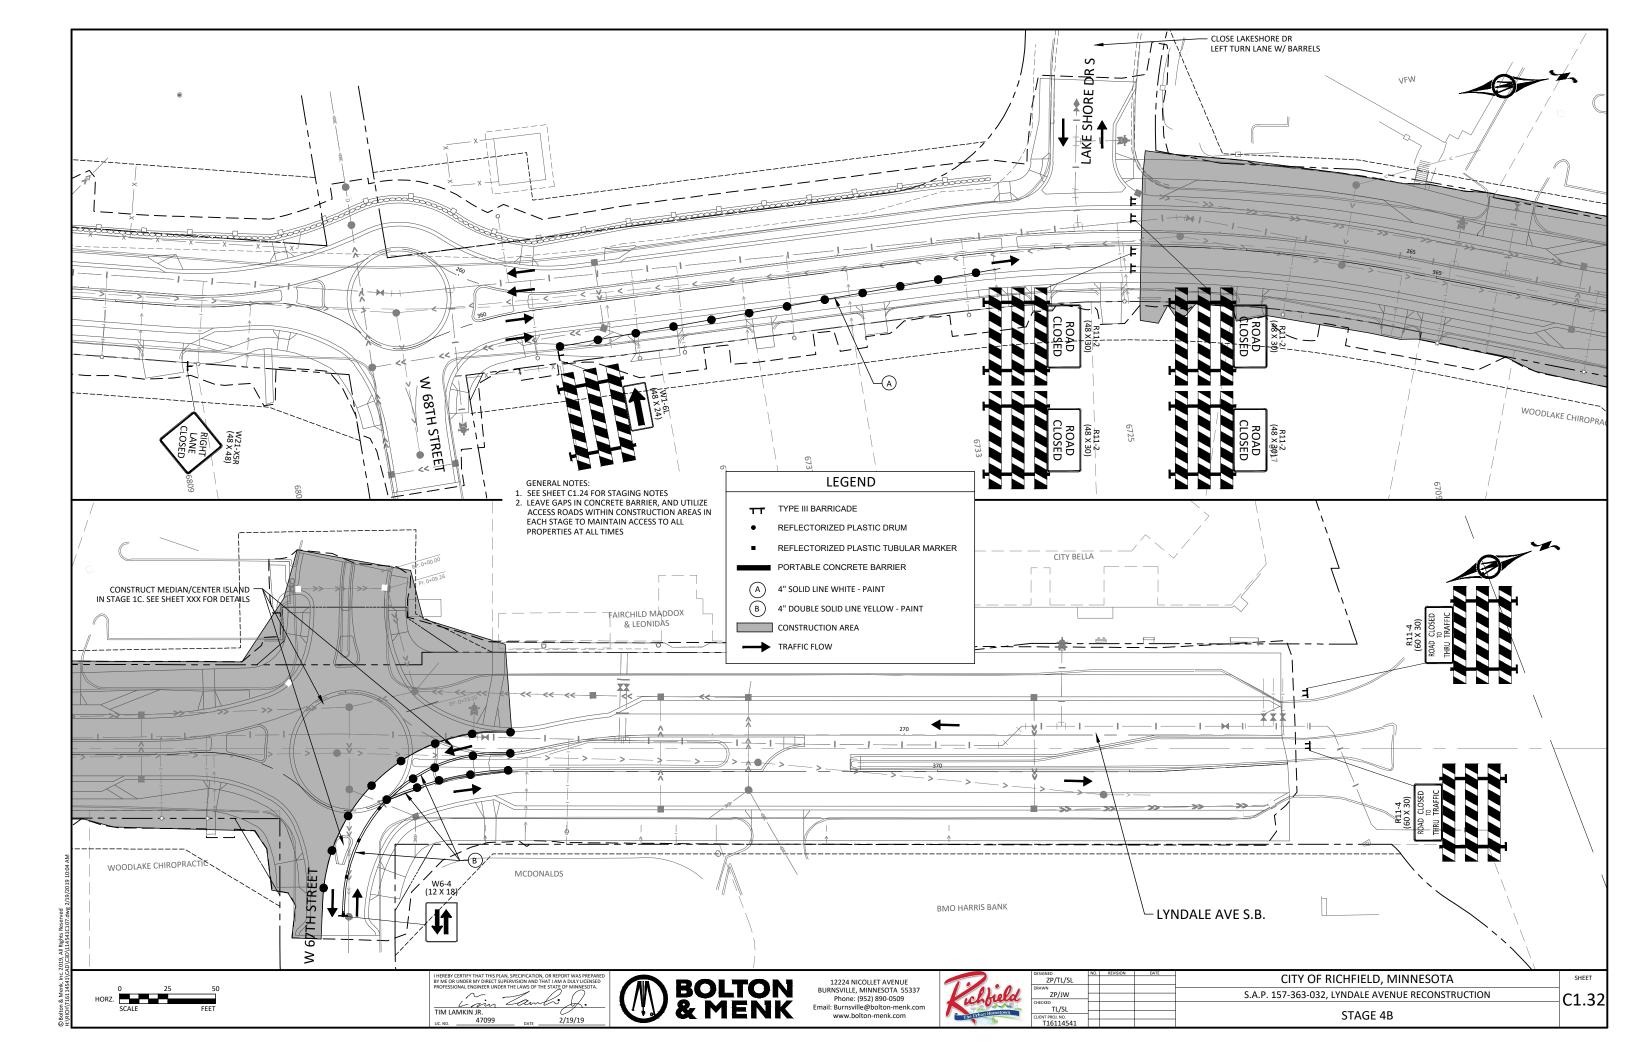


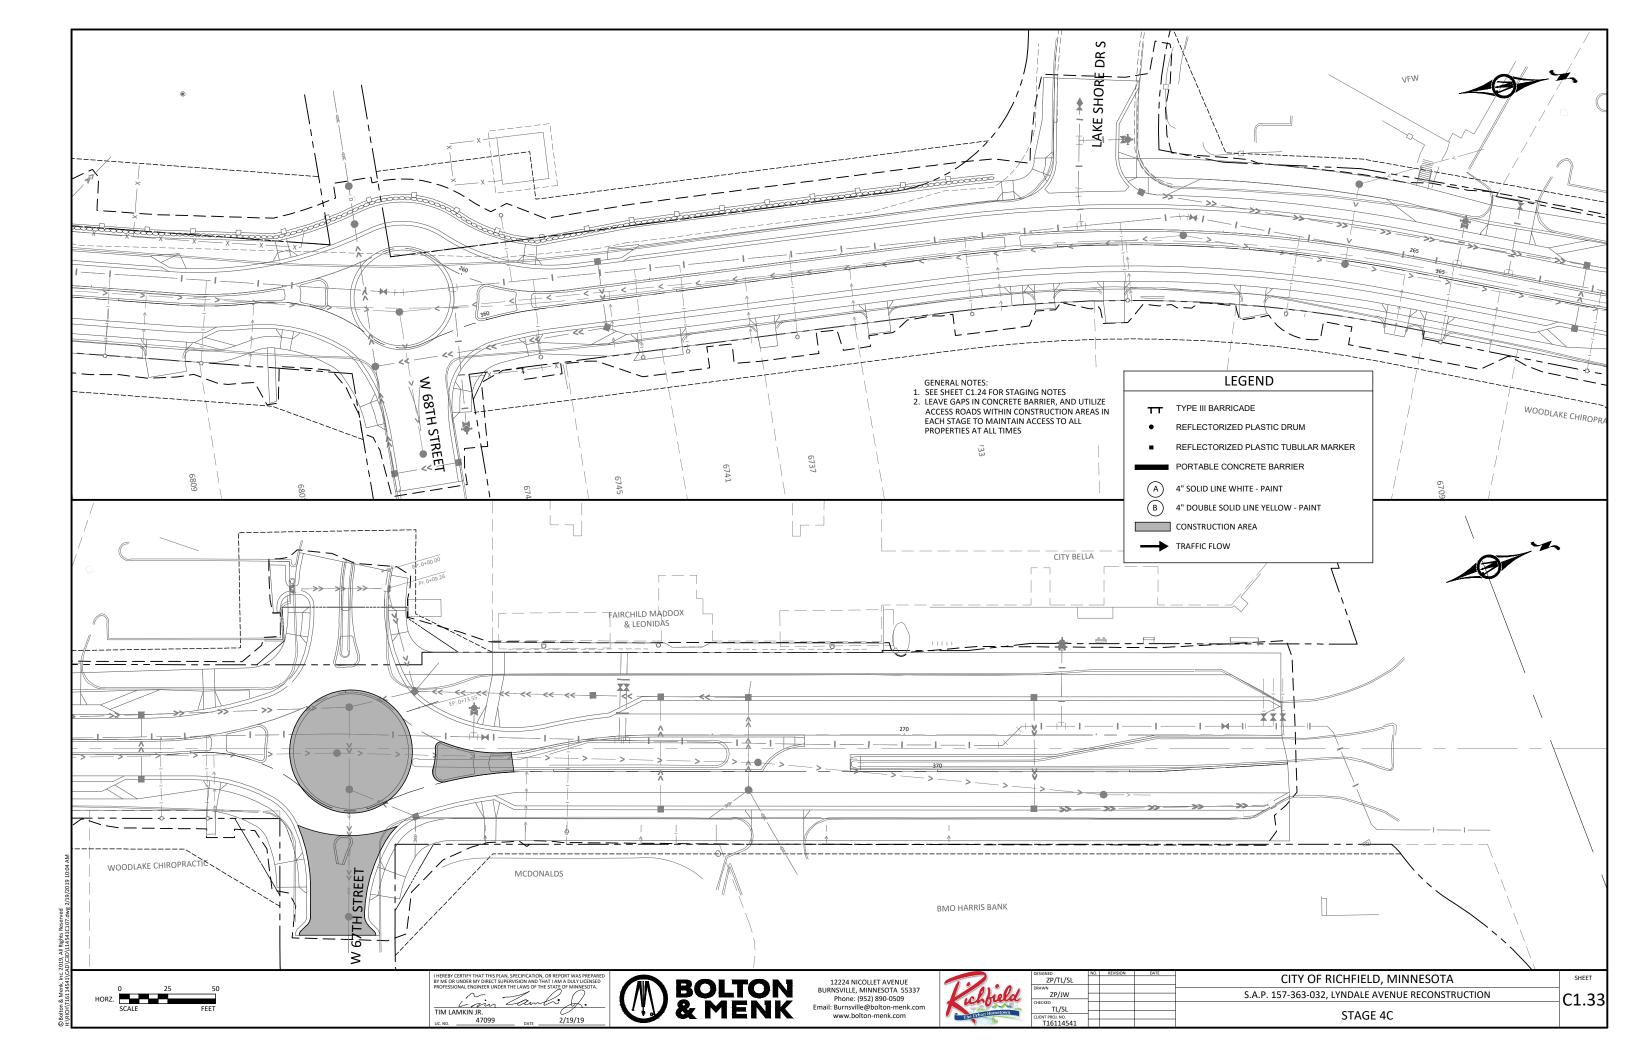


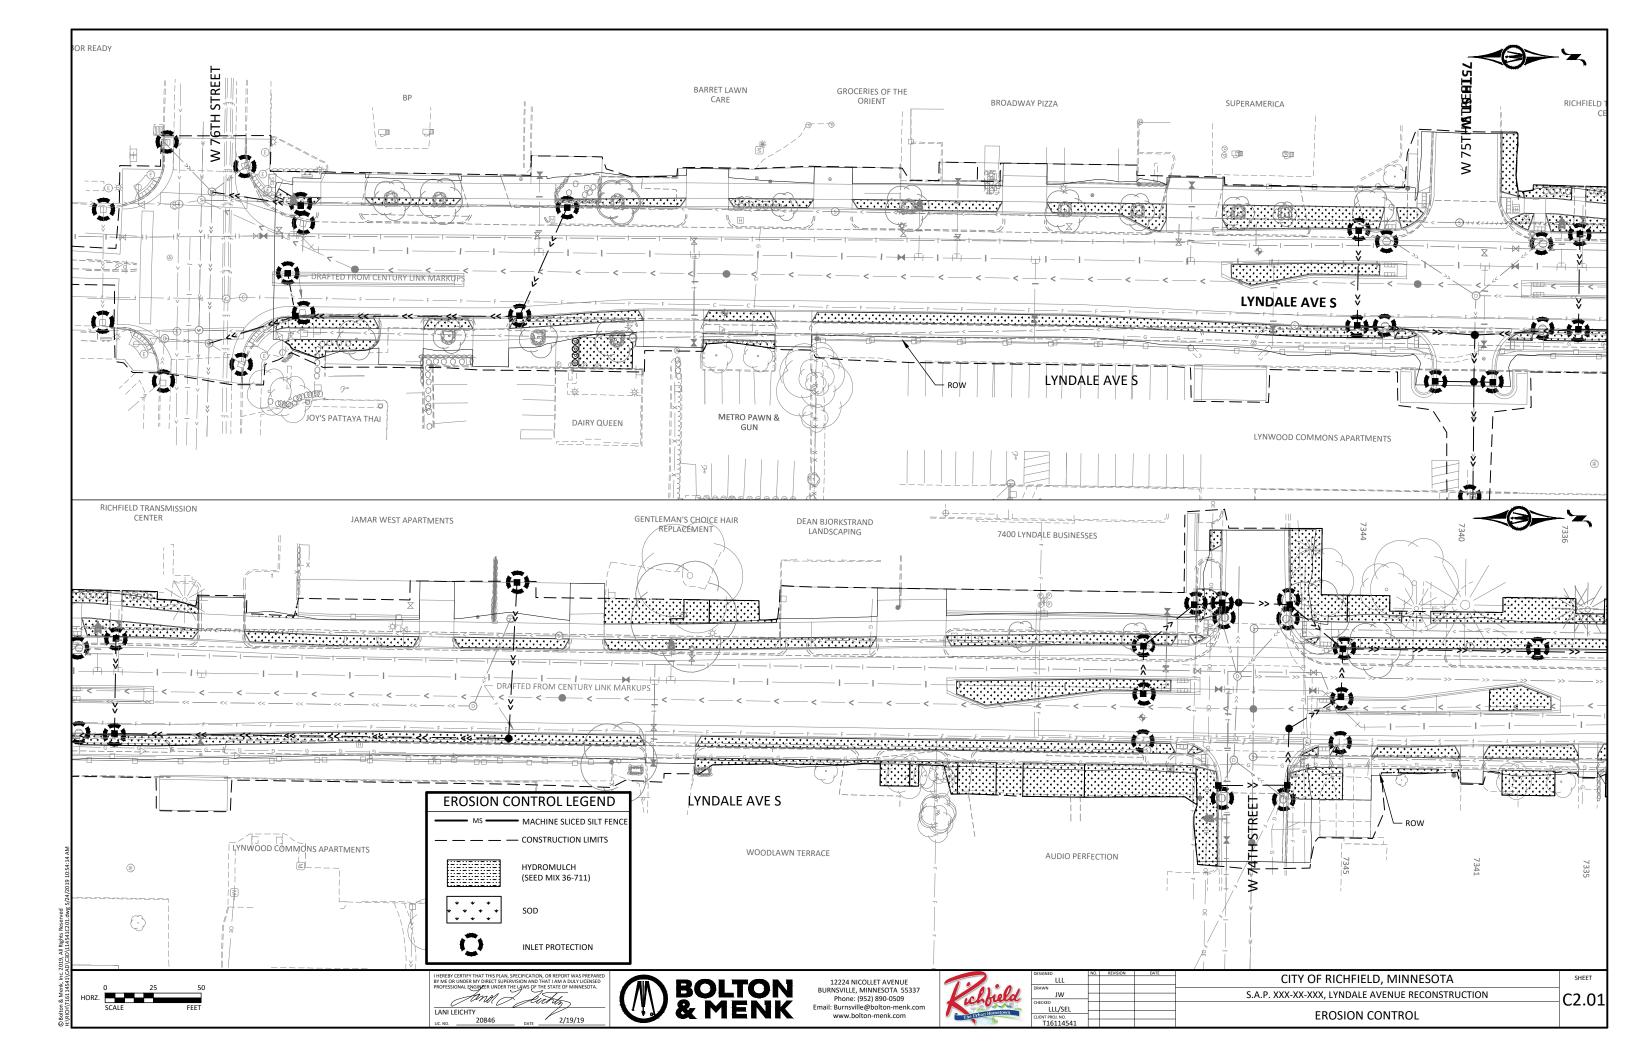

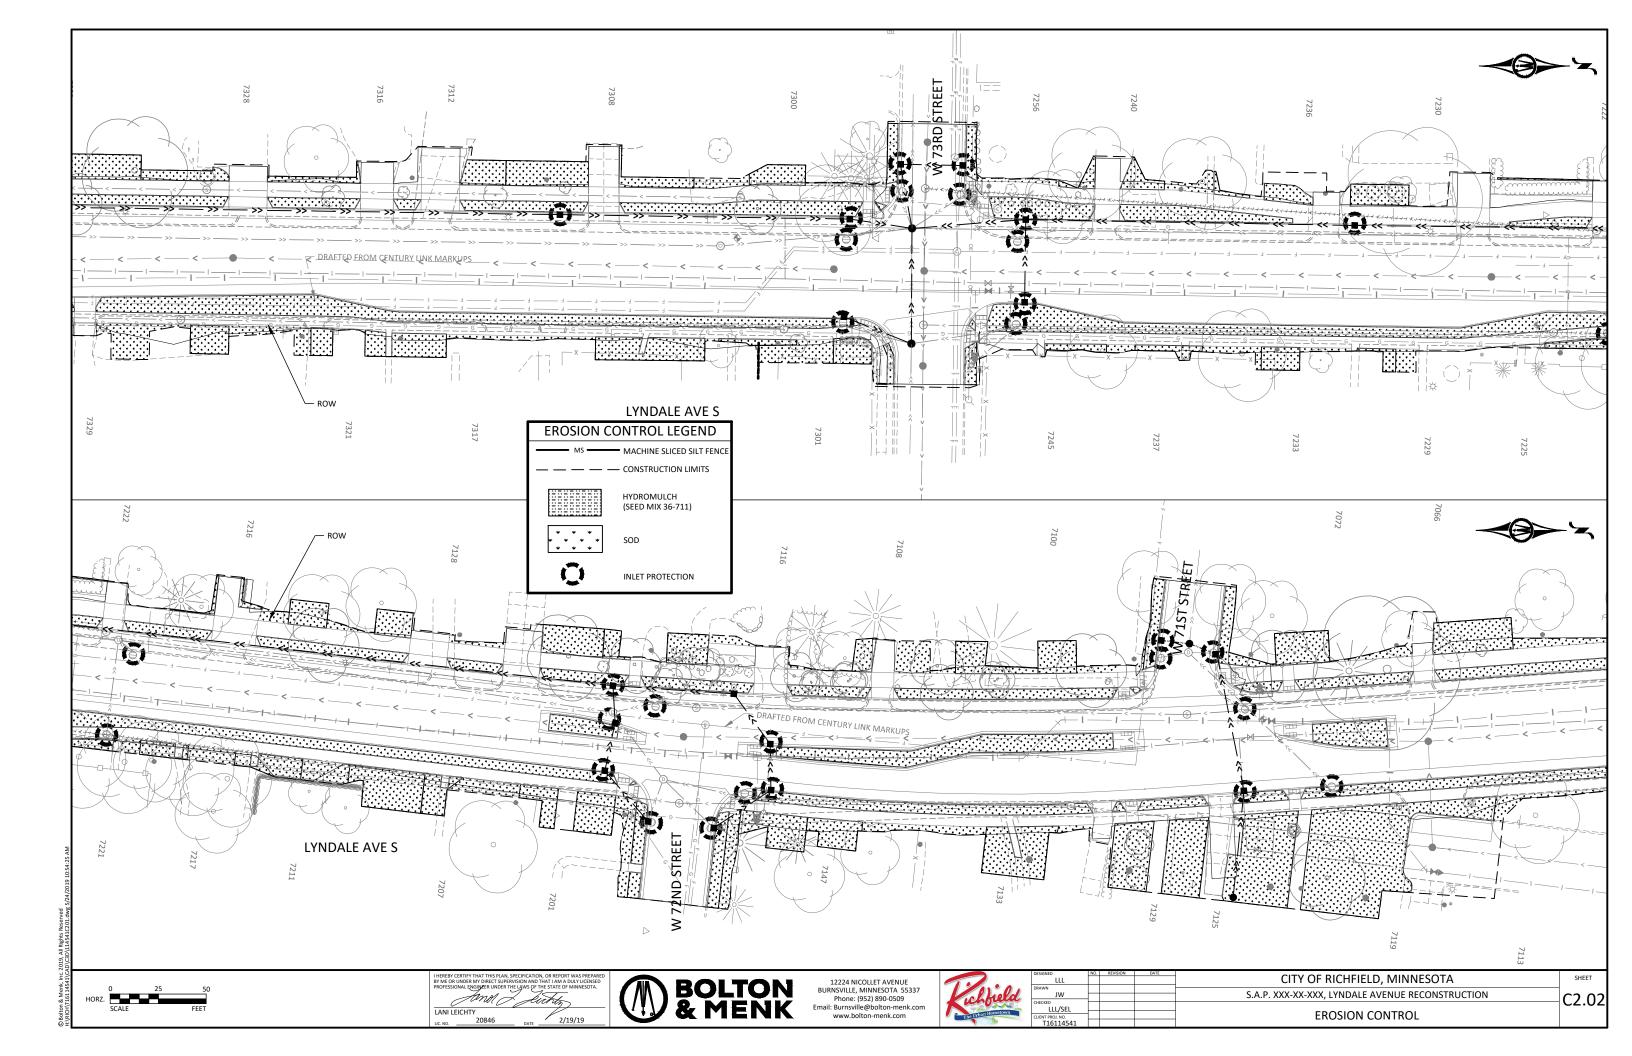

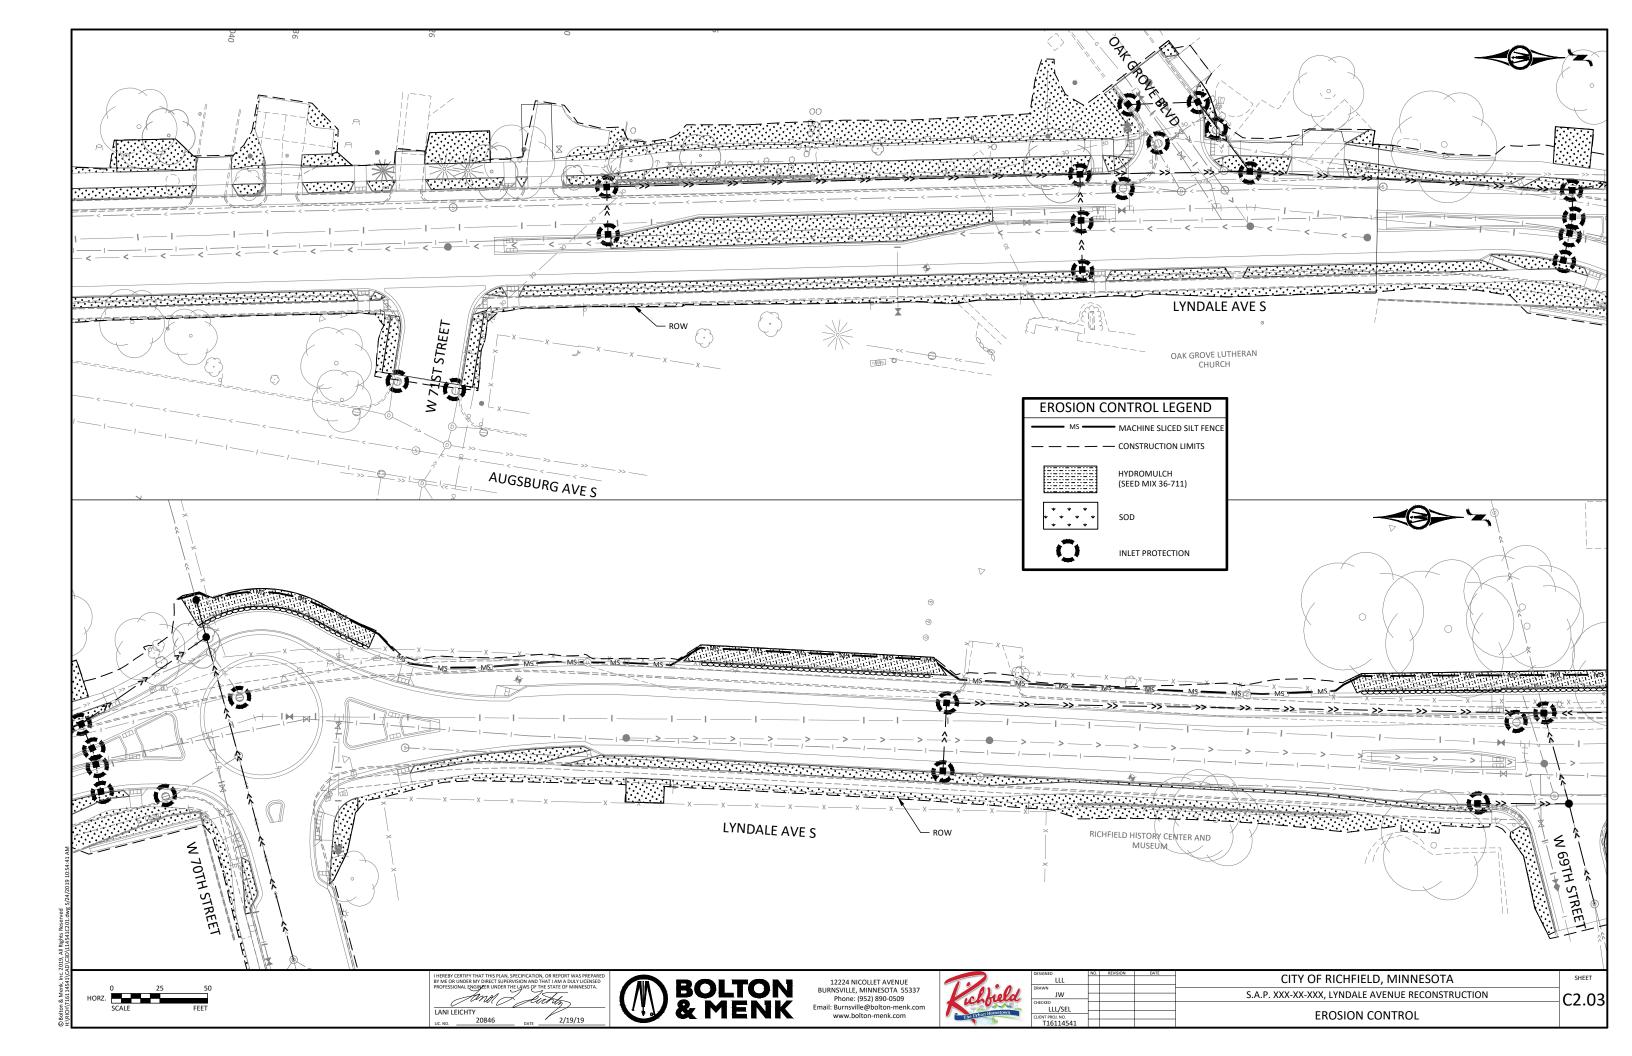

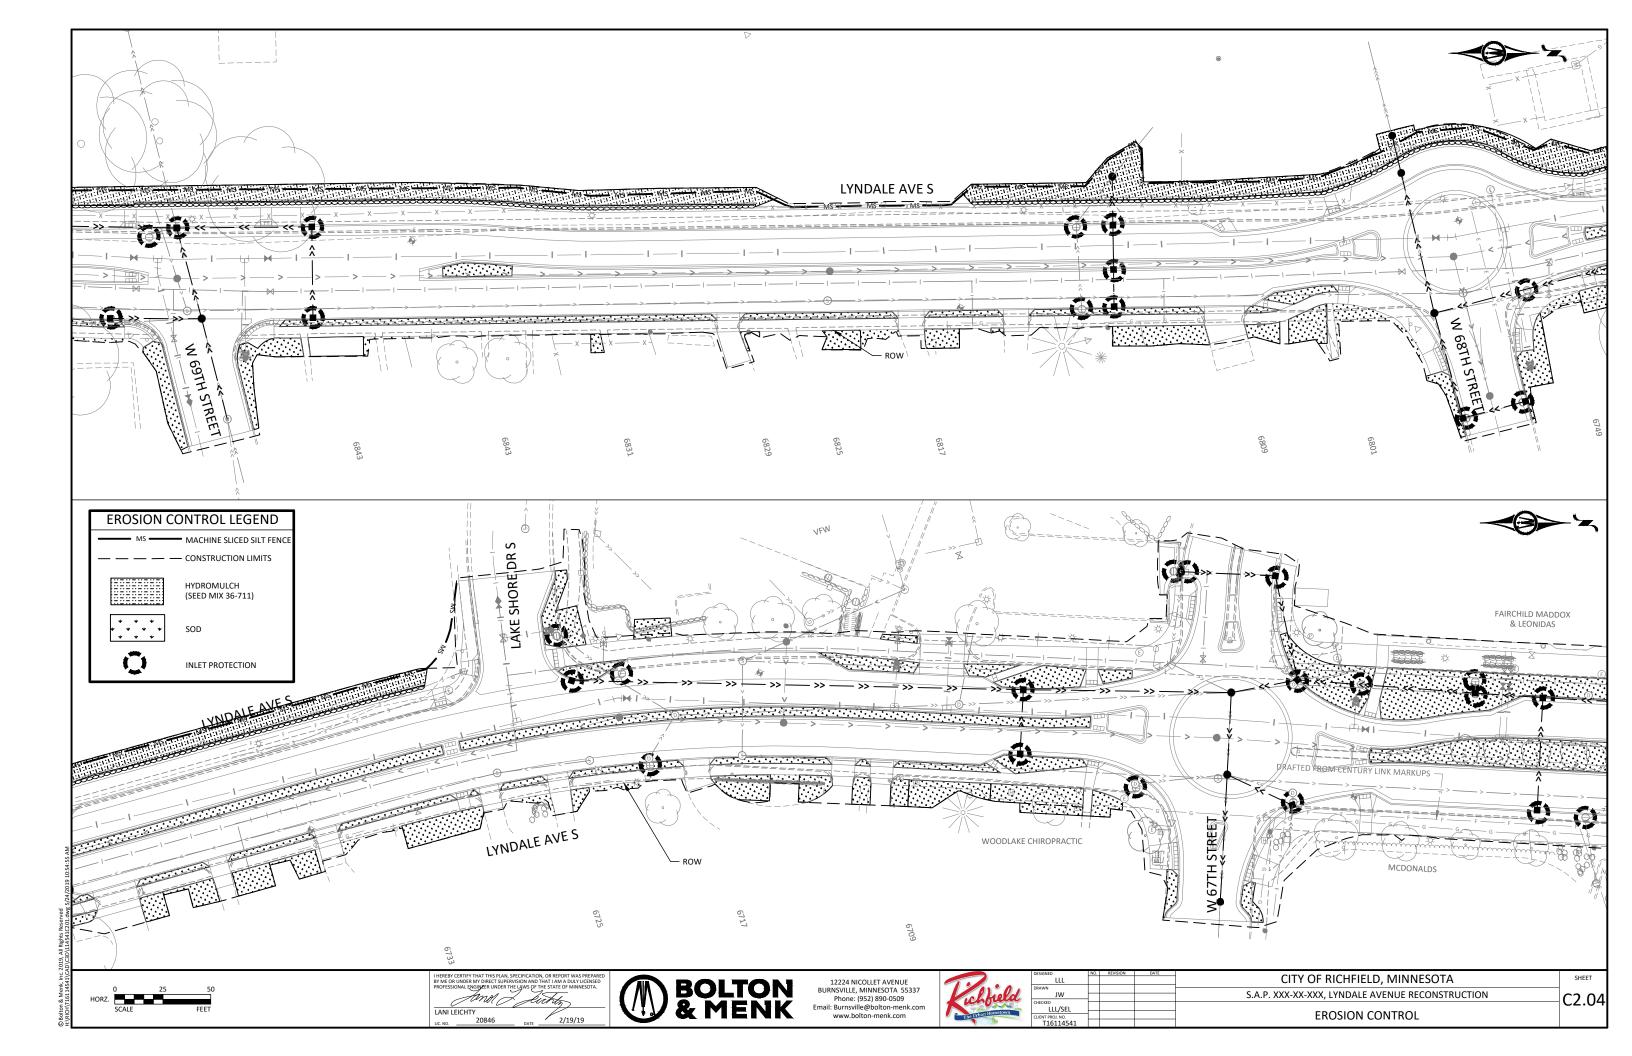

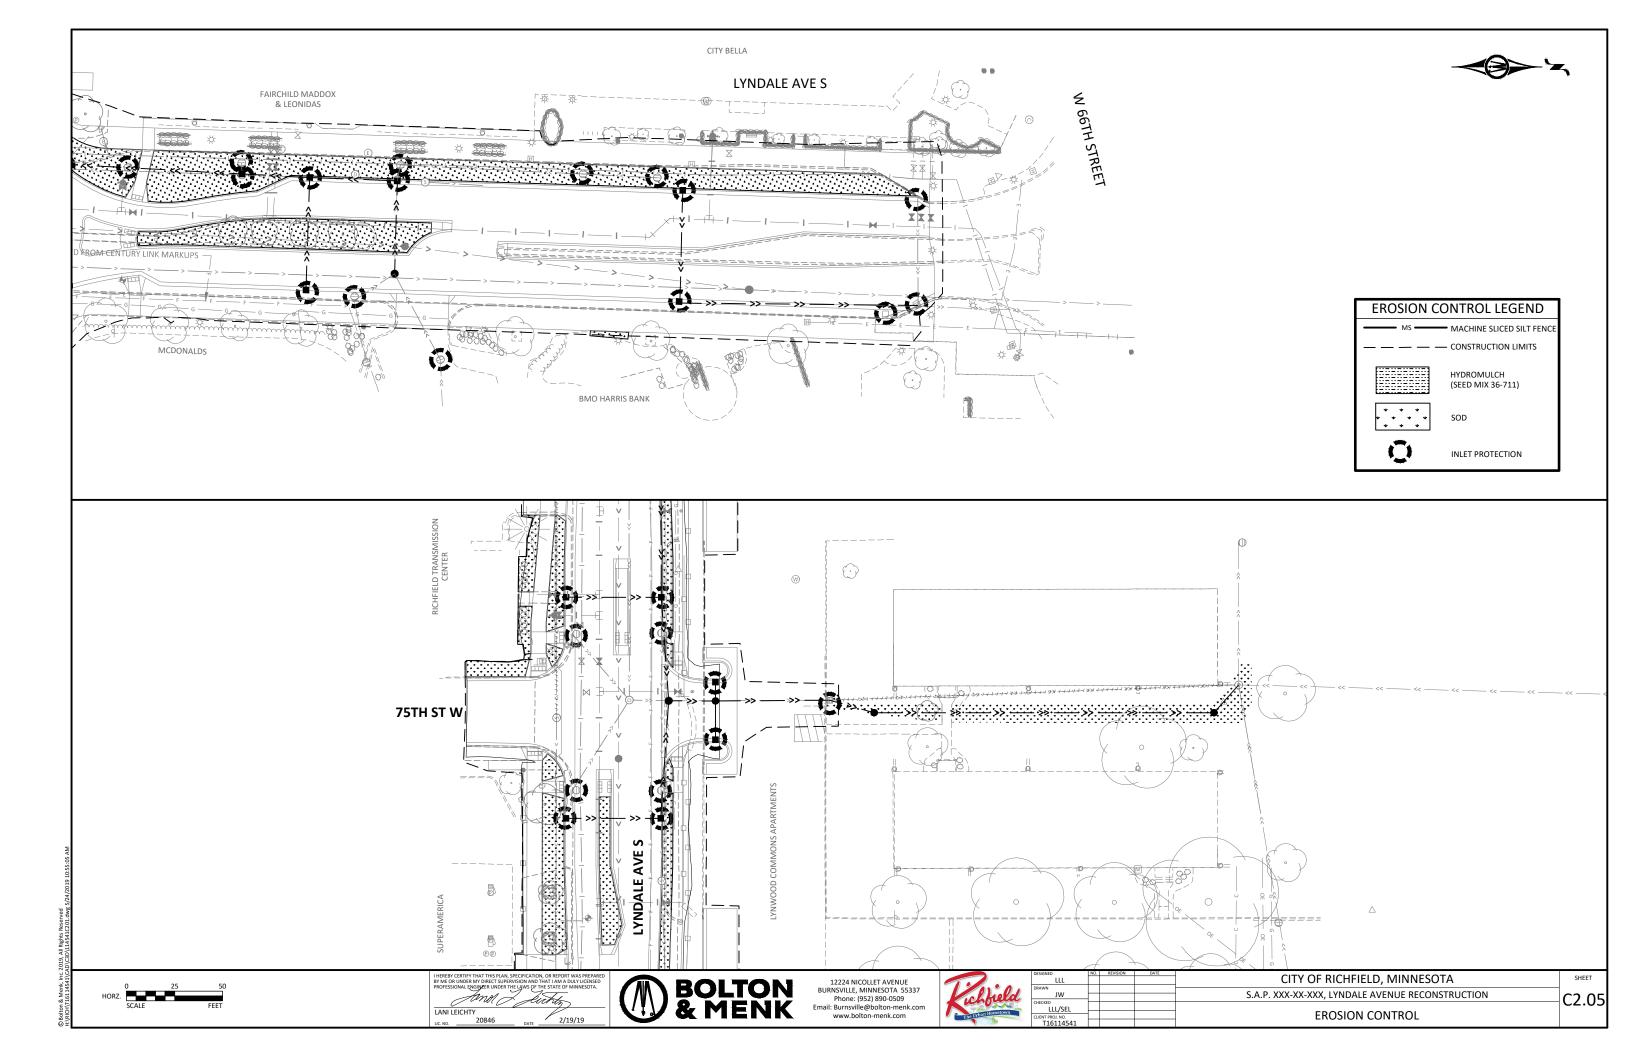

STORMWATER POLLUTION PREVENTION PLAN (SWPPP)

LYNDALE AVENUE RECONSTRUCTION 2019

CITY OF RICHFIELD HENNEPIN COUNTY, MINNESOTA

University of Minnesota

Lanol Leichty

Design of Construction SWPPP (May 31 2020)



The Contractor and Owner must apply for coverage under the MPCA's General Stormwater Permit for Construction Activity as required by the National Pollutant Discharge Elimination System (NPDES) Phase II program. Coverage under the permit will begin automatically 7 calendar days after the electronic submittal date or after the postmarked date of a complete application. [Longer time frames apply to sites that disturb areas greater than 50 acres.]

The Contractor shall provide one or more trained Construction SWPPP Manager(s) knowledgeable and experienced in the application of erosion prevention and sediment control BMPs that will oversee the implementation of the SWPPP, and the installation, inspection and maintenance of the erosion prevention and sediment control BMPs. A Construction SWPPP Manager must be available for an on-site inspection within 72 hours upon request by the MPCA.

	COMPANY	CONTACT PERSON	PHONE
OWNER:	City of Richfield	XXXXX	XXX-XXX-XXX
SWPPP DESIGNER:	Bolton & Menk, Inc.	Lanol Leichty	952-890-0509
CONTRACTOR:	TBD		
CONSTRUCTION SWPPP MANAGER:	TBD		
PARTY RESPONSIBLE FOR LONG TERM O&M:	City of Richfield	XXXXX	XXX-XXX-XXXX

The SWPPP Designer and Construction SWPPP Manager must have appropriate training. Documentation showing training commensurate with the job duties and responsibilities is required to be included in the SWPPP prior to any work beginning on the site. Training documentation for the SWPPP Designer is included on this sheet. The Contractor shall attach training documentation to this SWPPP for the Construction SWPPP Manager prior to the start of construction. This information shall be kept up to date until the project NOT is filed.

ADDITIONAL COMPENSATION

Payment for all work associated with Erosion and Sediment Control shall be as described in the Project Manual. Unless otherwise authorized by the Owner no additional payment shall be made for any work required to administer and maintain the site erosion and sediment control in compliance with the Minnesota Pollution Control Agency (MPCA) - General Stormwater Permit for Construction Activity (MN R100001) including but not limited to inspection, maintenance, and removal of BMPs or addition of BMPs to accommodate Contractor phasing.

SPECIAL ENVIRONMENTAL CONSIDERATIONS:


1)	Was an environmental review required for this project or any part of a common plan of development or sale that includes all or any portion of this project?	NO
2)	Does any portion of the site have the potential to affect threatened or endangered species or their critical habitat?	NO
3)	Does any portion of this site discharge to a Calcareous fen.	NO
4)	Will any portion of the site potentially affect properties listed on the National Register of Historic Places or a known or discovered archeological site?	NO
5)	Have any Karst features have been identified in the project vicinity?	NO
6)	Is compliance with temporary or permanent stormwater management design requirements infeasible for this project?	NO
7)	Has the MN DNR promulgated "work in water restrictions" for any Public Water this site disharges to during fish spawning?	NO

GENERAL STORMWATER DISCHARGE REQUIREMENTS

All requirements listed in Part III of the Permit for the design of the permanent stormwater management system and discharge have been included in the preparation of this SWPPP. These include but are not limited to::

- The expected amount, frequency, intensity, and duration of precipitation
- The nature of stormwater runoff and run-on at the site
- Peak flow rates and stormwater volumes to minimize erosion at outlets and downstream channel and stream bank erosion
- The range of soil particle sizes expected to be present on the site.



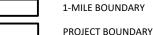

IMPAIRED, SPECIAL OR PROTECTED WATERS

NATIONAL WETLANDS INVENTORY

CALCAREOUS FEN

RECEIVING WATERS

PROJECT AREAS:

Total Project Size (disturbed area) =	12.3	ACRES
Existing area of impervious surface =	10.6	ACRES
Post construction area of impervious surface =	10.8	ACRES
Total new impervious surface area created =	0.2	ACRES

Planned Construction Start Date Estimated Construction Completion Date

PERMANENT STORMWATER MANAGEMENT SYSTEM:

Type of storm water management used if more than 1 acre of new impervious surface is created.

XX/XX/XXXX

XX/XX/XXXX

	Wet Sedimentation Basin
	Infiltration/Filtration
	Regional Pond
Х	Permanent Stormwater Management Not Required

PROJECT LOCATION:

COUNTY	TOWNSHIP	RANGE	SECTION	LATITUDE	LONGITUDE
Hennepin	28	24	27, 28, 33. 34	44.877667	-93.289039

BMP SUMMARY	QUANTITY	UNIT
SILT FENCE	1750	LF
INLET PROTECTION	58	EACH
SODDING, TYPE LAWN	11,500	SQ YD


DESCRIPTION OF CONSTRUCTION ACTIVITIES AND STORMWATER MANAGEMENT:

Construction activities include: Removals, site grading, replacement of sanitary sewer, water main and storm sewer. temporary erosion and sediment control, and permanent stabilization.

This project involves reconstructing Lyndale Avenue from 76th Avenue West to 66th Street West. Road safety improvements will be made, which include left and right hand turn lanes, roundabouts and center medians. Additional storm sewer will be added to improve capture of surface runoff. The drainage patterns and discharge locations will remain as they currently exist.

The following documentation will be retained for a period of not less than 3-years from the date of submittal of the NOT in compliance with Part III.E of the Permit.

- The final SWPPP
- Copies of all stormwater related permits required for the project
- Records of all inspection and maintenance conducted during construction
- Copies of all permanent operation and maintenance agreements; including all
- right-of-way, contracts, covenants and other binding requirements regarding perpetual maintenance, and
- All required calculations for design of the temporary and permanent BMPs

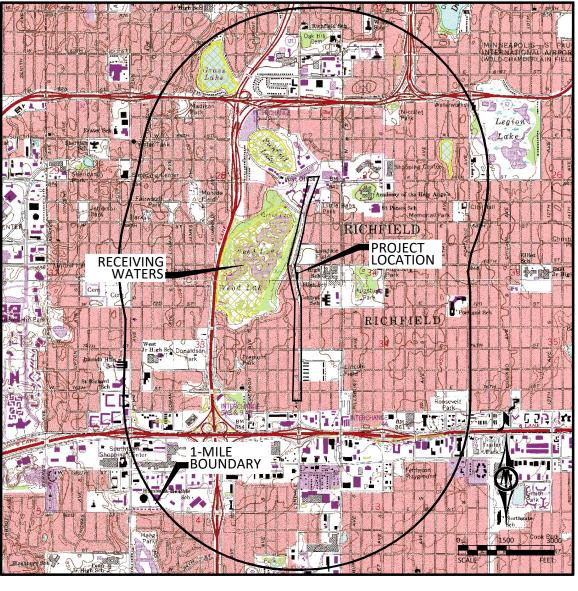

RECEIVING WATERS:

Receiving waters, including surface water, wetlands, Public Waters, and stormwater ponds, are identified on the USGS 7.5 min guad map within one mile of the project boundary. Receiving waters that are impaired, the impairment, and WLA are listed as follows. All specific BMPs relative to construction activities listed in this permit for special and impaired waters have been incorporated into this plan. All specific BMPs listed in approved TMDLs and those BMPs listed for construction related waste load allocations have also been incorporated

NAME OF WATER BODY	TYPE (ditch, pond, wetland, lake, etc.)	Appendix A Special Water?	Flows to Impaired Water Within 1 Mile?	USEPA Approved TMDL?
Wood Lake	Lake	No	No	No
Impairments: None				

IMPLEMENTATION SCHEDULE AND PHASING: The Contractor is required to provide an updated schedule and site management plan meeting the minimum requirements of Section 1717.2.C and 1717.2.D of the Minnesota 2016 Standard Specifications.

- 1) Submit SWPPP Updates to Engineer. Submittal shall include any requested changes to the SWPPP, including but not limited to: Trained Personnel, Locations for Stockpiles, Concrete Washout, Sanitation Facilities, Types and Locations of Erosion & Sediment Control. Failure to submit updates shall be considered acceptance of the SWPPP as designed with no changes.
- 2) Install perimeter sediment control, inlet protection, and construction exit. Remove bituminous and concrete pavement.
- Install sanitary sewer and watermain.
- Install storm sewer
- Add additional temporary BMPs as necessary during construction based on inspection reports. 7) Install curb and gutter.
- Install bituminous pavement. 9) Ensure final stabilization measures are complete
- 10) Remove inlet protection. 11) Provide digital copy of all Field SWPPP Documentation including Inspection Reports and SWPPP Revisions to the Owner.
- 12) Submit Notice of Termination (NOT) to MPCA. NOTE: The NOT must be submitted to MPCA before Final Stabilization is considered complete.





DESIGNED	NO.	ISSUED FOR	DATE	OUTLY OF BUSINESS B. AMAINIES OTA	
LLL				CITY OF RICHFIELD, MINNESOTA	SHEET
DRAWN					
LLL				LYNDALE AVENUE RECONSTRUCTION	C2 0C
CHECKED				25/12/1/21/22/1/20/1/20/1/20/1/20/1/20/1/	C2.06
LLL					C2.00
CLIENT PROJ. NO.				SWPPP - PROJECT INFORMATION	
T16 114541				34411 11(6)261 11(1 6)1(1)	

Information contained in this SWPPP narrative sheet summarizes requirements of the GENERAL PERMIT AUTHORIZATION TO DISCHARGE STORMWATER ASSOCIATED WITH CONSTRUCTION ACTIVITY UNDER THE NATIONAL POLLUTANT DISCHARGE ELIMINATION SYSTEM/STATE DISPOSAL SYSTEM PROGRAM - Permit No: MN RI0000l as they apply to this project. All provisions of the permit including those not specifically cited herein shall apply to this project. The Contractor is responsible to be familiar with and comply with all conditions of the permit. The full text of the permit is available at:

http://www.pca.state.mn.us/index.php/water/water-types-and-programs/stormwater/constructionstormwater/mpca-to-re-issue-construction-stormwater-general-permit.html

SWPPP AMENDMENTS

Permittee must amend SWPPP as necessary to include additional requirements to correct problems identified or address the following situations.

- 1. There is a change in design, construction, operation, maintenance, weather or seasonal conditions.
- 2. Inspections or investigations by site owner or operators, USEPA or MPCA officials determine the SWPPP is not minimizing discharge of pollutants to surface waters or underground waters or discharges are causing water quality standard exceedances.
- 3. The SWPPP is not achieving the objectives of minimizing pollutants in stormwater discharges associated with construction activity, or the SWPPP is not consistent with the terms and conditions of the permit.
- 4. The MPCA determines that the project's stormwater discharges may cause, have reasonable potential to cause, or contribute to non-attainment of any applicable water quality standard, or the SWPPP does not incorporate the applicable requirements of the permit.

EROSION PREVENTION PRACTICES

The location of areas not to be disturbed must be delineated on the project before site work begins.

Disturbance on steep slopes (>33.3%) shall be minimized. Where required, techniques such as phasing and stabilizing practices designed for steep slopes shall be used

All exposed soils must be stabilized as soon as possible, but in no case later than 14 days after the construction activity has temporarily or permanently ceased.

For public waters that have been promulgated "work in water restrictions" during fish spawning time frames, all exposed soil areas that are within 200 feet of the water's edge, and drain to these waters must complete stabilization within 24-hours during the time period.

Stormwater conveyance channels shall be routed around unstabilized areas. Erosion controls and velocity dissipation devices shall be used at outlets within and along the length of any constructed conveyance channel.

The normal wetted perimeter of all ditches or swales, including storm water management pond slopes, that drain waters from the site must be stabilized within 200' of any property edge or discharge point, including storm sewer inlets, within 24 hours of connection.

Stabilization of the remaining portions of any temporary or permanent ditches or swales within 14 calendar days after connecting to a surface water or property edge and construction in that portion of the ditch has temporary

Temporary or permanent ditches or swales used as sediment containment during construction do not need to be stabilized during temporary period of use and shall be stabilized within 24 hours after no longer used as sediment

Mulch, hydromulch, tackifier, or similar practice shall not be used in any portion of a temporary or permanent drainage ditch. Refer to erosion and sediment control plan for temporary and permanent stabilization measures for ditches and swales.

Stormwater discharges shall be directed to vegetated areas where feasible. Velocity dissipation devices shall be used at discharge point.

Phased construction will be used to extent practical or as indicated in the plans to minimize exposed soils.

Rapid stabilization shall be of type and quantity indicated in the project specifications. Additional rapid stabilization may be necessary to minimize erosion throughout the duration of the project. Type and quantity shall be determined by the engineer or inspector prior to installation. In extreme cases, the contractor shall use any available rapid stabilization to immediately mitigate erosion, then further remedy the situation with approval by owner or engineer.

SEDIMENT CONTROL PRACTICES

Practices must be established on all down gradient perimeters and be located up gradient of any buffer zones. Perimeter controls must be in place before up gradient land- disturbing activities begin and shall remain in place until final stabilization.

All sediment controls practices shall be re-installed if they have been adjusted or removed to accommodate shortterm activities and replaced immediately after the short term activity has ceased. Short term activities shall be performed as quickly as possible. Sediment control practices shall be re-installed even before the next precipitation event if the activity is not complete.

All storm drains must be protected by appropriate BMPs during construction until all sources to the inlet have

been stabilized. Inlet protection may be removed for specific safety concerns identified by the Permittee or jurisdictional authority. The removal shall be documented in the SWPPP and retained on site. Temporary stockpiles must have silt fence or other effective sediment controls and shall not be placed in surface waters or

Vehicle tracking BMPs shall be installed to minimize track out of sediment from the construction site. Method shall be approved by engineer prior to commencement of construction activities. Street sweeping shall be used if vehicle tracking BMPs are not adequate to prevent sediment from being tracked onto the street.

Soil compaction shall be minimized and topsoil shall be preserved, unless infeasible or if construction activities dictate soil compaction or topsoil stripping.

A 50 foot natural buffer, or redundant BMPs (where a buffer is infeasible) must be maintained when a surface water is located within 50 feet of disturbance activities and site runoff flows to the surface water.

If polymers, flocculants, or other sedimentation treatment chemicals are used on site, 1) conventional erosion and sediment controls shall be sowed prior to chemical placement. 2) chemicals shall be chosen based on soil types. and expected turbidity, pH, and flow rate of stormwater flowing into the treatment system, and 3) chemicals shall be used with accepted engineering practices and dosing specifications.

TEMPORARY SEDIMENTATION BASINS

The temporary sedimentation basin shall be constructed and made operational prior to disturbance of 10 or more acres draining to a common location.

Temporary sedimentation basins are required prior to runoff leaving the construction site or entering surface waters when 10 or more acres of disturbed soils drain to a common location. The basin must provide 3,600 cubic feet of "storage below the outlet per acre drained. If hydraulic calculations are available, the temporary sedimentation basin must provide a storage volume equivalent to the 2-year, 24-hour storm, but in no case less than 1800 cubic feet per acre drained. The temporary sedimentation basin must be constructed and made operational concurrent with the start of soil disturbance up gradient of the pond. The temporary sedimentation basin shall be designed to prevent short circuiting. The outfall shall be designed to remove floatable debris, allow for complete drawdown of the pond for maintenance activities, and have energy dissipation. The emergency spillway shall be stabilized.

Temporary sedimentation basins shall be situated outside of surface waters and any required buffer zone, and must be designed to avoid draining wetlands, unless the impact is in compliance with the requirements of this

Excessive sediment-laden water that is not properly filtered will not be permitted to discharge from site.

DEWATERING AND BASIN DRAINING

Turbid or sediment-laden waters related to dewatering or basin draining shall be discharged to a temporary or permanent sedimentation basin on the project site unless infeasible. The temporary or permanent basin may discharge to surface waters if the basin water has been visually checked to ensure adequate treatment has been obtained in the basin and that the nuisance conditions will not result from the discharge. Discharge points shall be adequately protected from erosion and proper velocity dissipation provided.

All water from dewatering or basin-draining activities must be discharged in a manner that does not cause nuisance conditions, erosion in the receiving channels or on down slope properties, or inundation in wetlands causing significant adverse impacts to the wetland.

If filters with backwash waters are used, the backwash water shall be hauled away for disposal, returned to the beginning of the treatment process, or incorporated into site in a manner that does not cause erosion. Backwash water may be discharged to sanitary sewer if permission is granted by the sanitary sewer authority.

POLLUTION PREVENTION

Building products that have the potential to leach pollutants must be under cover to prevent discharge or protected by an effective means designed to minimize contact with stormwater.

Pesticides, herbicides, insecticides, fertilizers, treatment chemicals, and landscape materials must be under cover.

Hazardous materials and toxic waste must be properly stored in sealed containers to prevent spills, leaks or other discharge. Restricted access storage areas must be provided to prevent vandalism.

Solid waste must be stored, collected and disposed of in compliance with Minn. R. CH 7035.

Portable toilets must be positioned so that they are secure and will not be tipped or knocked over. Sanitary waste must be disposed of properly in accordance with Minn. R. CH 7041.

Discharge of spilled or leaked chemicals, including fuel, from any area where chemicals or fuel will be loaded or unloaded shall be prevented using drip pans or absorbents. Supplies shall be available at all times to clean up discharged materials and that an appropriate disposal method must be available for recovered spilled materials.

Exterior vehicle or equipment washing on the project site shall be limited to a defined area of the site. Runoff from the washing area shall be contained in a sediment basin or other similarly effective controls and waste from the washing activity must be properly disposed of. No engine degreasing is allowed on site. Effective containment for all liquid and solid wastes generated by concrete and other washout operations related to construction activity shall be effectively contained. Liquid and solid washout waste shall not contact the ground, and containment must be designed so that it does not result in runoff from the washout operations or areas. A sign must be installed adjacent to each washout facility that requires site personnel to utilize the proper facilities for disposal of concrete and other washout wastes.

INFESTED WATERS:

MN DNR permits are not valid for work in waters that are designated as infested waters unless accompanied by an Infested Waters Permit or written notification has been obtained from MN DNR stating that such permit is not required. There is no exception for pre-existing permits. If a MN DNR Permit has been issued for the project and the water is later designated as infested, the Contractor shall halt all work covered by the MN DNR Permit until until such time as an Infested Waters Permit is obtained or that written notification is obtained stating that such permit is not required.

INSPECTION & MAINTENANCE

A trained person shall routinely inspect the entire construction site at least once every 7 days during active construction and within 24-hours after a rainfall event greater than 0.5 inches in 24 hours. Following an inspection that occurs within 24-hours after a rainfall event, the next inspection must be conducted within 7 days.

All inspections and maintenance conducted during construction must be recorded within 24 hours in writing and records must be retained with the SWPPP. Inspection report forms are available in the Project Specifications. Inspection report forms other than those provided shall be approved by the engineer.

Where parts of the project site have permanent cover, but work remains on other parts of the site, inspections may be reduced on these areas to once per month.

Where the site has permanent cover on all exposed areas and no construction activity is occurring anywhere on site, the site must be inspected during non-frozen conditions at least once per month for 12 months. Following the 12th month of permanent cover and no construction activity, inspections shall be terminated until construction activity resumes or notification from MPCA has been issued that erosion has been detected at the

During frozen ground conditions, inspections may be suspended and shall resume within 24 hours after runoff occurs or 24 hours prior to resuming construction activity, whichever is first.

Inspection and maintenance shall resume until another Permittee has obtained coverage under this Permit or the project has undergone Final Stabilization, and an NOT has been submitted.

All erosion prevention and sediment control BMPs shall be inspected to ensure integrity and effectiveness during all routine and post-rainfall inspections. All non-functioning BMPs must be repaired, replaced, or supplemented with functional BMPs by the end of the next business day after discovery, or as soon as field conditions allow access.

All perimeter control devices must be repaired, replaced, or supplemented when they become non-functional or the sediment reaches one-half (1/2) of the height of the device. These repairs must be made by the end of the next business day after discovery, or as soon as field conditions allow

Temporary and permanent sediment basins must be drained and the sediment removed when the depth of sediment collected in the basin reaches one-half (1/2) the storage volume. Drainage and sediment removal must be completed within 72 hours of discovery, or as soon as field conditions allow.

Surface waters, including drainage ditches and conveyance systems, must be inspected for erosion and sediment deposition during each inspection. All deltas and sediment deposited in drainage ways, catch basins, and other drainage systems shall be removed. The removal and stabilization must take place within seven (7) days of discovery unless precluded by legal, regulatory, or physical access constraints. The Permittee is responsible for obtaining all applicable permits prior to conducting any work in surface waters.

Construction site vehicle exit locations must be inspected for evidence of off-site sediment tracking onto paved surfaces. Tracked sediment must be removed from all paved surfaces both on and off site within 24-hours of discovery, or if applicable, within a shorter time to comply with the permit.

Streets and other areas adjacent to the project must be inspected for evidence of off-site accumulations of sediment. If sediment is present, it must be removed in a manner and at a sufficient frequency to minimize off-site impacts.

All infiltration areas must be inspected to ensure that no sediment from ongoing construction activity is reaching the infiltration area and that equipment is not being driven across the infiltration area.


FINAL STABILIZATION

Final Stabilization is not complete until all of the following requirements have been met:

- 1. All soil disturbing activities at the site have been completed and all soils are stabilized by a uniform perennial vegetative cover with a density of 70% of its expected final growth density over the entire pervious surface area, or other equivalent means necessary to prevent soil failure under erosive conditions.
- 2. Permanent stormwater management system is constructed, meets all requirements of the Permit, and is operating as designed. Temporary or permanent sedimentation basins that are to be used as permanent water quality management basins have been cleaned of any accumulated sediment. All sediment has been removed from conveyance systems, and ditches are stabilized with permanent cover.
- 3. All temporary synthetic and structural erosion prevention and sediment control BMPs have been removed. BMPs designed to decompose on site may be left in place.
- 4. For residential construction only, individual lots are considered finally stabilized if the structure(s) are finished, temporary erosion protection and down gradient perimeter control has been completed and the residence has been sold to the homeowner. Also, the "Homeowner Fact Sheet" has been provided to the homeowner



DESIGNED	NO.	ISSUED FOR	DATE	CITY OF DICUFIED AMAINIFCOTA	SHEET
LLL				CITY OF RICHFIELD, MINNESOTA	SHEET
DRAWN LLL				LYNDALE AVENUE RECONSTRUCTION	
CHECKED				LTINDALE AVENUE RECONSTRUCTION	וכט כאו
LLL					C2.07
CLIENT PROJ. NO.				SWPPP - NARRATIVE	
T16.114541					

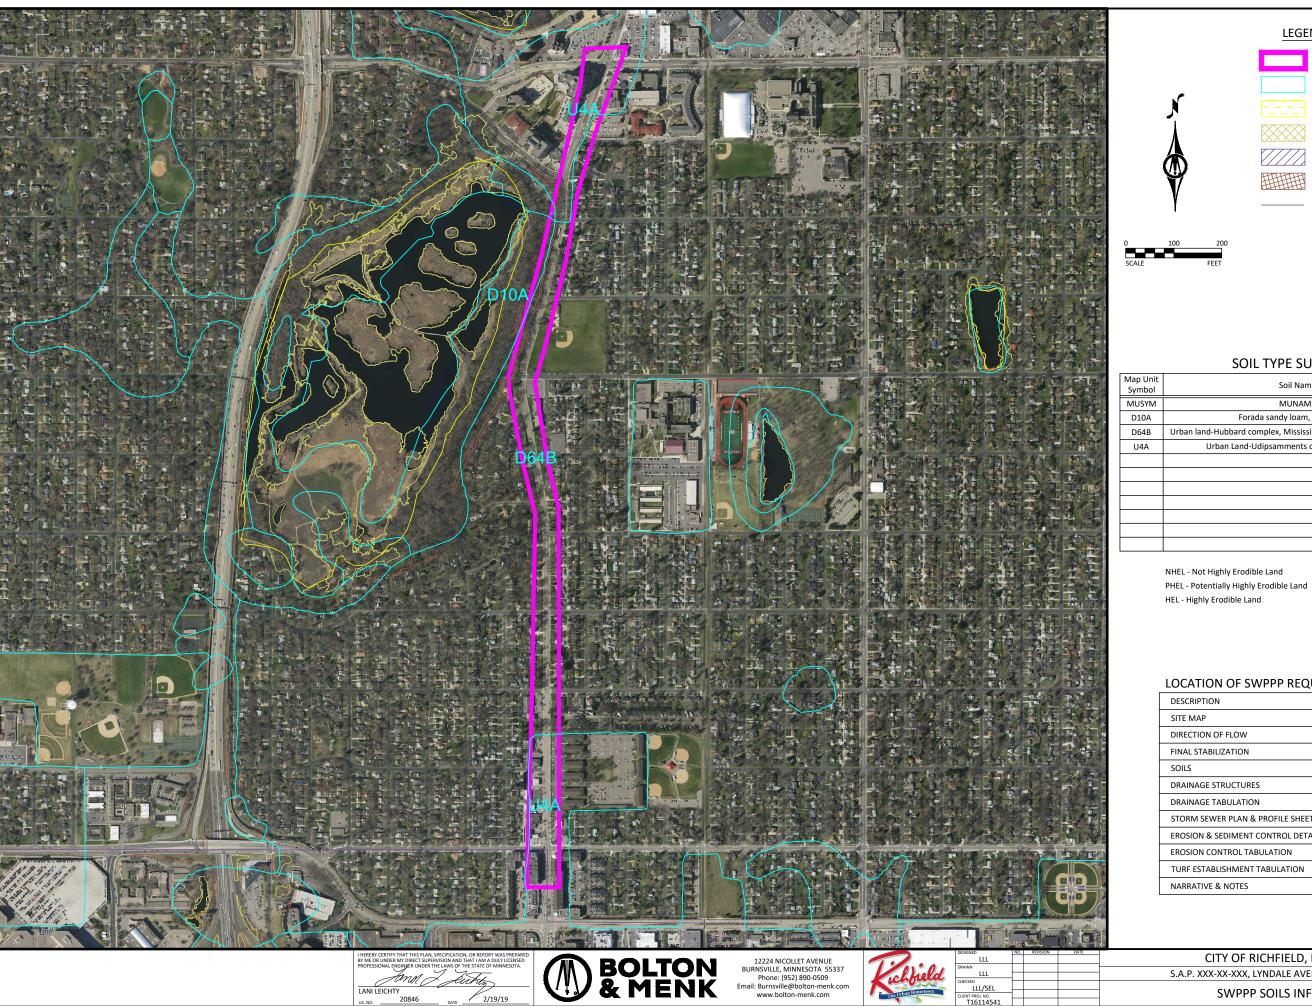

LEGEND

PROJECT BOUNDARY

SOIL TYPE

IMPAIRED, SPECIAL OR PROTECTED WATERS

NATIONAL WETLANDS INVENTORY

DWSMA, LOW VULNERABILITY

STEEP SLOPES (>33.3%)

RECEIVING WATERS


SOIL TYPE SUMMARY


Map Unit Symbol	Soil Name	Hyd. Soil Group	Erodibility
MUSYM	MUNAME	HYDGRP	MUHELCL
D10A	Forada sandy loam, 0-2% slopes	B/D	NHEL
D64B	Urban land-Hubbard complex, Mississippi River Valley, 0 - 8 % slopes	Α	NHEL
U4A	Urban Land-Udipsamments complex, 0-2% slopes		NHEL


LOCATION OF SWPPP REQUIREMENTS IN PROJECT PLAN


DESCRIPTION	SHEET NO.
SITE MAP	C2.01
DIRECTION OF FLOW	C2.XX
FINAL STABILIZATION	C2.XX
SOILS	C2.03
DRAINAGE STRUCTURES	C1.XX
DRAINAGE TABULATION	C1.XX
STORM SEWER PLAN & PROFILE SHEETS	C5.01 - C5.10
EROSION & SEDIMENT CONTROL DETAILS	C2.04
EROSION CONTROL TABULATION	C2.XX
TURF ESTABLISHMENT TABULATION	C2.XX
NARRATIVE & NOTES	C2.06 - C2.07


CITY OF RICHFIELD, MINNESOTA S.A.P. XXX-XXX, LYNDALE AVENUE RECONSTRUCTION C2.08 SWPPP SOILS INFORMATION

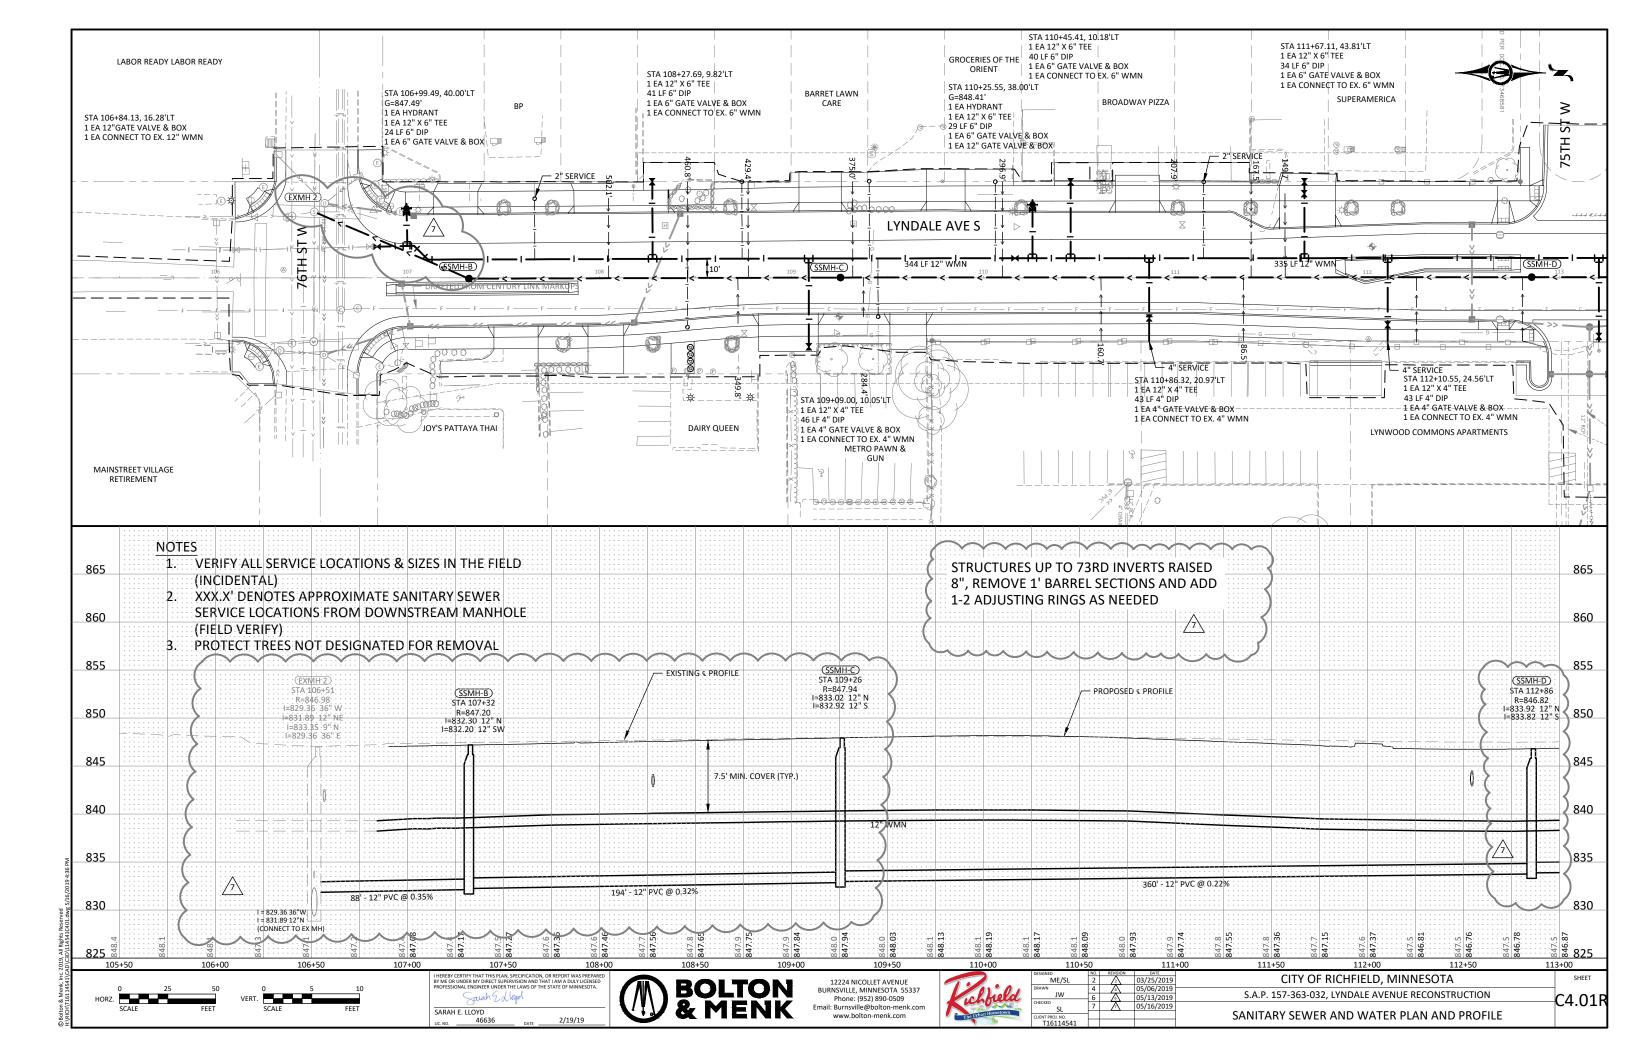


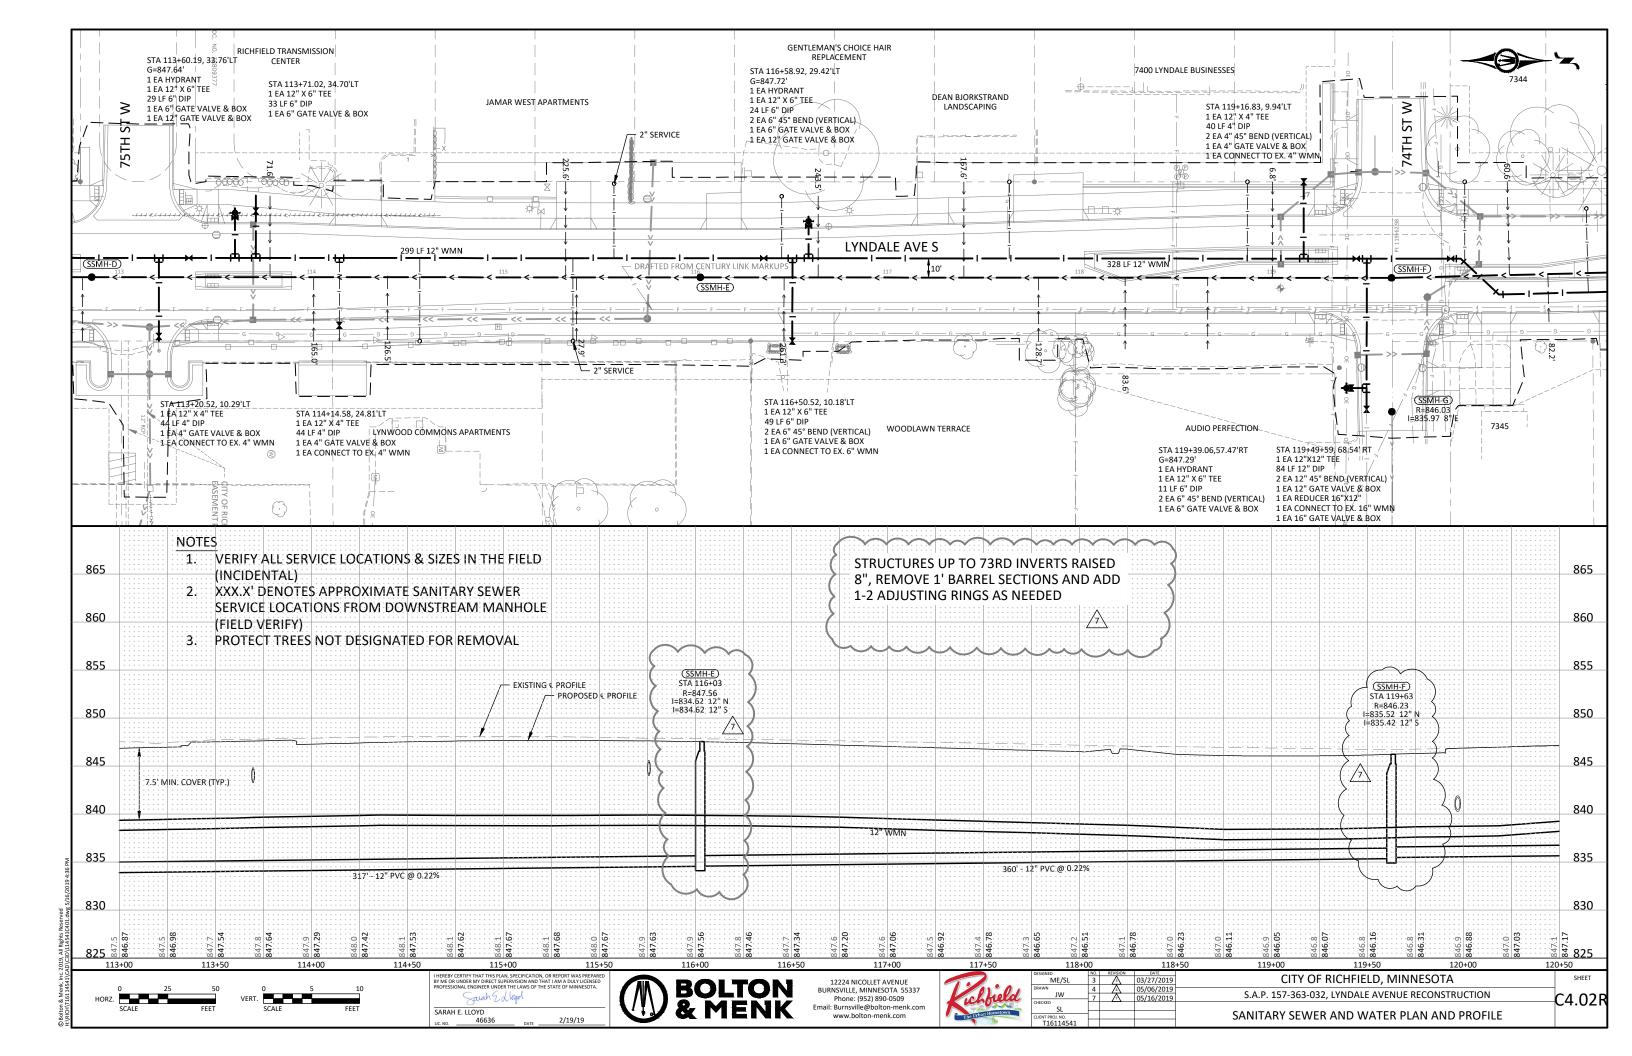


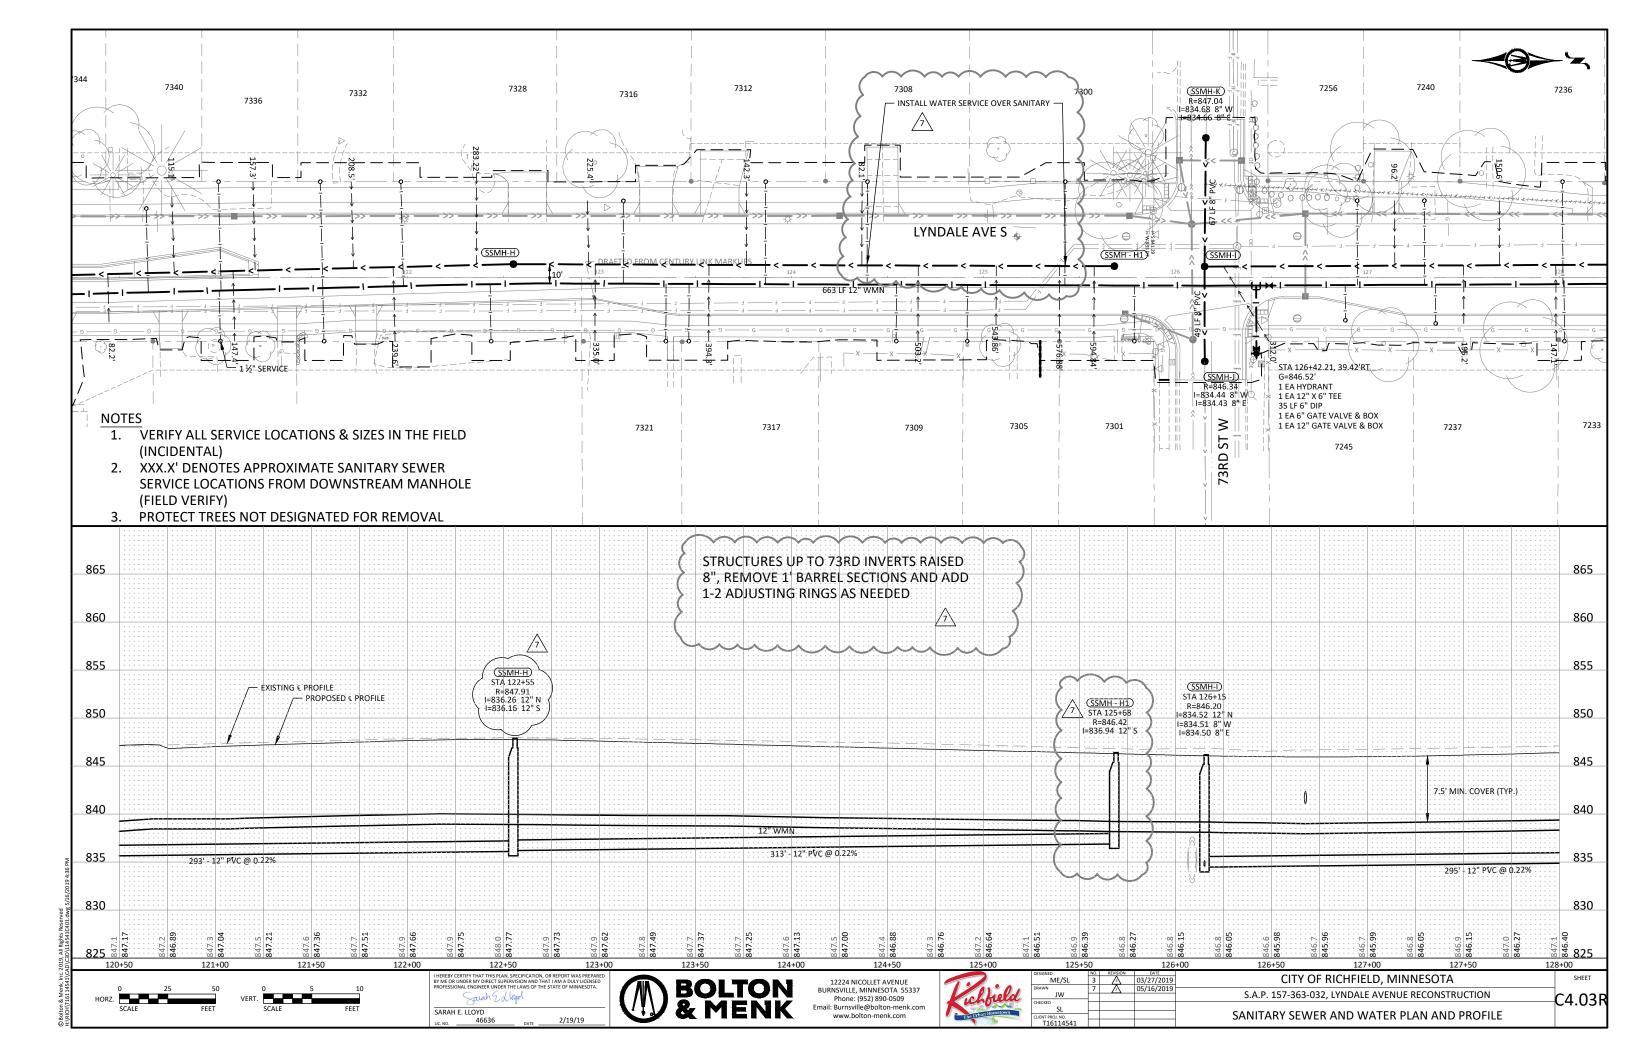


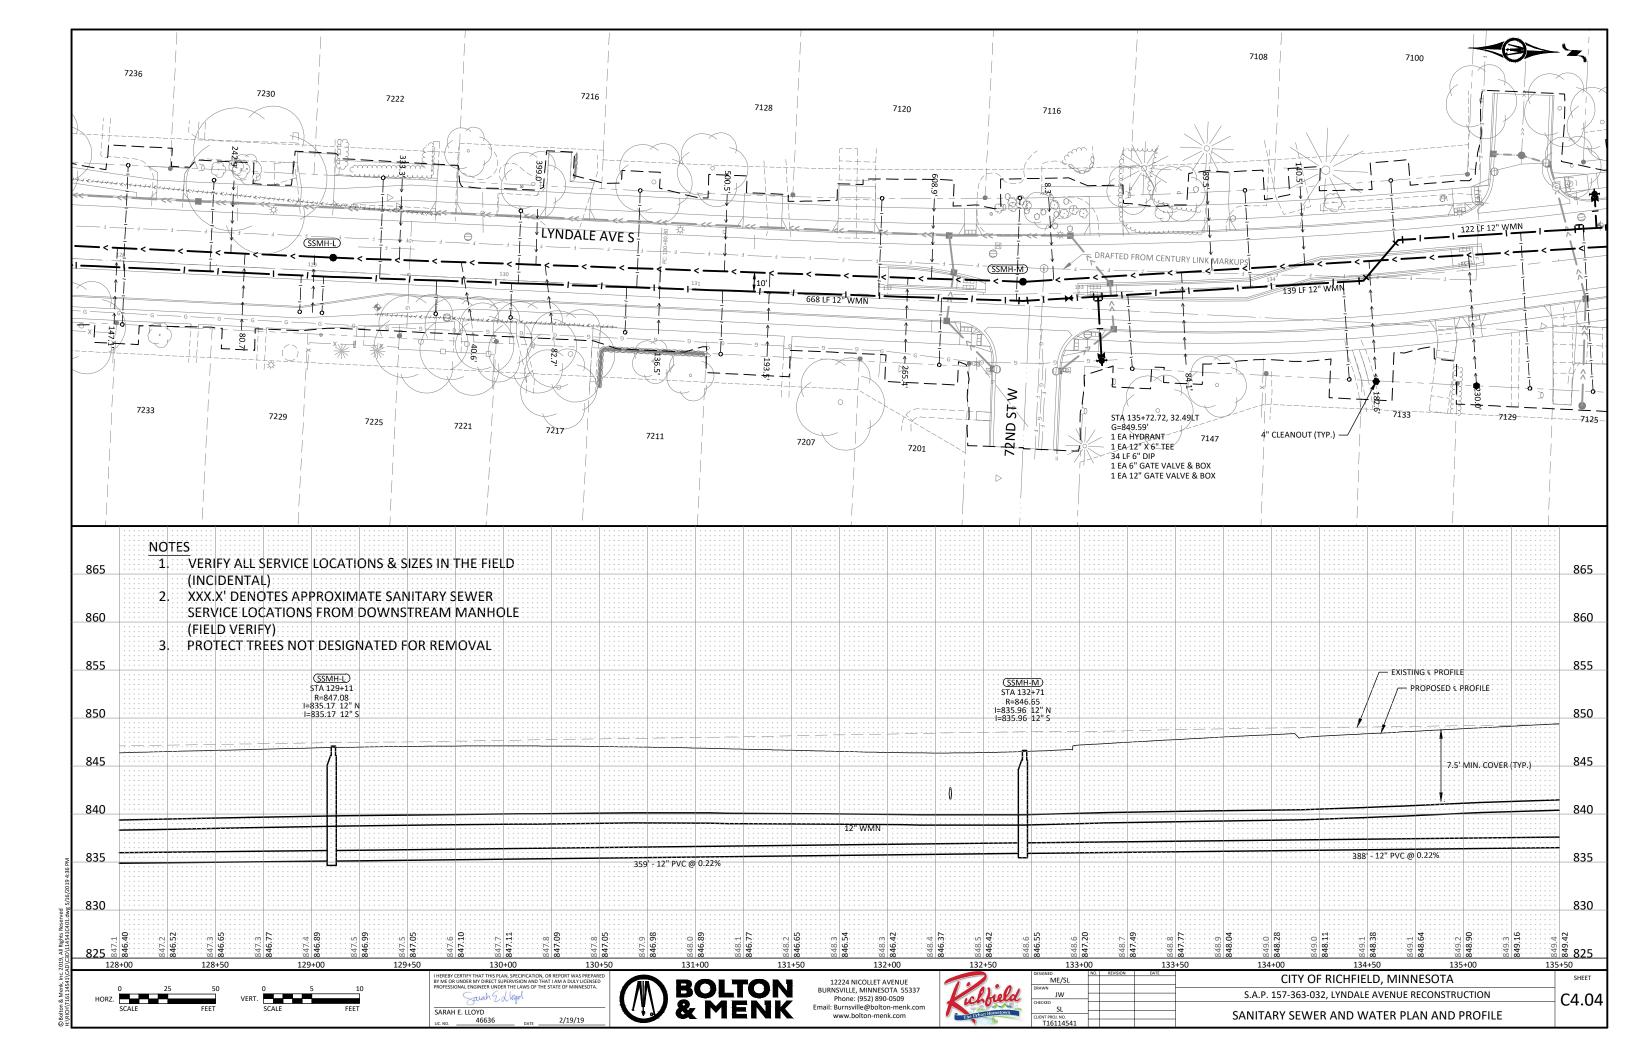


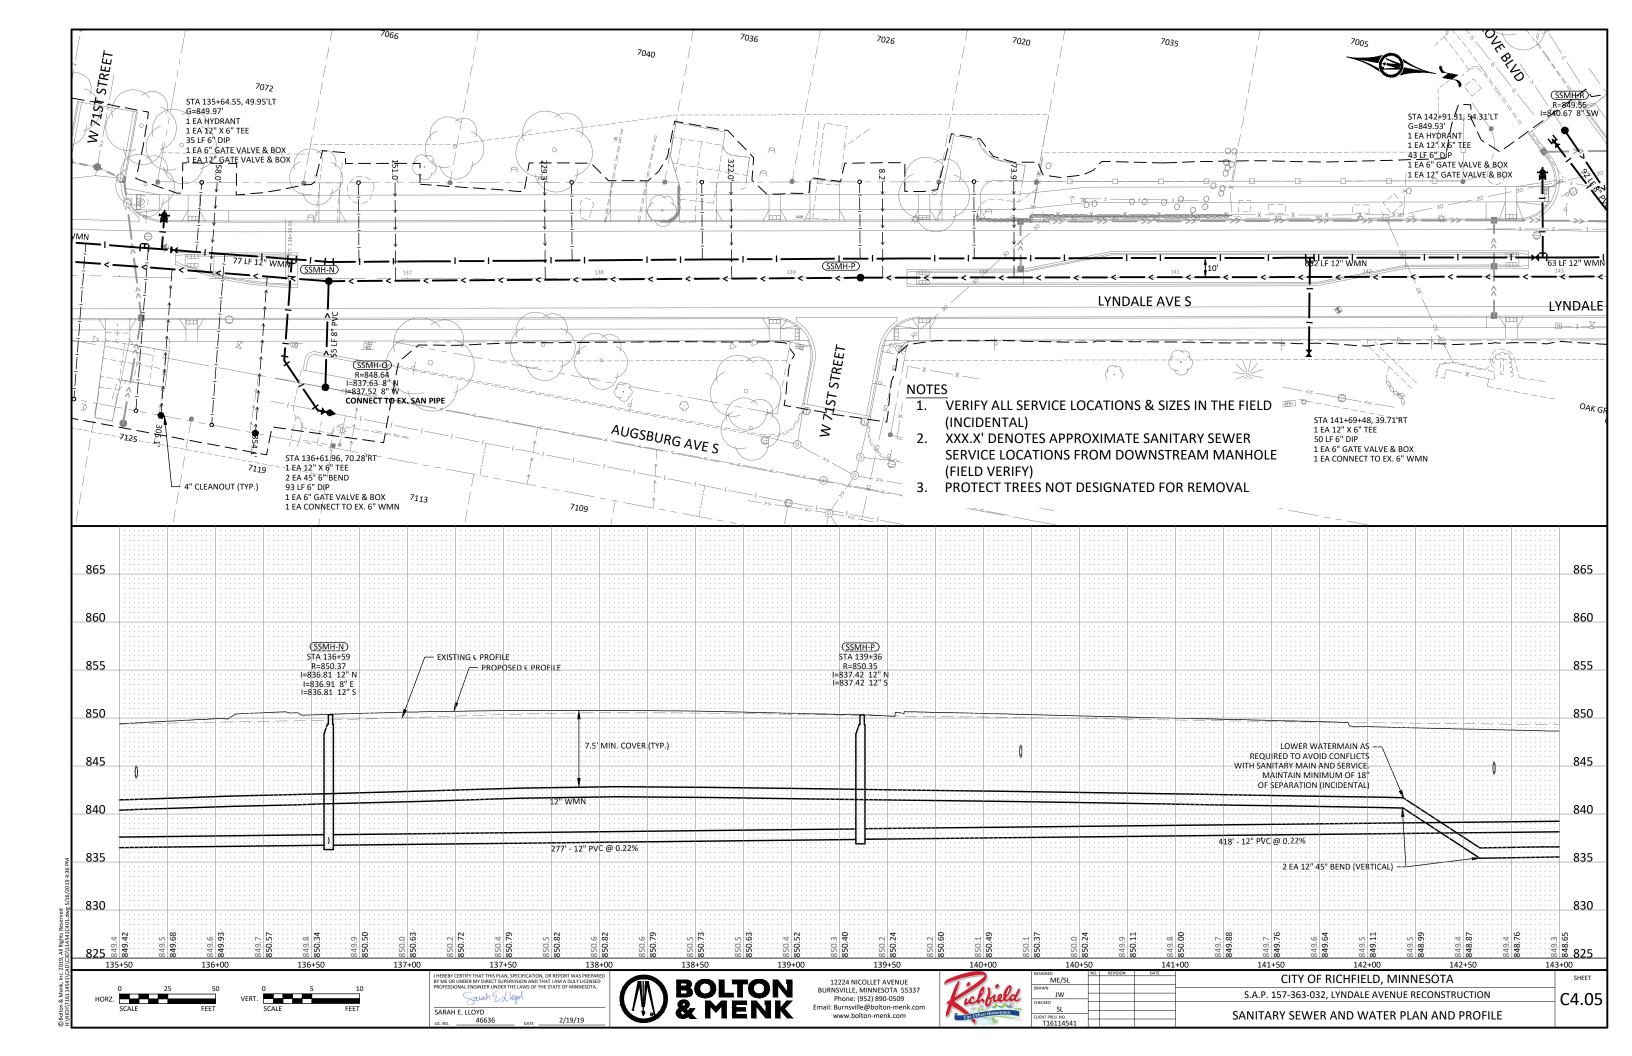


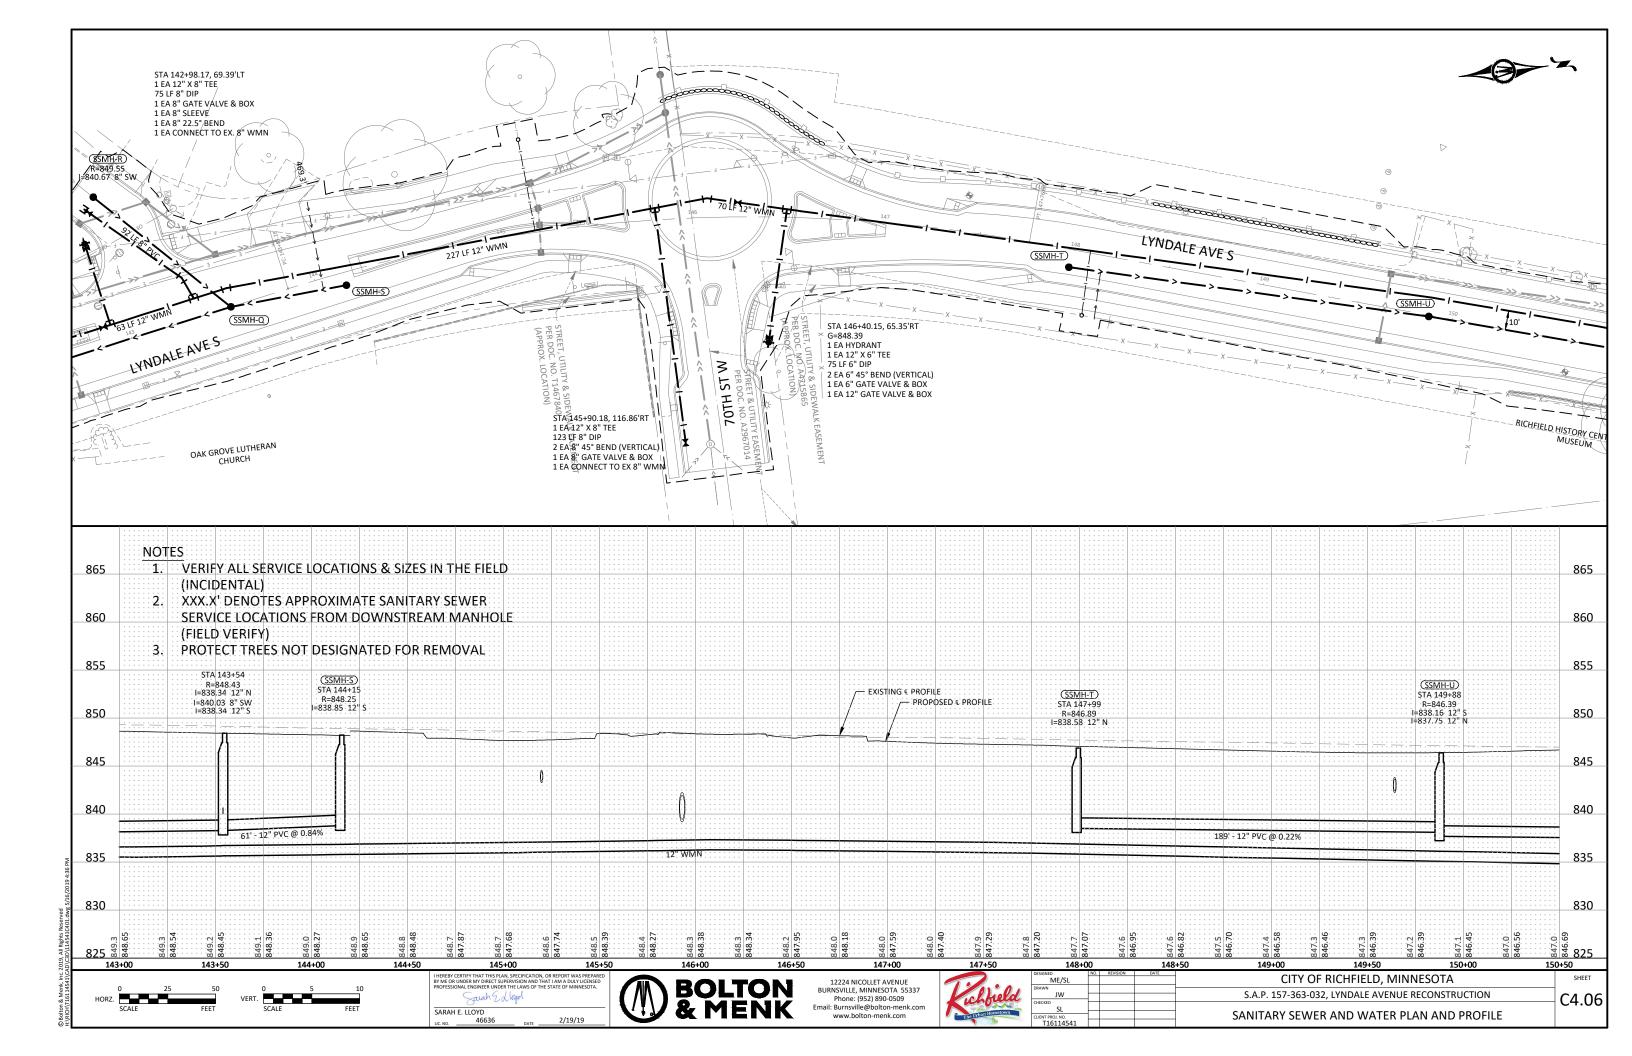


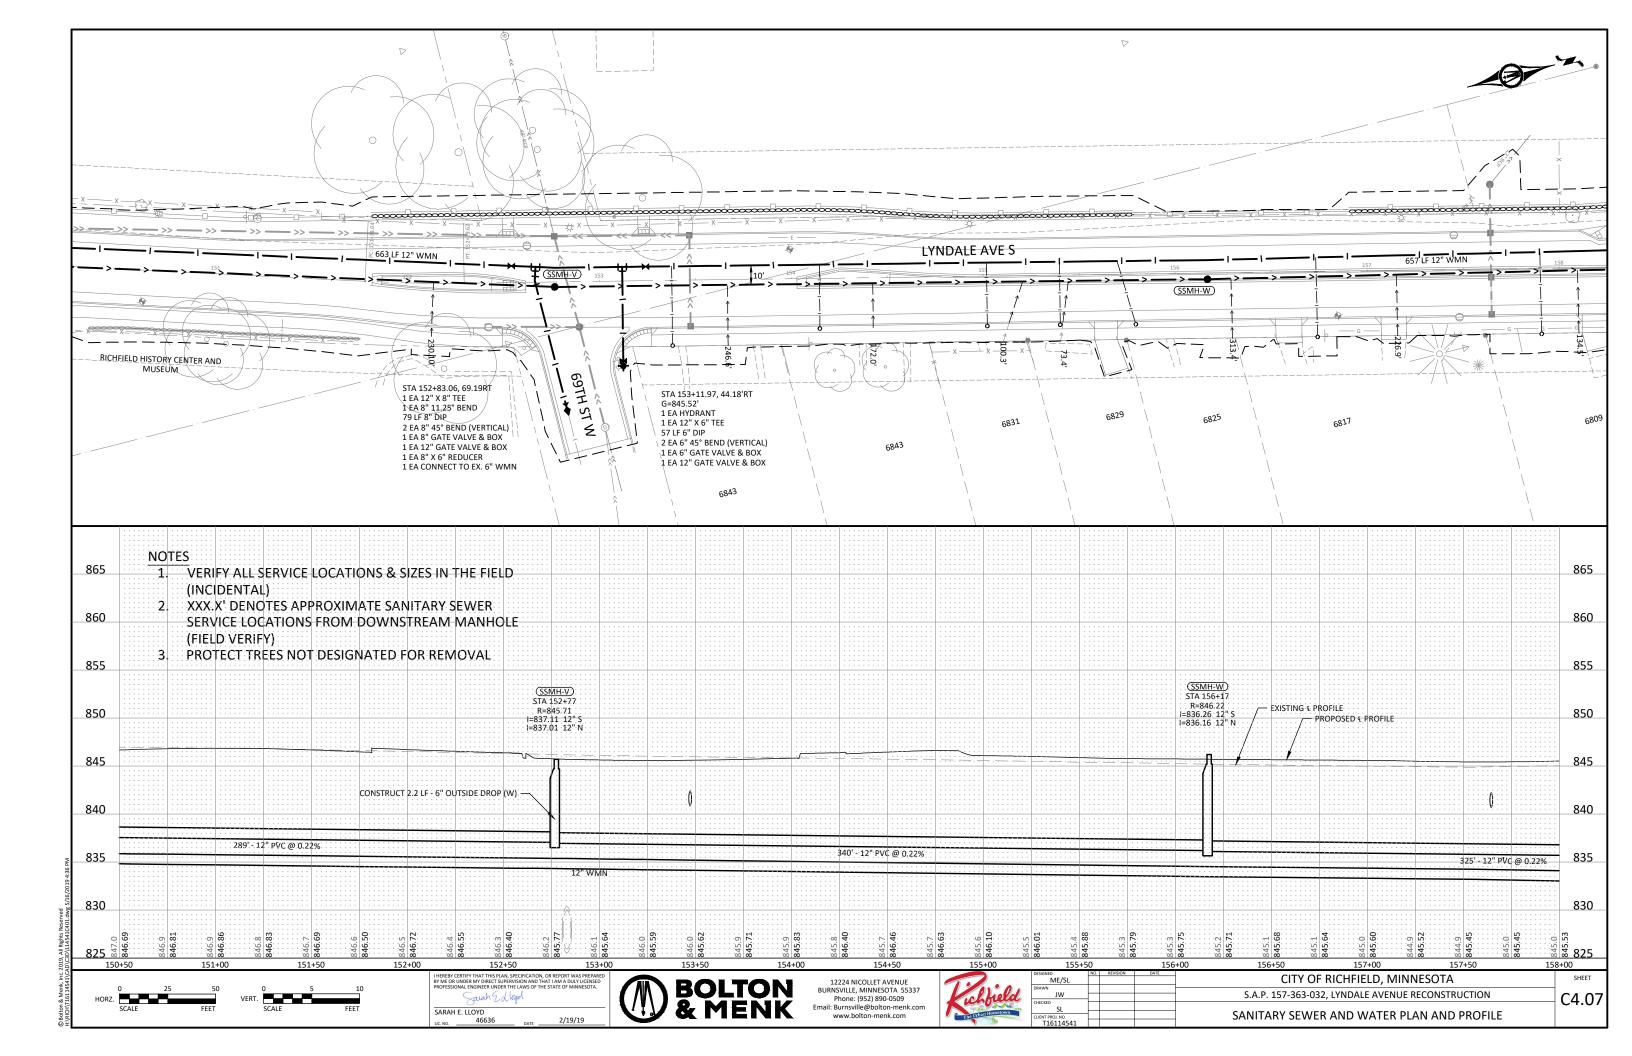


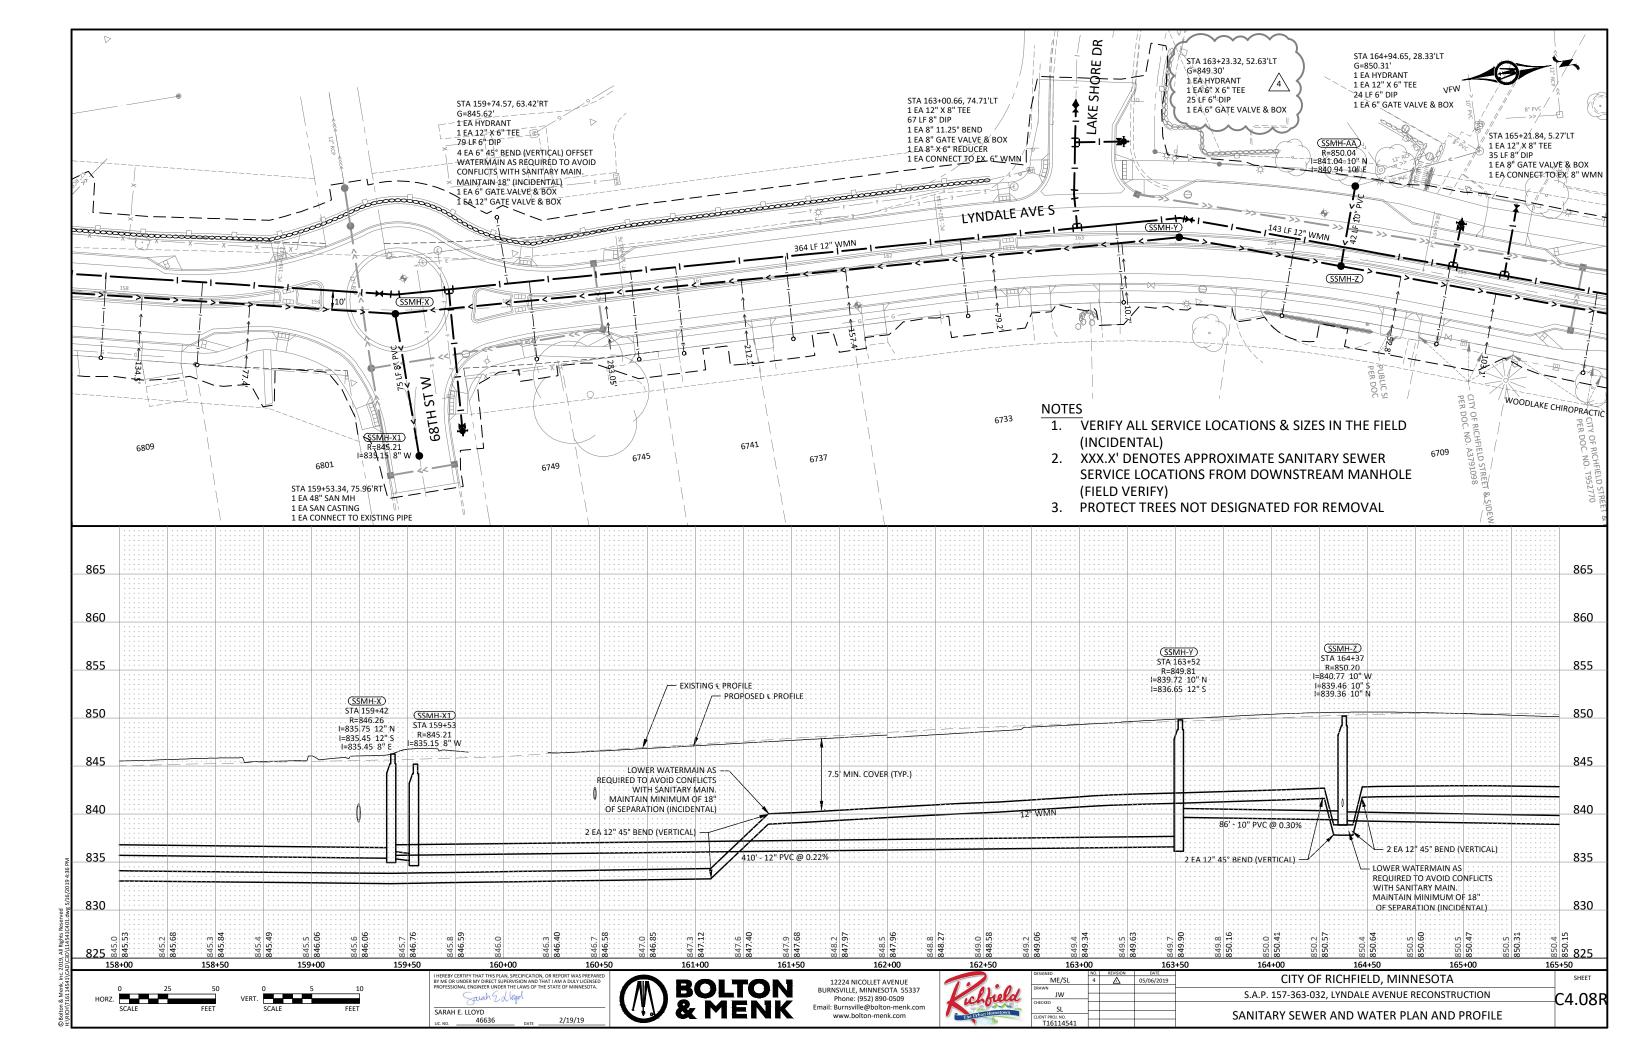


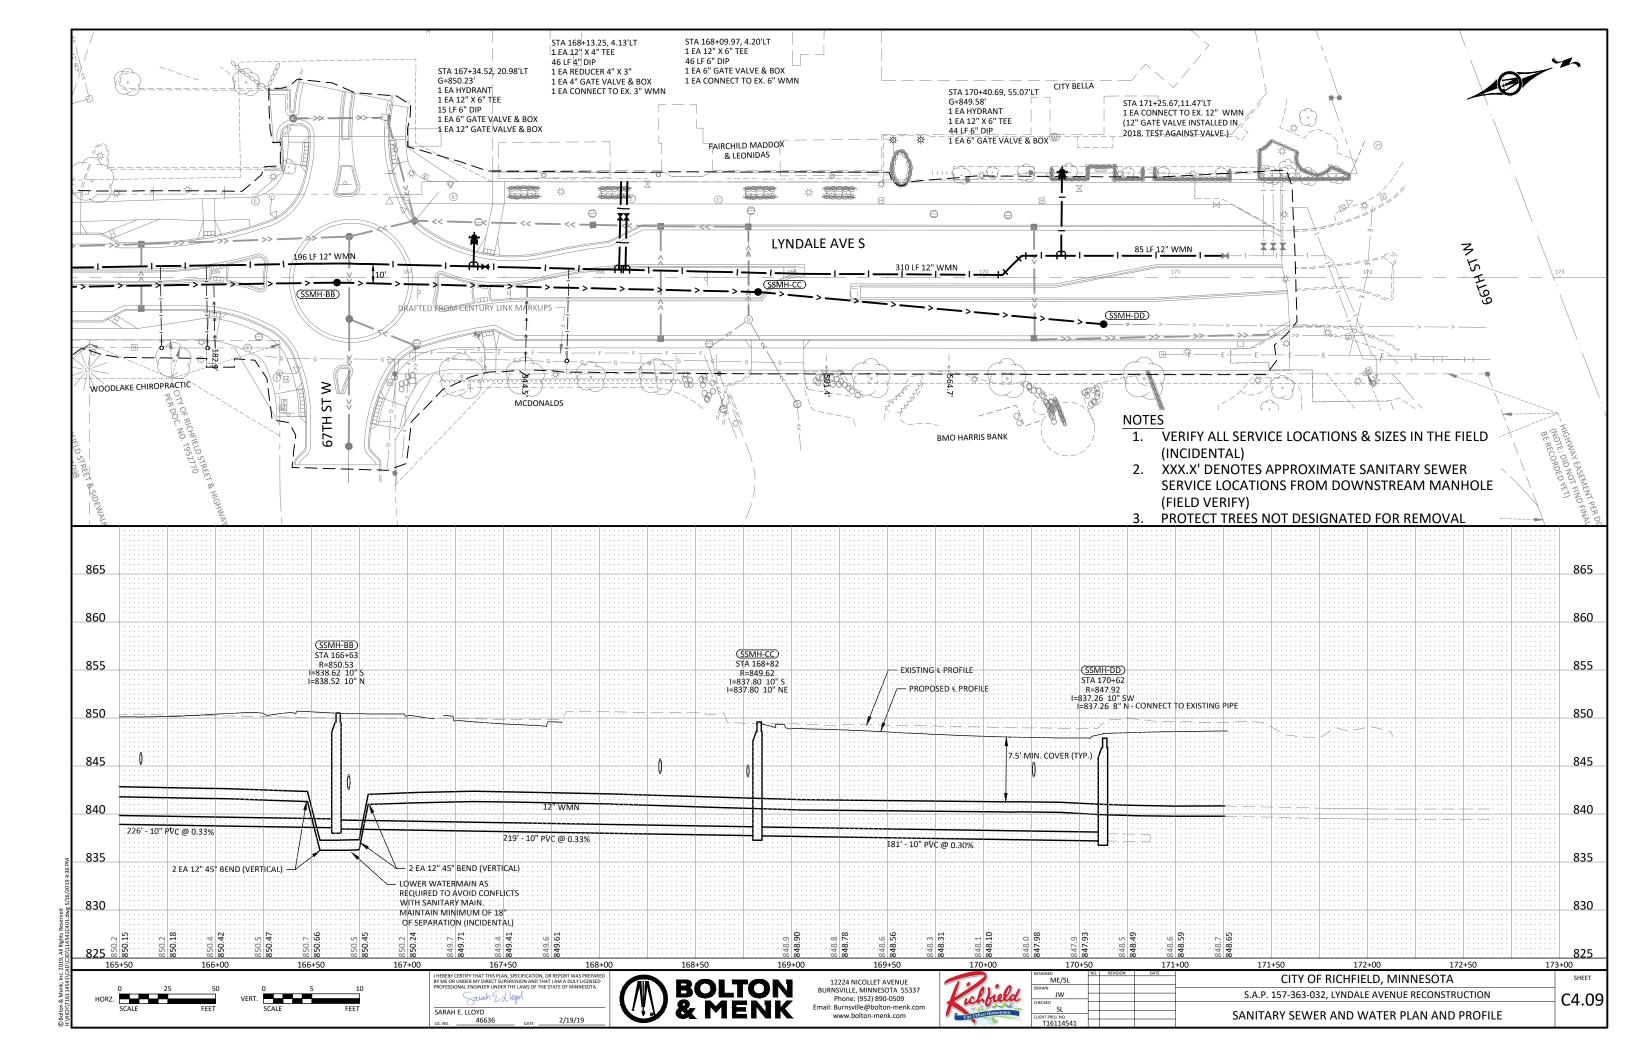


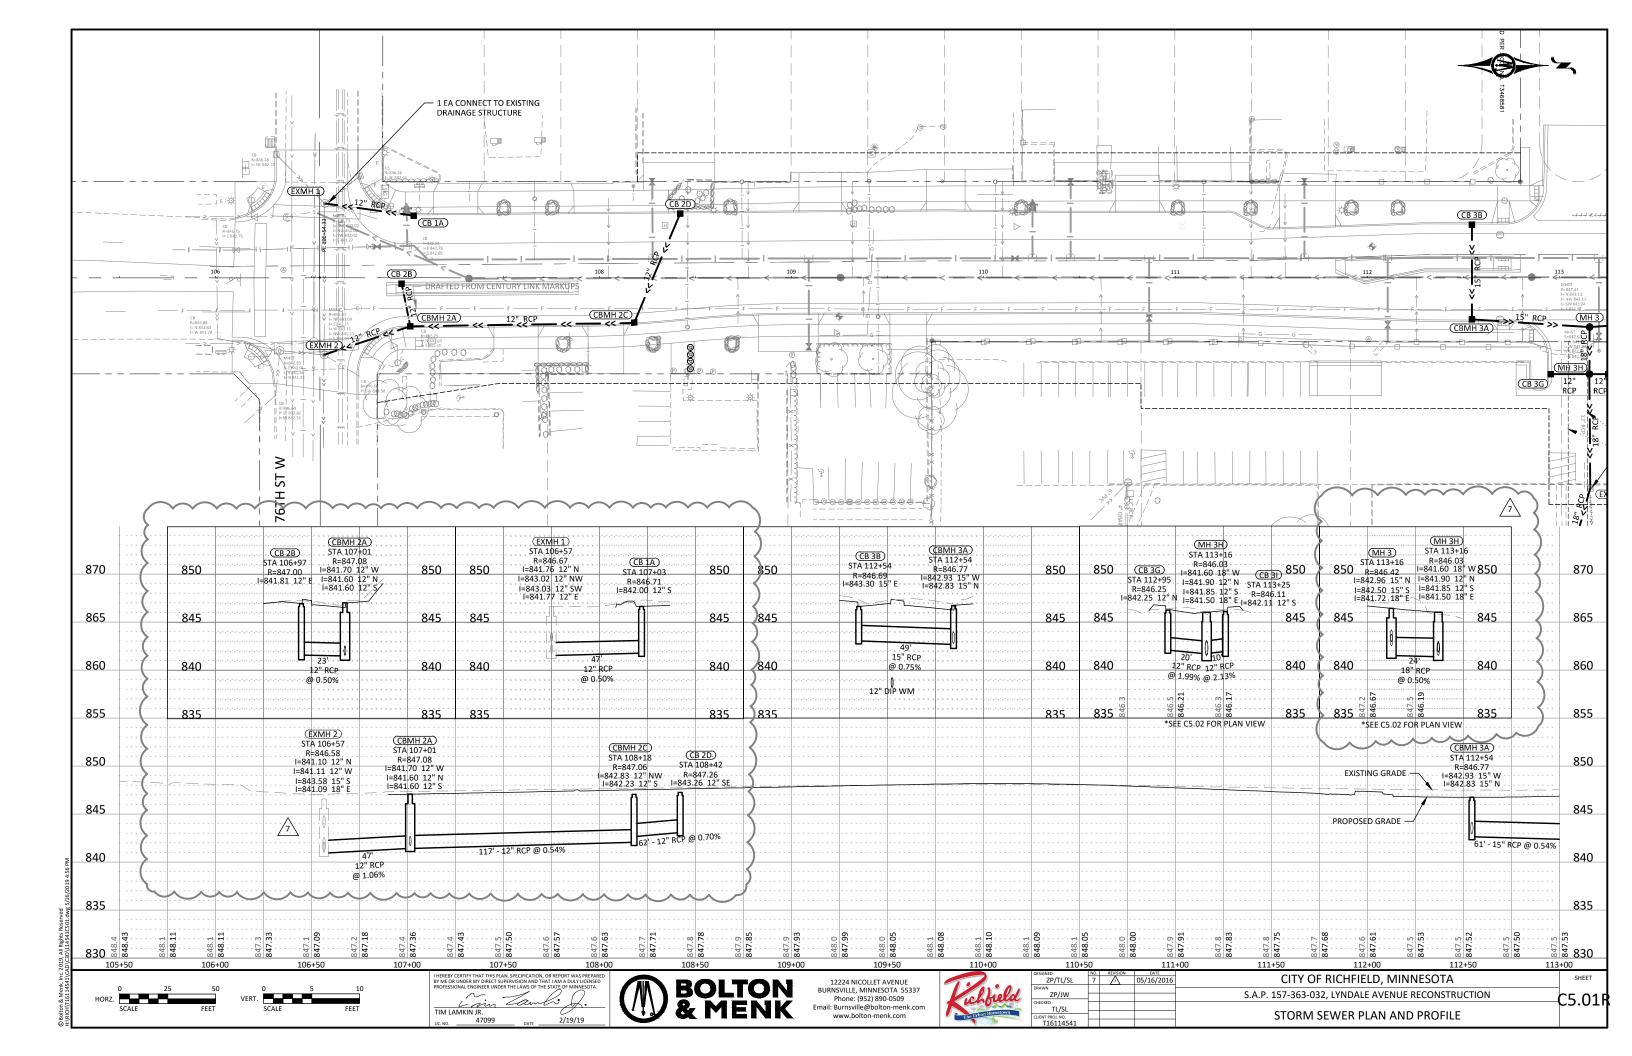


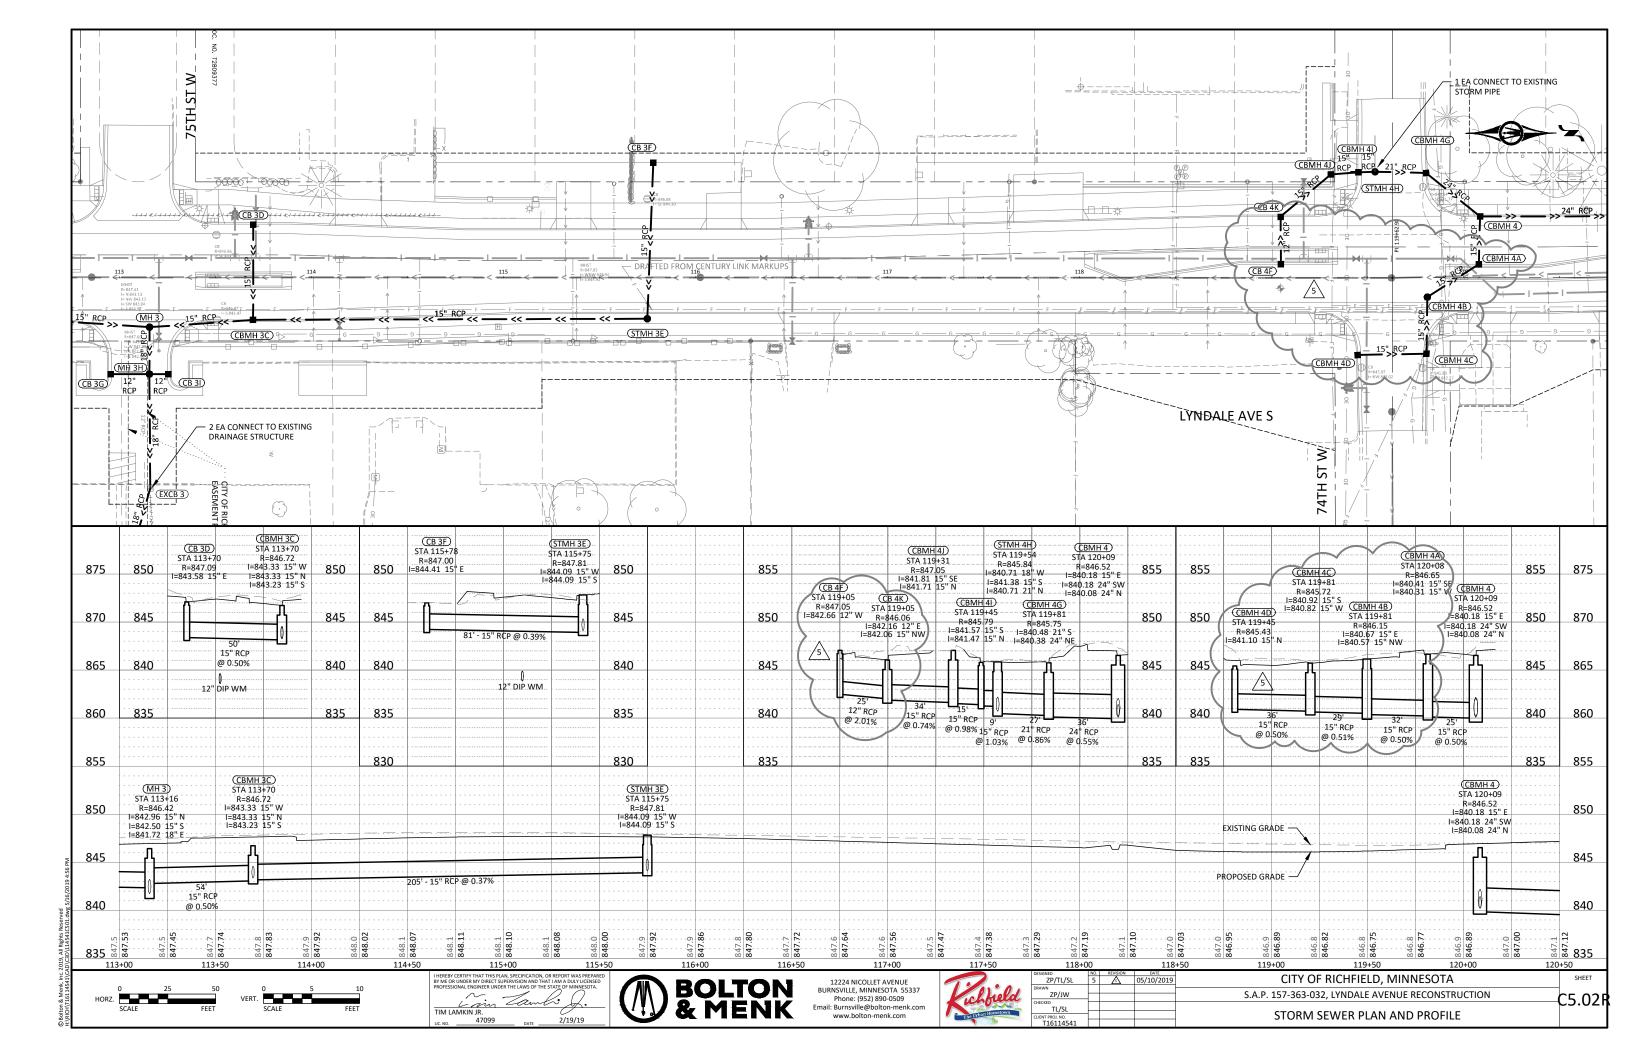


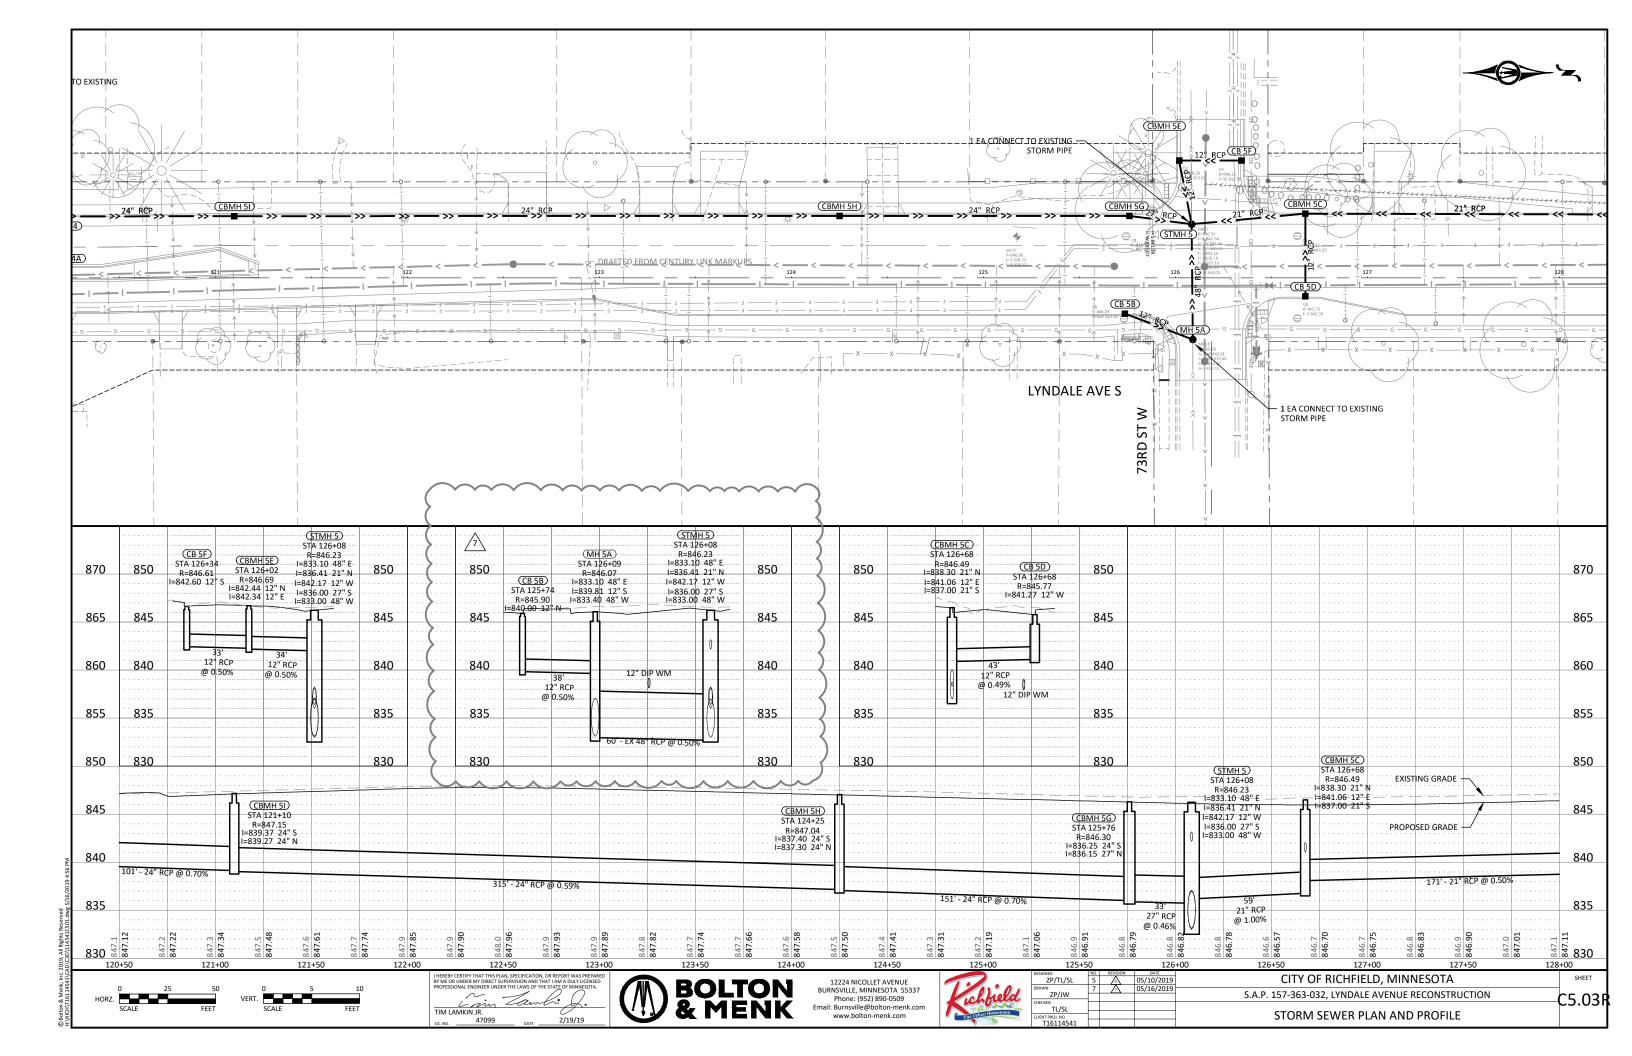


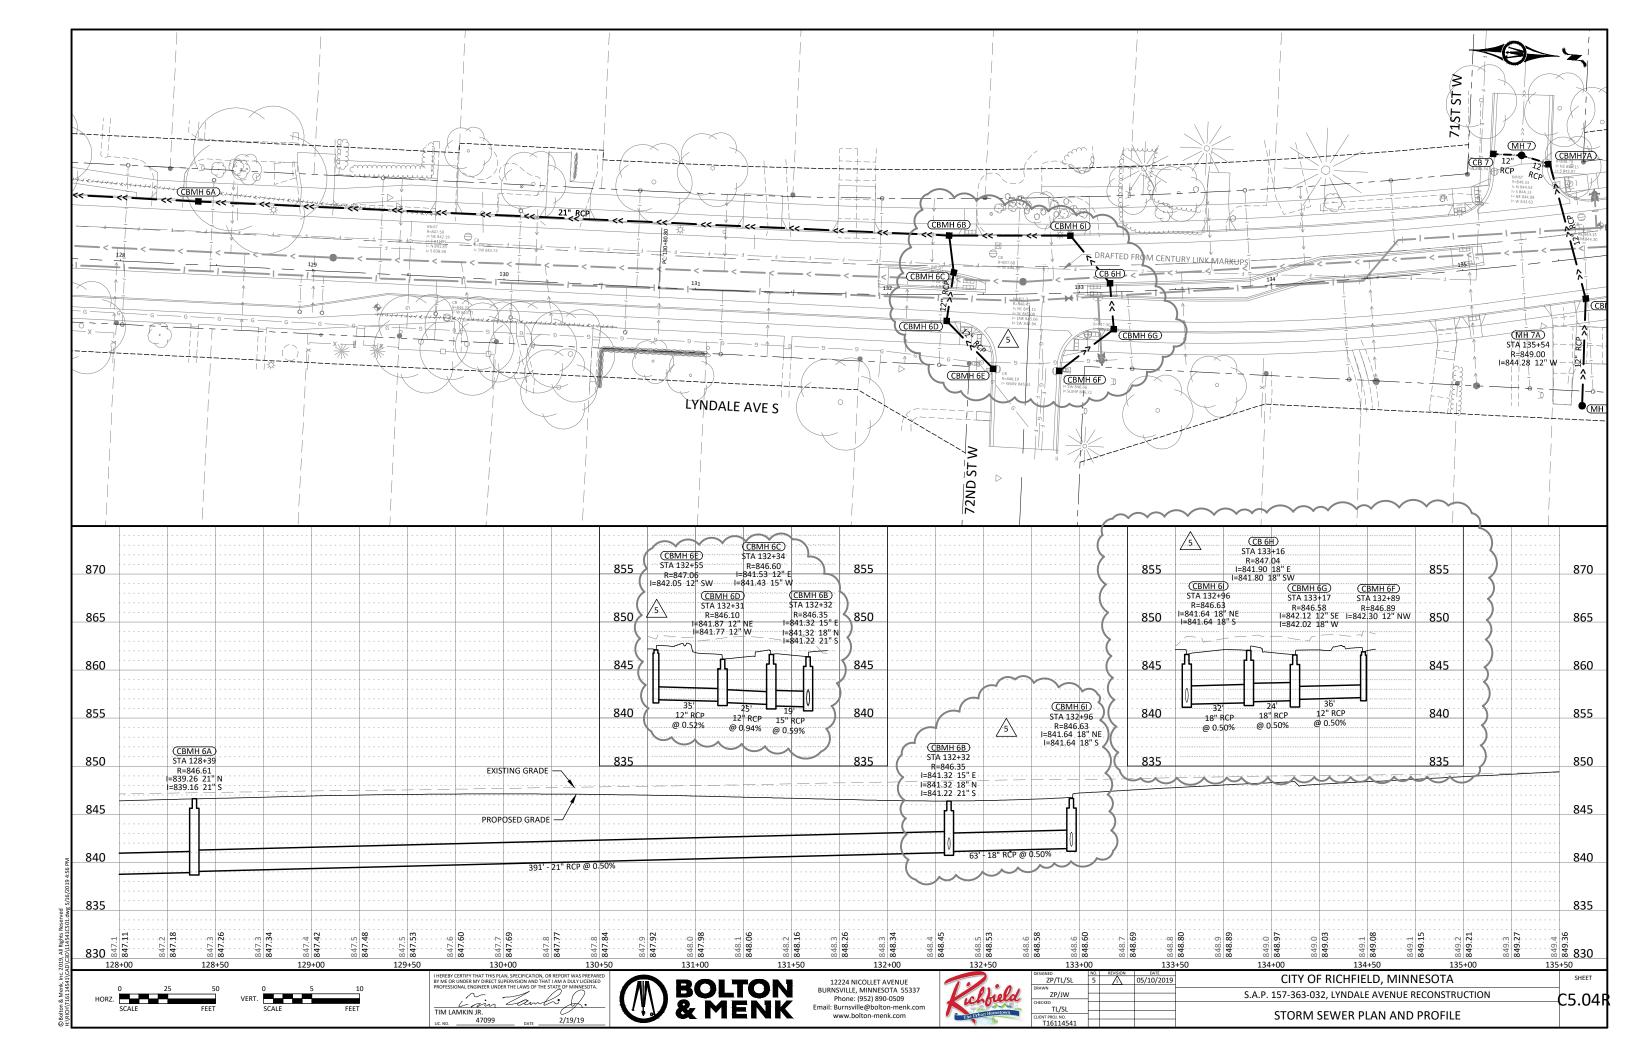


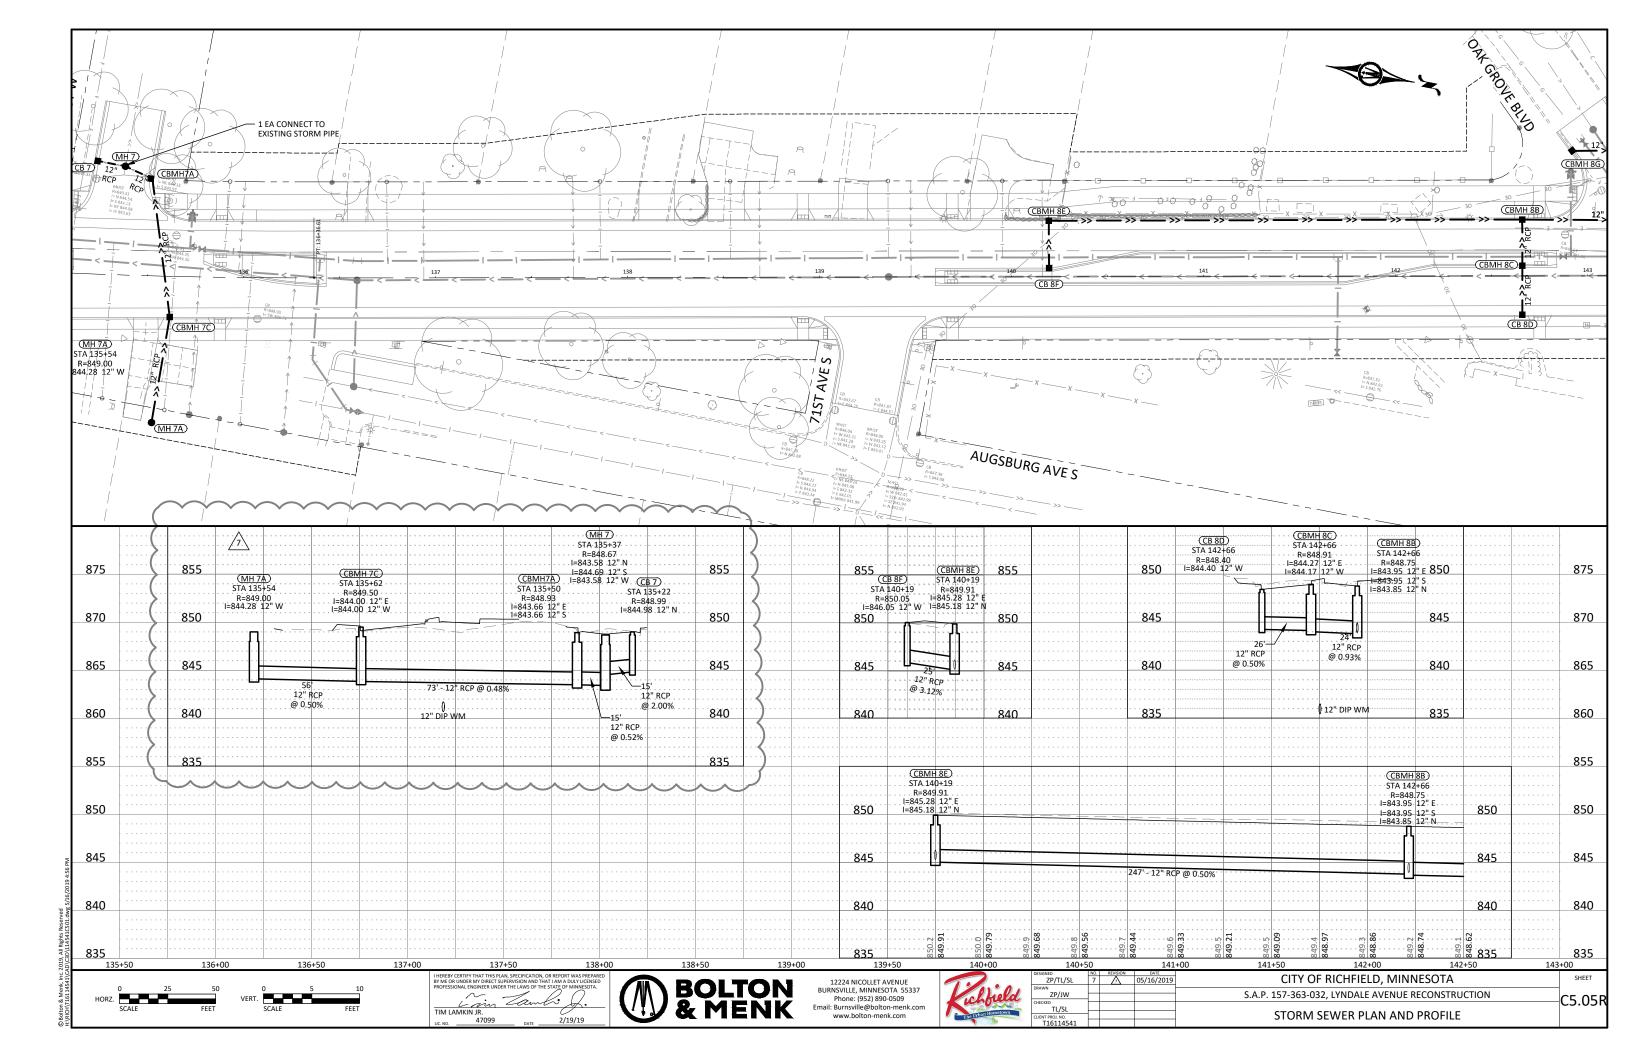


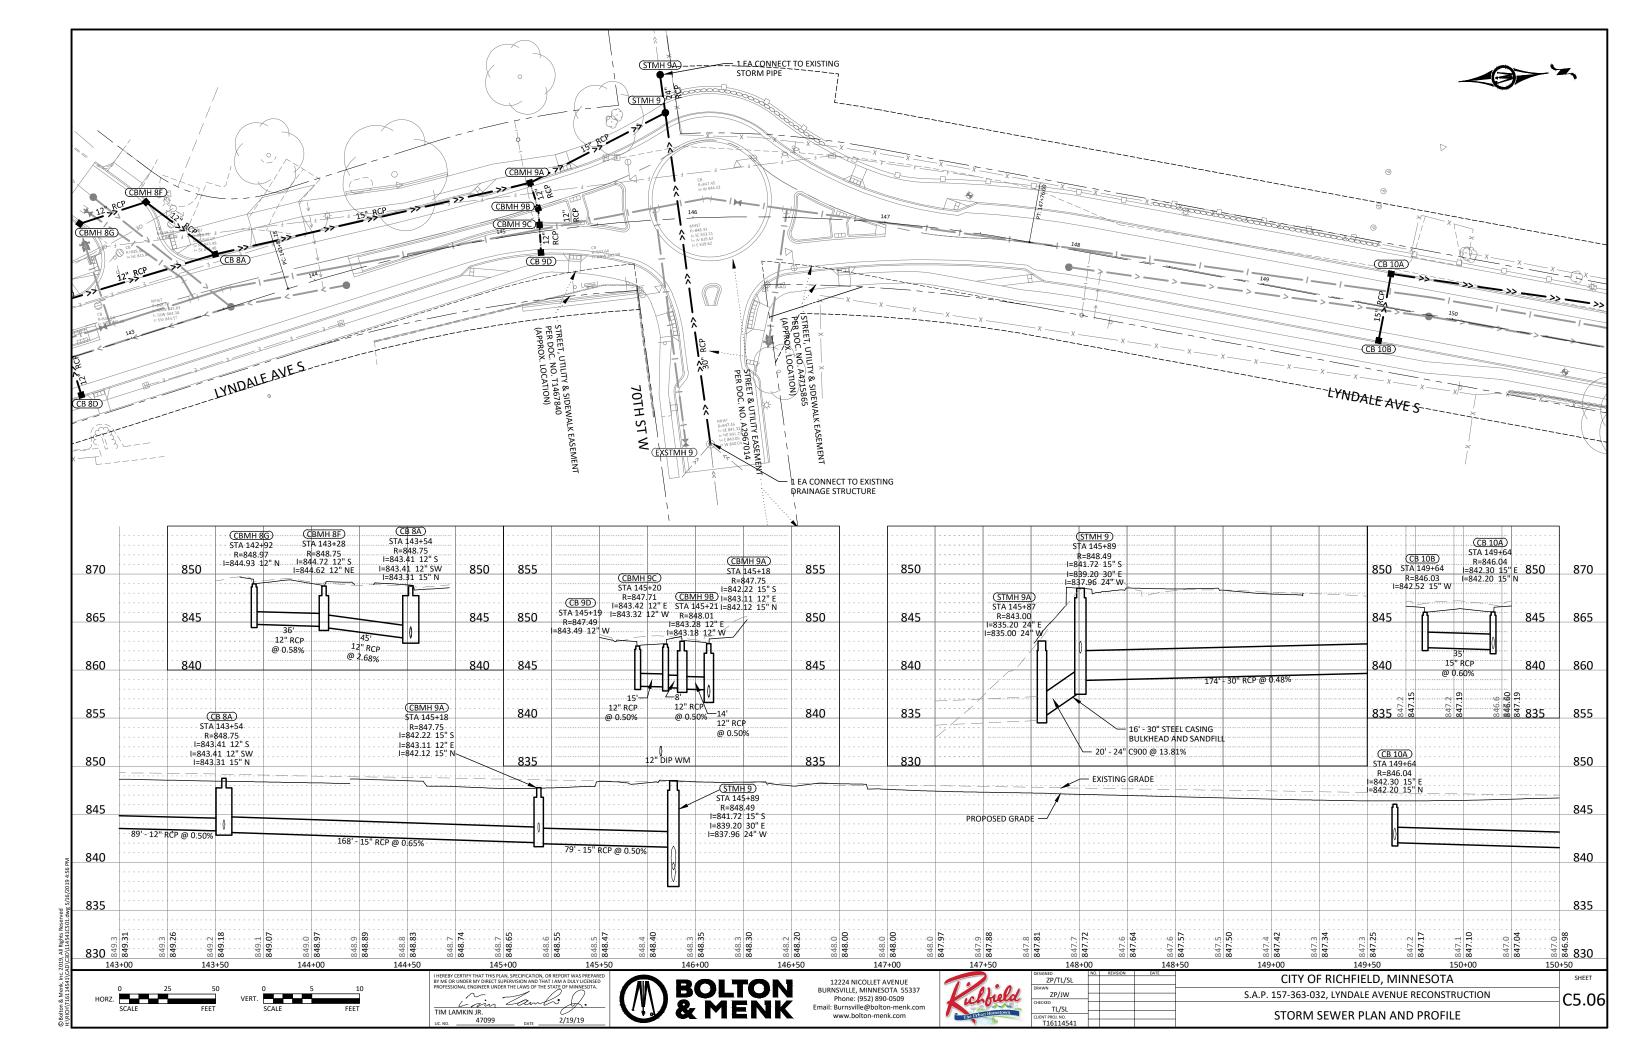

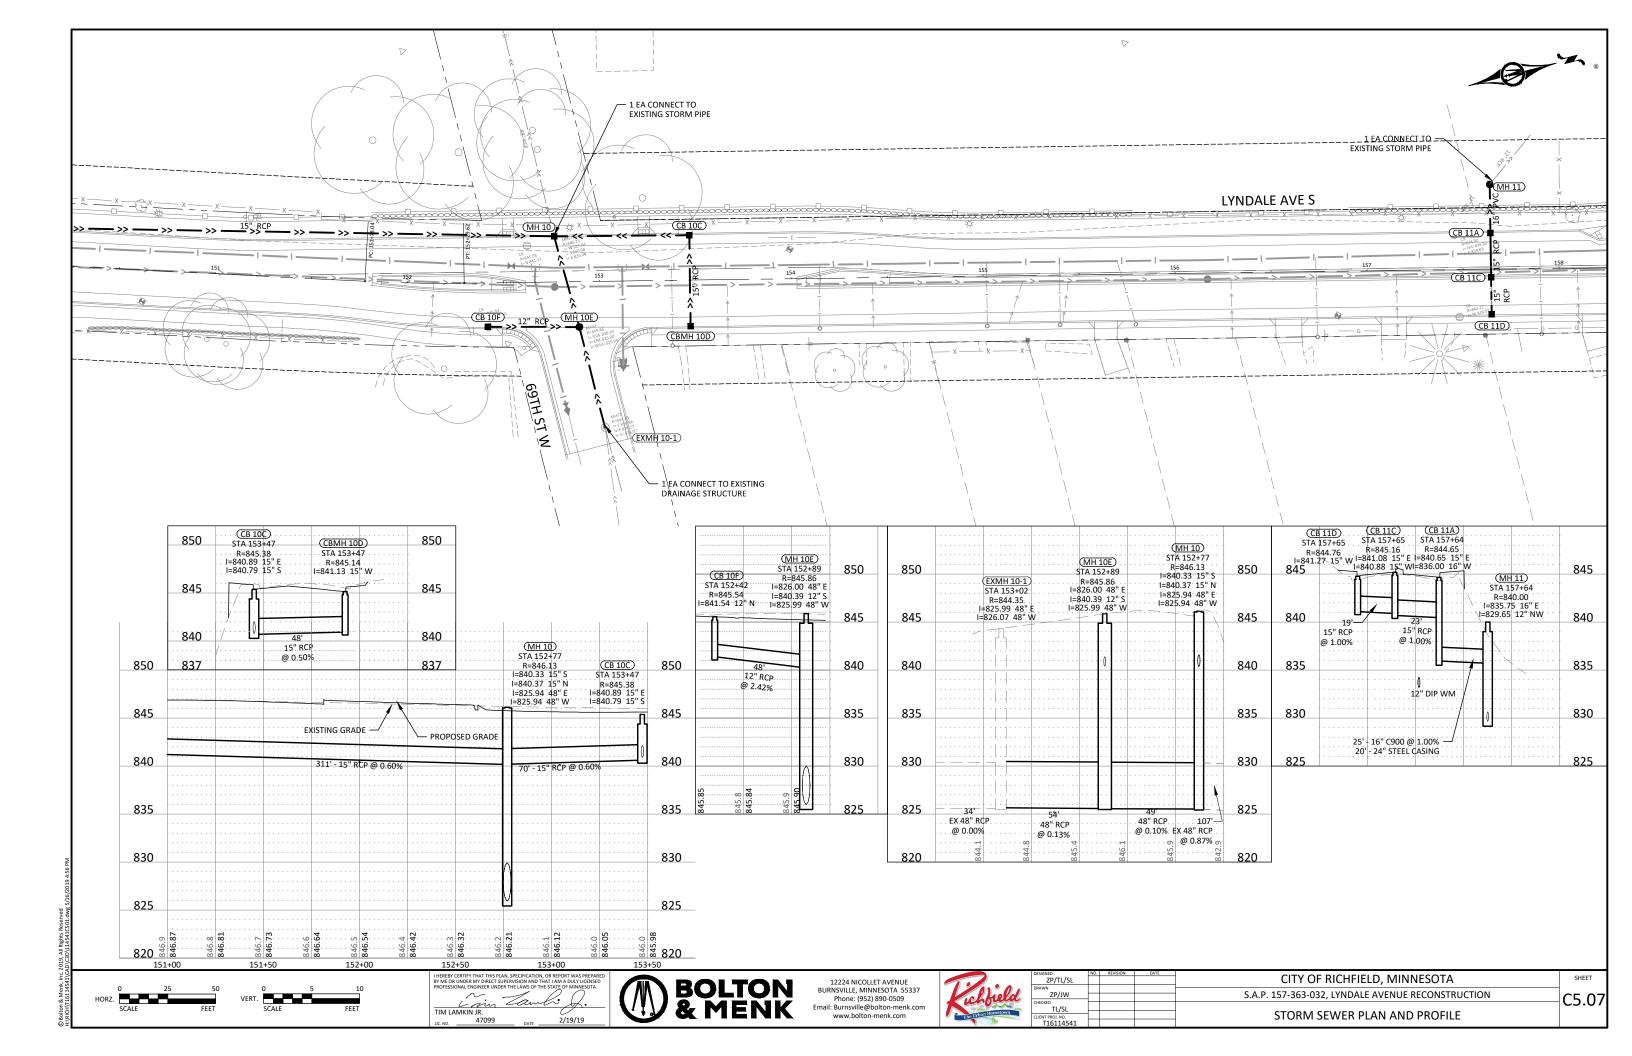


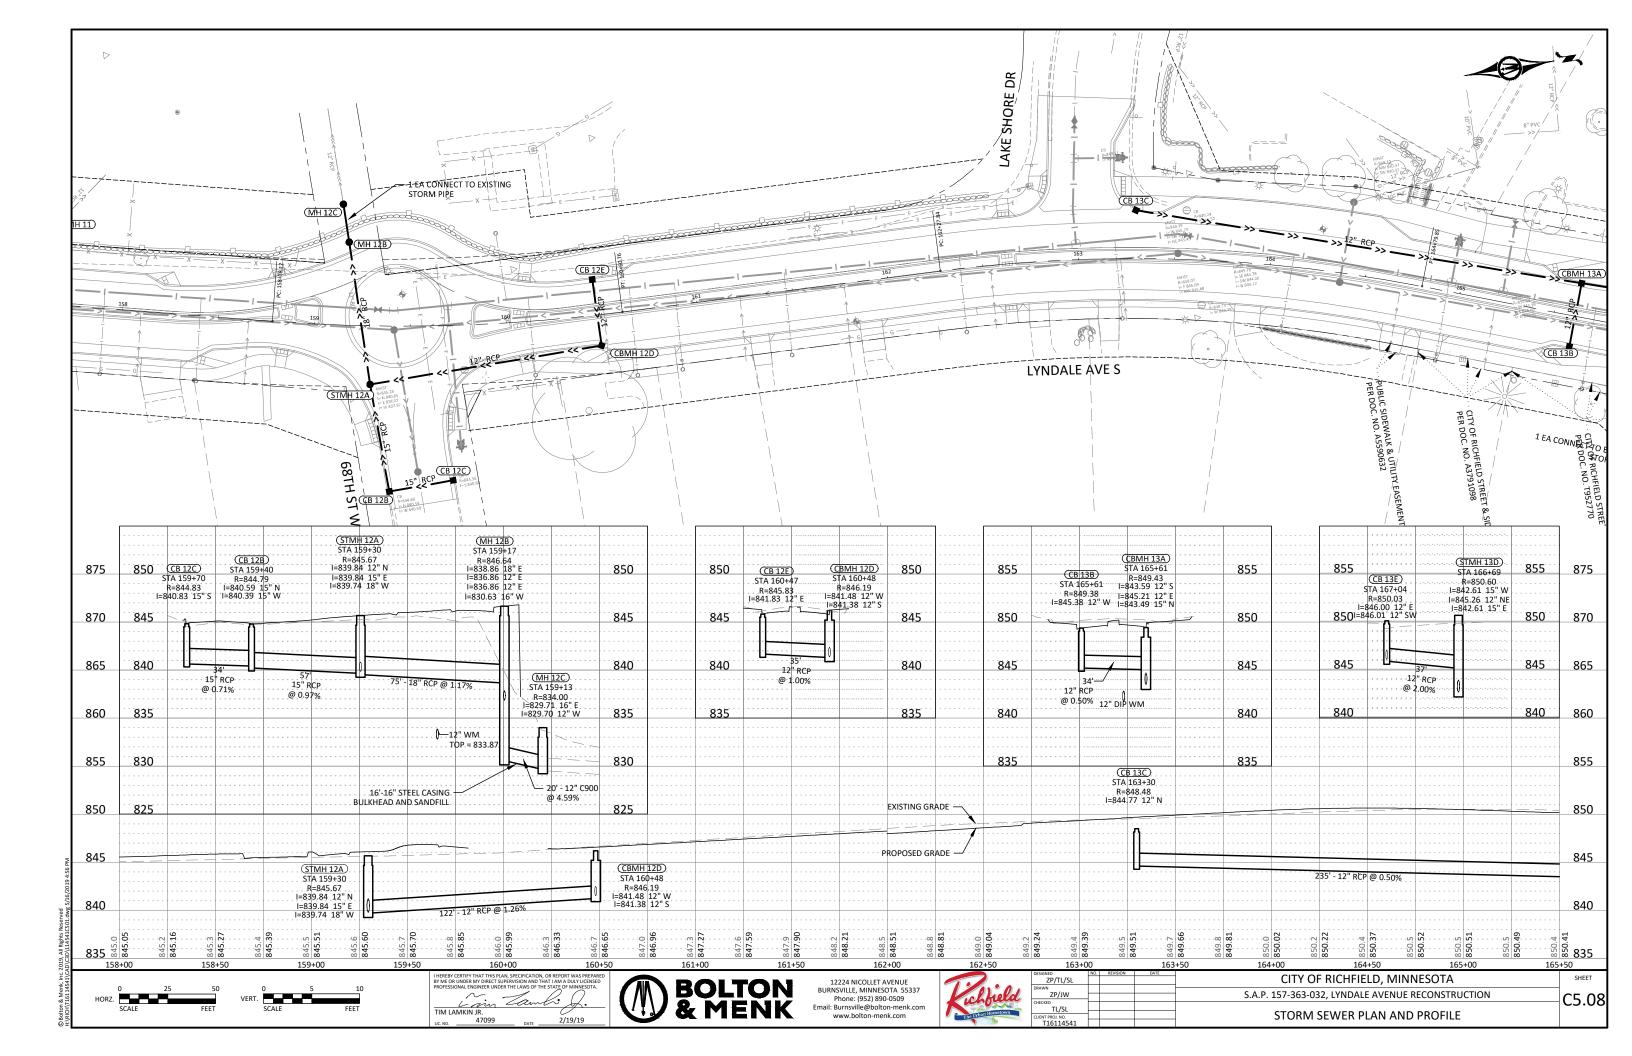

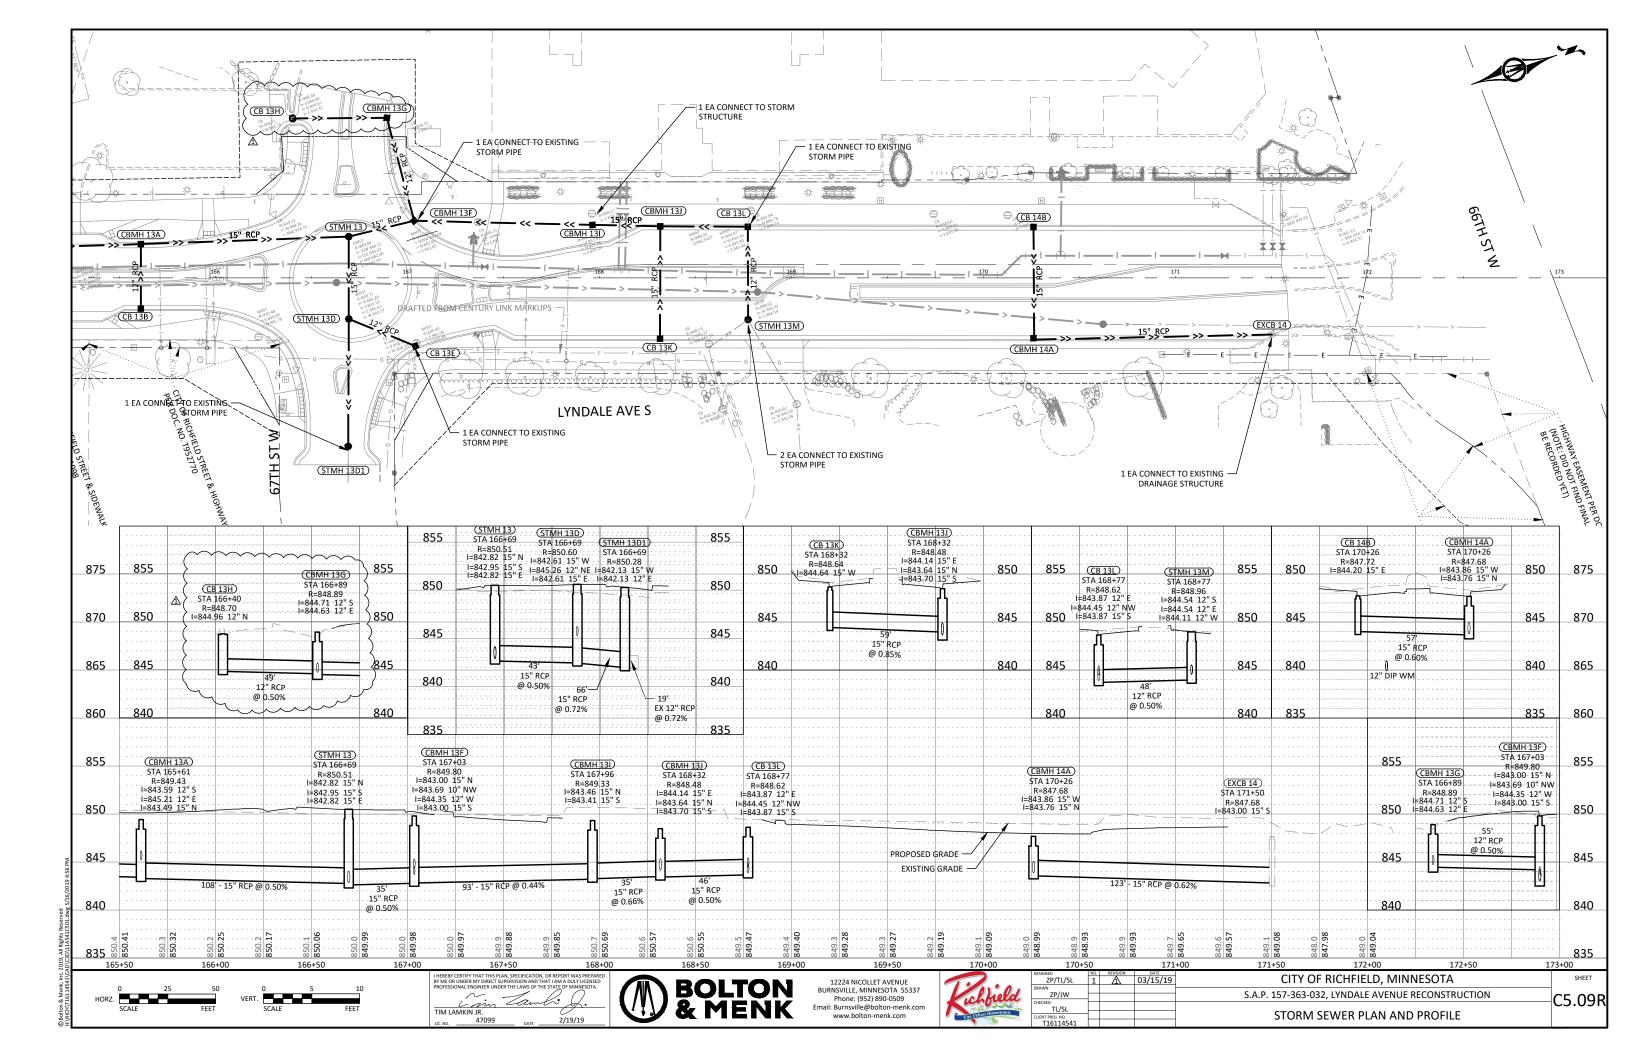

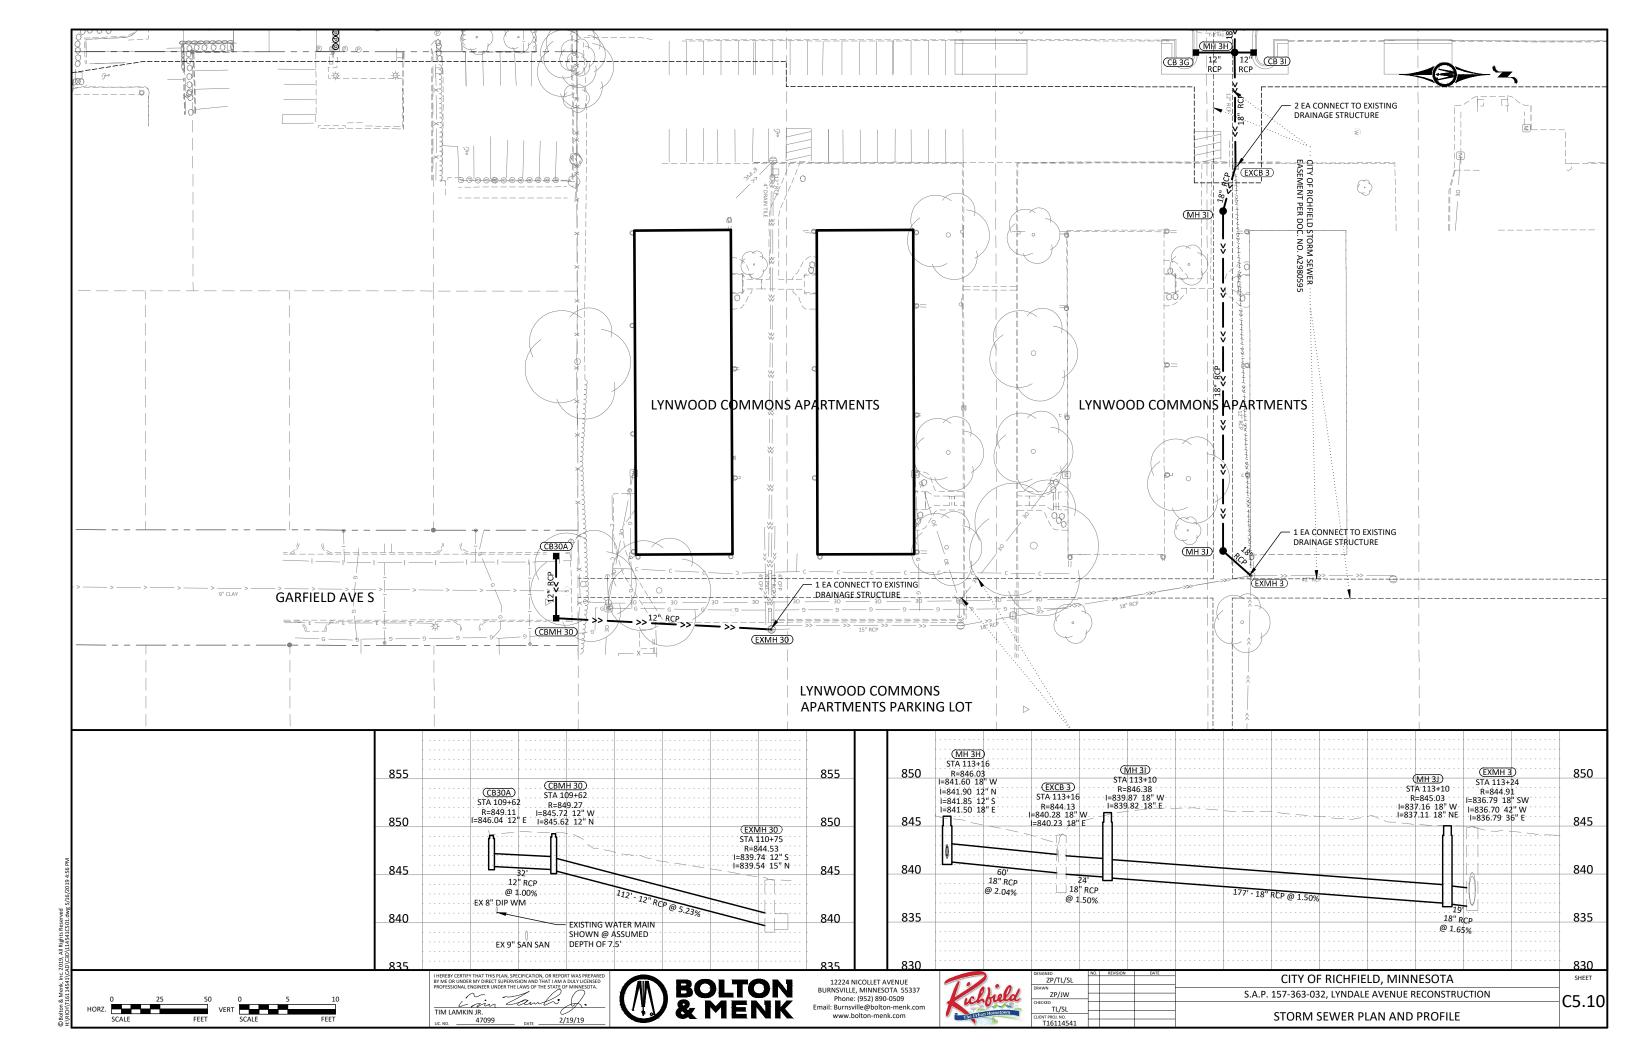



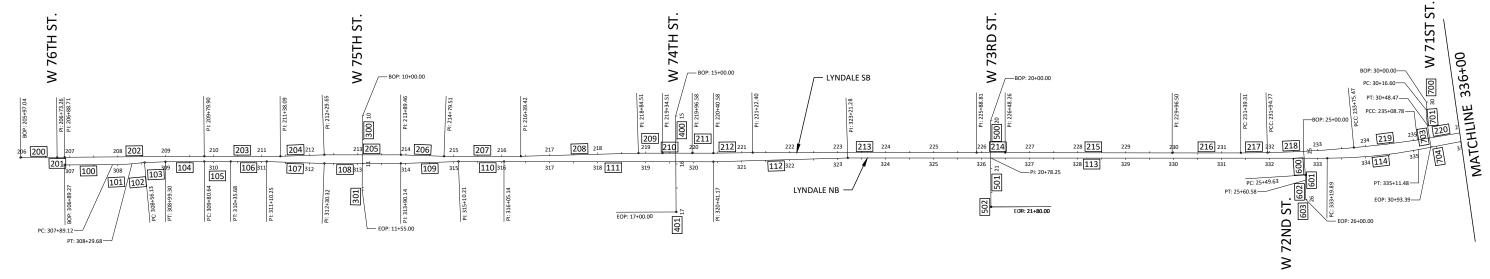

	LYNDALE NB													
POINT ID	POINT	START STATION	END STATION	LENGTH	DELTA	RADIUS	CHORD	START N	START E	END N	END E	AZIMUTH		
100	ВОР	306+89.27	307+89.12	99.85				127173.27	524625.17	127273.12	524624.46	359° 35' 15.87"		
101	PC	307+89.12	308+29.68	40.56	4° 38' 52.02"	500.00	40.55	127273.12	524624.46	127313.62	524622.52	357° 15' 49.86"		
102	PT	308+29.68	308+56.13	26.45				127313.62	524622.52	127339.97	524620.19	354° 56' 23.85"		
103	PC	308+56.13	308+99.30	43.17	4° 56' 49.98"	500.00	43.16	127339.97	524620.19	127383.09	524618.24	357° 24' 48.85"		
104	PT	308+99.30	309+80.64	81.34				127383.09	524618.24	127464.42	524618.08	359° 53' 13.84"		
105	PC	309+80.64	310+35.68	55.03	0° 26' 16.63"	7200.00	55.03	127464.42	524618.08	127519.46	524617.89	359° 48' 24.19"		
106	PT	310+35.68	311+10.25	74.58				127519.46	524617.89	127594.03	524617.93	0° 01' 32.51"		
107	PI	311+10.25	312+30.32	120.07				127594.03	524617.93	127714.03	524621.98	1° 56' 05.78"		
108	PI	312+30.32	313+90.14	159.82				127714.03	524621.98	127873.85	524622.05	0° 01' 32.83"		
109	PI	313+90.14	315+10.21	120.06				127873.85	524622.05	127993.85	524618.11	358° 06' 59.92"		
110	PI	315+10.21	316+05.14	94.93				127993.85	524618.11	128088.78	524618.15	0° 01' 32.57"		
111	PI	316+05.14	320+41.17	436.04				128088.78	524618.15	128524.82	524618.34	0° 01' 32.35"		
112	PI	320+41.17	323+21.28	280.11				128524.82	524618.34	128804.82	524610.47	358° 23' 17.59"		
113	PI	323+21.28	333+19.89	998.61				128804.82	524610.47	129803.43	524610.90	0° 01' 30.55"		

						75TH	ST					
POINT ID	POINT	START STATION	END STATION	LENGTH	DELTA	RADIUS	CHORD	START N	START E	END N	END E	AZIMUTH
300	ВОР	10+00	11+55	155.00				127794.41	524522.48	127793.00	524677.47	90° 31' 25.84"
301	EOP	11+55	11+55	0.00				127793.00	524677.47	127793.00	524677.47	90° 31' 25.84"

						74TH	ST					
POINT ID	POINT	START STATION	END STATION	LENGTH	DELTA	RADIUS	CHORD	START N	START E	END N	END E	AZIMUTH
400	ВОР	15+00	17+00	200.00				128446.42	524522.92	128447.36	524722.92	89° 43' 57.08"
401	EOP	17+00	17+00	0.00				128447.36	524722.92	128447.36	524722.92	89° 43' 57.08"

						73RD	ST					
POINT ID	POINT	START STATION	END STATION	LENGTH	DELTA	RADIUS	CHORD	START N	START E	END N	END E	AZIMUTH
500	ВОР	20+00	20+78.25	78.25				129102.52	524532.35	129102.58	524610.60	89° 57' 21.03"
501	PI	20+78.25	21+80	101.75				129102.58	524610.60	129103.02	524712.34	89° 45' 00.35"
502	EOP	21+80	21+80	0.00				129103.02	524712.34	129103.02	524712.35	89° 45' 00.35"

					LY	NDALE S	SB					
POINT ID	POINT	START STATION	END STATION	LENGTH	DELTA	RADIUS	CHORD	START N	START E	END N	END E	AZIMUTH
200	ВОР	205+97.04	206+73.26	76.23				127081.48	524609.83	127157.71	524609.29	359° 35' 15.8
201	PI	206+73.26	206+88.71	15.45				127157.71	524609.29	127173.16	524609.17	359° 35' 15.8
202	PI	206+88.71	209+79.90	291.19				127173.16	524609.17	127464.34	524607.08	359° 35' 15.8
203	PI	209+79.90	211+38.09	158.19				127464.34	524607.08	127622.53	524606.99	359° 58' 03.5
204	PI	211+38.09	212+29.65	91.56				127622.53	524606.99	127714.04	524603.98	358° 06' 59.8
205	PI	212+29.65	213+89.46	159.81				127714.04	524603.98	127873.85	524604.05	0° 01' 32.83
206	PI	213+89.46	214+79.51	90.05				127873.85	524604.05	127963.85	524607.09	1° 56' 05.82
207	PI	214+79.51	216+39.42	159.91				127963.85	524607.09	128123.76	524607.17	0° 01' 32.6
208	PI	216+39.42	218+84.51	245.08				128123.76	524607.17	128368.75	524600.28	358° 23' 20.
209	PI	218+84.51	219+34.51	50.00				128368.75	524600.28	128418.75	524600.30	0° 01' 32.54
210	PI	219+34.51	219+96.58	62.07				128418.75	524600.30	128480.83	524600.33	0° 01' 32.4
211	PI	219+96.58	220+40.58	43.99				128480.83	524600.33	128524.82	524600.34	0° 01' 30.4
212	PI	220+40.58	221+22.40	81.83				128524.82	524600.34	128606.64	524599.38	359° 19' 25.
213	PI	221+22.40	225+88.81	466.41				128606.64	524599.38	129073.05	524599.58	0° 01' 30.6
214	PI	225+88.81	226+48.26	59.44				129073.05	524599.58	129132.49	524599.61	0° 01' 30.6
215	PI	226+48.26	229+96.50	348.24				129132.49	524599.61	129480.74	524599.76	0° 01' 30.3
216	PI	229+96.50	231+39.31	142.81				129480.74	524599.76	129623.55	524599.83	0° 01' 30.6
217	PC	231+39.31	231+94.77	55.46	1° 15' 30.84"	2525.00	55.46	129623.55	524599.83	129679.01	524599.24	359° 23' 45.:
218	PCC	231+94.77	233+75.47	180.69	4° 06' 00.61"	2525.00	180.65	129679.01	524599.24	129859.36	524588.89	356° 42' 59.
219	PCC	233+75.47	235+08.78	133.32	3° 01' 30.52"	2525.00	133.30	129859.36	524588.89	129991.72	524573.00	353° 09' 13.9

	72ND ST													
POINT ID														
600	ВОР	25+00	25+49.63	49.63				129754.78	524596.47	129757.96	524646.00	86° 19' 32.64"		
601	PC	25+49.63	25+60.58	10.95	3° 08' 13.01"	200.00	10.95	129757.96	524646.00	129758.36	524656.94	87° 53' 39.15"		
602	PT	25+60.58	26+00	39.41				129758.36	524656.94	129758.73	524696.36	89° 27' 45.66"		
603	603 EOP 26+00 26+00 0.00 129758.73 524696.36 129758.73 524696.36 89° 27' 45.66"													

	71ST ST WEST														
POINT ID															
700	ВОР	30+00	30+16.60	16.60				130009.92	524494.01	130009.94	524510.60	89° 55' 59.80"			
701	PC	30+16.60	30+48.47	31.87	9° 07' 52.10"	200.00	31.84	130009.94	524510.60	130012.51	524542.34	85° 22' 03.75"			
703	PT	30+48.47	30+93.39	44.91				130012.51	524542.34	130019.69	524586.68	80° 48' 07.70"			
704	704 EOP 30+93.39 30+93.39 0.00 130019.69 524586.68 130019.69 524586.68 80° 48' 07.70"														







12224 NICOLLET AVENUE
BURNSVILLE, MINNESOTA 55337
Phone: (952) 890-0509
Email: Burnsville@bolton-menk.com
www.bolton-menk.com


Poriod
The Urban Hometown

	DESIGNED ZP/TL/SL	NO.	REVISION	DATE	CITY OF RICHFIELD, I
i.	DRAWN				<u>'</u>
	ZP/JW				S.A.P. 157-363-032, LYNDALE AVE
	TL/SL				
	CLIENT PROJ. NO.				ALIGNMENT PLAN &
	T16114541				7.2.0

CHFIELD, MINNESOTA

YNDALE AVENUE RECONSTRUCTION

T PLAN & TABULATION

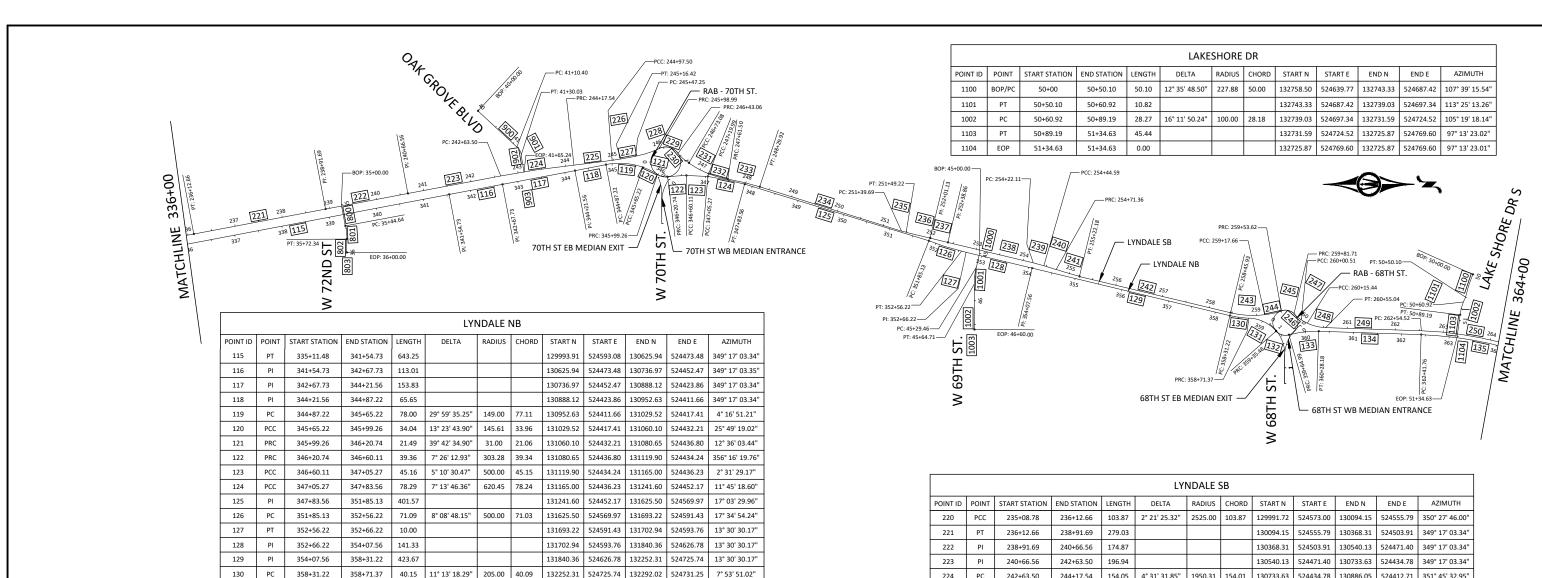

	71ST ST EAST													
POINT ID														
800	ВОР	35+00	35+44.64	44.64				130401.26	524495.13	130409.56	524539.00	79° 17' 03.34"		
801	PC	35+44.64	35+72.34	27.69	10° 34' 43.29"	150.00	27.66	130409.56	524539.00	130412.18	524566.53	84° 34' 24.99"		
802	PT	35+72.34	36+00	27.66				130412.18	524566.53	130412.25	524594.19	89° 51' 46.63"		
803	EOP	36+00	36+00	0.00				130412.25	524594.19	130412.25	524594.19	89° 51' 46.63"		

18° 11' 43.43" | 199.00 | 62.93

79.00 62.37

26.00 27.95

364+93.73 | 251.97 | 18° 58' 35.01" | 760.78 | 250.82 | 132651.01 | 524765.45 | 132896.83 | 524815.28 | 11° 27' 33.75"

132292.02 524731.25 132348.29

132348.29 524758.13 132375.12

132375.12 524765.96 132437.56

524758.13

524765.96

132437.56 | 524758.14 | 132651.01 | 524765.45 | 1° 57' 39.33"

25° 32' 05.84"

16° 16' 27.85"

524758.14 352° 51' 47.62'

46° 29' 47.92"

65° 01' 03.90"

	OAK GROVE BLVD														
POINT ID															
900	ВОР	40+00	41+10.40	110.40				130685.83	524299.60	130766.65	524374.80	42° 56' 13.60"			
901	PC	41+10.40	41+30.03	19.64	37° 30' 00.81"	30.00	19.29	130766.65	524374.80	130775.80	524391.78	61° 41' 14.01"			
902	PT	41+30.03	41+65.24	35.20				130775.80	524391.78	130781.65	524426.50	80° 26' 14.41"			
903	EOP	41+65.24	41+65.24	0.00				130781.65	524426.50	130781.65	524426.50	80° 26' 14.25"			

	69TH ST														
POINT ID	POINT	START STATION	END STATION	LENGTH	DELTA	RADIUS	CHORD	START N	START E	END N	END E	AZIMUTH			
1000	ВОР	45+00	45+29.46	29.46				131731.02	524596.07	131724.10	524624.71	103° 34' 23.66"			
1001	PC	45+29.46	45+64.71	35.25	13° 27' 50.68"	150.00	35.17	131724.10	524624.71	131719.91	524659.63	96° 50' 28.32"			
1002	1002 PT 45+64.71 46+60 95.30 131719.91 524659.63 131719.73 524754.92 270° 06′ 32.98"														
1003	EOP	46+60	46+60	0.00				131719.73	524754.92	131719.73	524754.92	90° 06' 32.98"			

	LYNDALE SB											
POINT ID	POINT	START STATION	END STATION	LENGTH	DELTA	RADIUS	CHORD	START N	START E	END N	END E	AZIMUTH
220	PCC	235+08.78	236+12.66	103.87	2° 21' 25.32"	2525.00	103.87	129991.72	524573.00	130094.15	524555.79	350° 27' 46.00
221	PT	236+12.66	238+91.69	279.03				130094.15	524555.79	130368.31	524503.91	349° 17' 03.3
222	PI	238+91.69	240+66.56	174.87				130368.31	524503.91	130540.13	524471.40	349° 17' 03.34
223	PI	240+66.56	242+63.50	196.94				130540.13	524471.40	130733.63	524434.78	349° 17' 03.34
224	PC	242+63.50	244+17.54	154.05	4° 31' 31.85"	1950.31	154.01	130733.63	524434.78	130886.05	524412.71	351° 45′ 32.9
225	PRC	244+17.54	244+97.50	79.96	2° 20' 57.42"	1950.00	79.95	130886.05	524412.71	130965.37	524402.67	352° 47' 34.40
226	PCC	244+97.50	245+16.42	18.93	2° 07' 19.37"	511.00	18.92	130965.37	524402.67	130984.04	524399.57	350° 33' 26.00
227	PT	245+16.42	245+47.25	30.83				130984.04	524399.57	131014.35	524393.95	349° 29' 46.32
228	PC	245+47.25	245+98.99	51.74	14° 53' 48.91"	199.00	51.59	131014.35	524393.95	131063.43	524378.05	342° 02' 51.8
229	PRC	245+98.99	246+43.06	44.07	81° 26' 45.68"	31.00	40.45	131063.43	524378.05	131102.45	524388.74	15° 19' 20.25
230	PRC	246+43.06	246+73.08	30.02	19° 21' 43.81"	88.83	29.88	131102.45	524388.74	131125.25	524408.03	40° 14' 19.54
231	PCC	246+73.08	247+19.99	46.91	13° 26' 15.36"	200.00	46.80	131125.25	524408.03	131166.38	524430.36	28° 29' 31.75
232	PCC	247+19.99	247+61.50	41.51	11° 53' 32.54"	200.00	41.44	131166.38	524430.36	131206.25	524441.66	15° 49' 37.80
233	PRC	247+61.50	248+29.92	68.42	9° 34' 27.16"	409.44	68.34	131206.25	524441.66	131272.68	524457.68	13° 33' 29.59
234	PT	248+29.92	251+39.69	309.78				131272.68	524457.68	131568.35	524550.10	17° 21' 30.84
235	PC	251+39.69	251+49.22	9.53	6° 06' 31.08"	89.36	9.52	131568.35	524550.10	131577.61	524552.34	13° 35' 25.33
236	PT	251+49.22	252+01.13	51.91				131577.61	524552.34	131628.08	524564.47	13° 30' 30.17
237	PI	252+01.13	252+38.86	37.73				131628.08	524564.47	131664.76	524573.28	13° 30' 30.17
238	PI	252+38.86	254+22.11	183.25				131664.76	524573.28	131842.95	524616.08	13° 30' 30.17
239	PC	254+22.11	254+44.59	22.49	2° 34' 17.58"	501.00	22.48	131842.95	524616.08	131864.68	524621.85	14° 51' 32.45
240	PCC	254+44.59	254+71.36	26.77	3° 03' 41.87"	501.00	26.77	131864.68	524621.85	131890.18	524629.98	17° 40' 32.17
241	PRC	254+71.36	255+22.18	50.82	5° 41' 52.93"	511.00	50.80	131890.18	524629.98	131938.92	524644.28	16° 21' 26.64
242	PI	255+22.18	258+45.93	323.74				131938.92	524644.28	132253.71	524719.91	13° 30' 30.17
243	PC	258+45.93	259+17.66	71.73	20° 39' 07.66"	199.00	71.34	132253.71	524719.91	132324.94	524723.87	3° 10′ 56.34′
244	PCC	259+17.66	259+53.62	35.96	10° 21' 16.11"	199.00	35.91	132324.94	524723.87	132360.03	524716.20	347° 40' 44.4
245	PRC	259+53.62	259+81.71	28.09	61° 53' 50.60"	26.00	26.74	132360.03	524716.20	132386.04	524722.42	13° 27' 01.70
246	PRC	259+81.71	260+00.51	18.80	10° 52' 52.16"	99.00	18.77	132386.04	524722.42	132400.64	524734.23	38° 57' 30.91
247	PCC	260+00.51	260+15.44	14.93	8° 38' 35.21"	99.00	14.92	132400.64	524734.23	132413.66	524741.51	29° 11' 47.22
248	PCC	260+15.44	260+55.04	39.59	22° 54' 50.29"	99.00	39.33	132413.66	524741.51	132451.92	524750.63	13° 25' 04.47
249	PT	260+55.04	262+54.52	199.49				132451.92	524750.63	132651.29	524757.46	1° 57′ 39.33′
250	PC	262+54.52	265+00.97	246.45	18° 24' 20.41"	767.18	245.39	132651.29	524757.46	132892.03	524804.97	11° 09' 49.54









	ZP/TL/S
old.	ZP/JW
ietown	CHECKED TL/SL
	CLIENT PROJ. NO. T161145

0	NO.	REVISION	DATE	OUTLY OF BLOUEIELD ANNUALES OF A
P/TL/SL				CITY OF RICHFIELD, MINNESOTA
ZP/JW				S.A.P. 157-363-032, LYNDALE AVENUE RECONSTRUCTION
ZP/JVV				3.A.P. 137-303-032, LTINDALE AVEINUE RECONSTRUCTION
TL/SL				
ROJ. NO.				ALIGNMENT PLAN & TABULATION
6114541				

C6.02

SHEET

131

132

133

PRC

PRC

PRC

PT

PC

358+71.37

359+35.48

359+64.99

360+28.18

362+41.76

359+35.48

359+64.99

360+28.18


362+41.76 213.58

64.11

29.50

63.20



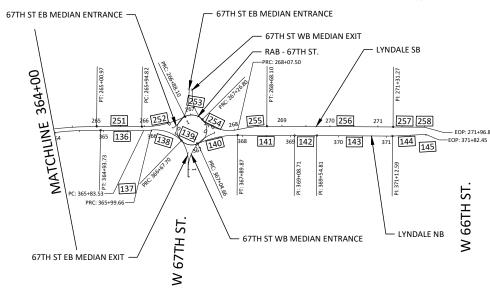

	LYNDALE NB											
POINT ID	POINT	START STATION	END STATION	LENGTH	DELTA	RADIUS	CHORD	START N	START E	END N	END E	AZIMUTH
136	PT	364+93.73	365+83.53	89.80				132896.83	524815.28	132981.02	524846.54	20° 21' 59.75"
137	PC	365+83.53	365+99.66	16.13	3° 54' 37.27"	236.38	16.13	132981.02	524846.54	132996.46	524851.22	16° 52' 24.25"
138	PRC	365+99.66	366+67.70	68.03	49° 20' 27.11"	79.00	65.95	132996.46	524851.22	133047.38	524893.13	39° 27' 06.04"
139	PRC	366+67.70	367+04.66	36.96	68° 18' 41.23"	31.00	34.81	133047.38	524893.13	133077.54	524910.51	29° 57' 58.98"
140	PRC	367+04.66	367+89.87	85.21	24° 32' 00.80"	199.00	84.56	133077.54	524910.51	133161.26	524922.39	8° 04' 38.77"
141	PT	367+89.87	369+08.71	118.85				133161.26	524922.39	133272.69	524963.71	20° 20' 39.17"
142	PI	369+08.71	369+54.81	46.10				133272.69	524963.71	133315.91	524979.74	20° 20' 39.17"
143	PI	369+54.81	371+12.59	157.78				133315.91	524979.74	133463.85	525034.59	20° 20' 39.17"
144	PI	371+12.59	371+82.44	69.86				133463.85	525034.59	133530.67	525054.96	16° 57' 14.96"
145	EOP	371+82.44	371+82.45	0.00				133530.67	525054.96	133530.67	525054.96	16° 57' 14.95"


	LYNDALE SB											
POINT ID	POINT	START STATION	END STATION	LENGTH	DELTA	RADIUS	CHORD	START N	START E	END N	END E	AZIMUTH
251	PT	265+00.97	265+94.82	93.84				132892.03	524804.97	132980.01	524837.63	20° 21' 59.75"
252	PC	265+94.82	266+88.10	93.28	26° 51' 29.22"	199.00	92.43	132980.01	524837.63	133071.77	524848.79	6° 56' 15.14"
253	PRC	266+88.10	267+26.80	38.70	71° 31' 54.28"	31.00	36.24	133071.77	524848.79	133103.38	524866.51	29° 16' 27.67"
254	PRC	267+26.80	268+07.50	80.70	58° 31' 45.48"	79.00	77.24	133103.38	524866.51	133166.04	524911.67	35° 46' 32.07"
255	PRC	268+07.50	268+68.10	60.60	13° 49' 59.84"	251.00	60.45	133166.04	524911.67	133224.84	524925.71	13° 25' 39.25"
256	PT	268+68.10	271+31.27	263.16				133224.84	524925.71	133471.63	525017.08	20° 19' 02.57"
257	PT	271+31.27	271+96.83	65.56				133471.63	525017.08	133533.10	525039.90	20° 21' 48.21"
258	PT	271+96.83	271+96.83	0.00				133533.10	525039.90	133533.10	525039.90	20° 21' 48.20"











	DES
Phold	DRA
Jrban Hometown	CHE
Irban Homes	CLIE

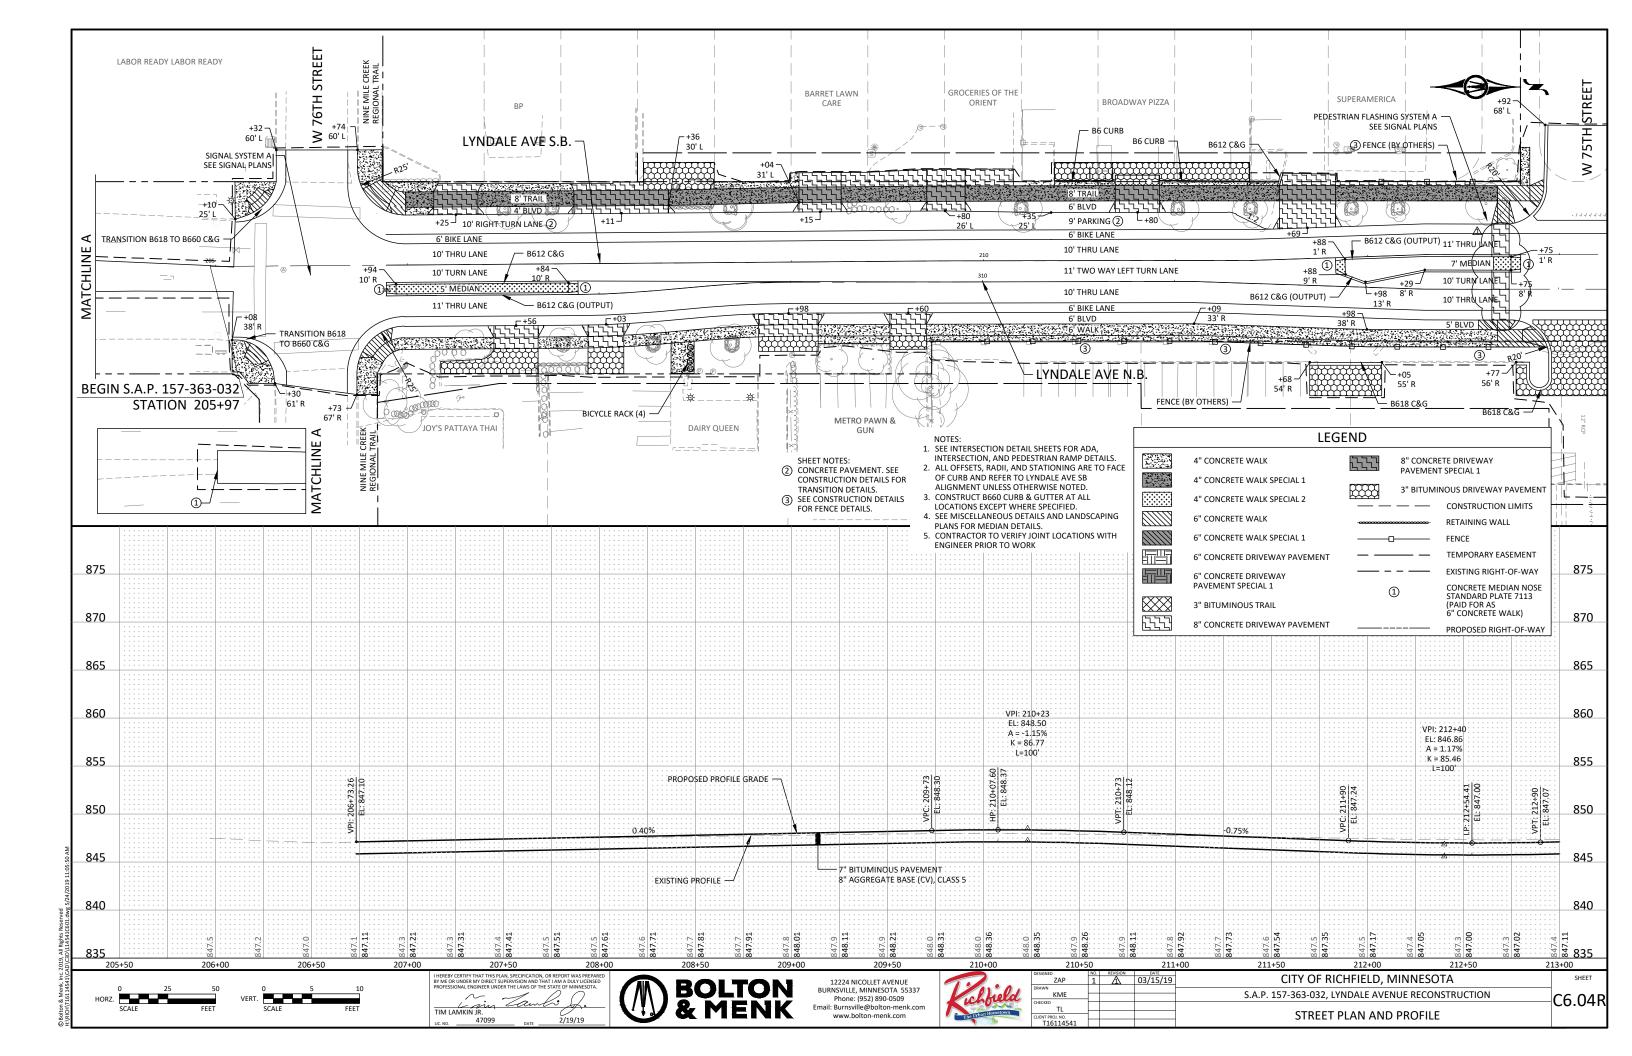


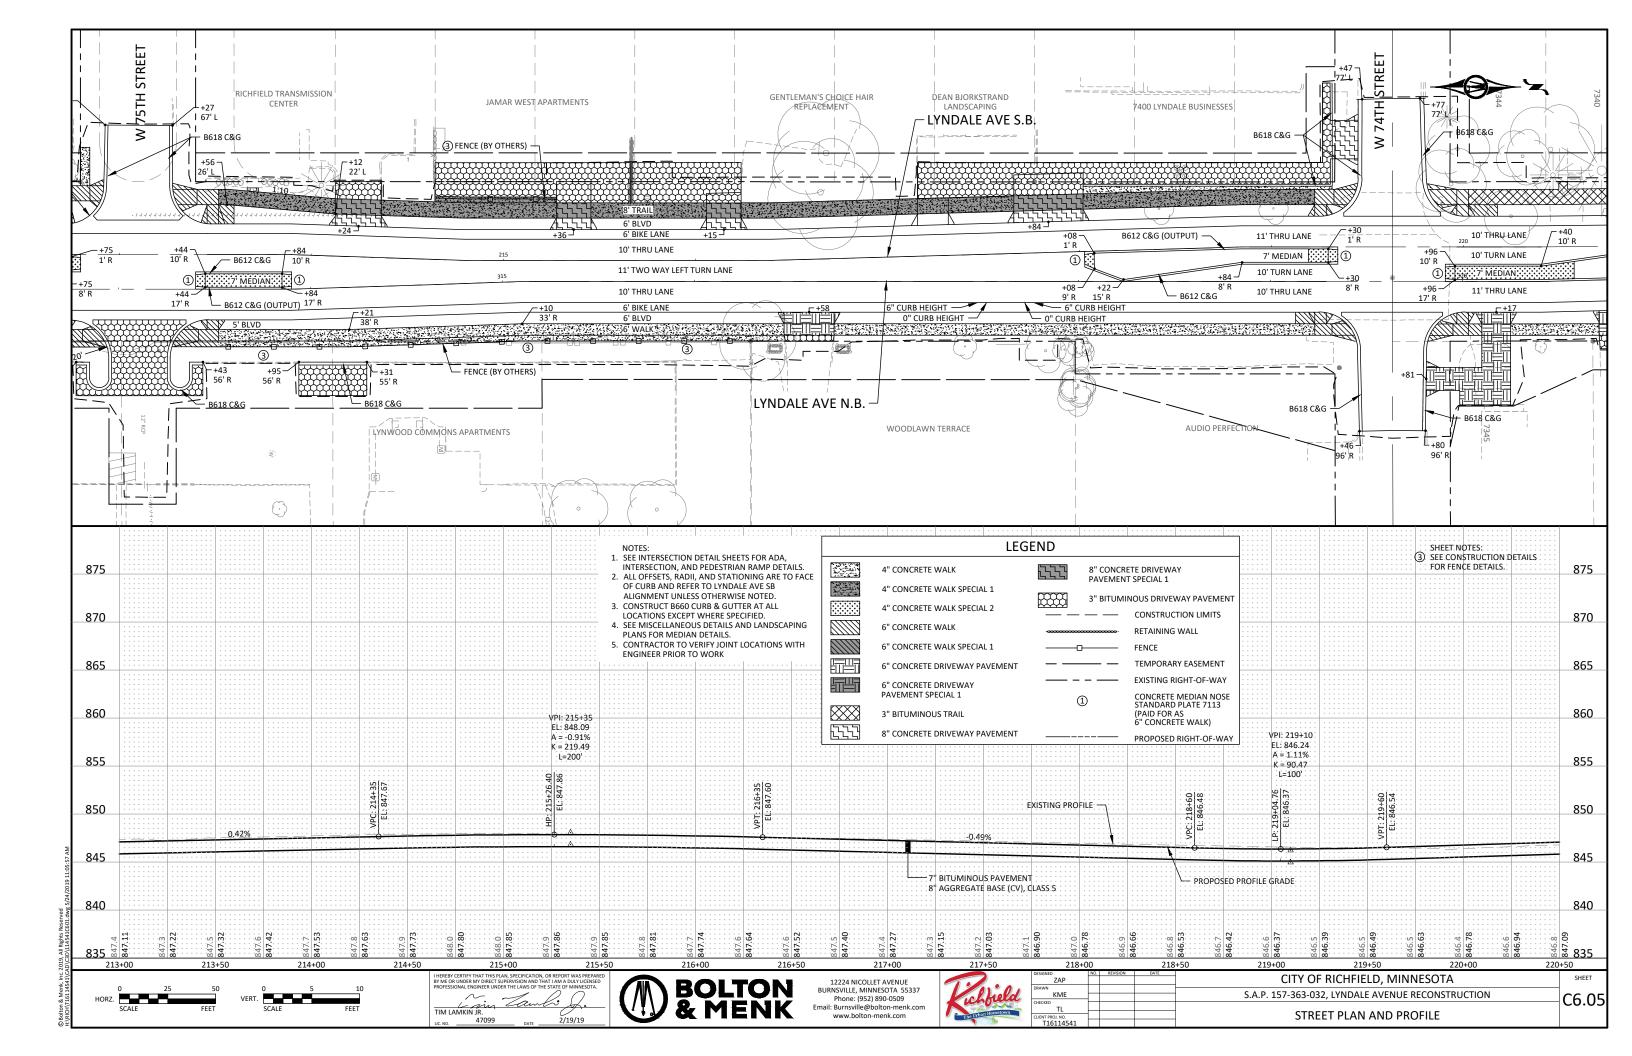


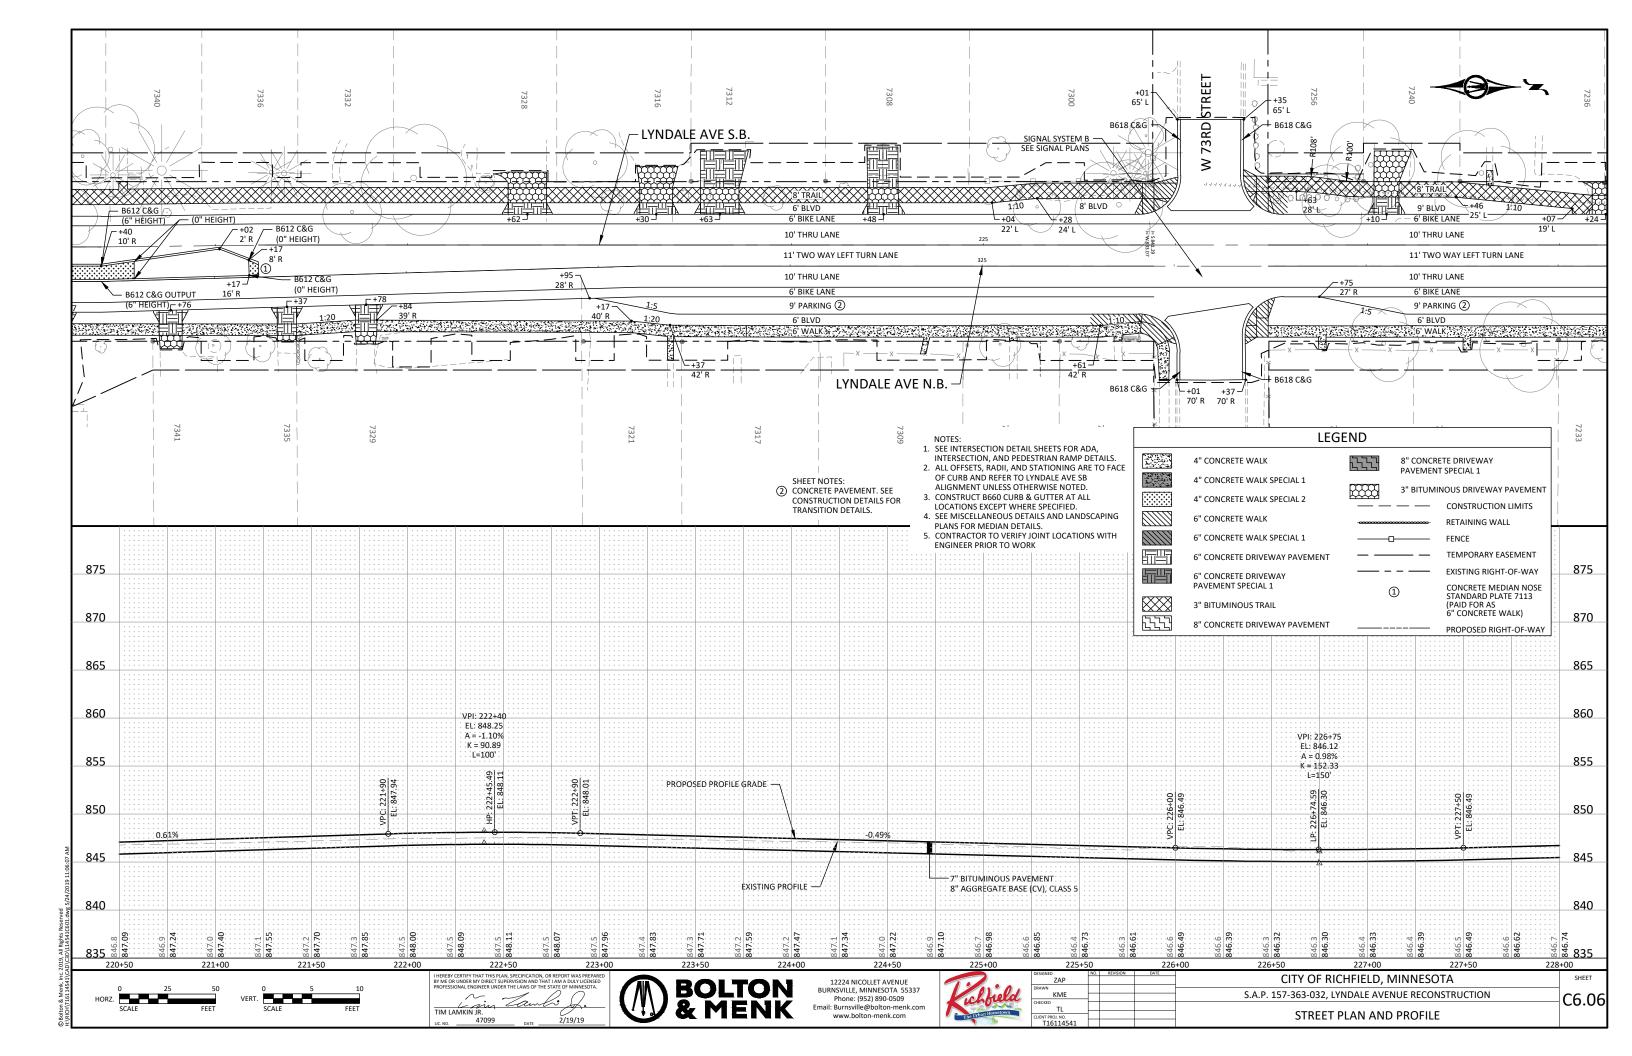


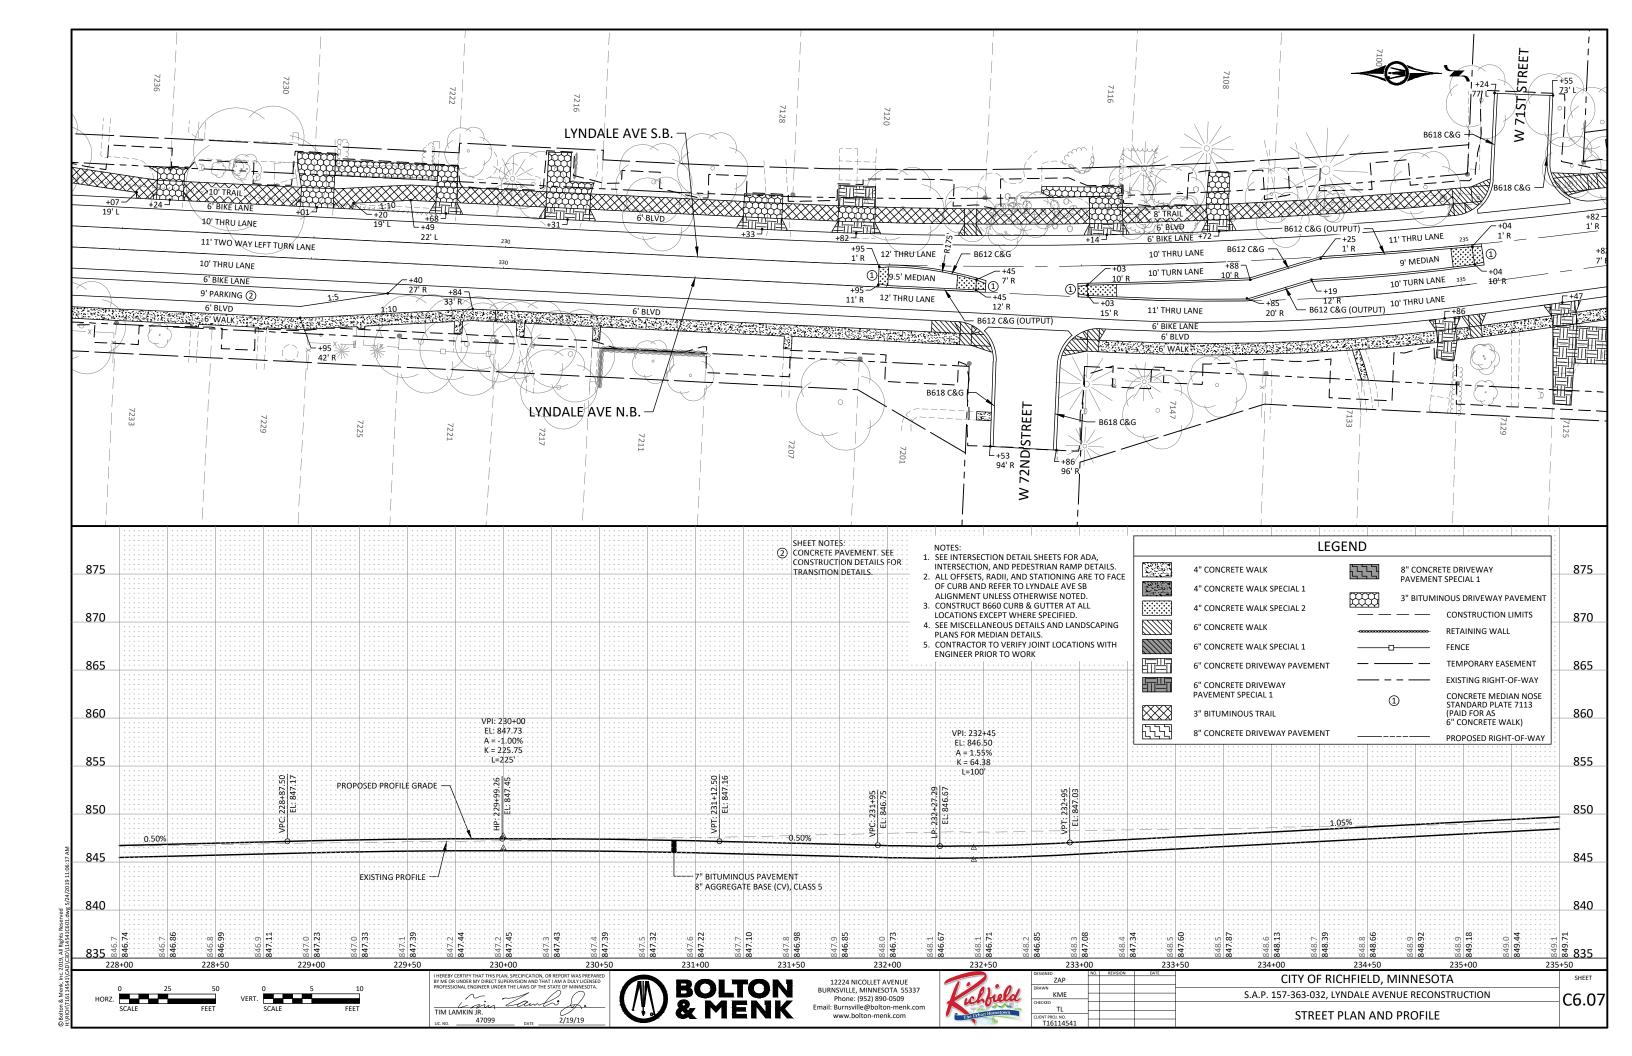


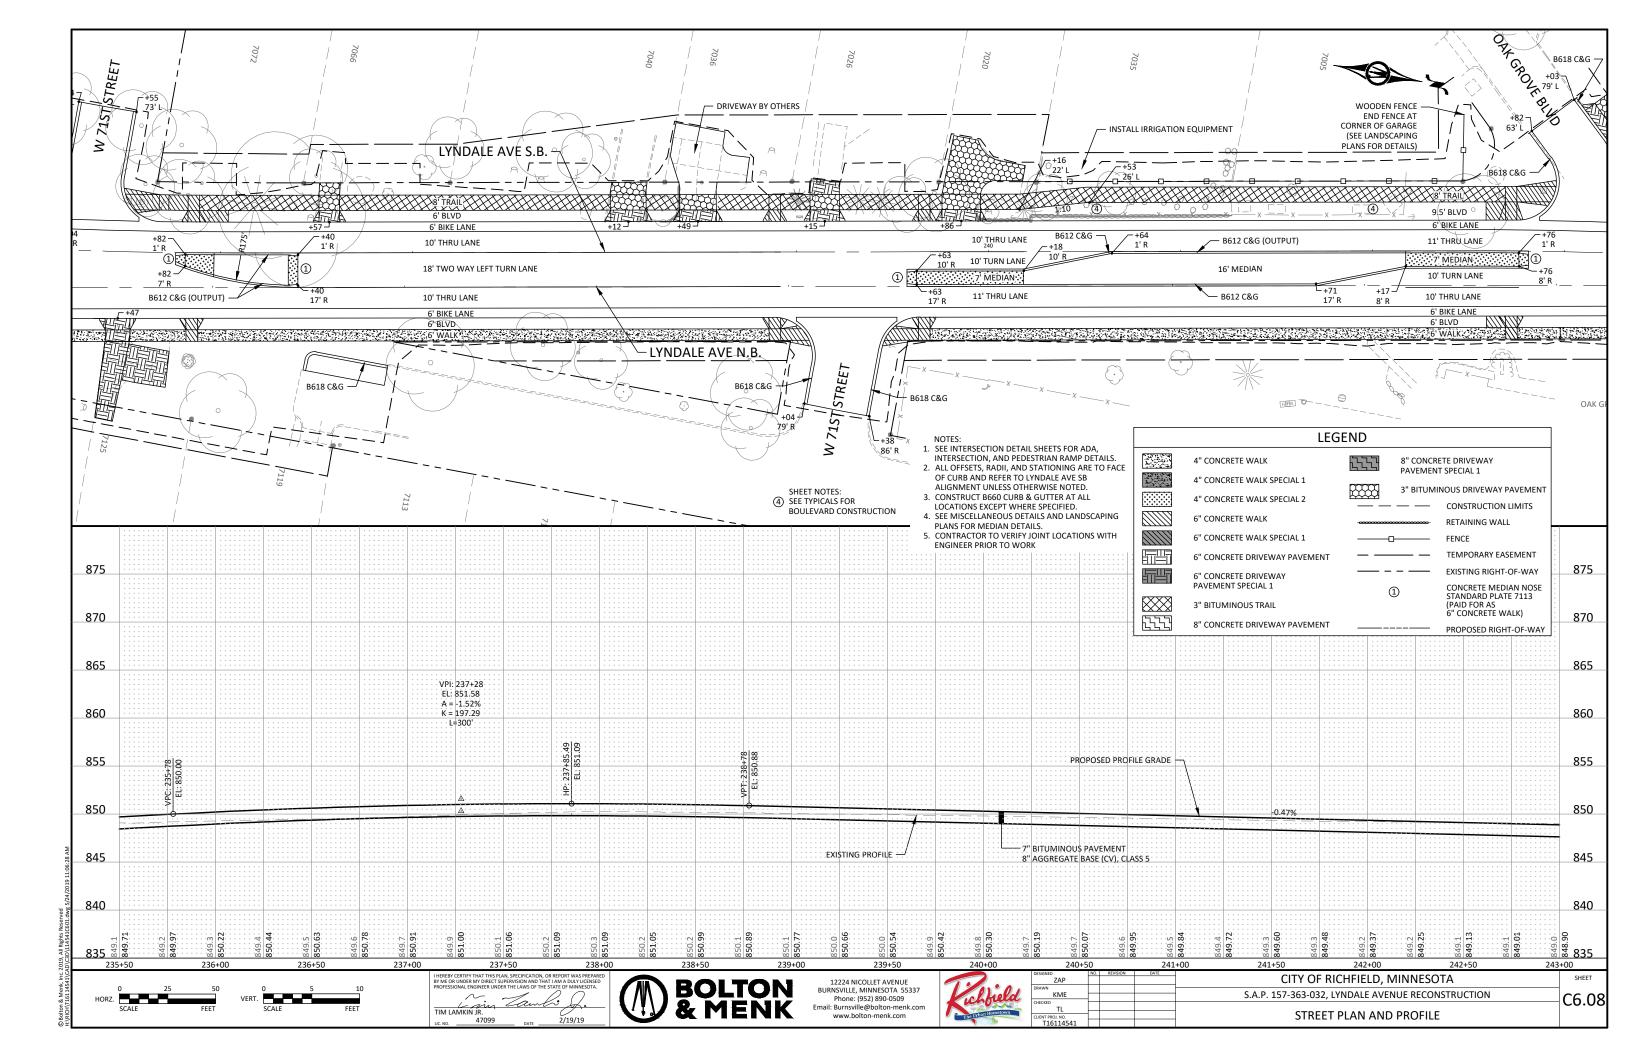


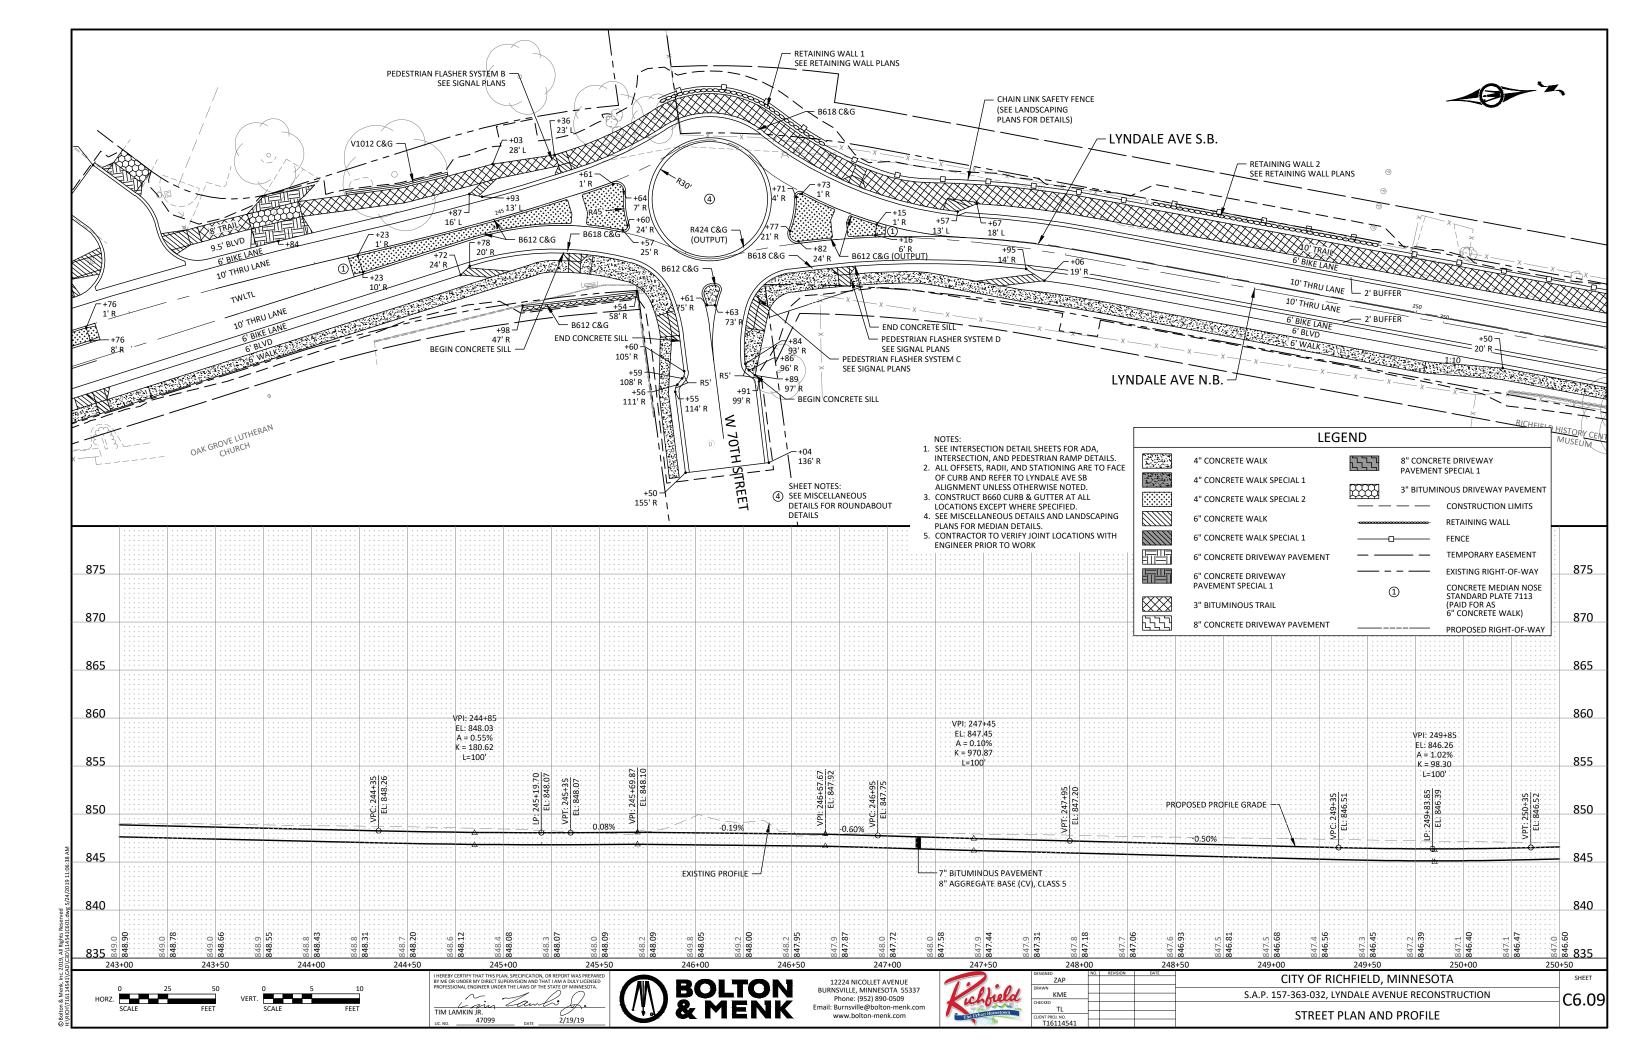


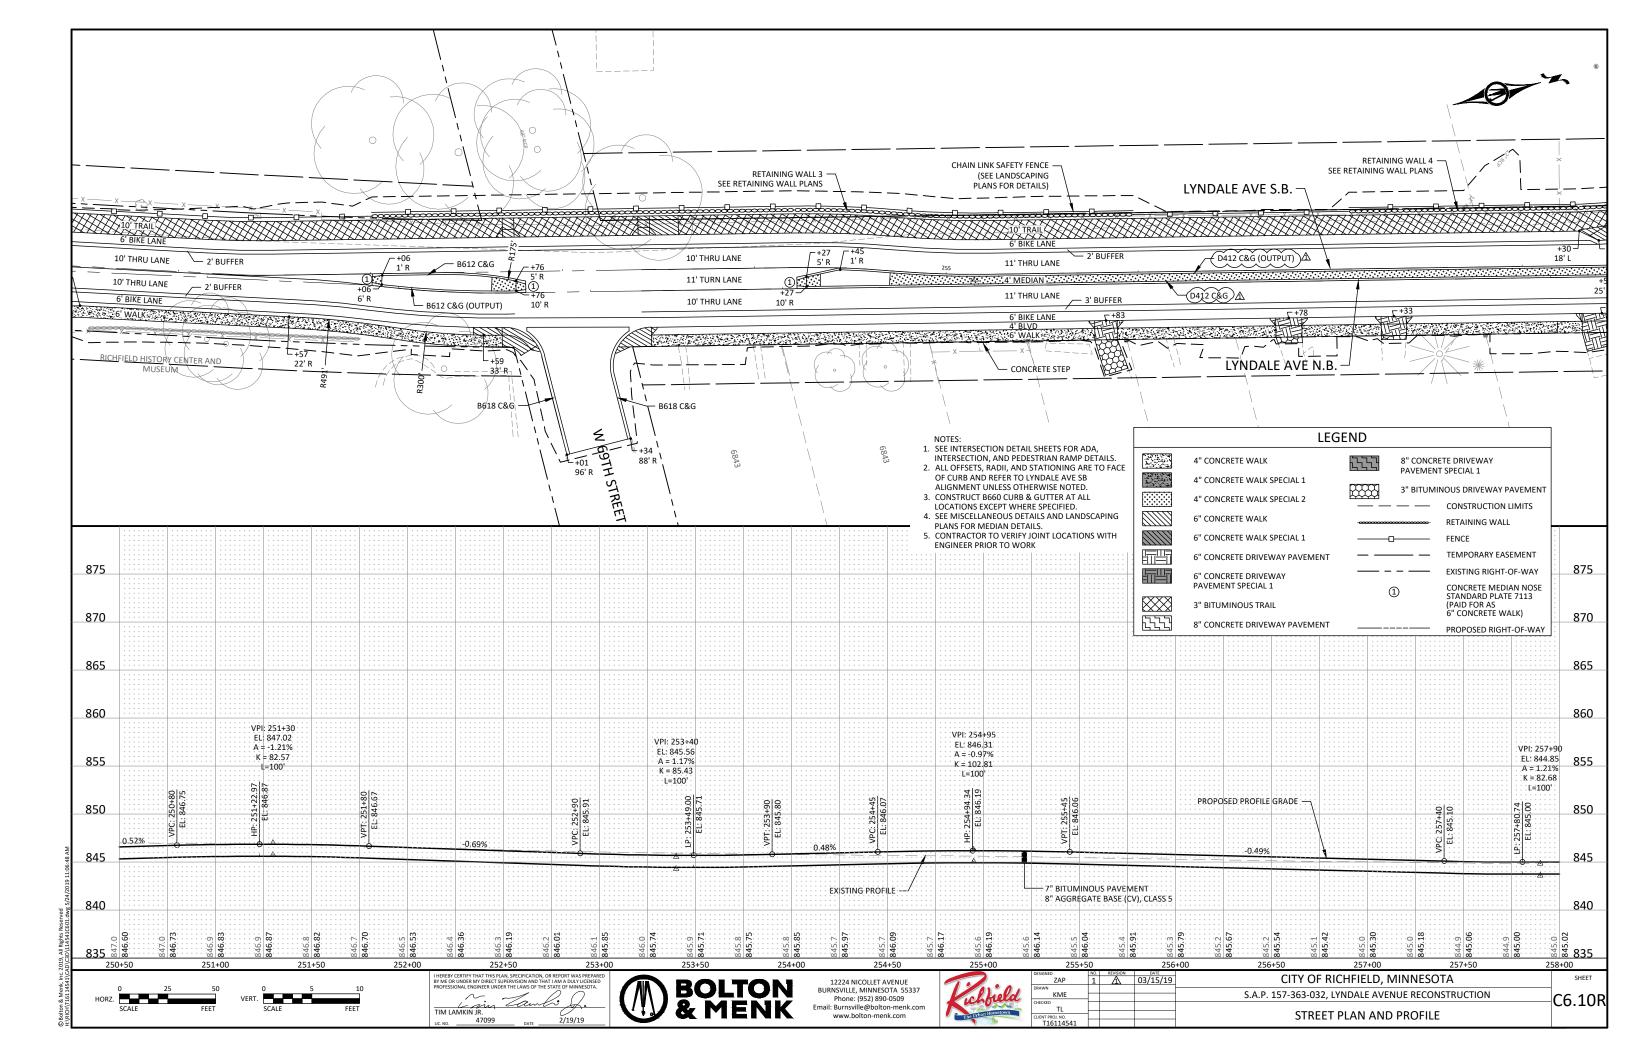

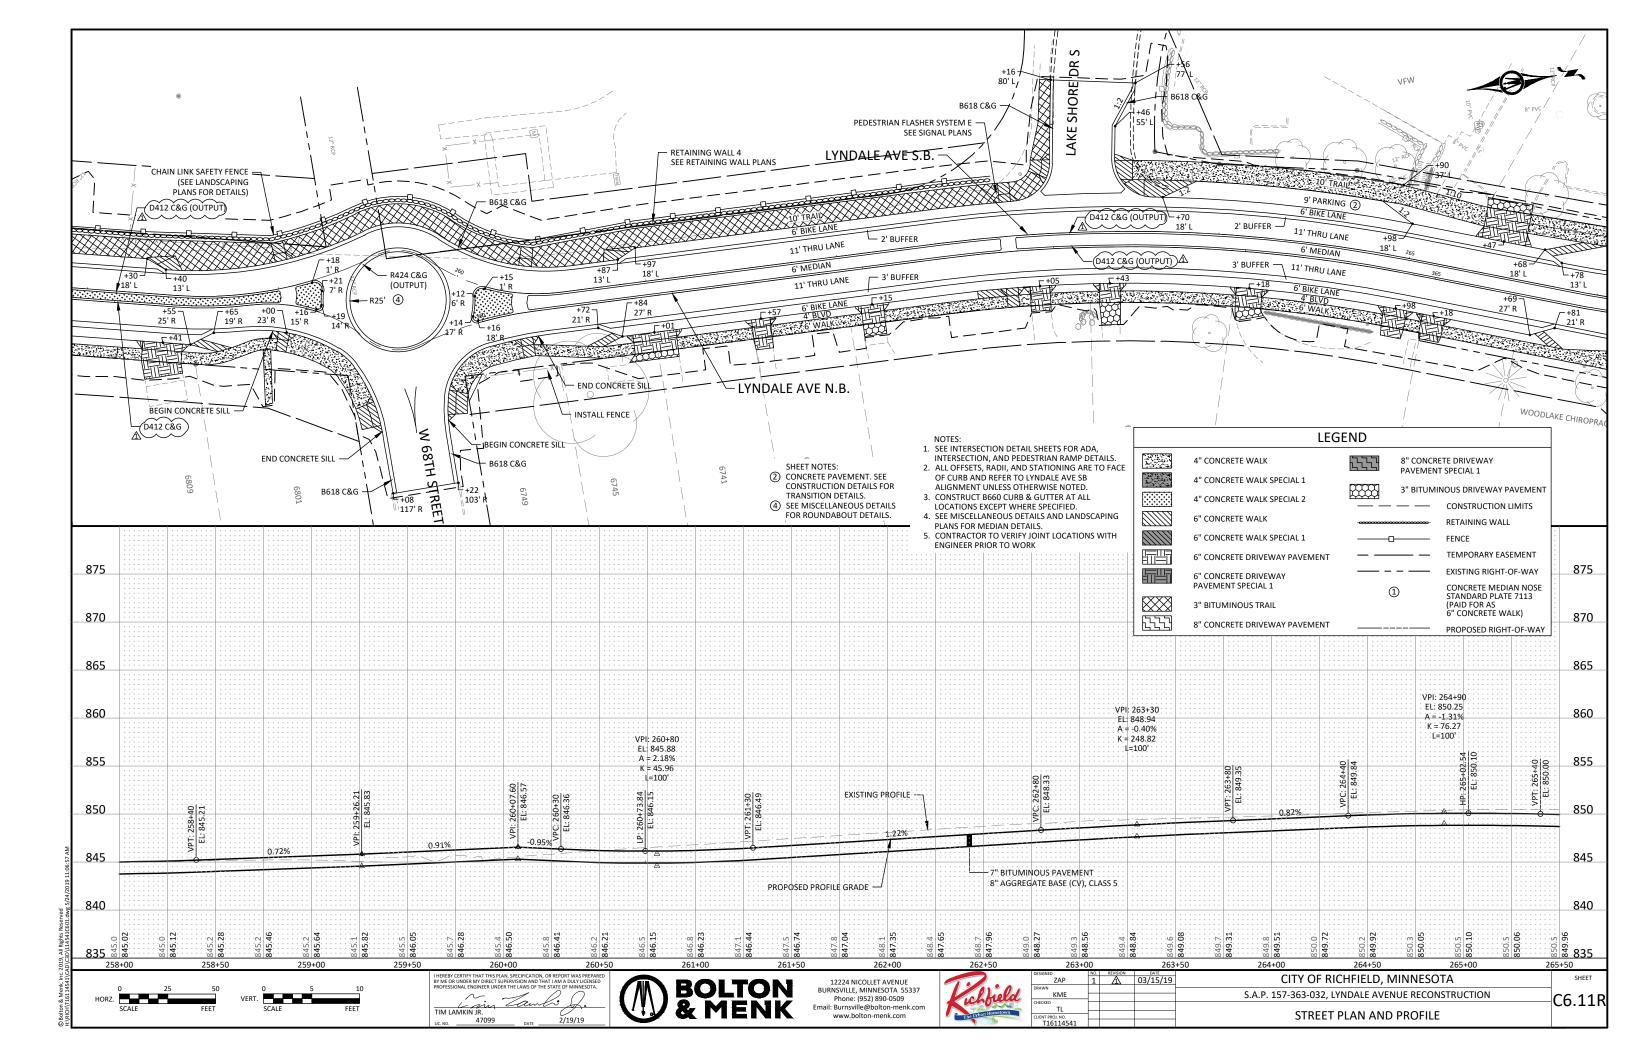

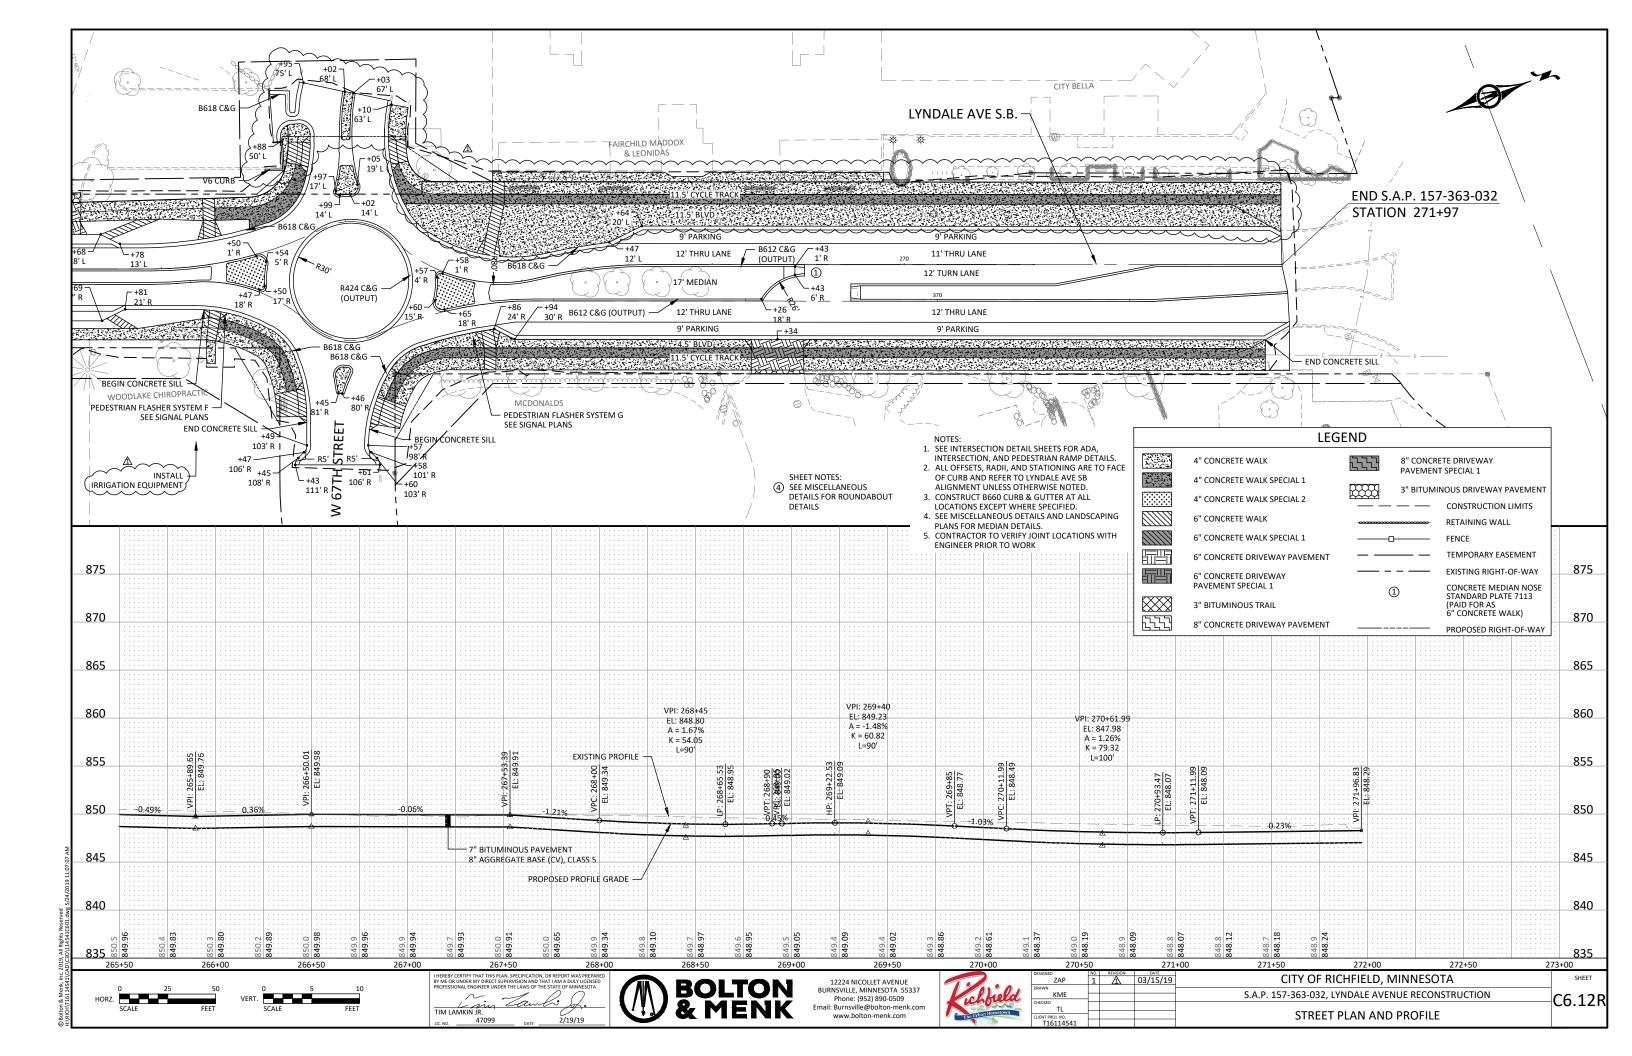

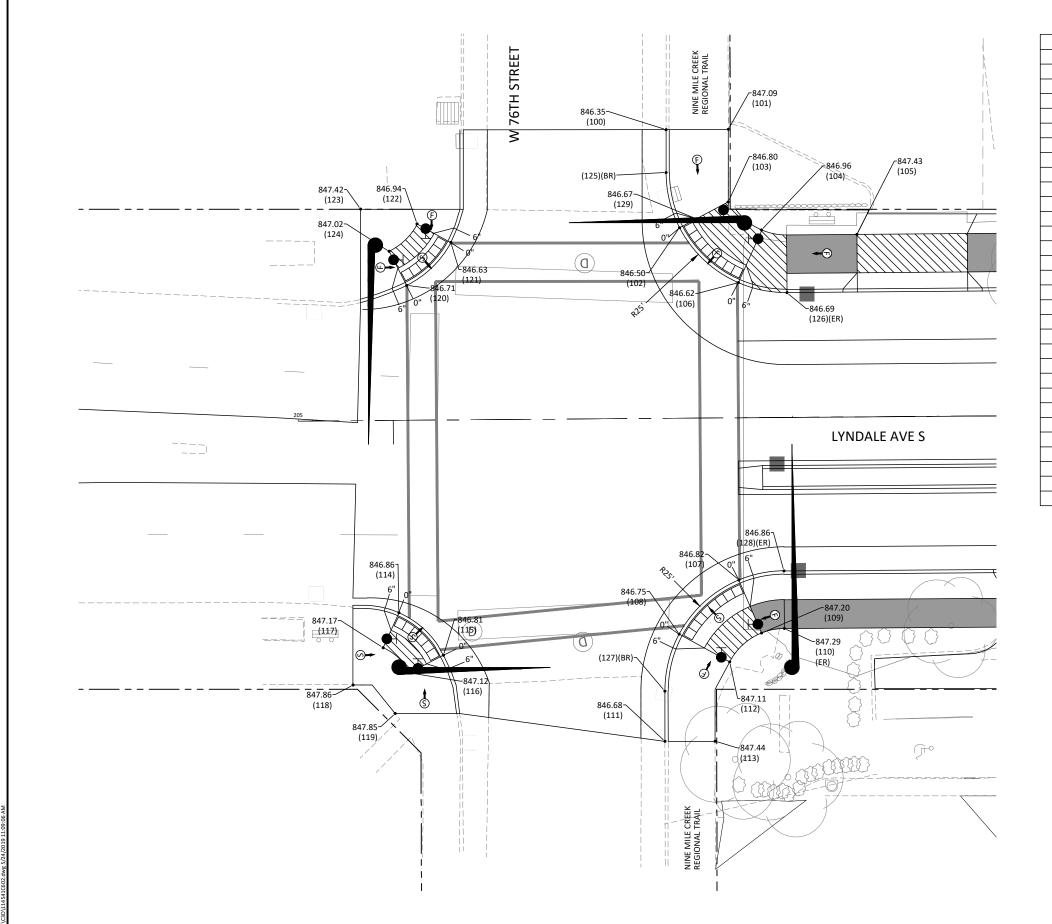

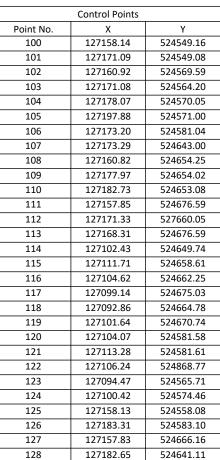

127164.46



XXX

524567.72

CONTROL POINTS AT GUTTER FLOW LINE & TOP OF CONCRETE

TRUNCATED DOMES (SEE STANDARD PLATE 7038)

CONSTRUCT CONCRETE CURB & GUTTER

LANDING AREA - 4' X 4' MIN DIMENSIONS AND MAX 2.0% SLOPE IN ALL DIRECTIONS

PEDESTRIAN ACCESS ROUTE

" CURB HEIGH

<u>\$</u>

INDICATES PEDESTRIAN RAMP - SLOPE SHALL BE BETWEEN 5.0% MINIMUM AND 8.3% MAXIMUM IN THE DIRECTION SHOWN AND CROSS SLOPE SHALL NOT EXCEED 2.0%

INDICATES PEDESTRIAN RAMP - SLOPE SHALL BE GREATER THAN 2.0% AND LESS THAN 5.0% IN THE DIRECTION SHOWN AND CROSS SLOPE

SHALL NOT EXCEED 2.0%

DRAINAGE FLOW ARROW

0 10 20 HORZ. SCALE FEET





12224 NICOLLET AVENUE BURNSVILLE, MINNESOTA 55337 Phone: (952) 890-0509 Email: Burnsville@bolton-menk.com www.bolton-menk.com



DESIGNED	NO.	REVISION	DATE	
ZAP				
DRAWN				
KME				1
CHECKED				
TL				
CLIENT PROJ. NO.				
T16114541				


1. BR = BEGIN RADIUS

ER = END RADIUS HP = HIGH POINT

LP = LOW POINT

129


____C6.13

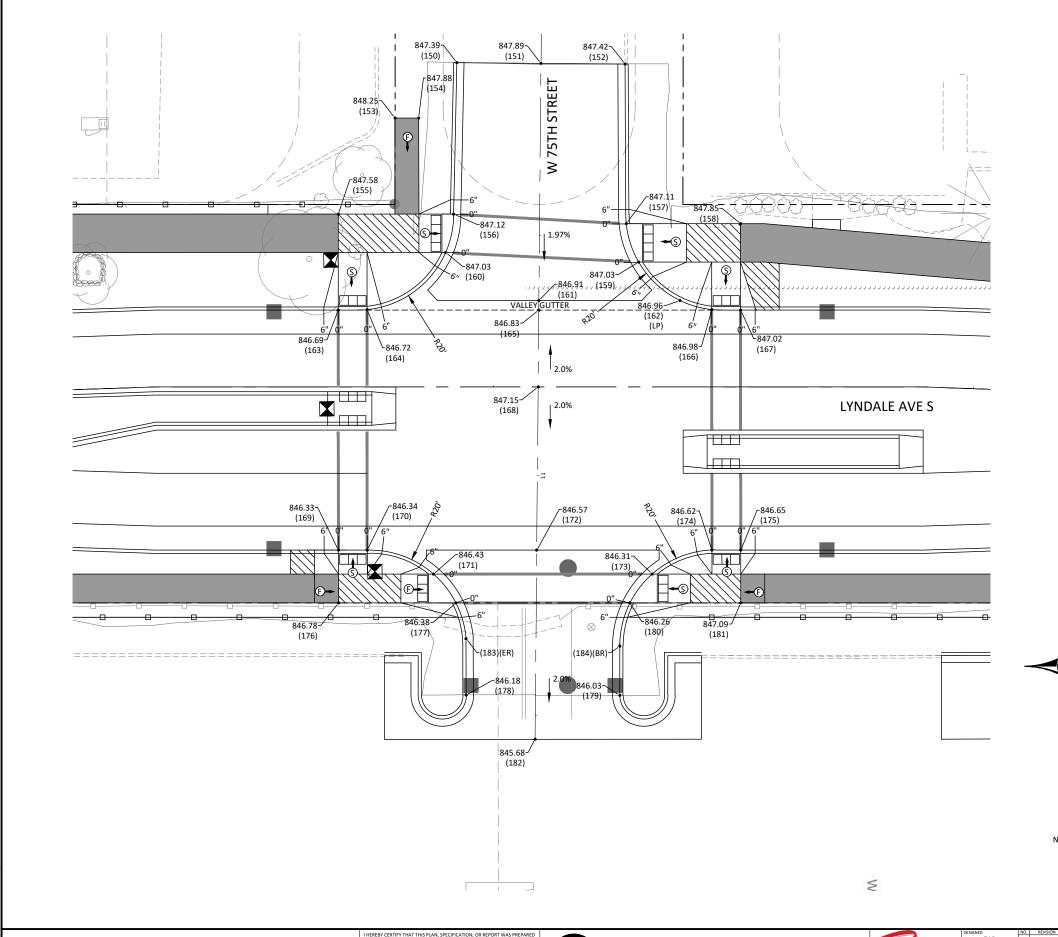

	Control Points	
Point No.	Х	Υ
150	127776.78	524536.45
151	127794.28	524536.60
152	127811.79	524536.76
153	127763.88	524548.01
154	127768.81	524548.01
155	127752.05	524568.00
156	127776.07	524568.01
157	127812.03	524570.03
158	127835.86	524570.04
159	127814.61	524578.03
160	127774.39	524576.00
161	127793.83	524586.02
162	127823.20	524586.03
163	127752.03	524588.00
164	127758.04	524587.90
165	127793.81	524588.02
166	127829.86	524587.93
167	127835.86	524588.04
168	127793.67	524604.02
169	127752.05	524638.00
170	127758.05	524638.00
171	127771.86	524643.01
172	127793.36	524638.02
173	127817.41	524643.03
174	127829.85	524638.04
175	127835.85	524638.03
176	127752.05	524649.00
177	127776.51	524649.01
178	127778.64	524668.18
179	127810.64	524668.27
180	127812.78	524649.03
181	127835.85	524649.04
182	127793.00	524677.41
183	127778.63	524656.44
184	127810.64	524658.00



1. BR = BEGIN RADIUS ER = END RADIUS HP = HIGH POINT LP = LOW POINT

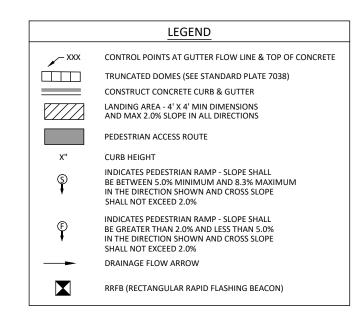






12224 NICOLLET AVENUE BURNSVILLE, MINNESOTA 55337 Phone: (952) 890-0509 Email: Burnsville@bolton-menk.com www.bolton-menk.com



DESIGNED	NO.	REVISION	DATE	
ZAP				
DRAWN				
KME				
CHECKED				
TL	\vdash			
CLIENT PROJ. NO.				

CITY OF RICHFIELD, MINNESOTA S.A.P. 157-363-032, LYNDALE AVENUE RECONSTRUCTION INTERSECTION **DETAILS**

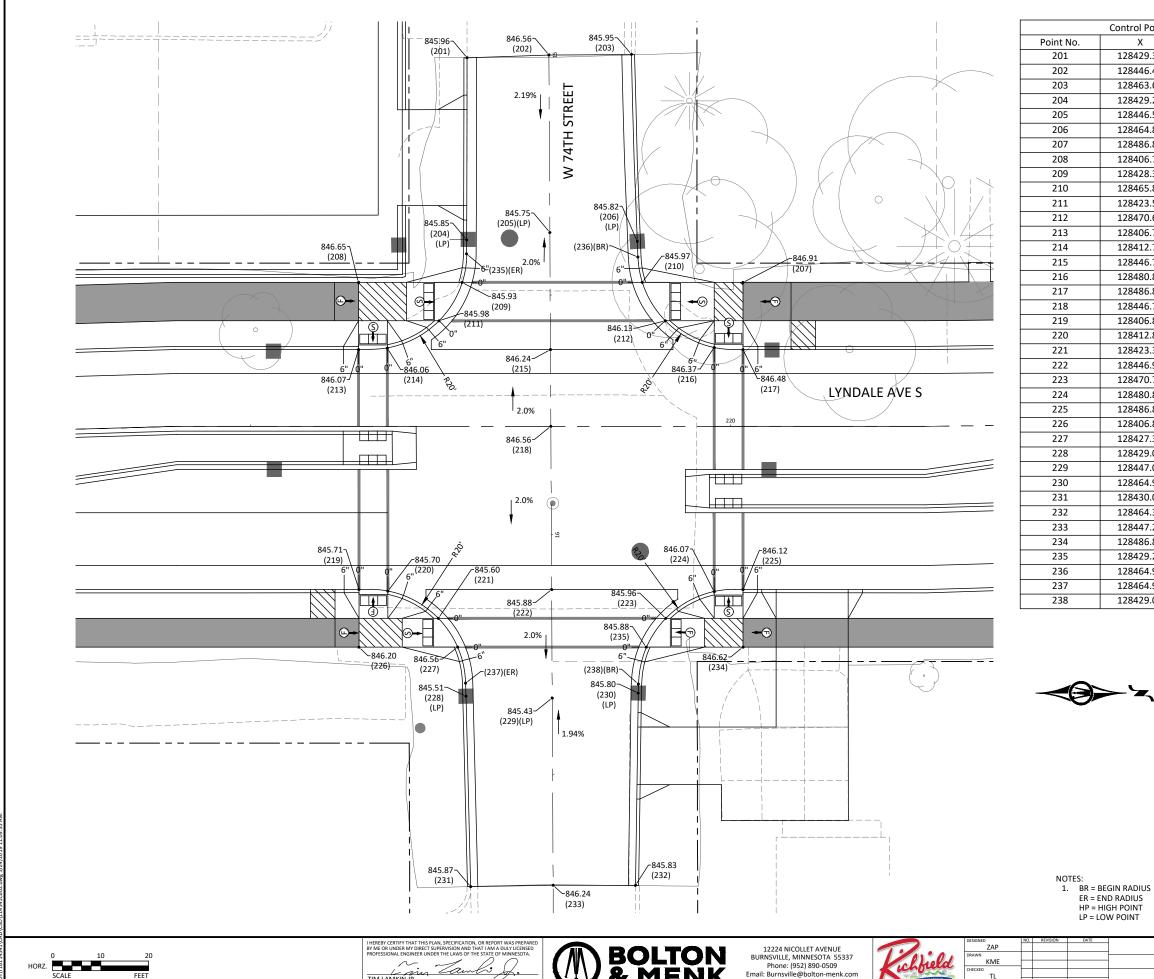

Control Points							
Point No.	X	Υ					
201	128429.36	524523.49					
202	128446.42	524522.92					
203	128463.60	524522.84					
204	128429.26	524561.42					
205	128446.59	524559.92					
206	128464.83	524561.76					
207	128486.83	524570.33					
208	128406.74	524570.29					
209	128428.32	524570.30					
210	128465.83	524570.32					
211	128423.53	524578.30					
212	128470.63	524578.32					
213	128406.73	524584.29					
214	128412.73	524583.99					
215	128446.71	524584.31					
216	128480.83	524583.91					
217	128486.83	524584.33					
218	128446.78	524600.31					
219	128406.80	524634.29					
220	128412.80	524634.65					
221	128423.31	524640.30					
222	128446.94	524634.31					
223	128470.70	524640.32					
224	128480.81	524634.77					
225	128486.81	524634.33					
226	128406.80	524646.29					
227	128427.35	524646.30					
228	128429.08	524656.53					
229	128447.03	524656.91					
230	128464.96	524655.90					
231	128430.03	524696.20					
232	128464.39	524695.95					
233	128447.23	524695.92					
234	128486.81	524646.33					
235	128429.25	524564.39					
236	128464.93	524565.07					
237	128464.98	524654.04					
238	128429.01	524653.80					



LEGEND

CONTROL POINTS AT GUTTER FLOW LINE & TOP OF CONCRETE

TRUNCATED DOMES (SEE STANDARD PLATE 7038) CONSTRUCT CONCRETE CURB & GUTTER

LANDING AREA - 4' X 4' MIN DIMENSIONS

AND MAX 2.0% SLOPE IN ALL DIRECTIONS

PEDESTRIAN ACCESS ROUTE

CURB HEIGHT

INDICATES PEDESTRIAN RAMP - SLOPE SHALL BE BETWEEN 5.0% MINIMUM AND 8.3% MAXIMUM IN THE DIRECTION SHOWN AND CROSS SLOPE SHALL NOT EXCEED 2.0%

INDICATES PEDESTRIAN RAMP - SLOPE SHALL BE GREATER THAN 2.0% AND LESS THAN 5.0% IN THE DIRECTION SHOWN AND CROSS SLOPE SHALL NOT EXCEED 2.0%

DRAINAGE FLOW ARROW




www.bolton-menk.com

SIGNED	NO.	REVISION	DATE	
ZAP				
RAWN				-
KME				1
IECKED	\vdash			
TL	ш			
JENT PROJ. NO.	1			

S.A.P. 157-363-032, LYNDALE AVENUE RECONSTRUCTION

INTERSECTION **DETAILS**

BOLTON & MENK

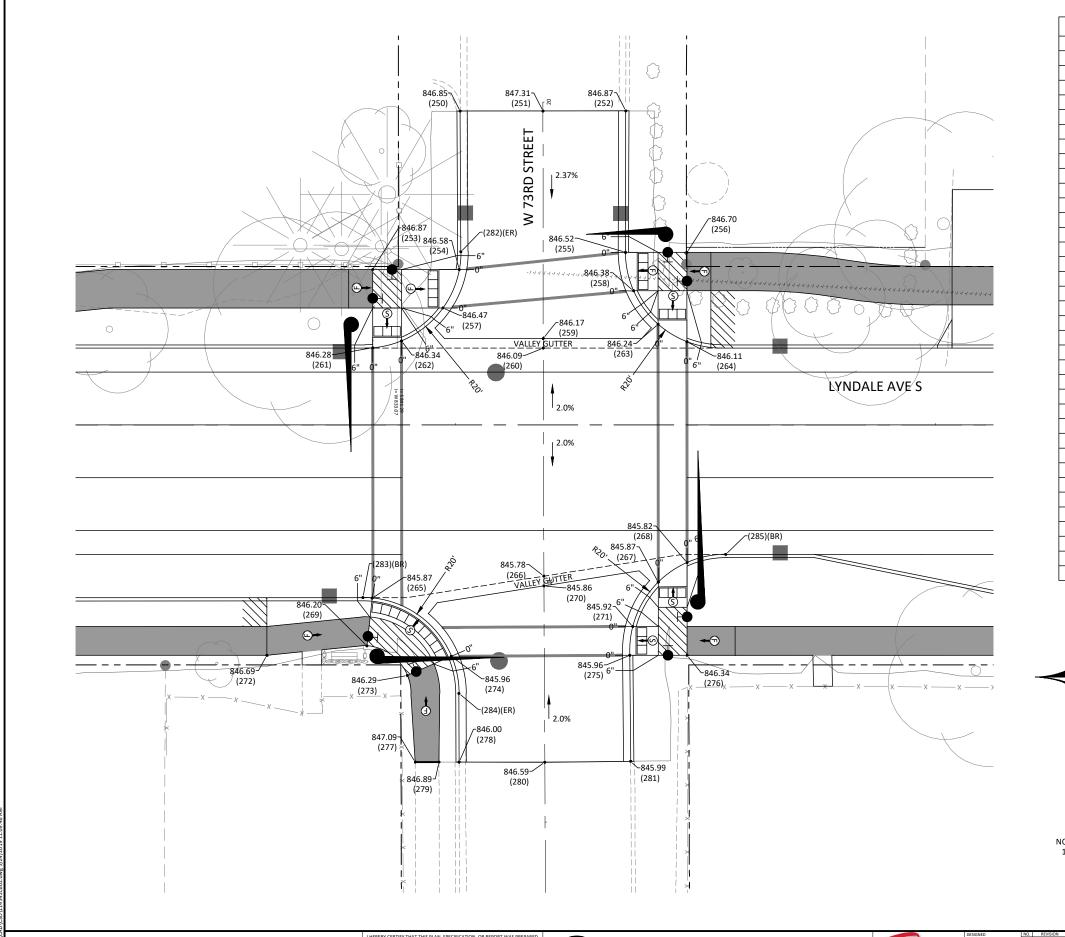

Control Points								
Point No.	Х	Υ						
250	129085.27	524534.22						
251	129102.52	524534.21						
252	129119.76	524534.18						
253	129067.04	524567.22						
254	129085.06	524567.22						
255	129119.69	524563.66						
256	129132.50	524563.67						
257	129081.65	524575.22						
258	129121.38	524571.66						
259	129102.55	524581.60						
260	129102.56	524583.60						
261	129067.03	524583.51						
262	129073.03	524582.06						
263	129126.49	524578.64						
264	129132.49	524582.27						
265	129066.89	524635.67						
266	129102.67	524631.10						
267	129126.49	524632.37						
268	129132.49	524628.30						
269	129065.80	524645.62						
270	129102.67	524633.13						
271	129121.17	524641.61						
272	129044.97	524647.57						
273	129074.21	512651.79						
274	129083.37	524647.77						
275	129120.54	524647.62						
276	129132.48	524647.61						
277	129075.86	524669.83						
278	129084.98	524669.84						
279	129080.80	524669.83						
280	129102.84	524669.87						
281	129120.73	524669.68						
282	129085.39	524563.50						
283	129064.97	524635.58						
283	129084.96	524655.55						
285	129140.54	524626.61						



XXX

INDICATES PEDESTRIAN RAMP - SLOPE SHALL BE BETWEEN 5.0% MINIMUM AND 8.3% MAXIMUM IN THE DIRECTION SHOWN AND CROSS SLOPE SHALL NOT EXCEED 2.0%

LEGEND

TRUNCATED DOMES (SEE STANDARD PLATE 7038) CONSTRUCT CONCRETE CURB & GUTTER

LANDING AREA - 4' X 4' MIN DIMENSIONS AND MAX 2.0% SLOPE IN ALL DIRECTIONS

CONTROL POINTS AT GUTTER FLOW LINE & TOP OF CONCRETE

INDICATES PEDESTRIAN RAMP - SLOPE SHALL BE GREATER THAN 2.0% AND LESS THAN 5.0% IN THE DIRECTION SHOWN AND CROSS SLOPE SHALL NOT EXCEED 2.0%

1. BR = BEGIN RADIUS ER = END RADIUS HP = HIGH POINT LP = LOW POINT

DRAINAGE FLOW ARROW

PEDESTRIAN ACCESS ROUTE







12224 NICOLLET AVENUE BURNSVILLE, MINNESOTA 55337 Phone: (952) 890-0509 Email: Burnsville@bolton-menk.com www.bolton-menk.com



DESIGNED	NO.	REVISION	DATE	
ZAP				
DRAWN				\vdash
KME	-			1
CHECKED	⊢			-
TL TL	_			
CLIENT PROJ. NO.	i			

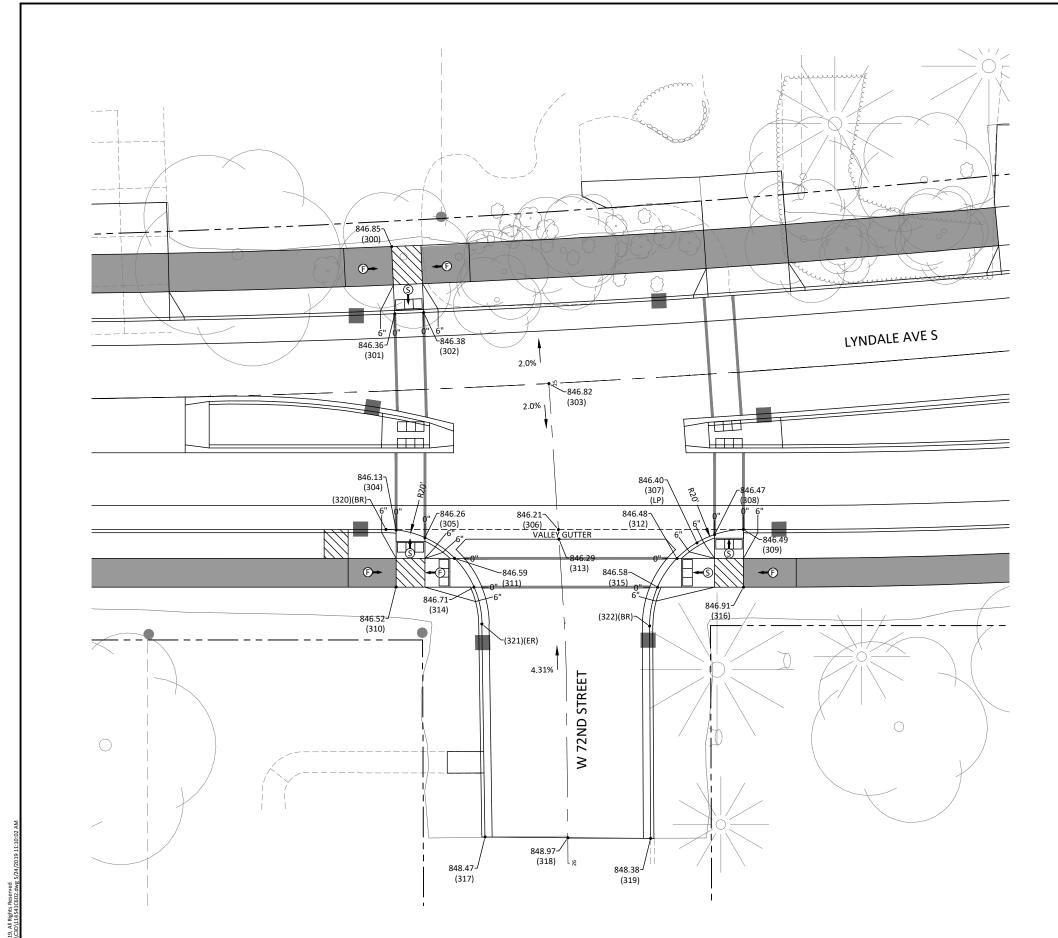

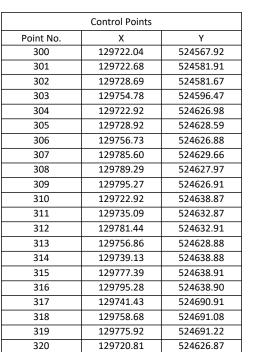

129740.80

129775.72

321

322





__XXX

524646.58

524646.99

CONTROL POINTS AT GUTTER FLOW LINE & TOP OF CONCRETE

TRUNCATED DOMES (SEE STANDARD PLATE 7038) CONSTRUCT CONCRETE CURB & GUTTER

LANDING AREA - 4' X 4' MIN DIMENSIONS AND MAX 2.0% SLOPE IN ALL DIRECTIONS

PEDESTRIAN ACCESS ROUTE

INDICATES PEDESTRIAN RAMP - SLOPE SHALL BE BETWEEN 5.0% MINIMUM AND 8.3% MAXIMUM IN THE DIRECTION SHOWN AND CROSS SLOPE

SHALL NOT EXCEED 2.0%

INDICATES PEDESTRIAN RAMP - SLOPE SHALL BE GREATER THAN 2.0% AND LESS THAN 5.0% IN THE DIRECTION SHOWN AND CROSS SLOPE SHALL NOT EXCEED 2.0%

DRAINAGE FLOW ARROW



12224 NICOLLET AVENUE BURNSVILLE, MINNESOTA 55337 Phone: (952) 890-0509 Email: Burnsville@bolton-menk.com www.bolton-menk.com




DESIGNED	NO.	REVISION	DATE	
ZAP				
DRAWN				
KME	_			
KIVIE				
CHECKED	\vdash			_
T1				
I L	-			1
CLIENT PROJ. NO.	1			

1. BR = BEGIN RADIUS

ER = END RADIUS HP = HIGH POINT

LP = LOW POINT

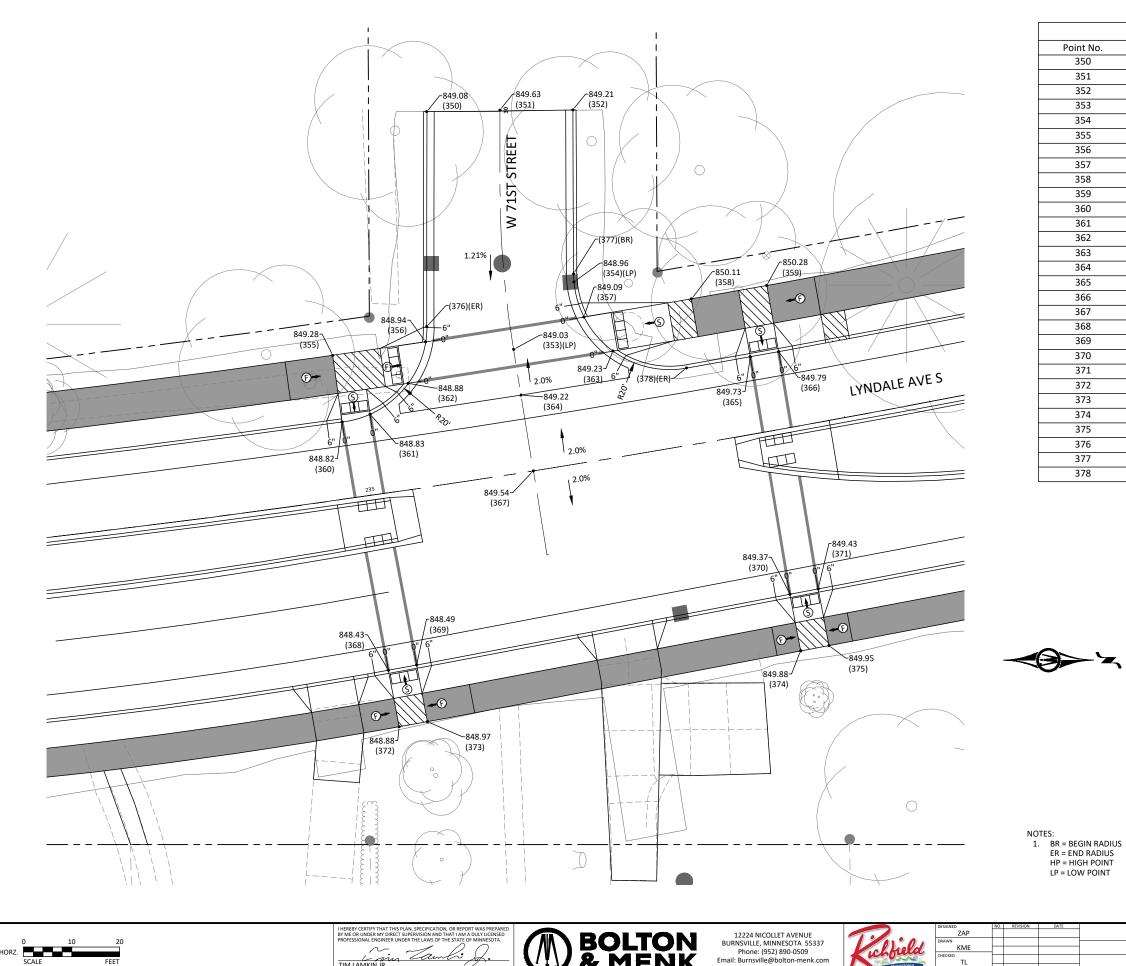

	Control Points	
Point No.	Х	Y
350	129994.33	524494.70
351	130009.92	524494.01
352	130025.13	524494.00
353	130012.75	524543.85
354	130025.33	524529.84
355	129975.06	524545.10
356	129994.39	524542.28
357	130027.40	524537.10
358	130049.78	524533.36
359	130065.49	524530.57
360	129977.02	524558.95
361	129982.83	524557.34
362	129990.79	524550.90
363	130033.44	524544.22
364	130014.30	524553.39
365	130062.07	524545.40
366	130067.96	524544.36
367	130016.85	524569.18
368	129986.63	524610.69
369	129992.54	524609.62
370	130070.28	524594.91
371	130076.18	524593.80
372	129988.87	524622.48
373	129994.77	524621.41
374	130072.52	524606.70
375	130078.41	524605.59
376	129994.65	524539.11
377	130025.25	524528.15
378	130048.75	524547.77



LP = LOW POINT

INDICATES PEDESTRIAN RAMP - SLOPE SHALL BE BETWEEN 5.0% MINIMUM AND 8.3% MAXIMUM IN THE DIRECTION SHOWN AND CROSS SLOPE

LEGEND

TRUNCATED DOMES (SEE STANDARD PLATE 7038)

CONSTRUCT CONCRETE CURB & GUTTER LANDING AREA - 4' X 4' MIN DIMENSIONS AND MAX 2.0% SLOPE IN ALL DIRECTIONS

CONTROL POINTS AT GUTTER FLOW LINE & TOP OF CONCRETE

INDICATES PEDESTRIAN RAMP - SLOPE SHALL BE GREATER THAN 2.0% AND LESS THAN 5.0% IN THE DIRECTION SHOWN AND CROSS SLOPE SHALL NOT EXCEED 2.0%

SHALL NOT EXCEED 2.0%

DRAINAGE FLOW ARROW

PEDESTRIAN ACCESS ROUTE








www.bolton-menk.com

DESIGNED	NO.	REVISION	DATE	i
ZAP				
DRAWN				ſ
KME				
CHECKED				i
TL				ı
CLIENT PROJ. NO.				i



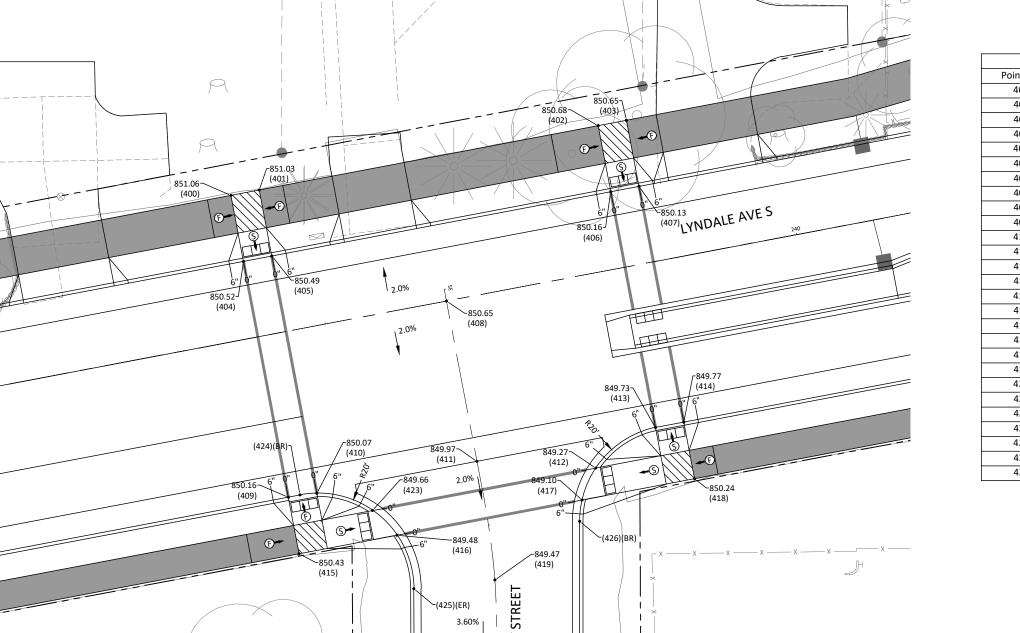

71ST

≥

-847.93

(422)

~847.98

848.61~ (421)

(420)

Control Points						
Point No.	Х	Υ				
400	130356.84	524475.55				
401	130362.73	524474.44				
402	130433.34	524461.07				
403	130439.24	524459.96				
404	130359.44	524489.31				
405	130365.33	524488.19				
406	130435.94	524474.83				
407	130441.84	524473.71				
408	130401.73	524497.59				
409	130368.74	524538.44				
410	130374.69	524537.64				
411	130408.05	524531.00				
412	130432.81	524532.42				
413	130445.24	524523.96				
414	130451.14	524522.84				
415	130370.97	524550.23				
416	130391.39	524546.36				
417	130429.94	524539.06				
418	130453.37	524534.63				
419	130411.76	524555.70				
420	130394.98	524579.28				
421	130412.21	524579.50				
422	130429.44	524579.42				
423	130386.30	524541.22				
424	130371.17	524537.98				
425	130394.87	524557.54				
426	130429.44	524543.52				
· · · · · · · · · · · · · · · · · · ·						

CONSTRUCT CONCRETE CURB & GUTTER

CONTROL POINTS AT GUTTER FLOW LINE & TOP OF CONCRETE

TRUNCATED DOMES (SEE STANDARD PLATE 7038)

LEGEND

LANDING AREA - 4' X 4' MIN DIMENSIONS AND MAX 2.0% SLOPE IN ALL DIRECTIONS

PEDESTRIAN ACCESS ROUTE

INDICATES PEDESTRIAN RAMP - SLOPE SHALL BE BETWEEN 5.0% MINIMUM AND 8.3% MAXIMUM IN THE DIRECTION SHOWN AND CROSS SLOPE

SHALL NOT EXCEED 2.0%

INDICATES PEDESTRIAN RAMP - SLOPE SHALL BE GREATER THAN 2.0% AND LESS THAN 5.0% IN THE DIRECTION SHOWN AND CROSS SLOPE SHALL NOT EXCEED 2.0%

DRAINAGE FLOW ARROW


1. BR = BEGIN RADIUS ER = END RADIUS HP = HIGH POINT LP = LOW POINT

I HEREBY CERTIFY THAT THIS PLAN, SPECIFICATION, OR REPORT WAS PREPARED
BY ME OR UNDER MY DIRECT SUPERVISION AND THAT I AM A DULY LICENSED
PROFESSIONAL ENGINEER UNDER THE LAWS OF THE STATE OF MINNESOTA.
~ ~ 0.0
Low clinto st.
TIM LAMKIN JR.
UC NO 47099 DATE 2/19/19





DESIGNED	NO.	REVISION	DATE	
ZAP				
DRAWN				_
KME				1
CHECKED	\vdash			
TL				
CLIENT PROJ. NO.	\vdash			

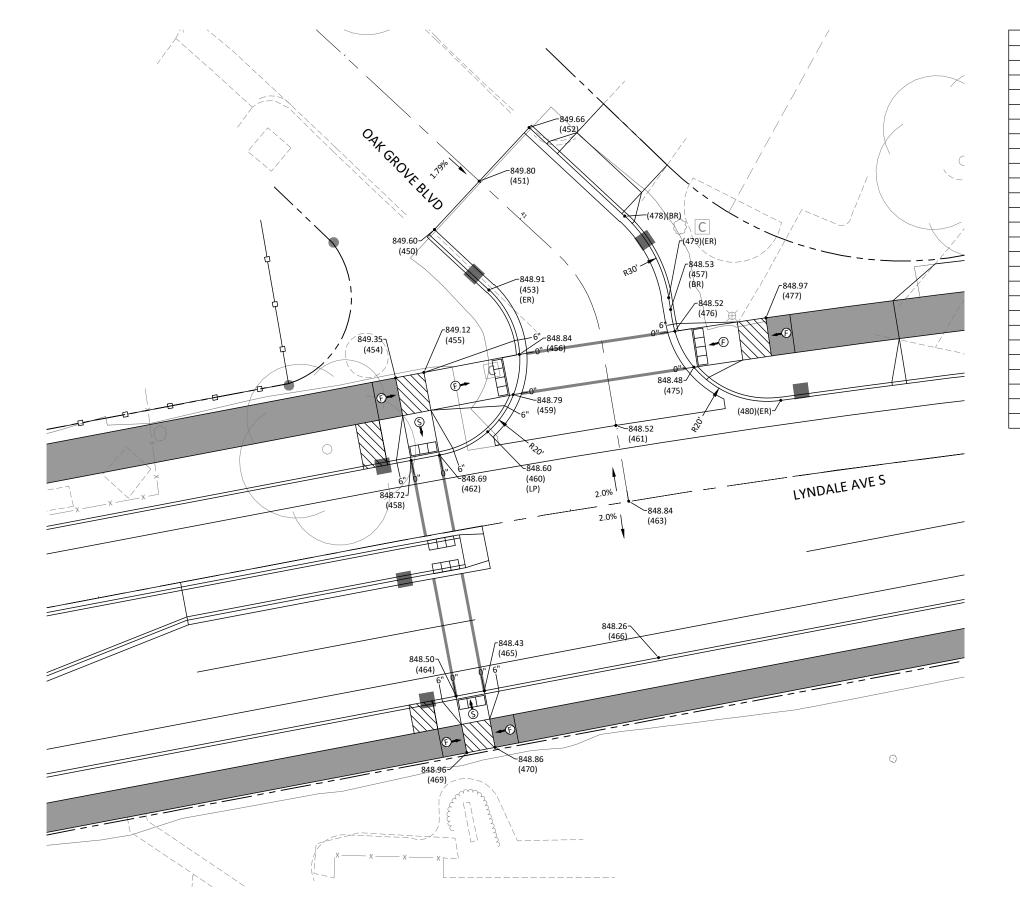

Control Points					
Point No.	Х	Υ			
450	130741.20	524369.90			
451	130750.56	524359.83			
452	130760.95	524348.64			
453	130752.55	524382.48			
454	130733.10	524400.79			
455	130738.98	524399.67			
456	130758.90	524395.90			
457	130790.41	524386.59			
458	130736.35	524417.98			
459	130757.61	524404.29			
460	130752.30	524412.02			
461	130778.99	524410.72			
462	130742.24	524416.87			
463	130781.65	524426.50			
464	130745.67	524467.10			
465	130751.57	524465.98			
466	130787.85	524459.08			
469	130747.89	524478.89			
470	130753.80	524477.76			
475	130795.23	524392.59			
476	130791.28	524391.09			
477	130810.26	524388.31			
478	130780.84	524367.14			
479	130789.99	524384.13			
480	130813.34	524405.53			



LEGEND

CONTROL POINTS AT GUTTER FLOW LINE & TOP OF CONCRETE

TRUNCATED DOMES (SEE STANDARD PLATE 7038) CONSTRUCT CONCRETE CURB & GUTTER

LANDING AREA - 4' X 4' MIN DIMENSIONS AND MAX 2.0% SLOPE IN ALL DIRECTIONS


PEDESTRIAN ACCESS ROUTE

INDICATES PEDESTRIAN RAMP - SLOPE SHALL BE BETWEEN 5.0% MINIMUM AND 8.3% MAXIMUM IN THE DIRECTION SHOWN AND CROSS SLOPE SHALL NOT EXCEED 2.0%

INDICATES PEDESTRIAN RAMP - SLOPE SHALL BE GREATER THAN 2.0% AND LESS THAN 5.0% IN THE DIRECTION SHOWN AND CROSS SLOPE

1. BR = BEGIN RADIUS ER = END RADIUS HP = HIGH POINT LP = LOW POINT

SHALL NOT EXCEED 2.0% DRAINAGE FLOW ARROW

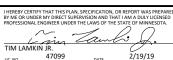





12224 NICOLLET AVENUE BURNSVILLE, MINNESOTA 55337 Phone: (952) 890-0509 Email: Burnsville@bolton-menk.com www.bolton-menk.com



ESIGNED	NO.	REVISION	DATE	
ZAP				
RAWN				
KME	$\overline{}$			
HECKED	-			
TI				
I L				
LIENT PROJ. NO.				

CITY OF RICHFIELD, MINNESOTA S.A.P. 157-363-032, LYNDALE AVENUE RECONSTRUCTION INTERSECTION **DETAILS**

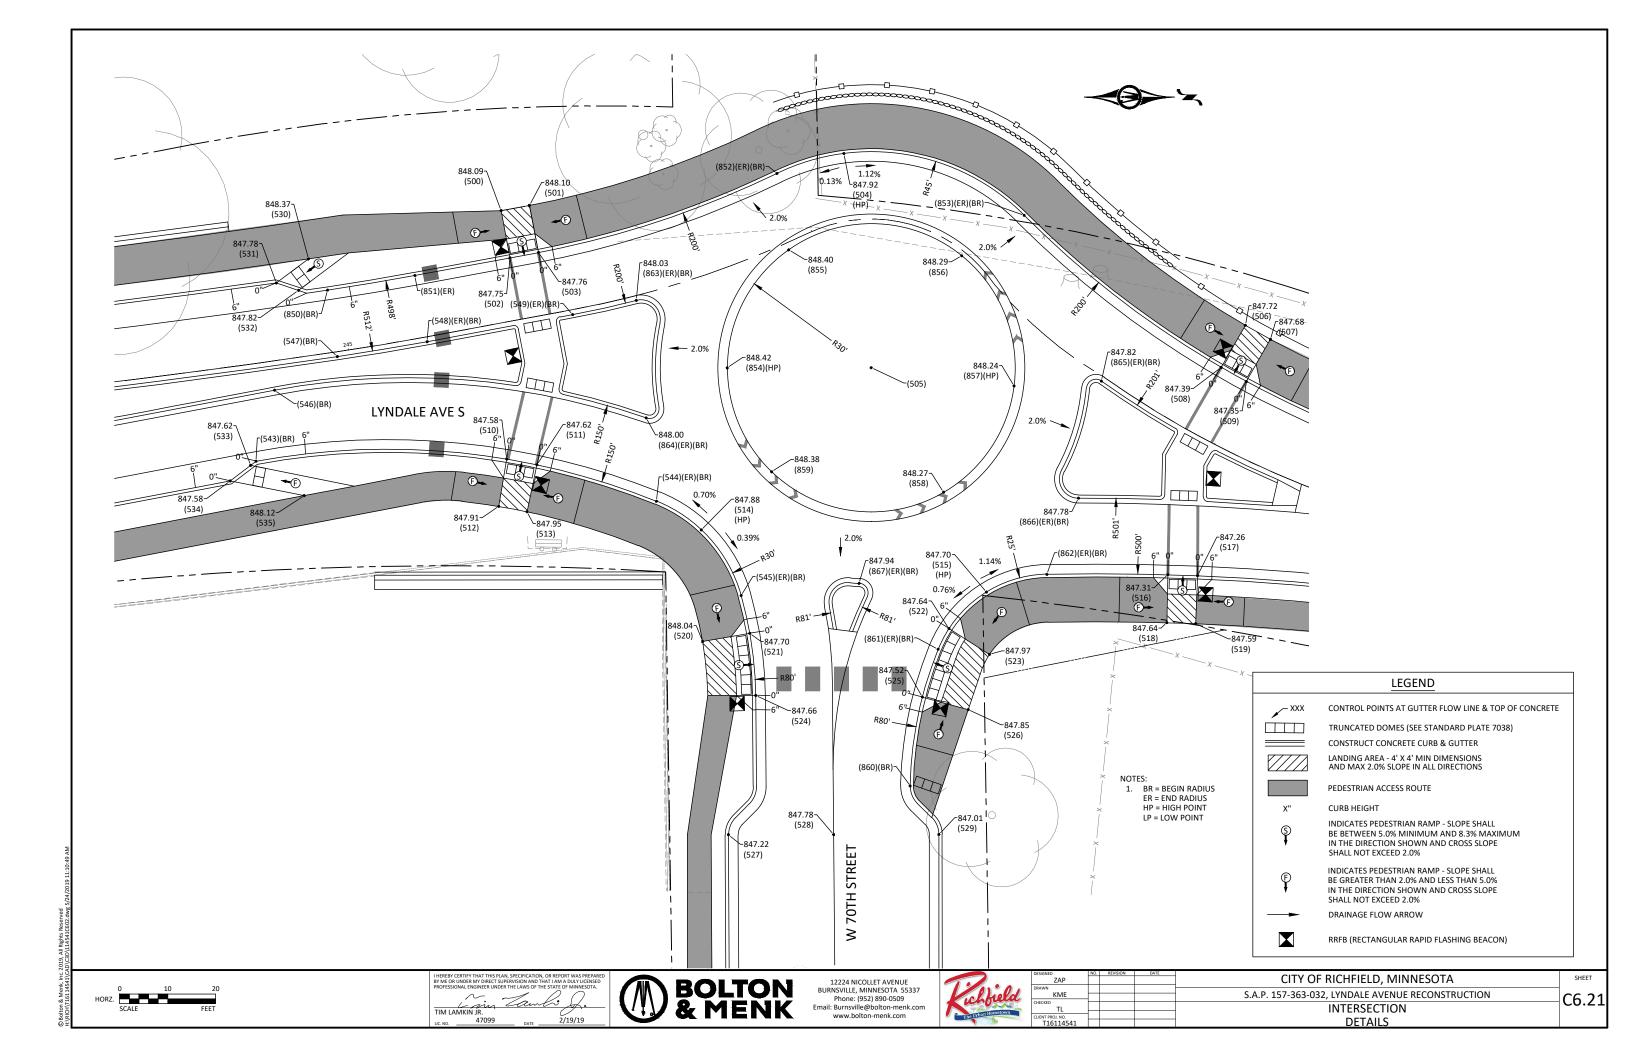

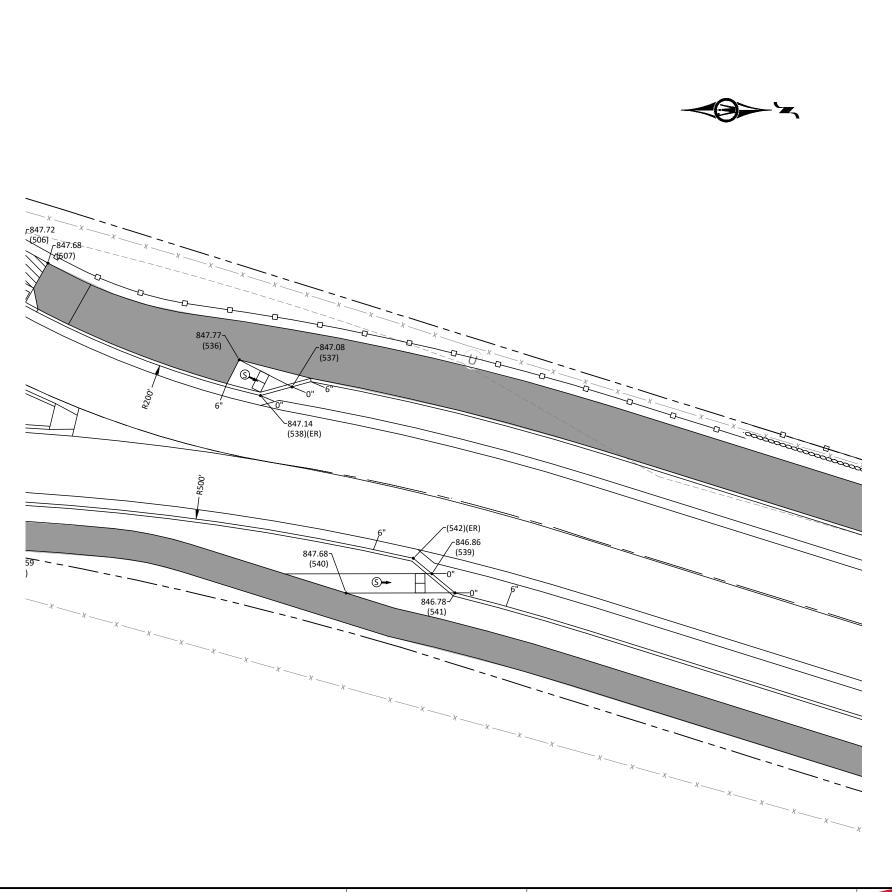

	Control Points	
Point No.	Х	Υ
500	130999.65	524373.28
501	131005.55	524372.19
502	131001.47	524383.11
503	131007.42	524381.99
504	131071.07	524361.41
505	131076.73	524406.03
506	131154.67	524397.23
507	131159.90	524400.16
508	131149.65	524405.98
509	131154.88	524408.93
510	131000.77	524425.02
511	131007.09	524426.22
512	130999.12	524434.90
513	131005.01	524436.00
514	131041.31	524439.81
515	131100.72	524452.81
516	131138.51	524449.18
517	131144.70	524449.42
518	131138.29	524459.18
519	131144.28	524459.39
520	131041.58	524463.08
521	131051.43	524461.38
522	131092.92	524460.39
523	131101.33	524465.80
524	131052.64	524474.32
525	131032.04	524474.67
526	131097.33	524477.29
527	131090.92	524503.37
528	131040.93	524503.34
529		
	131090.79	524503.29
530	130959.50	524383.32
531	130952.80	524388.33
532	130957.42	524389.86
533	130947.43	524426.32
534	130943.18	524429.55
535	130958.57	524432.64
536	131199.74	524420.33
537	131210.74	524425.96
538	131204.16	524427.77
539	131239.85	524464.91
540	131221.98	524468.91
541	131244.65	524468.91
542	131235.97	524461.68
543	130948.56	524425.47
544	131031.97	524433.83
545	131049.62	524453.49
546	130952.44	524410.68
547	130965.51	524403.66
548	130984.22	524400.55
549	131014.53	524394.93

	LEGEND
(XX	CONTROL POINTS AT GUTTER

JTTER FLOW LINE & TOP OF CONCRETE

Control Points

Χ 130963.47

130981.67

131057.11

131108.62

131046.73

131059.54

131095.60

131106.49

131091.79

131055.97

131084.81

131090.65

131113.28

131027.80

131029.85

131124.68

131119.90

131074.19

524389.81

524386.79

524365.55

524374.30

524406.05 524381.46

524382.73

524409.84

524431.99

524427.70 524493.18

524464.71

524449.11

524392.00

524416.47

524408.85

524433.24

524450.98

Point No.

850 851

852

853

854

855

856

857

858

859

860

861 862

863

864

865 866

867

TRUNCATED DOMES (SEE STANDARD PLATE 7038) CONSTRUCT CONCRETE CURB & GUTTER

> LANDING AREA - 4' X 4' MIN DIMENSIONS AND MAX 2.0% SLOPE IN ALL DIRECTIONS

> > PEDESTRIAN ACCESS ROUTE

CURB HEIGHT

INDICATES PEDESTRIAN RAMP - SLOPE SHALL BE BETWEEN 5.0% MINIMUM AND 8.3% MAXIMUM IN THE DIRECTION SHOWN AND CROSS SLOPE SHALL NOT EXCEED 2.0%

INDICATES PEDESTRIAN RAMP - SLOPE SHALL BE GREATER THAN 2.0% AND LESS THAN 5.0% IN THE DIRECTION SHOWN AND CROSS SLOPE

DRAINAGE FLOW ARROW



12224 NICOLLET AVENUE BURNSVILLE, MINNESOTA 55337 Phone: (952) 890-0509 Email: Burnsville@bolton-menk.com www.bolton-menk.com



ESIGNED	NO.	REVISION	DATE	
ZAP				
RAWN				
KME				
HECKED				
TL				
JENT PROJ. NO.				


NOTES: 1. BR = BEGIN RADIUS

ER = END RADIUS HP = HIGH POINT LP = LOW POINT

CITY OF RICHFIELD, MINNESOTA
S.A.P. 157-363-032, LYNDALE AVENUE RECONSTRUCTION
INTERSECTION
DETAILS

SHEET C6.22



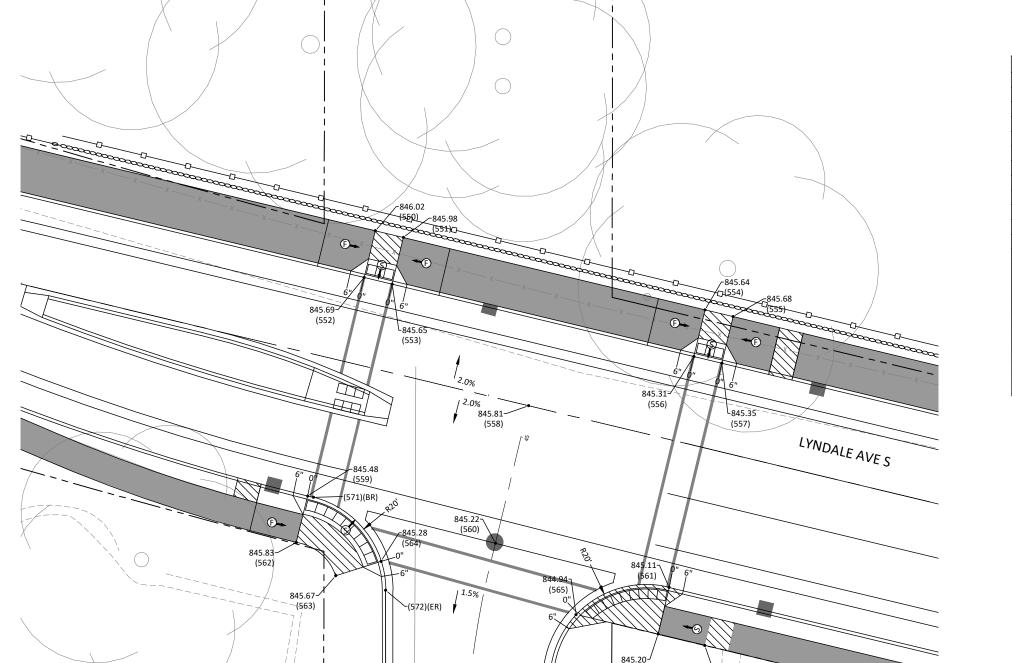

Control Points				
Point No.	Х	Y		
550	131700.68	524553.11		
551	131706.51	524554.51		
552	131698.34	524562.84		
553	131704.18	524564.24		
554	131769.36	524569.61		
555	131775.20	524571.61		
556	131767.03	524579.33		
557	131772.86	524580.74		
558	131732.59	524589.57		
559	131686.55	524608.37		
560	131735.67	524618.21		
561	131761.83	524627.42		
562	131684.17	524618.04		
563	131692.37	524624.98		
564	131701.84	524621.98		
565	131742.45	524633.11		
566	131769.27	524639.48		
567	131759.55	524637.19		
568	131702.80	524680.86		
569	131719.89	524680.85		
570	131736.99	524680.84		



XXX

CONTROL POINTS AT GUTTER FLOW LINE & TOP OF CONCRETE

C6.23

TRUNCATED DOMES (SEE STANDARD PLATE 7038) CONSTRUCT CONCRETE CURB & GUTTER

LANDING AREA - 4' X 4' MIN DIMENSIONS AND MAX 2.0% SLOPE IN ALL DIRECTIONS

LEGEND


PEDESTRIAN ACCESS ROUTE

INDICATES PEDESTRIAN RAMP - SLOPE SHALL BE BETWEEN 5.0% MINIMUM AND 8.3% MAXIMUM IN THE DIRECTION SHOWN AND CROSS SLOPE SHALL NOT EXCEED 2.0%

INDICATES PEDESTRIAN RAMP - SLOPE SHALL BE GREATER THAN 2.0% AND LESS THAN 5.0% IN THE DIRECTION SHOWN AND CROSS SLOPE SHALL NOT EXCEED 2.0%

DRAINAGE FLOW ARROW

1. BR = BEGIN RADIUS ER = END RADIUS HP = HIGH POINT LP = LOW POINT

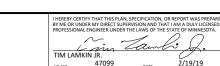

844.15~

(568)

69TH STREET

≥

 (\Box)

-844.57

(569)



~844.31


~(573)(BR)

(567)

[\]845.75



DESIGNED	NO.	REVISION	DATE	
ZAP				
DRAWN				
KME				l .
KIVIE				
CHECKED	-			
TI				
I L				i .
CLIENT PROJ. NO.				
				1

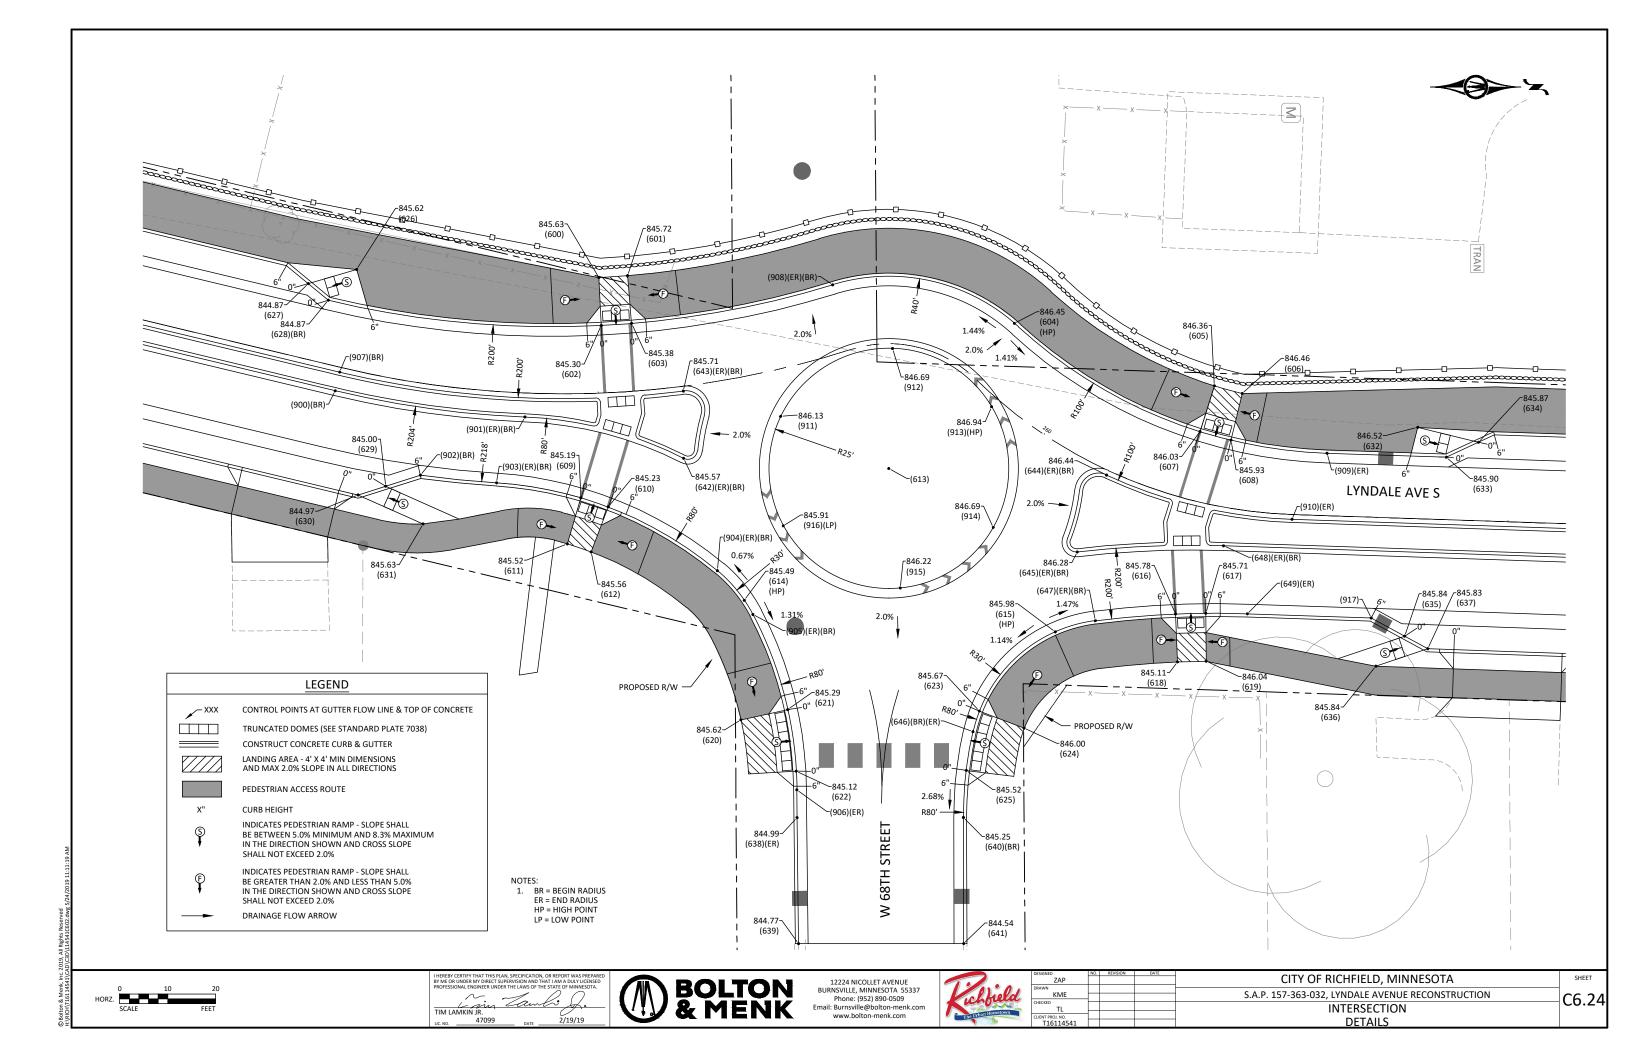

Control Points						
Point No.	Х	Υ				
600	132307.49	524701.20				
601	132313.46	524700.78				
602	132307.99	524711.18				
603	132314.29	524710.75				
604	132394.04	524710.77				
605	132435.71	524723.82				
606	132441.50	524725.42				
607	132432.71	524733.36				
608	132439.15	524735.15				
609	132303.72	524747.09				
610	132309.41	524748.99				
611	132300.88	524756.68				
612	132305.86	524758.35				
613	132367.85	524741.00				
614	132337.76	524741.00				
615	132402.53	524775.07				
	132402.53	524773.07				
616						
617	132433.89	524771.21				
618	132433.98	524781.36				
619	132433.98	524781.20				
620	132337.01	524793.37				
621	132346.78	524791.25				
622	132348.55	524804.07				
623	132386.70	524791.56				
624	132396.03	524795.12				
625	132383.97	524803.94				
626	132257.02	524699.49				
627	132246.92	524702.41				
628	132251.09	524705.90				
629	132263.03	524722.66				
630	132257.30	524746.47				
631	132270.82	524752.52				
632	132478.05	524732.49				
633	132484.03	524738.72				
634	132490.71	524735.61				
635	132475.33	524776.00				
636	132469.32	524782.24				
637	132480.12	524778.61				
638	132348.72	524813.74				
639	132349.02	524840.01				
640	132383.38	524813.75				
641	132383.42	524840.01				
642	132325.12	524738.87				
643	132325.07	524724.86				
644	132413.24	524742.41				
645	132407.14	524758.43				
646	132385.38	524795.86				
647	132410.91	524772.75				
648	132437.59	524757.15				
649	132442.55	524771.32				


Control Points				
Point No.	Х	Υ		
900	132252.54	524724.77		
901	132292.06	524730.25		
902	132270.31	524742.35		
903	132286.14	524743.96		
904	132332.16	524762.30		
905	132339.54	524771.43		
906	132348.68	524807.97		
907	132253.48	524720.88		
908	132356.18	524702.74		
909	132459.17	524737.87		
910	132451.88	524751.63		
911	132345.33	524730.14		
912	132368.66	524716.01		
913	132389.29	524728.14		
914	132389.62	524753.29		
915	132370.23	524765.89		
916	132345.88	524752.93		
917	132468.33	524772.21		






7	
ch	field
Urban	Hometown



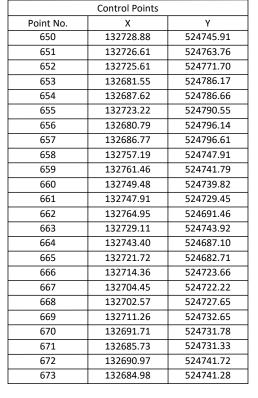

Point No.	X	Y
650	132728.88	524745.91
651	132726.61	524763.76
652	132725.61	524771.70
653	132681.55	524786.17
654	132687.62	524786.66
655	132723.22	524790.55
656	132680.79	524796.14
657	132686.77	524796.61
658	132757.19	524747.91
659	132761.46	524741.79
660	132749.48	524739.82
661	132747.91	524729.45
662	132764.95	524691.46
663	132729.11	524743.92
664	132743.40	524687.10
665	132721.72	524682.71
666	132714.36	524723.66
667	132704.45	524722.22
668	132702.57	524727.65
669	132711.26	524732.65
670	132691.71	524731.78
671	132685.73	524731.33
672	132690.97	524741.72
673	132684.98	524741.28

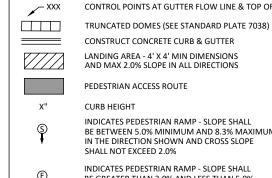

1. BR = BEGIN RADIUS ER = END RADIUS HP = HIGH POINT


LP = LOW POINT

INDICATES PEDESTRIAN RAMP - SLOPE SHALL BE BETWEEN 5.0% MINIMUM AND 8.3% MAXIMUM IN THE DIRECTION SHOWN AND CROSS SLOPE SHALL NOT EXCEED 2.0% INDICATES PEDESTRIAN RAMP - SLOPE SHALL BE GREATER THAN 2.0% AND LESS THAN 5.0% IN THE DIRECTION SHOWN AND CROSS SLOPE SHALL NOT EXCEED 2.0% DRAINAGE FLOW ARROW

RRFB (RECTANGULAR RAPID FLASHING BEACON)

LEGEND

CONTROL POINTS AT GUTTER FLOW LINE & TOP OF CONCRETE

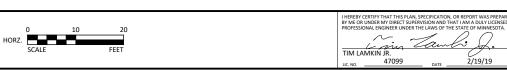



849.51~

--848.41

2.0%

1 2.0%

848.75~

(667) 848.70~

> r848.45 (670)

(672)

-847.95

(654)

(657)

~(674)(BR) ₹

(668)

848.06

(673)

847.87

(653)

848.20~ (656)

(664)

LAKESHORE DR S

848.82~

-848.61 (663)

848.53

(650)

/-848.89 (651)

~848.96

(652)

-848.50

(655)

~849.63

.+555558889:

LYNDALE AVE S

(662)

L_{849.16}


~(677)(ER)


12224 NICOLLET AVENUE BURNSVILLE, MINNESOTA 55337 Phone: (952) 890-0509 Email: Burnsville@bolton-menk.com www.bolton-menk.com




ESIGNED	NO.	REVISION	DATE	
ZAP				
RAWN				
KME				
HECKED				
IL				
LIENT PROJ. NO.	_			
T16114541				1


CITY OF RICHFIELD, MINNESOTA S.A.P. 157-363-032, LYNDALE AVENUE RECONSTRUCTION INTERSECTION **DETAILS**

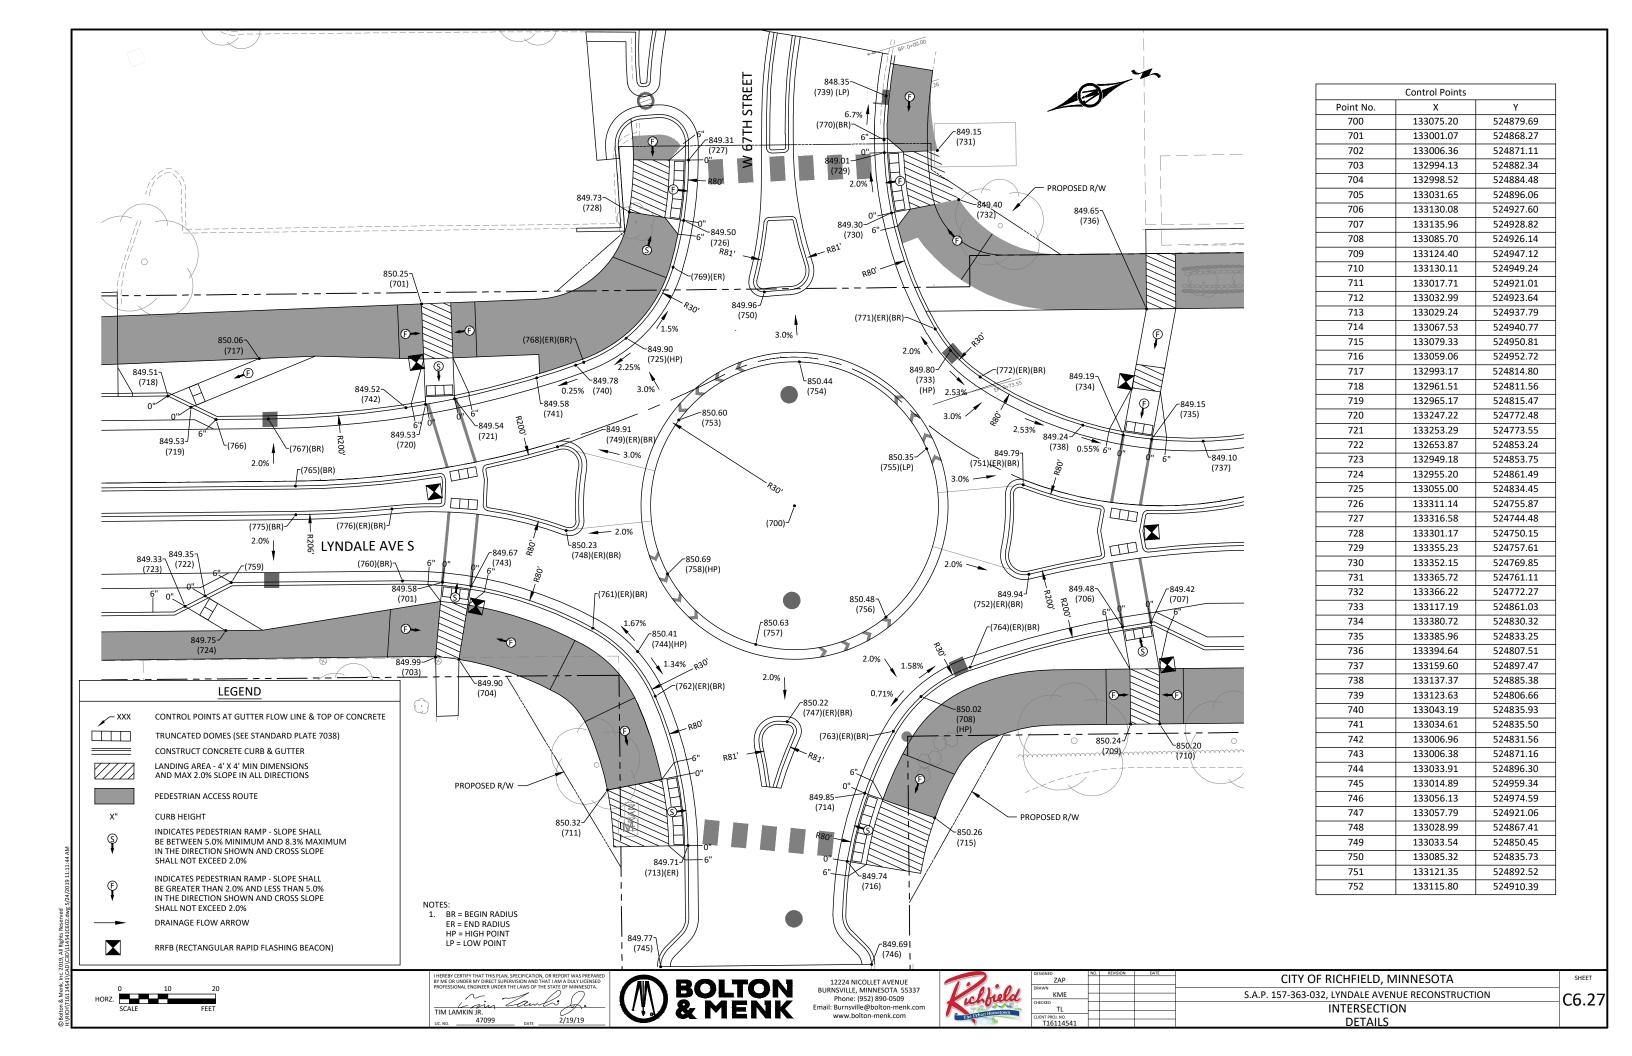

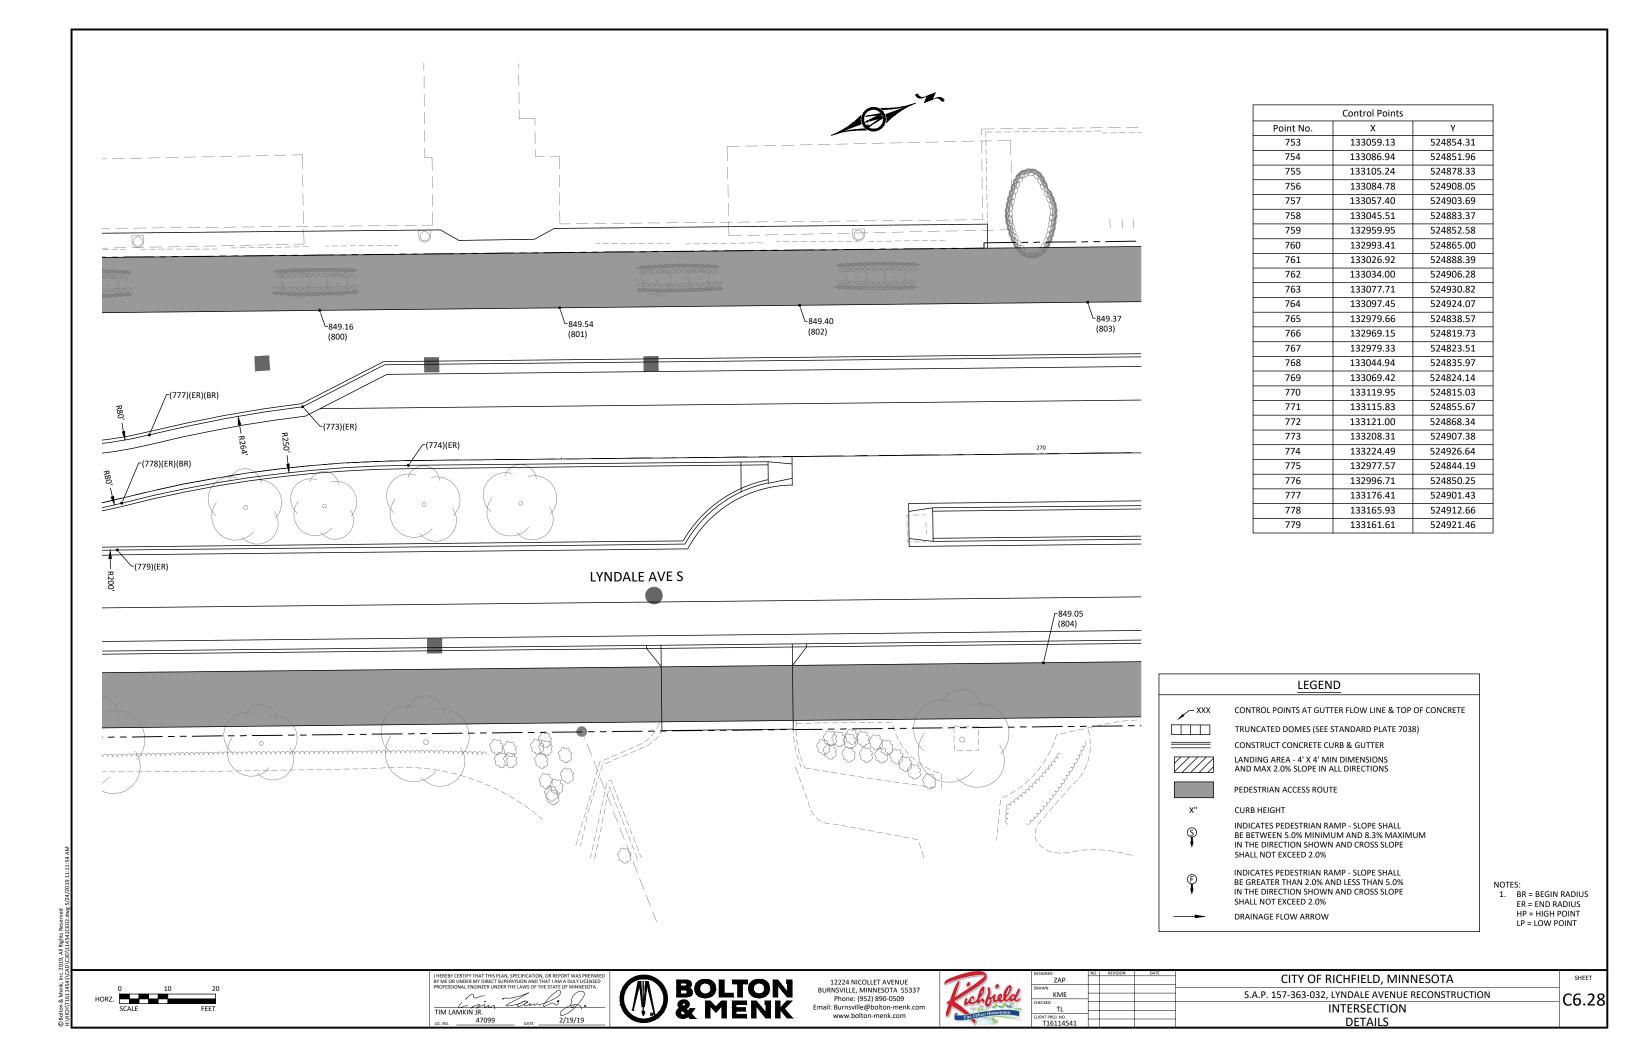

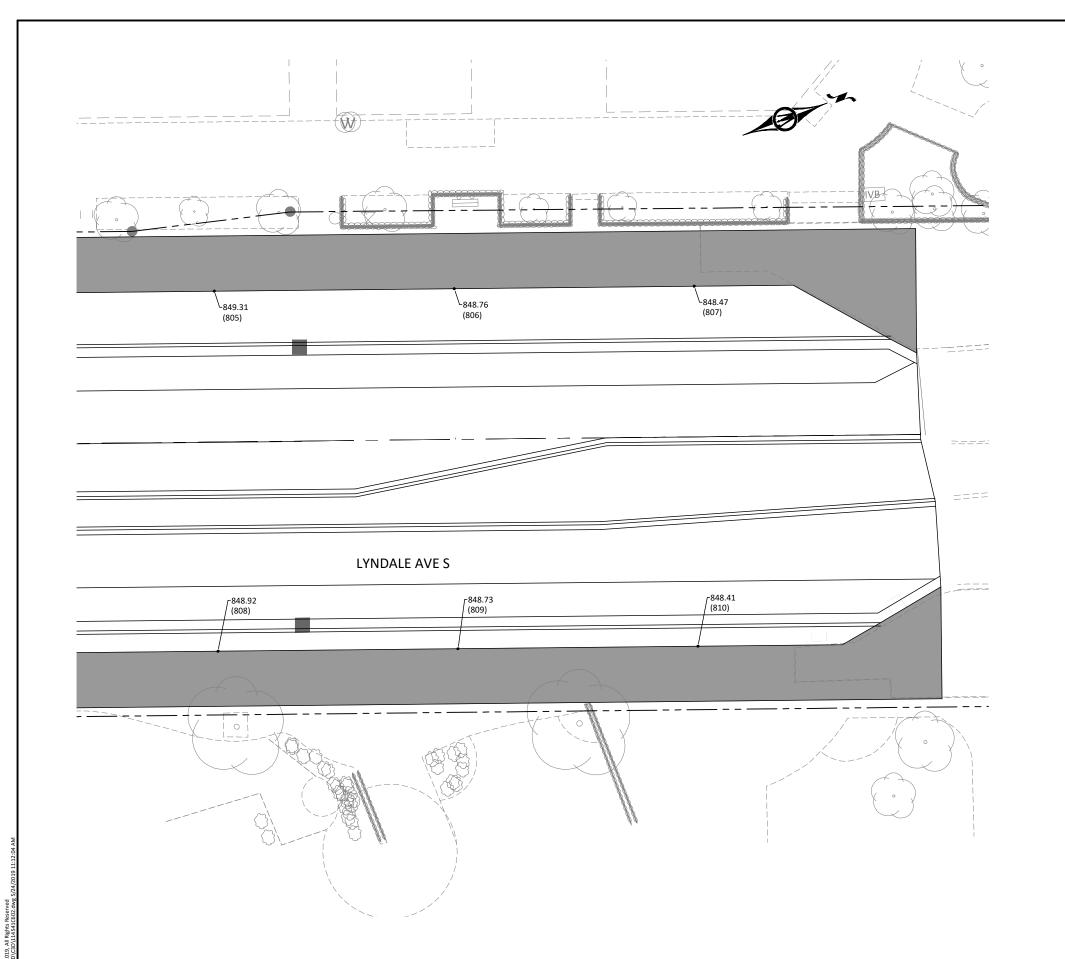

Control Points				
Point No.	Х	Y		
800	133218.82	524889.88		
801	133265.70	524907.26		
802	133312.58	524924.64		
803	133368.84	524945.50		
804	133333.39	525012.35		
805	133406.34	524959.41		
806	133453.22	524976.79		
807	133500.10	524994.17		
808	133380.27	525029.73		
809	133427.15	525047.11		
810	133474.03	525064.50		

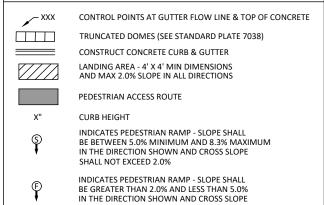

SHALL NOT EXCEED 2.0% DRAINAGE FLOW ARROW

LEGEND







12224 NICOLLET AVENUE BURNSVILLE, MINNESOTA 55337 Phone: (952) 890-0509 Email: Burnsville@bolton-menk.com www.bolton-menk.com



ZAP			
DRAWN			\vdash
KME			1
CHECKED	-		-
TL	-		
CLIENT PROJ. NO.			
TACAAAFAA			1

NOTES:

1. BR = BEGIN RADIUS
ER = END RADIUS
HP = HIGH POINT
LP = LOW POINT

CITY OF RICHFIELD, MINNESOTA S.A.P. 157-363-032, LYNDALE AVENUE RECONSTRUCTION INTERSECTION **DETAILS**

THE FOLLOWING STANDARD PLATES, APPROVED BY THE FEDERAL HIGHWAY ADMINISTRATION, SHALL APPLY ON THIS PROJECT.

	STANDARD PLATES					
	PLATE NO.	PLATE DESCRIPTION				
	8110E	TRAFFIC SIGNAL BRACKETING (POLE MOUNTED)				
	8111E	TRAFFIC SIGNAL BRACKETING (PEDESTAL MOUNTED),				
	OILLE	(3 SHEETS)				
(1)	(1) 8122F	PEDESTAL & PEDESTAL BASE				
(1)	01225	(FOR TRAFFIC CONTROL SIGNALS SUPPORT), (2 SHEETS)				
(2)	8123G	POLE AND MAST ARM, (2 SHEETS)				

(1) SEE SPECIAL PROVISIONS.

(2) SIGNAL MOUNTING PLATE (END OF MAST ARM) APPLIES.

	TABULATION OF ESTIMATED QUANTITIES							
NOTES	ITEM DESCRIPTION	UNIT	TOTAL					
(3)	REMOVE SIGNAL SYSTEM "A"	EACH	1					
(3)	REMOVE SIGNAL SYSTEM "B"	EACH	1					
	TRAFFIC CONTROL SIGNAL SYSTEM "A"	SIG SYS	1					
	TRAFFIC CONTROL SIGNAL SYSTEM "B"	SIG SYS	1					

(3) SEE SPECIAL PROVISIONS.

PEDESTRIAN CROSSWALK FLASHER F & G LYNDALE AVE. AT W. 67TH ST.

PEDESTRIAN CROSSWALK FLASHER B, C & D LYNDALE AVE. AT W. 70TH ST.

TRAFFIC SIGNAL SYSTEM B **EMERGENCY VEHICLE PREEMPTION SYSTEM** LYNDALE AVE. AT W. 73RD ST.

TRAFFIC SIGNAL SYSTEM A EMERGENCY VEHICLE PREEMPTION SYSTEM LYNDALE AVE. AT W. 76TH ST.

COLOR CODING OF CONDUCTORS

RFD ORANGE BL BLUE WHITE WH R/BLK RED WITH BLACK TRACER

O/BLK ORANGE WITH BLACK TRACER BL/BLK BLUE WITH BLACK TRACER WH/BLK WHITE WITH BLACK TRACER

BLACK BLK BLK/WH

W 66TH ST

W 69TH ST

W 71TH ST

W 73TH ST

W 76TH ST

[⊒]E W 70TH ST

W 68TH ST 븖븖

W 67TH ST

BLACK WITH WHITE TRACER BLK/R BLACK WITH RED TRACER WH/R WHITE WITH RED TRACER G/BLK GREEN WITH BLACK TRACER

GARFIELD AVE S

--HARRIET AVE

☐

G GREEN YELLOW

ABBREVIATIONS WIRING DIAGRAM LEGEND

DENOTES TAP OF CABLED CONDUCTOR OR PARALLELING OF CABLED

CONDUCTORS WITH TAPS AS INDICATED BY THE WIRING DIAGRAM

PHASE

SIGNAL PHASE AND FACE NUMBER 2-1

RED RED YEL YELLOW

GREEN GRN RLTA **RED LEFT TURN ARROW** YLTA YELLOW LEFT TURN ARROW

FLASHING YELLOW LEFT TURN ARROW FYLTA

GLTA GREEN LEFT TURN ARROW RRTA RED RIGHT TURN ARROW YRTA YELLOW RIGHT TURN ARROW

FYRTA FLASHING YELLOW RIGHT TURN ARROW

GRTA GREEN RIGHT TURN ARROW

DON'T WALK DW W WALK

NEU NEUTRAL

SPARE SPARE CONDUCTOR

EQG **EQUIPMENT GROUND** 0 **EQUIPMENT GROUND CONNECTION**

PB PUSH BUTTON

IND INDICATOR

EVP **EMERGENCY VEHICLE PREEMPTION** PEDESTRIAN INDICATION PED OR P

APS ACCESSIBLE PEDESTRIAN SIGNAL

LUM LUMINAIRE

CONTROLLER AND CABINET CAC

SC SERVICE CABINET SOP SOURCE OF POWER HANDHOLE НН

MA MAST ARM SA SIGNAL ASSEMBLY PEDESTAL MOUNT

PEDESTRIAN FLASHER ASSEMBLY PFA

PEDESTAL MOUNT FYEL FLASHING YELLOW

RRFB RECTANGULAR RAPID FLASHING BEACON

DETECTOR ZONE (_ DENOTES PHASE) TMC TRAFFIC MANAGEMENT CAMERA

NEUTRAL CONDUCTOR INPLACE STRUCTURE

INPLACE CONDUCTOR OR CONDUIT ACCESSIBLE PEDESTRIAN SIGNAL

APS SM SINGLE MODE FIBER OPTIC CABLE MM MULTI MODE FIBER OPTIC CABLE

SIGNAL PLAN LAYOUT LEGEND

PULL VAULT



CONTROLLER CABINET AND BATTERY BACK-UP READY SERVICE CABINET WITH METER AND DISCONNECT ON ONE CONCRETE PAD



POLE MOUNTED



PVC HANDHOLE WITH METAL COVER



MAST ARM SIGNAL POLE WITH OPTIONAL LUMINAIRE SHAFT EXTENSION AS NOTED



APS PUSH BUTTON STATION



| | | | >

VIDEO DETECTION CAMERA AND TRAFFIC MANAGEMENT CAMERA

LUMINAIRE

EMERGENCY VEHICLE PREEMPTION (EVP) ONE-WAY

SIGNAL FACE WITH BACKGROUND SHIELD



PEDESTRIAN INDICATION



SIGNAL PHASE AND FACE NUMBER



VIDEO DETECTION ZONE RIGID STEEL CONDUIT (RSC)



RECTANGULAR RAPID FLASH BEACON



INPLACE HANDHOLE




INPLACE CONDUIT



INPLACE CONTROLLER AND CABINET



INPLACE SOURCE OF POWER PAD MOUNTED POLE MOUNTED

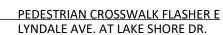

PEDESTRIAN CROSSWALK FLASHER A LYNDALE AVE. AT W. 75TH ST.

43354

I 494

GOOM

LAKE

OAK GROVE BLVD



12224 NICOLLET AVENUE BURNSVILLE, MINNESOTA 55337 Phone: (952) 890-0509 www.bolton-menk.com





	DESIGNED
	2
0	DRAWN
o Vol.	K
	CHECKED
etown	l E
	CLIENT PROJ
	T161

DESIGNED	NO.	REVISION	DATE	ĺ
ZAP				
DRAWN				r
KME				
CHECKED	\vdash			ŕ
BTN				
CLIENT PROJ. NO.				
TACAAAFAA				

SIGNAL PLANS

C7.01

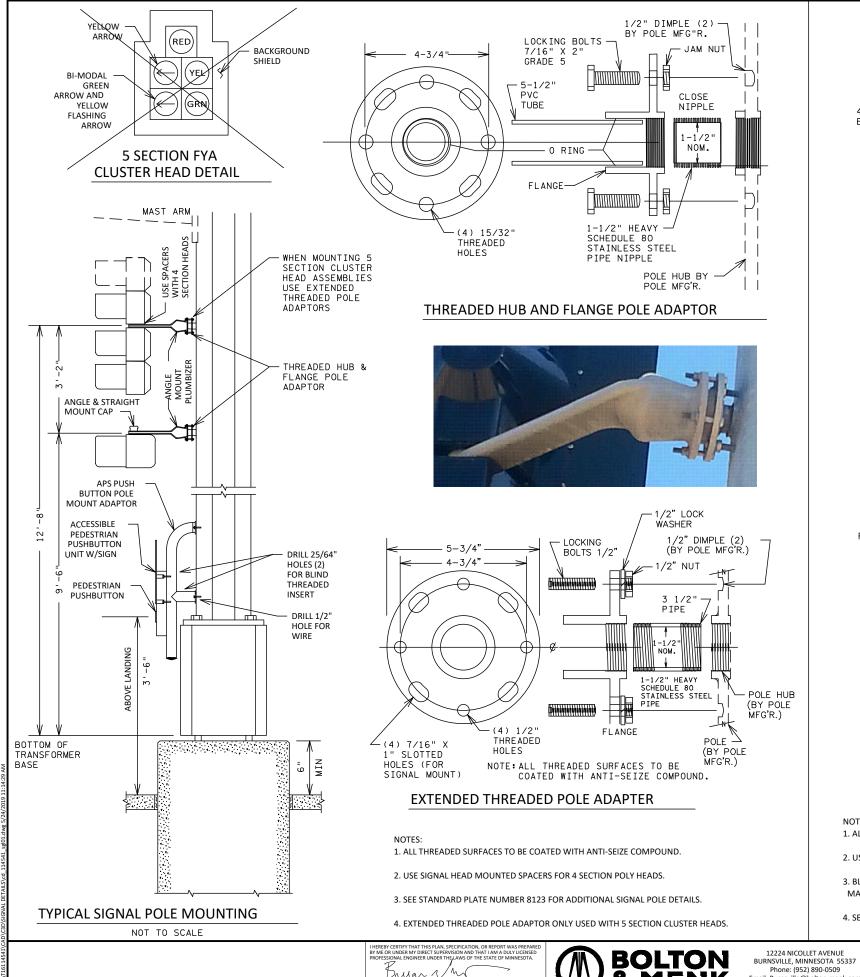

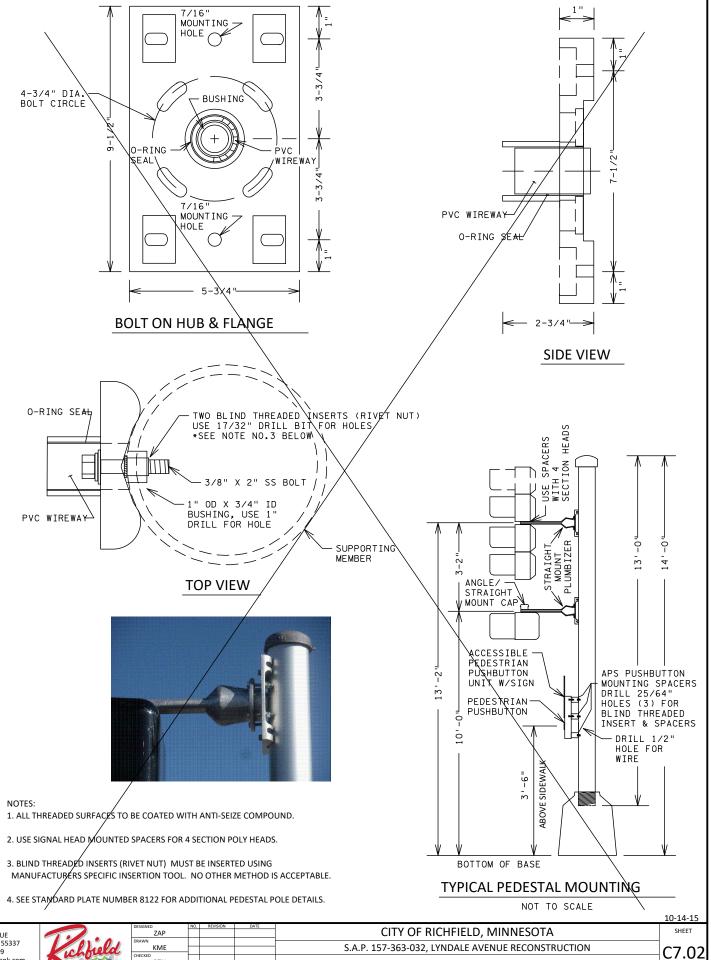


SIGNAL PLANS

BRYAN T. NEMETH 43354



Phone: (952) 890-0509 Email: Burnsville@bolton-menk.com www.bolton-menk.com

BTN

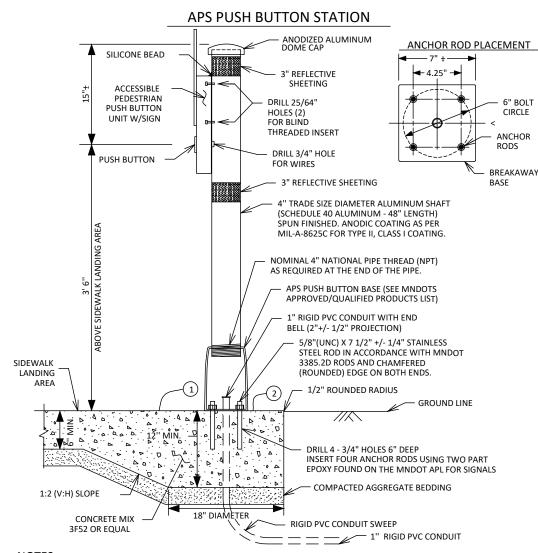

NOTES

PLACEMENT AND ORIENTATION OF THE PUSH BUTTON STATION IS CRITICAL. MOUNT THE BUTTON SO THAT THE FACE IS PARALLEL WITH THE ASSOCIATED CROSSWALK. SCREW IN SHAFT TO A TIGHTENED POSITION BEFORE MOUNTING ACCESSIBLE PEDESTRIAN PUSH BUTTON UNIT TO THE SHAFT

ORIENT ACCESS OPENING ON THE BREAKAWAY PEDESTAL DIRECTLY BELOW THE APS BUTTON.

PLUMB THE PUSH BUTTON STATION WITH LEVELING SHIMS IN ACCORDANCE WITH STANDARD PLATE 8129.

INSTALL BLIND THREADED INSERTS USING MANUFACTURER'S SPECIFIC INSERTION TOOL

USE ZINC PLATED STEEL 1/4 - 20 UNC BLIND THREADED INSERTS SUITABLE FOR MOUNTING ON SURFACE WALL THICKNESS OF .337. APPROVED BLIND INSERTS ARE LISTED ON MNDOT'S APPROVED/QUALITY PRODUCTS LIST WEBSITE FOR TRAFFIC SIGNALS.

USE APS 1/4 - 20 STAINLESS STEEL MOUNTING BOLTS. APPLY BRUSH ON ANTI SEIZE COMPOUND TO BOLTS PRIOR TO ASSEMBLY.

APPLY A BEAD OF 100% SILICONE SEALANT ALONG THE TOP OF THE PUSH BUTTON UNIT WHERE IT COMES IN CONTACT WITH THE $4^{\prime\prime}$ SHAFT.

USE WHITE REFLECTIVE SHEETING AT INTERSECTION CORNERS AND YELLOW REFLECTIVE SHEETING IN CENTER MEDIANS. APPROVED TUBE DELINEATOR SHEETING IS LISTED ON MNDOT'S APPROVED/QUALIFIED PRODUCTS LIST WEBSITE FOR SIGNING.

AN 18" X 6" FIBER FORMING TUBE MAY BE USED FOR THE LOWER HALF OF THE FOUNDATION WHEN CONDITIONS DO NOT ALLOW FOR THE 18" X 6" HOLE TO STAND OPEN.


- THE PUSH BUTTON STATION FOUNDATION IS MONOLITHIC (POURED AT ONE TIME) WITH THE SIDEWALK. PROVIDE A 1:2 (V:H) SLOPE GRADE WHERE THE 6" MIN SIDEWALK DEPTH TRANSITIONS TO THE 12" MIN FOUNDATION DEPTH. MAINTAIN THE COMPACTED AGGREGATE BEDDING AND THICKNESS USED FOR THE SIDEWALK THROUGHOUT THE SLOPE AND FOUNDATION GRADING. PROVIDE 1:2 (V:H) SLOPE GRADING 360 DEGREES FOR THE TRANSITION FROM THE SIDEWALK TO THE FOUNDATION WHEN THE FOUNDATION IS NOT LOCATED NEAR EDGE OF SIDEWALK AND IS SURROUNDED BY CONCRETE WALK.
- (2) ENSURE CONCRETE CONTROL JOINTS AND EDGE OF CONCRETE WALK ARE A MINIMUM 9" FROM THE CENTER OF THE PUSH BUTTON FOUNDATION.

TYPICAL APS PEDESTRIAN PUSH BUTTON LOCATION


THIS IS A GENERAL DETAIL INTENDED TO SHOW THE REQUIREMENTS OF APS PUSH BUTTON LOCATION. FOR PROJECT SPECIFIC INFORMATION REGARDING PEDESTRIAN RAMP LAYOUT AND PUSH BUTTON LOCATIONS. SEE THE PLAN.


SUPPLEMENTAL GUIDANCE FOR CONSTRUCTING COMPLIANT APS PUSH BUTTONS:

- (1) THE FACE OF THE BUTTON SHALL BE PARALLEL WITH THE OUTSIDE EDGE OF CROSSWALK.
- 2 A MINIMUM 4 FT X 4 FT LANDING AREA SHALL BE PROVIDED ADJACENT TO EACH BUTTON, WITH A 2 PERCENT MAXIMUM SLOPE IN ALL DIRECTIONS.
- (3) BUTTONS SHALL BE WITHIN 5 FT OF THE OUTSIDE EDGE OF THE CROSSWALK.
- 4 BUTTONS SHALL BE BETWEEN 1.5 FT AND 10 FT FROM THE BACK OF CURB OR EDGE OF ROADWAY, MEASURED IN THE DIRECTION OF TRAVEL. STANDALONE PUSH BUTTON STATIONS SHOULD BE 4' MINIMUM FROM THE BACK OF CURB TO AVOID KNOCKDOWNS.
- (5) BUTTONS SHALL BE AT LEAST 10 FT APART.
- 6 PROVIDE A MAINTENANCE ACCESS ROUTE (MAR) WHEREVER POSSIBLE FOR SNOW REMOVAL PURPOSES. A MAR REQUIRES A 6 FT MINIMUM CLEAR DISTANCE BETWEEN A PUSH BUTTON AND ANY OBSTRUCTIONS, INCLUDING BUILDINGS, V-CURB, ELECTRICAL FOUNDATIONS, SIGNAL CABINETS, OR ANOTHER PUSH BUTTON.
- (7) BUTTON SHOULD BE 2 FT MINIMUM FROM RAMP GRADE BREAK AND BACK OF WALK.

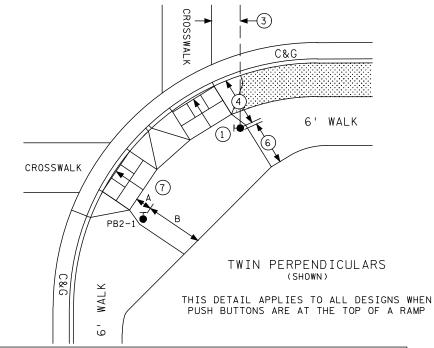

CONTRACTOR MUST USE OPTION 1 OR 2 WHEN THE APS PUSH BUTTON IS SHOWN AT THE EDGE OF WALK. OPTION USED (OR SELECTED) MUST BE THE SAME THROUGHOUT THE ENTIRE PROJECT.

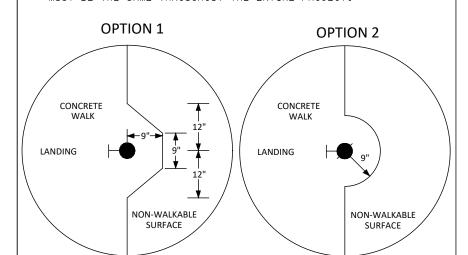

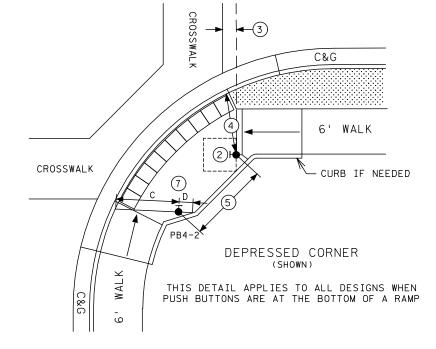

SIGNAL C	ONTROL	POINTS	DISTANCE TO	DISTANCE TO BACK OF
SIGNAL NO.	Х	Y		LANDING (FT)
PB2-1	-	-	Α	В
PB4-2	_	-	С	D

- A DISTANCE MEASURED FROM THE PUSH BUTTON TO THE FRONT OF LANDING/TOP OF RAMP
- B CLEAR DISTANCE MEASURED FROM THE PUSH BUTTON TO THE BACK OF LANDING/EDGE OF WALK
- C CLEAR DISTANCE MEASURED FROM THE PUSH BUTTON TO THE OUTSIDE EDGE OF DOMES IN THE DIRECTION OF TRAVEL
- D CLEAR DISTANCE FROM THE PUSH BUTTON TO THE BACK OF LANDING MEASURED IN THE OPPOSITE DIRECTION OF TRAVEL

HEREBY CERTIFY THAT THIS PLAN, SPECIFICATION, OR REPORT WAS PREPARED BY ME ON UNDER MY DIRECT SUPERVISION AND THAT I AM A DULY LICENSED PROFESSIONAL ENGINEER UNDER THE LAWS OF THE STATE OF MINNESOTA.

BRYAN T. NEMETH

UC NO. 43354

DATE

2/19/19



12224 NICOLLET AVENUE BURNSVILLE, MINNESOTA 55337 Phone: (952) 890-0509 Email: Burnsville@bolton-menk.com www.bolton-menk.com




IGNED		NO.	REVISION	DATE	CITY OF BIGUEIELD AMBINECOTA	
ZAP					CITY OF RICHFIELD, MINNESOTA	
WN						
KME	H	_			S.A.P. 157-363-032, LYNDALE AVENUE RECONSTRUCTION	
CKED		_				
BTN	L					
NT PROJ. NO.					SIGNAL PLANS	
T1611454	11	-			SIGNALILANS	


04-15-16

C7.03

TYPICAL PAD WITH CONTROLLER CABINET AND SERVICE CABINET NOT TO SCALE FOR ILLUSTRATION ONLY SEE SIGNAL PLAN LAYOUT FOR ADDITIONAL INFORMATION PLAN VIEW

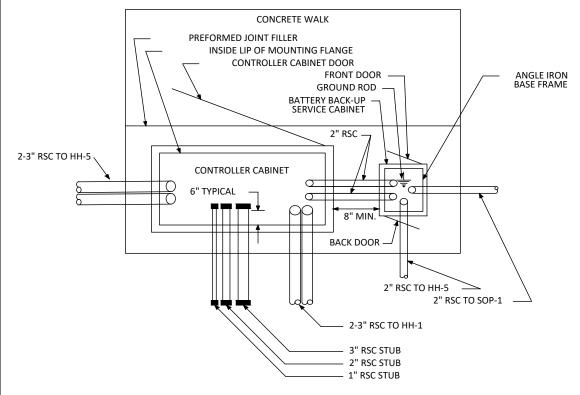


FRONT VIEW

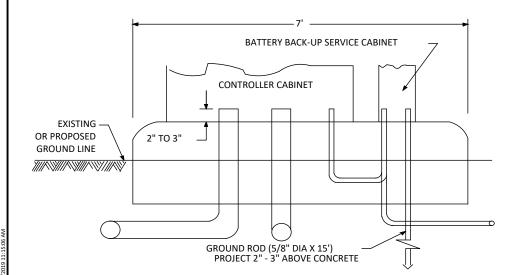


NOTES:

- 1. THE UPPER PART OF THE CONCRETE PAD SHALL BE BEVELED OR CHAMFERED IN A NEAT MANNER, AS DIRECTED BY THE ENGINEER.
- 2. THE TOP OF THE CONDUITS SHALL BE THREADED AND CAPPED AFTER INSTALLATION (UNTIL CABLES ARE INSTALLED).
- 3. THE LOCATION OF CONDUITS WITHIN THE CONCRETE PAD SHALL BE 6" TO THE CENTER OF THE CONDUIT FROM THE INSIDE LIP OF THE MOUNTING FLANGE ON THE DOOR SIDE OF THE CABINET. THE CONDUITS SHALL PROJECT 2" TO 3" ABOVE THE CONCRETE. THE CONDUITS SHALL NOT INTERFERE WITH THE CABINET FUNCTIONS (CONTROL EQUIPMENT, SUPPORTING MEMBERS, ETC.). FINAL CONDUIT LOCATIONS, AS DIRECTED BY THE ENGINEER.
- 4. CONDUITS WITH BOTH ENDS TERMINATING WITHIN THE PAD SHALL BE INSTALLED WITHIN THE CONCRETE PAD.
- 5. A CONCRETE SIDEWALK SHALL BE ON THE DOOR SIDE OF THE CONTROLLER CABINET, AS DIRECTED BY THE ENGINEER.
- 6. THE CONCRETE PAD AND THE CONCRETE WALK SHALL BE CONCRETE MIX 3G52 OR EQUAL, AS DIRECTED BY THE ENGINEER.
- 7. THE CONCRETE PAD ELEVATION SHALL BE ADJUSTED TO MAINTAIN THE 12" CLEARANCE ABOVE THE EXISTING OR PROPOSED GROUND LINE, AS DIRECTED BY THE ENGINEER.
- 8. THE SERVICE CABINET DOORS SHALL FACE AWAY FROM THE CONTROLLER CABINET TO AVOID CONFLICT WITH THE CONTROLLER CABINET OR THE CONTROLLER CABINET DOOR OPEN AS SHOWN.
- 9. THREAD AND CAP BOTH ENDS OF ALL RSC STUBS. THE CAPS LOCATED WITHIN THE CONTROLLER CABINET SHALL BE PERMANENTLY MARKED WITH AN ARROW TO INDICATE THE DIRECTION OF THE RSC STUBS. NO RSC STUB SHALL BE TERMINATED UNDER ANY FORM OF PAVEMENT OR HARD SURFACE, AS DIRECTED BY THE ENGINEER.


SIDE VIEW

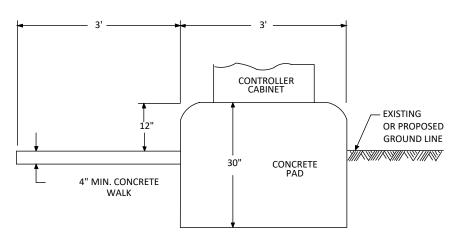

TYPICAL ANCHOR ROD LOCATION CONTROLLER CABINET AND **SERVICE CABINET** (NO SCALE)

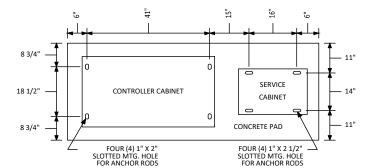

TYPICAL ANCHOR ROD CONTROLLER CABINET AND **SERVICE CABINET** (NO SCALE)

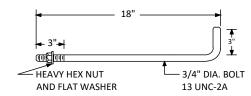

NOTES:

- 1. MATERIAL STEEL SHALL BE ASTM, A-36. 3/4" DIA. X 21" LONG BEFORE BENDING.
- 2. HOT DIP GALVANIZE FULL LENGTH. NUTS SHALL RUN FREE AFTER PLATING.
- 3. RODS TO BE SUPPLIED WITH GALVANIZED HEAVY HEX NUT AND FLAT WASHER, ASTM, A-563 ASSEMBLED AFTER ROD PLATING.

SIGNAL SYSTEM A

43354




12224 NICOLLET AVENUE BURNSVILLE, MINNESOTA 55337 Phone: (952) 890-0509 www.bolton-menk.com




	DESIGNED
	Z
0	DRAWN
eVal.	K
	CHECKED
ietown	В
ictoria.	CLIENT PROJ

	DESIGNED	N
	ZAP	
	DRAWN	Г
	KME	H
	CHECKED	⊣
-	BTN	L
	CLIENT PROJ. NO.	1
		ь

TYPICAL PAD WITH CONTROLLER CABINET AND SERVICE CABINET NOT TO SCALE FOR ILLUSTRATION ONLY SEE SIGNAL PLAN LAYOUT FOR ADDITIONAL INFORMATION PLAN VIEW

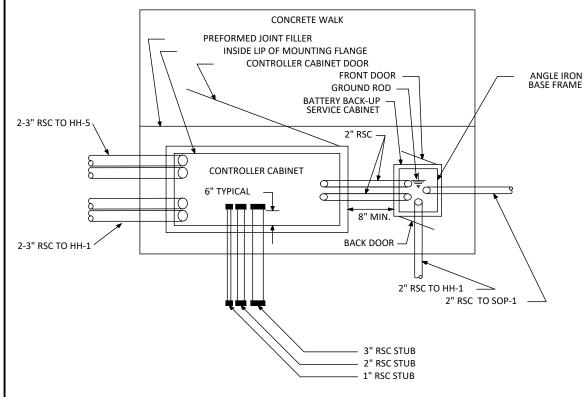


FRONT VIEW

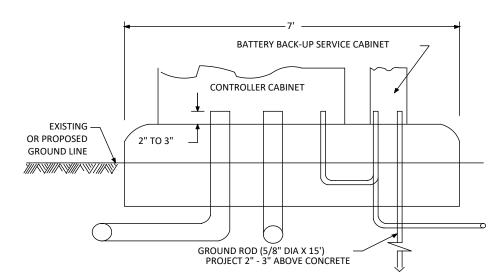


NOTES:


- 1. THE UPPER PART OF THE CONCRETE PAD SHALL BE BEVELED OR CHAMFERED IN A NEAT MANNER. AS DIRECTED BY THE ENGINEER.
- 2. THE TOP OF THE CONDUITS SHALL BE THREADED AND CAPPED AFTER INSTALLATION (UNTIL CABLES ARE INSTALLED).
- 3. THE LOCATION OF CONDUITS WITHIN THE CONCRETE PAD SHALL BE 6" TO THE CENTER OF THE CONDUIT FROM THE INSIDE LIP OF THE MOUNTING FLANGE ON THE DOOR SIDE OF THE CABINET. THE CONDUITS SHALL PROJECT 2" TO 3" ABOVE THE CONCRETE. THE CONDUITS SHALL NOT INTERFERE WITH THE CABINET FUNCTIONS (CONTROL EQUIPMENT, SUPPORTING MEMBERS, ETC.). FINAL CONDUIT LOCATIONS, AS DIRECTED BY THE ENGINEER.
- 4. CONDUITS WITH BOTH ENDS TERMINATING WITHIN THE PAD SHALL BE INSTALLED WITHIN THE CONCRETE PAD.
- 5. A CONCRETE SIDEWALK SHALL BE ON THE DOOR SIDE OF THE CONTROLLER CABINET, AS DIRECTED BY THE ENGINEER.
- 6. THE CONCRETE PAD AND THE CONCRETE WALK SHALL BE CONCRETE MIX 3G52 OR EQUAL, AS DIRECTED BY THE ENGINEER.
- 7. THE CONCRETE PAD ELEVATION SHALL BE ADJUSTED TO MAINTAIN THE 12" CLEARANCE ABOVE THE EXISTING OR PROPOSED GROUND LINE, AS DIRECTED BY THE ENGINEER.
- 8. THE SERVICE CABINET DOORS SHALL FACE AWAY FROM THE CONTROLLER CABINET TO AVOID CONFLICT WITH THE CONTROLLER CABINET OR THE CONTROLLER CABINET DOOR OPEN AS SHOWN.
- 9. THREAD AND CAP BOTH ENDS OF ALL RSC STUBS. THE CAPS LOCATED WITHIN THE CONTROLLER CABINET SHALL BE PERMANENTLY MARKED WITH AN ARROW TO INDICATE THE DIRECTION OF THE RSC STUBS. NO RSC STUB SHALL BE TERMINATED UNDER ANY FORM OF PAVEMENT OR HARD SURFACE, AS DIRECTED BY THE ENGINEER.

SIDE VIEW

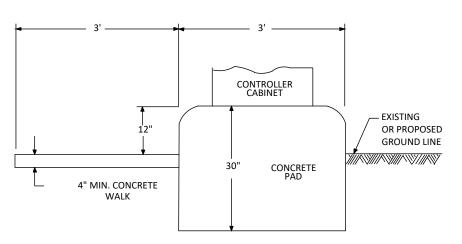

TYPICAL ANCHOR ROD LOCATION **CONTROLLER CABINET** AND SERVICE CABINET (NO SCALE)

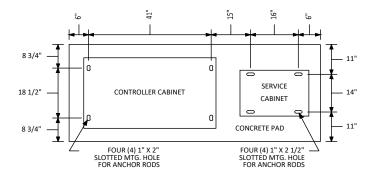

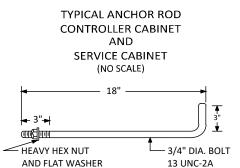

NOTES:

- 1. MATERIAL STEEL SHALL BE ASTM, A-36. 3/4" DIA. X 21" LONG BEFORE BENDING.
- 2. HOT DIP GALVANIZE FULL LENGTH. NUTS SHALL RUN FREE AFTER PLATING.
- 3. RODS TO BE SUPPLIED WITH GALVANIZED HEAVY HEX NUT AND FLAT WASHER, ASTM, A-563 ASSEMBLED AFTER ROD PLATING.

43354



12224 NICOLLET AVENUE BURNSVILLE, MINNESOTA 55337 Phone: (952) 890-0509 www.bolton-menk.com





	DESIGNED
	ZAP
1	DRAWN
Vol.	KME
	CHECKED
own	BTN
	CLIENT PROJ. NO

C7.05


SIGNAL SYSTEM B CITY OF RICHFIELD. MINNESOTA

S.A.P. 157-363-032, LYNDALE AVENUE RECONSTRUCTION

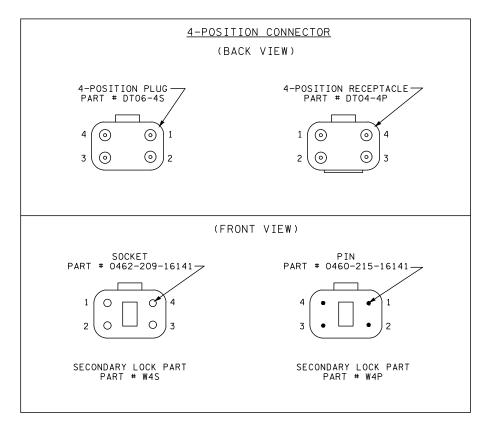

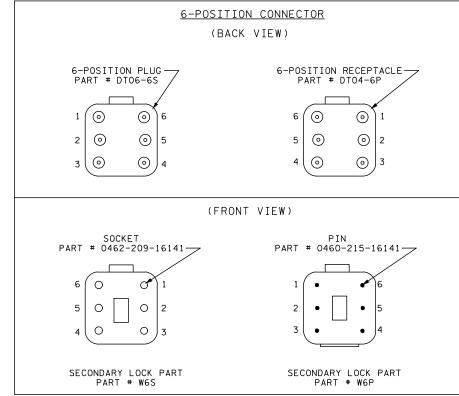

FART # W63		FAN	1 ** WOF
6 Posi	ition DT Conne	ector	(4 and 5 Section Heads)
Wire to Control Cabinet	Connector pin #	Wire to Signal Indication	Signal Indication
R	1	R	RED
0	2	0	YEL
BL	3	BL	GRN
WH	4	WH	NEU
O/BLK or BLK/R (6/C)	5	BLK/R	YLA or FYLA
BL/BLK or BLK (6/C)	6	BLK	GLA

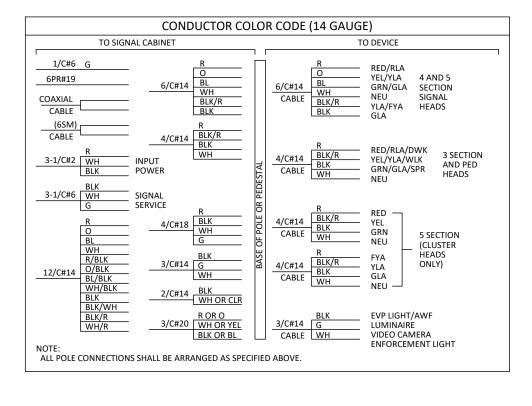

4 Positi	ector	(3 Section Head/DWK/WLK)	
Wire to Control Cabinet	Connector pin #	Wire to Signal Indication	Signal Indication
R or R/BLK or BLK	1	R	RED or DWK
O or O/BLK or BLK/WH or BLK	2	BLK/R	YEL or WLK
BL or BL/BLK or BLK/R or BLK	3	BLK	GRN or SPR
WH or WH/BLK or WH/R	4	WH	NEU

4 F (Used with	(EVP LHT/LUM/AWF/ VID CAM/ENF LHT)		
Wire to Control Cabinet	Connector pin #	Wire to Signal Indication	Signal Indication
BLK	1	BLK	EVP LHT or LUM or RED or YEL or VID CAM or ENF LHT or AWF
(Not Used)	2	(Not Used)	(Not Used) (See Note #8)
G	3	G	EQ.G
WH	4	WH	NEU

(Use Two C	4 POSITIOI Connectors for 5 Sectio	n DT Connectors n FYA Cluster Heads)							
12 Conductor Wire Connector 4 Conductor to Signal to Control Cabinet pin # Signal Indication Indication									
R	1	R	RED						
0	2	BLK/R	YEL						
BL	3	BLK	GRN						
WH	4	WH	NEU						
R/BLK	1	R	FYA						
O/BLK	2	BLK/R	YLA						
BL/BLK	3	BLK	GLA						
WH/BLK	4	WH	NEU						

WIRE COLOR CODE KEY								
R	R Red							
0	Orange							
BL	Blue							
WH	White							
BLK	Black							
BRN	Brown							
CL	Clear							
G	Green							
R/BLK	Red with Black Stripe							
O/BLK	Orange with Black Stripe							
BL/BLK	Blue with Black Stripe							
WH/BLK	White with Black Stripe							
WH/R	White with Red Stripe							
BLK/WH	Black with White Stripe							
BLK/R	Black with Red Stripe							

NOTES:

- 1. DTO4-P RECEPTACLE SHALL BE TERMINATED TO THE WIRING HARNESS RUNNING FROM THE BASE/JUNCTION BOX OF THE POLE TO SIGNAL INDICATIONS.
- 2. DTO6-_S PLUG SHALL BE TERMINATED TO THE CABLES RUNNING FROM THE TRAFFIC SIGNAL CABINET TO THE BASE/JUNCTION BOX OF THE POLE.
- 3. THERE SHALL BE A MINIMUM OF 24 INCHES OF SLACK ON EACH CABLE IN EVERY POLE BASE /JUNCTION BOX.
- 4. STRIP A MAXIMUM OF 6 INCHES OF THE OUTER JACKET OF EACH SIGNAL CABLE.
- 5. STRIP .250 INCHES OF INSULATION FROM EACH INDIVIDUAL CONDUCTOR.
- CRIMP PINS OR SOCKETS USING RATCHETING TYPE CRIMPING TOOL HDT-48-00. NO OTHER CRIMPING TOOL WILL BE ALLOWED.
- 7. WIRES MUST BE TERMINATED AS DETAILED IN TABLES DEPENDING ON WIRE COUNT.
- ANY UNUSED PIN MUST HAVE A SEALING PLUG PLACED IN BOTH THE PLUG & RECEPTACLE (PART # 114017).
- LABEL EACH HALF OF THE CONNECTOR (PLUG AND RECEPTACLE) WITH THE DEVICE

DESIGNATION (AS INDICATED IN THE WIRING DIAGRAM) USING A PERMANENT BLACK MARKER.

BRYAN T. NEMETH 43354









					12-29-15	
DESIGNED	NO.	REVISION	DATE	CITY OF DICUFIELD AMAINIFCOTA	011557	
ZAP				CITY OF RICHFIELD, MINNESOTA	SHEET	
DRAWN						
KME				S.A.P. 157-363-032, LYNDALE AVENUE RECONSTRUCTION		
CHECKED	\vdash				C7.06	
BTN	\vdash			0.00141 0.4410		
CLIENT PROJ. NO.				SIGNAL PLANS		
T16114541						


MAST ARM SIGNAL POLE FOUNDATION (NO SCALE)

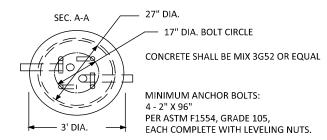

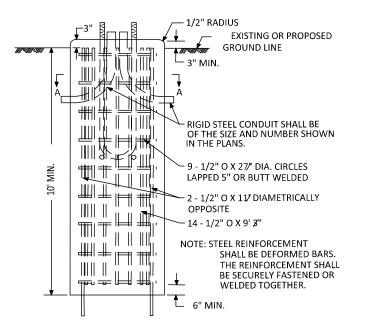

SIGNAL ASSEMBLY PEDESTAL MOUNT FOUNDATION (NO SCALE)


SEC. A-A

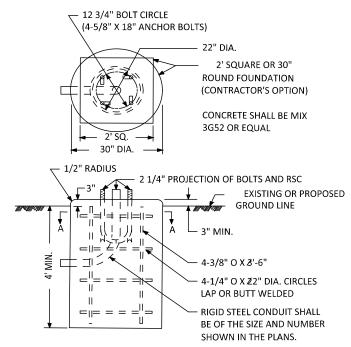

NOTE:

STEEL REINFORCEMENT SHALL BE DEFORMED BARS. THE REINFORCEMENT SHALL BE SECURELY FASTENED OR WELDED TOGETHER.

SIGNAL ASSEMBLY PEDESTAL MOUNT FLAT WASHER TYPICAL (NO SCALE)

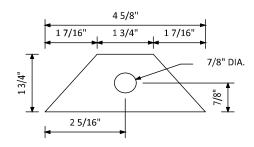

FLAT WASHERS SHALL BE 1/4" THICK A36 GALVANIZED STEEL.






www.bolton-menk.com

	ZAP	NO.	REVISION	DATE	CITY OF RICHFIEL
hold	DRAWN KME				S.A.P. 157-363-032, LYNDALE
ometown	CHECKED BTN				SIGNAL
Miletown	CLIENT PROJ. NO. T16114541	}—			SIGNAL

C7.07

VIDEO CAMERA LOCATIONS DETAIL (NO SCALE)

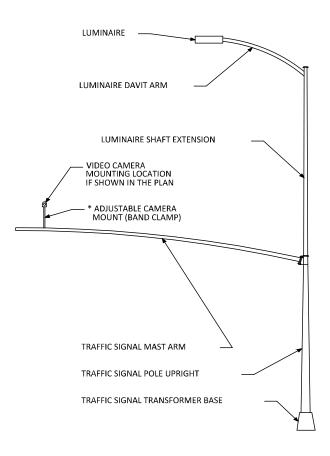

* HEIGHT OF MOUNTING BRACKET SHALL FACILITATE A CLEAR LINE OF SIGHT TO THE INTENDED FIELD OF VIEW AND ALLOW FOR FREE MOVEMENT OF THE VIDEO CAMERA. IF REQUIRED ALL COSTS TO PROVIDE AND INSTALL ADJUSTABLE CAMERA MOUNT SHALL BE INCLUDED IN THE UNIT PRICE BID FOR TRAFFIC CONROL SIGNAL SYSTEM (SYS).


BRYAN T. NEMETH 43354





	DESIGNED
	Z
000	DRAWN
al Love	K
Cho Cutto	CHECKED
Homelown	В
e Urban Hometown	CLIENT PROJ.
	T161

CLASSIC HEAVY MAST ARM SIGNAL POLE AND ROTATABLE LUMINAIRE SHAFT EXTENSION (NO SCALE, SEE SPECIAL PROVISIONS)

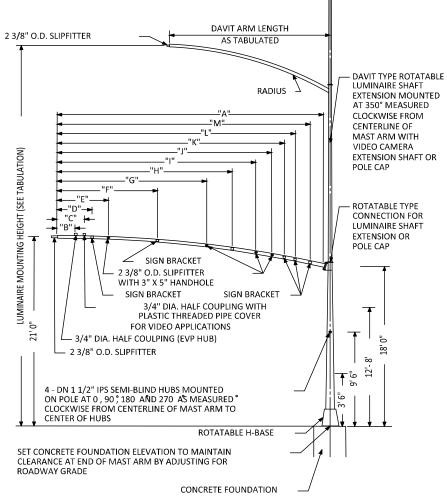

NOTES:

- 1.) POLE SHAFT SHALL BE BACK RAKED TO SET PLUMB UNDER NORMAL LOAD.
- 2.) SEE SPECIAL PROVISIONS FOR PAINTING AND GALVANIZING REQUIREMENTS OF MAST ARM SIGNAL POLES.

	MAST ARM POLE MOUNTING DETAILS														
	MAST ARM DIMENSIONS										LUMINAIRE	DAVIT			
POLE	"A"	"B"	"C"	"D"	"E"	"F"	"G"	"H"	" "	"J"	"K"	"L"	"M"	MOUNTING	ARM
FOLL	MAST ARM	EVP HUB	VIDEO HUB(1)	FYA SIGN	SIG. HEAD	SIGN	SIG. HEAD	SIGN	SIG. HEAD	SIG. HEAD	SIGN	SIGN	SIGN	HEIGHT	LENGTH
MA-1A	35.0'	3.0'	4.0'	6.0'	10.0'						13.0'	15.0'	17.0'	40.0'	8.0'
MA-2A	45.0'	3.0'	4.0'	6.0'	11.0'						14.0'	16.5'	19.0'	40.0'	8.0'
MA-3A	30.0'	3.0'	4.0'	6.0'	10.0'						13.0'	15.0'	17.0'	40.0'	8.0'
MA-4A	40.0'	3.0'	4.0'	6.0'	11.0'						14.0'	16.5'	19.0'	40.0'	8.0'
MA-1B	15.0'	3.0'	4.0'	6.0'							8.0'	10.0'	12.0'	40.0'	8.0'
MA-2B	30.0'	3.0'	4.0'	6.0'	11.0'						14.0'	16.5'	19.0'	40.0'	8.0'
MA-3B	25.0'	3.0'	4.0'	6.0'							9.0'	11.0'	13.0'	40.0'	8.0'
MA-4B	25.0'	3.0'	4.0'	6.0'	11.0'						14.0'	16.5'	19.0'	40.0'	8.0'

SPECIFIC NOTES:

(1) MOUNT WITH ADJUSTABLE CAMERA MOUNT (74")

BRYAN T. NEMETH 43354







www.bolton-menk.com

DESIGNED	NO.	REVISION	DATE	CITY OF DICHFIELD AMAINIFECTA	CHEET
ZAP				CITY OF RICHFIELD, MINNESOTA	SHEET
DRAWN					
KME	Т			S.A.P. 157-363-032, LYNDALE AVENUE RECONSTRUCTION	C7 00
CHECKED	\vdash			·	L/.U9
BTN	⊢			CICNIAL BLANC	
CLIENT PROJ. NO.	<u> </u>			SIGNAL PLANS	
T1611/15/11	ı	I			


TYPICAL SERVICE CABINET DETAILS

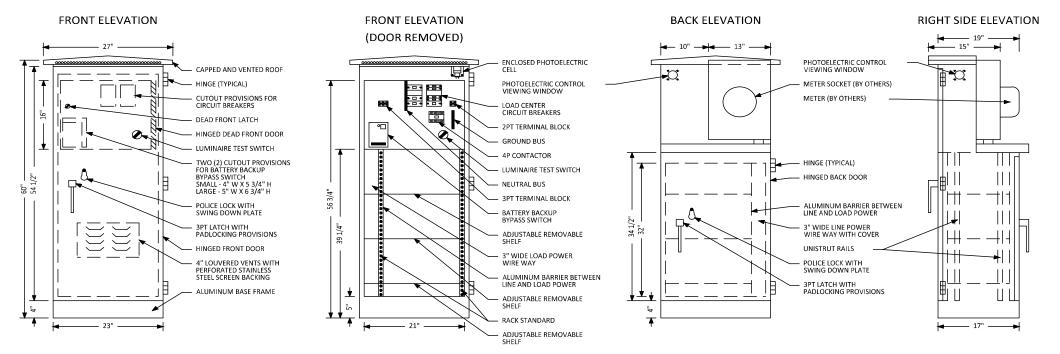


SERVICE CABINET BASE DETAILS

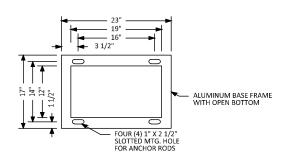

SERVICE CABINET SHELF DETAILS

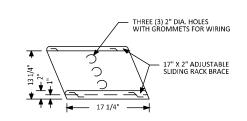



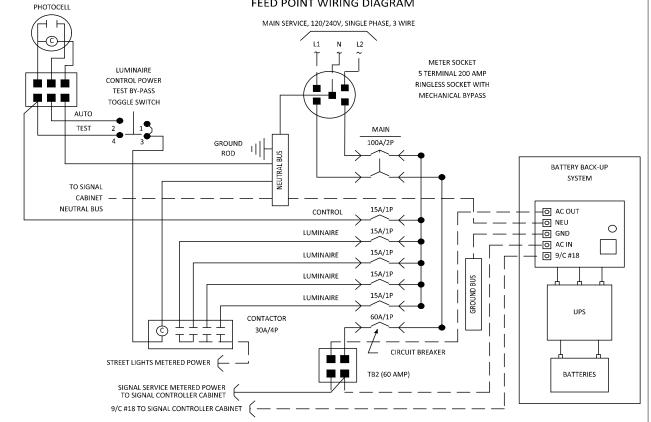

- 1. EACH SERVICE CABINET SHALL BE FABRICATED FROM 1/8" ALUMINUM FOR OUTDOOR WEATHERPROOF SERVICE. AFTER FABRICATION, THE SERVICE CABINET, BOTH INSIDE AND OUTSIDE, SHALL BE PROTECTED WITH AN EXTERNAL THIRTY (30) MINUTE CLEAR ANODIZED FINISH
- 2. ALL HINGES, HINGE PINS AND LOCKS SHALL BE OF NON-CORRODING CONSTRUCTION.
- 3. THE SERVICE CABINET DOORS SHALL BE ATTACHED TO THE ENCLOSURE WITH NON-CORRODING TAMPERPROOF CARRIAGE BOLTS AND SECURED WITH A STANDARD POLICE LOCK COMPLETE WITH A NUMBER 2 KEY AND SWING DOWN PLATE. PROVIDE ONE (1) KEY.
- 4. BOTH DOOR OPENINGS SHALL BE PROVIDED WITH A NEOPRENE GASKET TO FORM A COMPLETE SEAL WITH THE ENCLOSURE
- 5. PROVIDE A 2" DIA. WEATHERPROOF AND VANDAL RESISTANT CLEAR PLASTIC PHOTOELECTRIC CONTROL VIEWING WINDOW. LOCATED IN THE TOP SECTION OF THE CABINET AND ON THE LEFT OR RIGHT SIDE OF THE CABINET, ORIENTED TO ELIMINATE INTERFERENCE BY MANMADE LIGHT SOURCES AND SHALL NORMALLY FACE NORTH OR EAST.
- 6. THE CIRCUIT BREAKERS SHALL BE 120/240 VOLT AC, 60 HZ, AND SHALL BE CLEARLY MARKED WITH THE "ON" AND "OFF" POSITIONS AND IDENTIFIED WITH THE LOAD WHICH IT IS CARRYING (E.G. "SIGNALS", "LUMINAIRE WITH NUMBER" OR "FUTURE"). ALL CIRCUIT BREAKERS SHALL BE CLEARLY MARKED IN A MANNER THAT WILL NOT DETERIORATE WITH MOISTURE OR AGE.
- 7. SHORT CIRCUIT RATING 10,000 AIC SYMMETRICAL.
- 8. PROVIDE A PHOTOELECTRIC CONTROL CELL AND LUMINAIRE TEST SWITCH WITHIN
- 9. PROVIDE CLEARANCE TO INSTALL OR REMOVE THE PHOTOELECTRIC CONTROL CELL.

CONSTRUCTION NOTES

- 10. ALL CONDUIT ENTERING THE FOUNDATION SHALL BE SEALED WITH AN APPROVED DUCT
- 11. EACH SERVICE CABINET SHALL BE U.L. LISTED AND LABELED AS "SUITABLE FOR USE AS SERVICE ENTRANCE EQUIPMENT" AND APPROVED FOR OUTDOOR USE.
- 12. EACH SERVICE CABINET SHALL BE WELDED TO THE BASE IN ACCORDANCE WITH U.L.
- 13. SEE THE INTERSECTION LAYOUT FOR THE REQUIRED NUMBER OF LUMINAIRES AT EACH INTERSECTION.
- 14. A 1/2" THICK SOLID BUTYL RUBBER GASKET SHALL BE PROVIDED BETWEEN THE CONCRETE FOUNDATION AND THE SERVICE CABINET. THE GASKET SHALL CONSIST OF FOUR (4) STRIPS, SIZED TO FIT THE BASE INCLUDING CORNER HOLE/SLOTS TO ACCOMMODATE THE ANCHOR RODS. PROVIDE A 1/2" GAP FOR DRAINAGE.
- 15. UNISTRUT RAILS (#A400EA OR EQUIVALENT) USED FOR SHELF SUPPORTS FOR THREE (3) ADJUSTABLE AND REMOVABLE SHELVES SHALL BE MOUNTED TO THE SIDES OF THE SERVICE CABINET
- 16. THE 19" RACK IN THE BASE OF THE CABINET SHALL BE CONSTRUCTED TO
- 17. THE SERVICE CABINET SHALL BE SUPPLIED AND INSTALLED WITH BATTERY BACK-UP EQUIPMENT
- 18. ONE (1) SERVICE CABINET SHALL BE INSTALLED ON EACH EQUIPMENT PAD, SEE THE EQUIPMENT PAD DETAIL SHEETS FOR ADDITIONAL DETAILS.


43354



BURNSVILLE, MINNESOTA 55337 Phone: (952) 890-0509 www.bolton-menk.com



DESIGNED	NO.	REVISION	DATE	ſ
ZAP				
DRAWN				ľ
KME				
CHECKED	-			ì
BTN	_			
CLIENT PROJ. NO.	i			

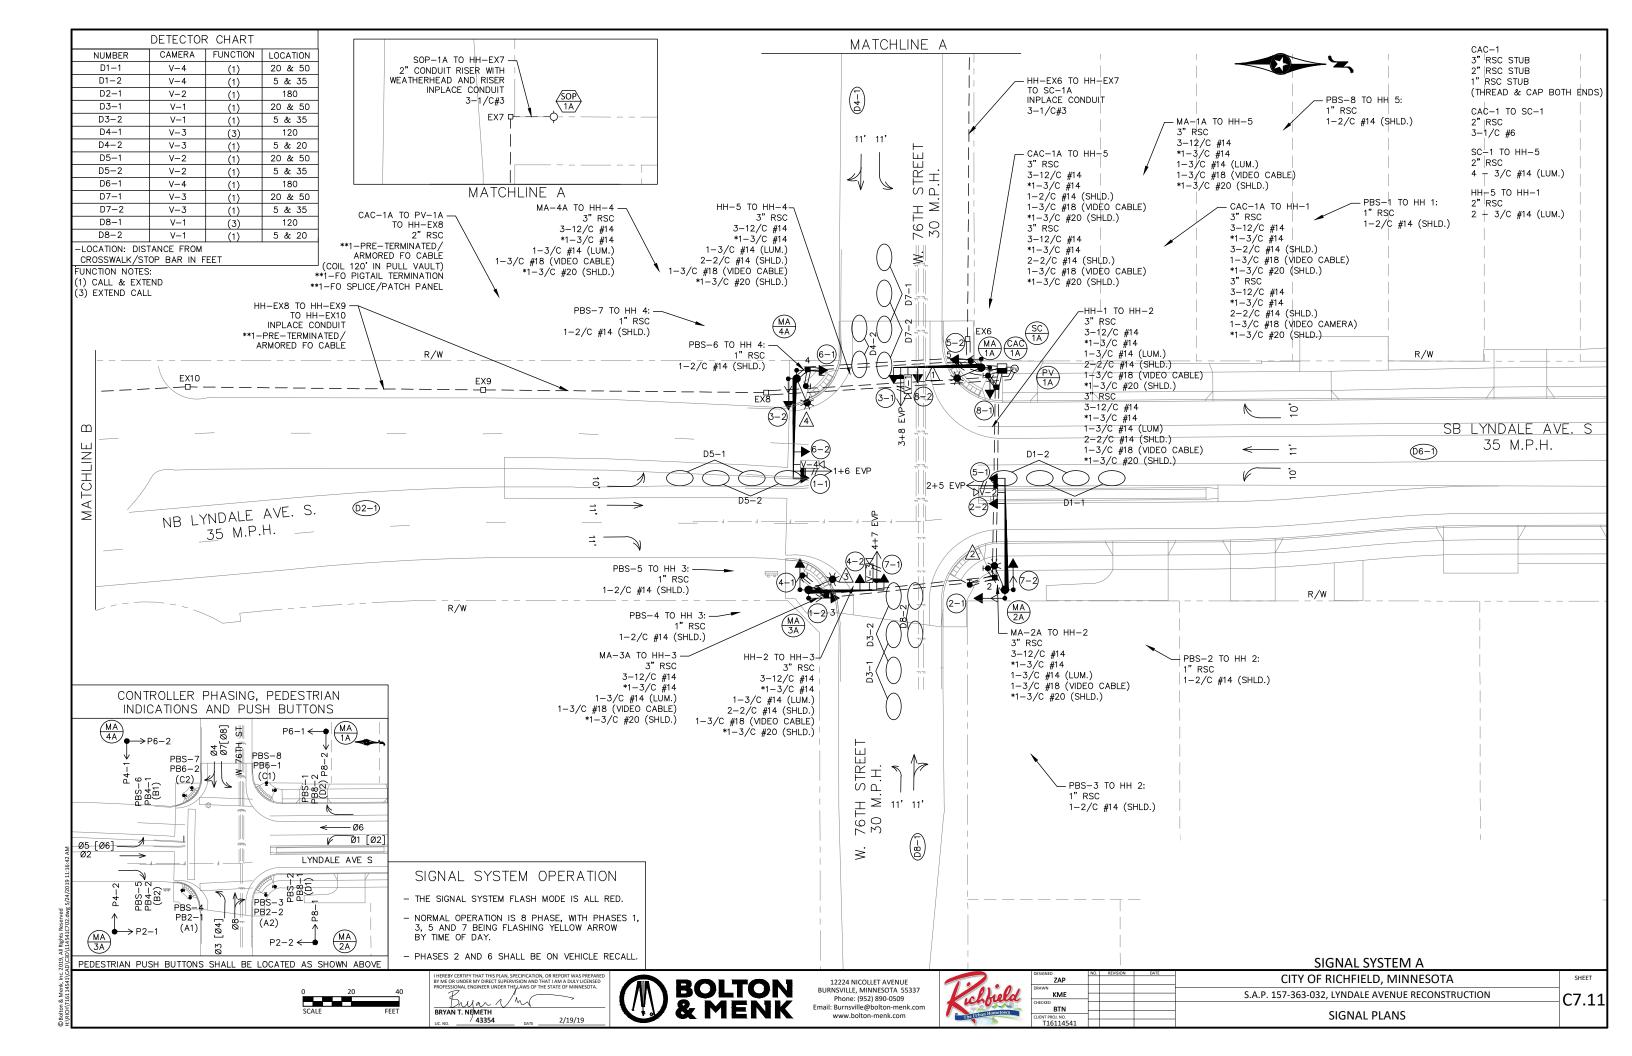

		•							
SIG.	FACE		SIG.		LEC		PLUMBIZER MOUNTING		
POLE	NO.	SIGNAL FACE MOUNT	Ø			ICATIONS		PED	ANGLE
NO.				RED	YEL	FYEL	GRN	. 25	
	3-1	MAST ARM (END)	3	-	-		-		STRAIGHT MOUNT PLUMBIZER
	8-2	MAST ARM (MID)	8	+	-	-			STRAIGHT MOUNT PLUMBIZER
	8-2 8-1	POLE MOUNT	8	•	•		•		180° ANGLE MOUNT PLUMBIZER
	P8-2	POLE MOUNT	8	-	-		_	***	180° ANGLE MOUNT PLUMBIZER
MA-1A	P0-Z	POLE IVIOUNT	5	-	-		—		180 ANGLE MOUNT PLOMBIZER
	5-2	POLE MOUNT	6	-	-	-	-		90° ANGLE MOUNT PLUMBIZER
	P6-1	POLE MOUNT	6			_		***	90° ANGLE MOUNT PLUMBIZER
	101	T OLE MICOITY	+ -						30 MAGE MOONT TEOMBLEEN
			5	-	-		-		
	5-1	MAST ARM (END)	6			-			STRAIGHT MOUNT PLUMBIZER
	2-2	MAST ARM (MID)	2	•	•		•		STRAIGHT MOUNT PLUMBIZER
MA-2A	2-1	POLE MOUNT	2	•	•		•		180° ANGLE MOUNT PLUMBIZER
IVIA-ZA	P2-2	POLE MOUNT	2					***	180° ANGLE MOUNT PLUMBIZER
	7-2	POLE MOUNT	7	-	-		-		90° ANGLE MOUNT PLUMBIZER
			8			-			
	P8-1	POLE MOUNT	8					***	90° ANGLE MOUNT PLUMBIZER
	7-1	MAST ARM (END)	7	-	-		-		STRAIGHT MOUNT PLUMBIZER
			8			-			CTRAIGUT MAGUNT RUMARITER
	4-2	MAST ARM (MID)	4	•	•		•		STRAIGHT MOUNT PLUMBIZER
	4-1	POLE MOUNT	4	•	•		•	***	180° ANGLE MOUNT PLUMBIZER
MA-3A	P4-2	POLE MOUNT	4					***	180° ANGLE MOUNT PLUMBIZER
	1-2	POLE MOUNT	1 2	-	-		-		90° ANGLE MOUNT PLUMBIZER
	P2-1	POLE MOUNT	2					***	90° ANGLE MOUNT PLUMBIZER
	PZ-1	POLE IVIOUNT							30 ANGLE WOONT PLOWBIZER
			1	-	-		-		
	1-1	MAST ARM (END)	2	 	<u> </u>		<u> </u>		STRAIGHT MOUNT PLUMBIZER
	6-2	MAST ARM (MID)	6	•	•		•		STRAIGHT MOUNT PLUMBIZER
	6-1	POLE MOUNT	6	•	•		•		180° ANGLE MOUNT PLUMBIZER
MA-4A	P6-2	POLE MOUNT	6					***	180° ANGLE MOUNT PLUMBIZER
	3-2	POLE MOUNT	3	-	-		-		90° ANGLE MOUNT PLUMBIZER
			4			-			
	P4-1	POLE MOUNT	4					***	90° ANGLE MOUNT PLUMBIZER

TYPICAL 4-SECTION	I SIGNAL HEAD PHAS	ING WITH FLASHING	YELLOW ARROW
SIGNAL FACE 1-1 AND 1-2	SIGNAL FACE 3-1 AND 3-2	SIGNAL FACE 5-1 AND 5-2	SIGNAL FACE 7-1 AND 7-2
Ø1 (Y) Ø2 (Y) FYA (G) Ø1 (G)	Ø3 (Y) Ø4 (Y) FYA (G)	Ø5 (Y) Ø6 (Y) FYA (G) Ø5 (G)	Ø7 (Y) Ø8 (Y) FYA Ø7 (G)

	SIGNAL STRUCT	URE LO	CATIONS			
NO.	LOCATION	NO.				
HH-1	206+96.55 - 32.33 (LT)	CAC-1A	206+98.01 - 40.21 (LT)			
HH-2	206+95.31 - 46.94 (RT)	SC-1A	207+00.19 - 40.19 (LT)			
HH-3	206+25.10 - 53.82 (RT)					
HH-4	206+18.06 - 40.46 (LT)	SOP-1A	SOP-1A INPLACE			
HH-5	206+79.46 - 43.67 (LT)					
PBS-1	206+93.77 - 37.24 (LT)	PBS-5				
PBS-2	206+92.43 - 43.06 (RT)	PBS-6				
PBS-3	206+84.77 - 49.88 (RT)	PBS-7	PBS-7 206+23.87 - 39.87 (LT)			
PBS-4	206+21.58 - 51.68 (RT)	PBS-8	206+85.93 - 43.31 (LT)			
NO.		ATION		MAST		
110.	FOUNDATION (1)		ARM			
MA-1A	206+90.25 - 40.59 (LT)	206+53.7	79 - 40.90 (LT)	35'		
MA-2A	206+99.46 - 52.07 (RT)	206+99.8	34 - 5.58 (RT)	45'		
MA-3A	206+17.63 - 51.44 (RT)	206+49.1	l3 - 51.71 (RT)	30'		
MA-4A	206+13.34 - 36.53 (LT)	206+11.6	52 - 4.93 (RT)	40'		

(1) TO THE CENTER OF THE HANDHOLE OR CONCRETE FOUNDATION.
ALL STATIONS AND OFFSETS ARE REFERENCED FROM LYNDALE SB ALIGNMENT.


NOTES:

- LED LUMINAIRES SHALL BE INSTALLED ON LUMINAIRE SHAFT EXTENSIONS ON MAST ARMS 1, 2, 3 AND 4.
- ALL HANDHOLES SHALL BE PVC TYPE WITH METAL FRAMES AND COVERS (SEE SPECIAL PROVISIONS). THE CONTRACTOR SHALL INSTALL AND PROGRAM ALL APS EQUIPMENT.
- ALL PEDESTRIAN PUSHBUTTONS SHALL BE APS PUSHBUTTONS WITH SIGNS (SEE SPECIAL PROVISIONS).
 ONE APS PUSHBUTTON AND SIGN (LT ARROW) SHALL BE FURNISHED AND INSTALLED ON PBS-2, 4, 6 AND 8. ONE APS PUSHBUTTON AND SIGN (RT ARROW) SHALL BE FURNISHED AND INSTALLED ON PBS-1, 3, 5 AND 7. INTERNATIONAL SYMBOLS SHALL BE USED FOR ALL PEDESTRIAN INDICATIONS (HAND AND WALKING PERSON). ALL PEDESTRIAN INDICATIONS SHALL HAVE COUNTDOWN TIMERS (SEE SPECIAL PROVISIONS).
- ALL VEHICULAR AND PEDESTRIAN INDICATIONS SHALL USE LED TECHNOLOGY (SEE SPECIAL PROVISIONS). THE ENGINEER SHALL LOCATE ALL POLES AND HANDHOLES PRIOR TO ANY CONSTRUCTION.

- ALL SIGNAL FACES SHALL HAVE BACKGROUND SHIELDS.
 THE CONTRACTOR SHALL FURNISH AND INSTALL VIDEO CAMERAS. VIDEO CAMERAS 1, 2, 3, AND 4 SHALL
- BE MOUNTED ON LUMINAIRES (SEE SPECIAL PROVISIONS).
 THE CONTRACTOR SHALL RESTORE ALL DISTURBED TURF, CONCRETE OR BITUMINOUS WALK, ETC.
 TO ITS ORIGINAL CONDITION OR BETTER (SEE SPECIAL PROVISIONS).
- SEE SPECIAL PROVISIONS FOR EMERGENCY VEHICLE PRE-EMPTION (EVP) SYSTEM, VIDEO DETECTION SYSTEM, BATTERY BACK-UP SIGNAL SERVICE CABINET, ACCESSIBLE PEDESTRIAN SIGNAL (APS), AND COUNTY FURNISHED ITEMS.
- COMMON BACKFILL AT SIGNAL STRUCTURES AS DIRECTED BY THE ENGINEER INCLUDED AS INCIDENTAL TO THE SIGNAL SYSTEM PAY ITEM.
- OVERHEAD MAST ARM MOUNTED TYPE "D" SIGN PANELS SHALL BE INCLUDED IN THE SIGNAL SYSTEM PAY
- ITEM (SEE SPECIAL PROVISIONS).
- ALL ITEMS SHOWN ARE FURNISH AND INSTALL UNLESS NOTED OTHERWISE.
- THE CONTRACTOR SHALL FURNISH AND INSTALL 4 R10-X12 (36" X 42") SIGN ADJACENT TO SIGNAL INDICATIONS 1-1, 3-1, 5-1 AND 7-1.

 * INDICATES ITEMS TO BE INCLUDED IN THE EVP SYSTEM PAY ITEM.

- ** INDICATES ITEMS TO BE INCLUDED IN THE INTERCONNECT SYSTEM PAY ITEM.
- THE REMOVAL AND DISPOSAL OF THE EXISTING SIGNAL SHALL BE INCLUDED IN THE REMOVE SIGNAL SYSTEM "A" PAY ITEM.
 SALVAGE BUS STOP SIGNS (2) FROM EXISTING SIGNAL SHALL BE INCLUDED IN THE ILEMOVE SIGNAL STOREM
 THE CONTRACTOR SHALL INSTALL SALVAGED BUS STOP SIGNS (2), ON POLE MA-1A FACING NORTH (STOPID 3423) AND
 ON POLE MA-3A FACING SOUTH (STOPID 3360).

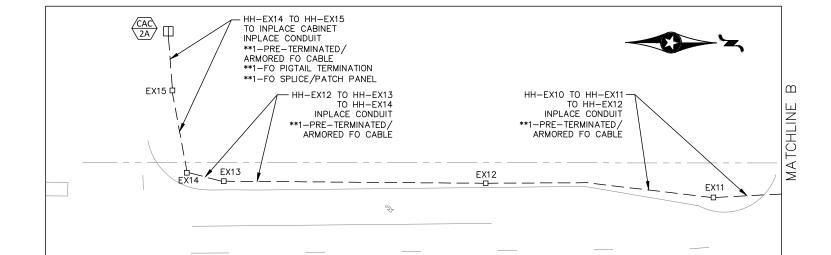

*** INTERNATIONAL SYMBOLS IN A DUAL FACE SINGLE HOUSING WITH PEDESTRIAN COUNTDOWN TIMER.

43354



12224 NICOLLET AVENUE BURNSVILLE, MINNESOTA 55337 Phone: (952) 890-0509 www.bolton-menk.com




ld	DESIGNED
	ZAP
	DRAWN
	KMI
	CHECKED
own	BTN
	CLIENT PROJ. NO
	T16114

SIGNAL SYSTEM A CITY OF RICHFIELD. MINNESOTA S.A.P. 157-363-032, LYNDALE AVENUE RECONSTRUCTION C7.12

POLE NOTES


SIGNAL PLANS

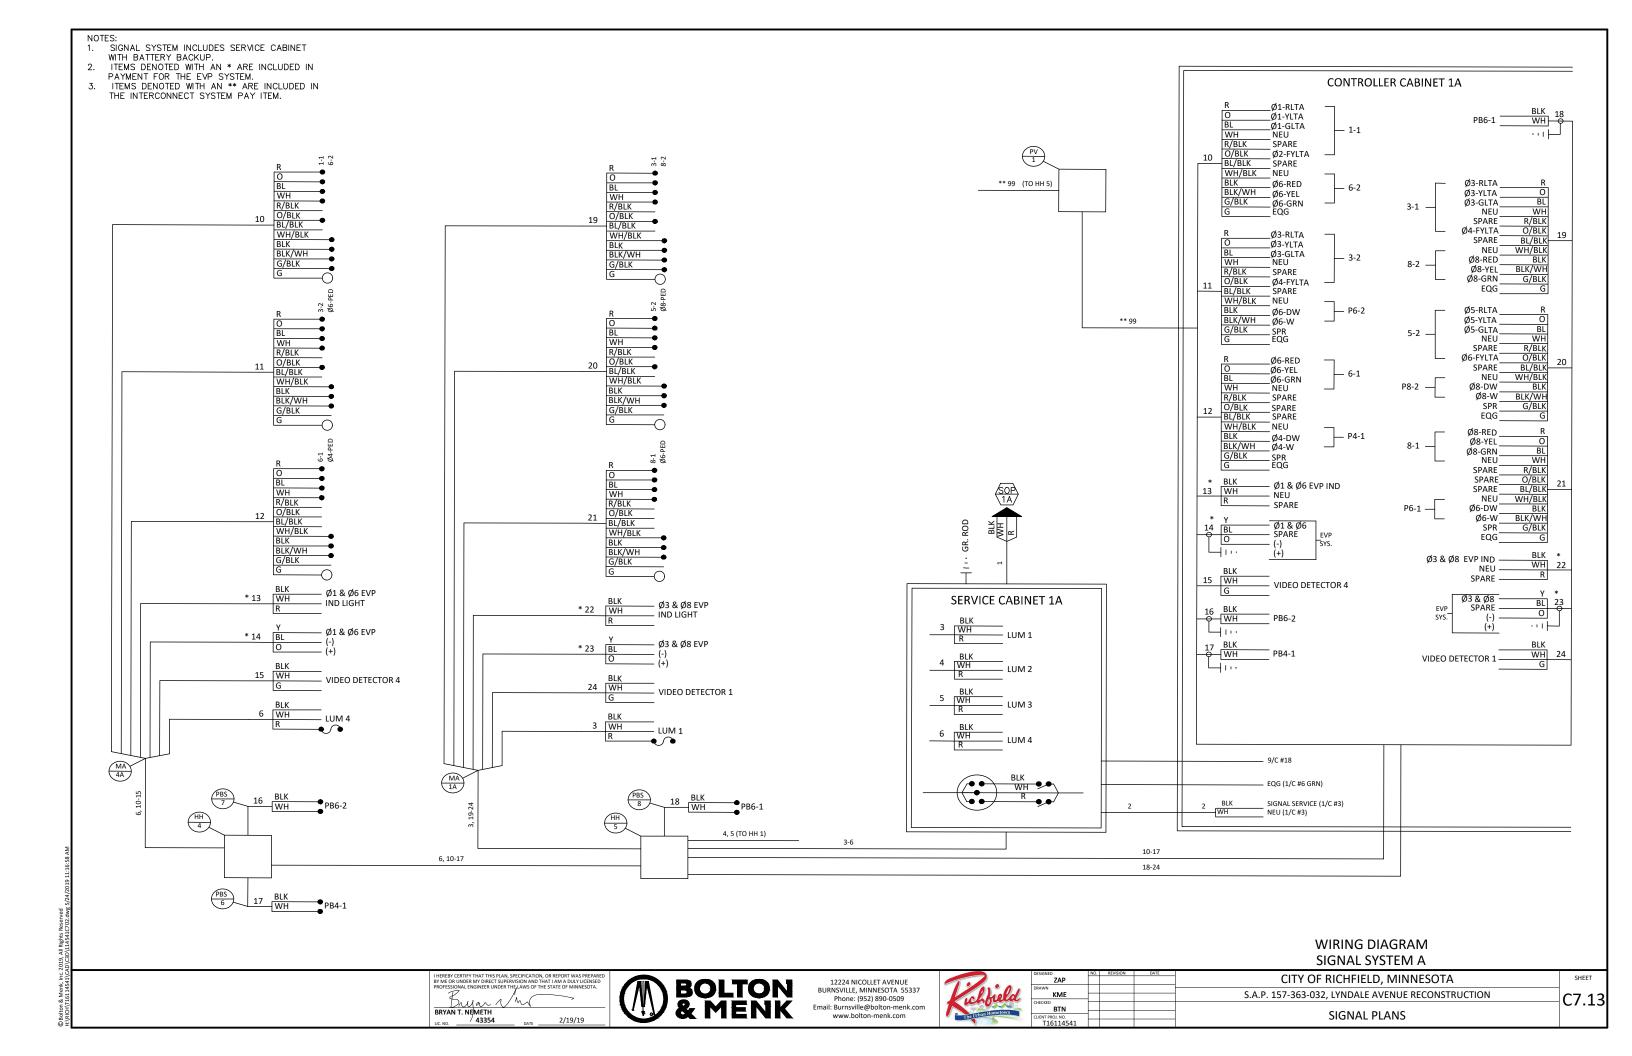



- 1. SIGNAL SYSTEM INCLUDES SERVICE CABINET
- WITH BATTERY BACKUP.

 ITEMS DENOTED WITH AN * ARE INCLUDED IN PAYMENT FOR THE EVP SYSTEM.

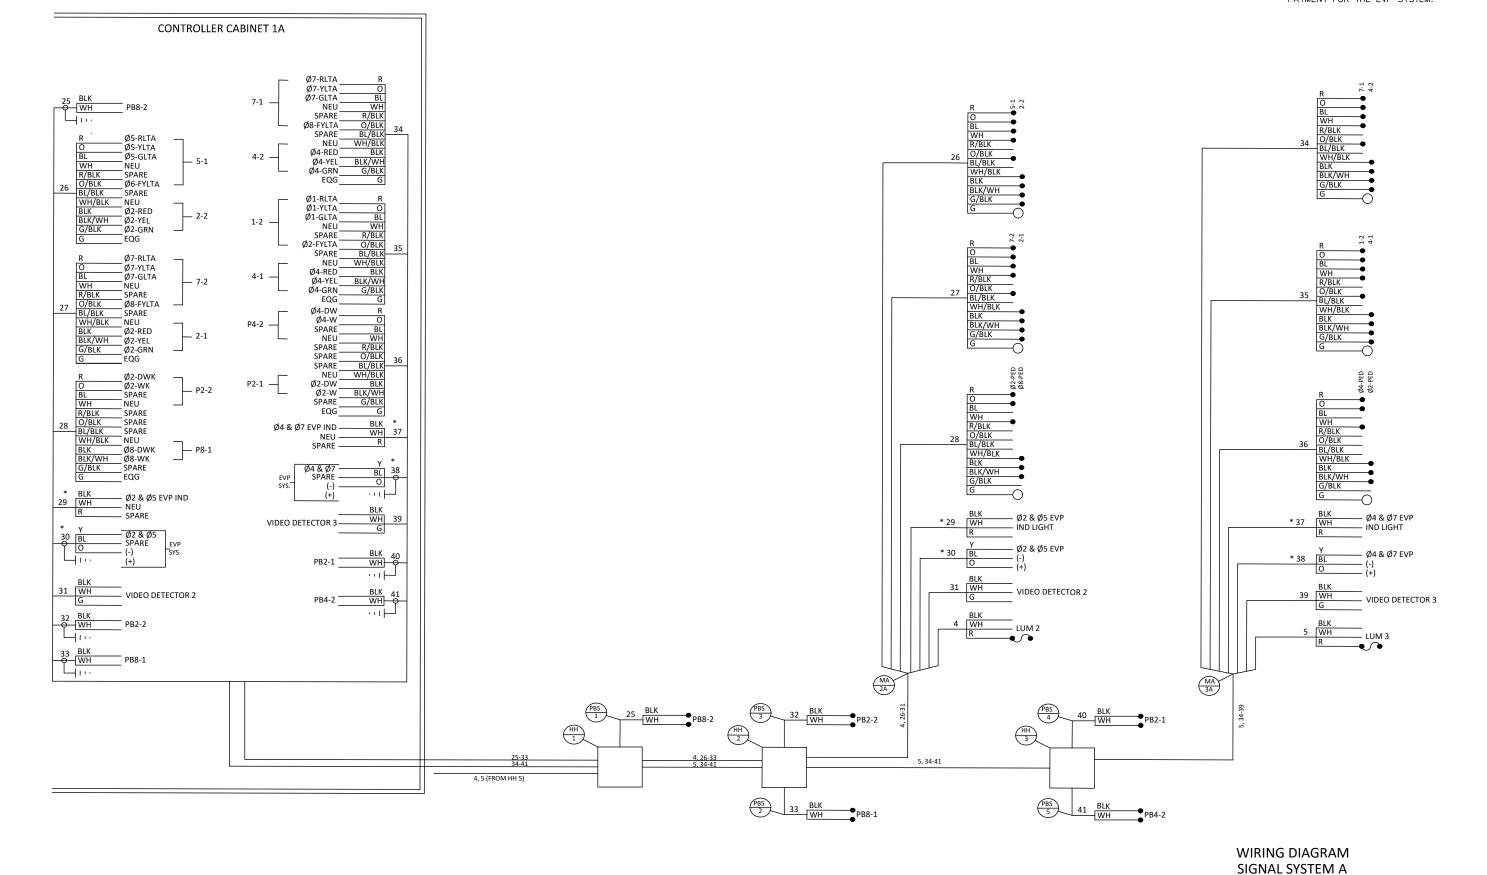

I HEREBY CERTIFY THAT THIS PLAN, SPECIFICATION, OR REPORT WAS PREPARED BY ME OR UNDER WHO RECET SUPERVISION AND THAT I AM A DULY LICENSED PROFESSIONAL ENDIRECT HUMBER THE LAWS OF THE STATE OF MINNESOTA.

BRYAN T. NEMETH

UC. NO. 43354

DATE 2/19/19




12224 NICOLLET AVENUE BURNSVILLE, MINNESOTA 55337 Phone: (952) 890-0509 Email: Burnsville@bolton-menk.com www.bolton-menk.com

12/100
chald
The Urban Hometown

NED	NO.	REVISION	DATE	OUTY OF BUOUFIELD ANNIHESOTA
ZAP				CITY OF RICHFIELD, MINNESOTA
N				
KME	Н			S.A.P. 157-363-032, LYNDALE AVENUE RECONSTRUCTION
ED	\vdash			
BTN				
				SIGNAL PLANS
PROJ. NO.	\vdash			SIGNAL FLANS
16114541				

SHEET

C7.14

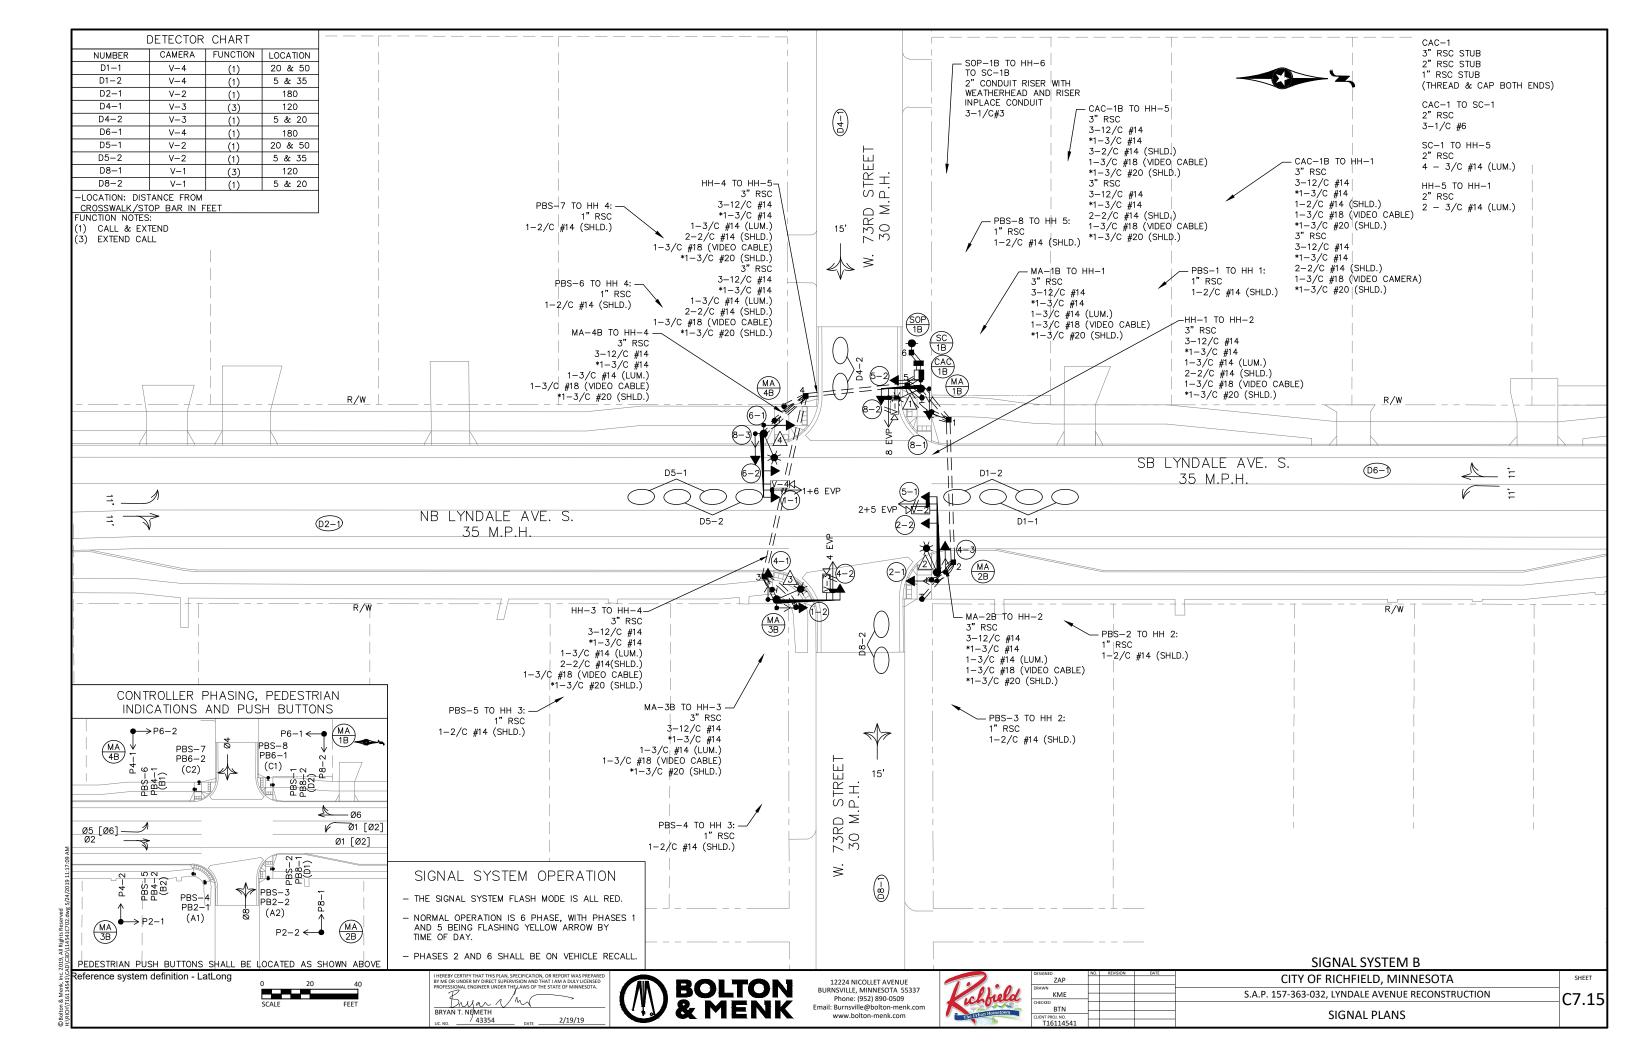

SIG.	FACE		CIC		LEC	INDICAT	IONS		DILLIA ADIZED A AGUNIZINIO
POLE NO.	SIGNAL FACE MOUNT	SIG.		12" IND	ICATIONS		PED	PLUMBIZER MOUNTING ANGLE	
		Ø	RED	YEL	FYEL	GRN	PED	ANGEL	
	8-2	MAST ARM (MID)	8	•	•		•		STRAIGHT MOUNT PLUMBIZER
1	8-1	POLE MOUNT	8	•	•		•		180° ANGLE MOUNT PLUMBIZER
MA-1B	P8-2	POLE MOUNT	8					***	180° ANGLE MOUNT PLUMBIZER
	5-2	POLE MOUNT	5 6	-	-	-	-		90° ANGLE MOUNT PLUMBIZER
-	P6-1	POLE MOUNT	6					***	90° ANGLE MOUNT PLUMBIZER
	5-1	MAST ARM (END)	5	-	-	-	-		STRAIGHT MOUNT PLUMBIZER
ı	2-2	MAST ARM (MID)	2	•	•		•		STRAIGHT MOUNT PLUMBIZER
MA-2B	2-1	POLE MOUNT	2	•	•		•		180° ANGLE MOUNT PLUMBIZER
IVIA-ZB	P2-2	POLE MOUNT	2					***	180° ANGLE MOUNT PLUMBIZER
Ī	4-3	POLE MOUNT	4	•	•		•		90° ANGLE MOUNT PLUMBIZER
	P8-1	POLE MOUNT	8					***	90° ANGLE MOUNT PLUMBIZER
	4-2	MAST ARM (MID)	4	•	•		•		STRAIGHT MOUNT PLUMBIZER
Ī	4-1	POLE MOUNT	4	•	•		•		180° ANGLE MOUNT PLUMBIZER
MA-3B	P4-2	POLE MOUNT	4					***	180° ANGLE MOUNT PLUMBIZER
	1-2	POLE MOUNT	1 2	-	-	-	-		90° ANGLE MOUNT PLUMBIZER
	P2-1	POLE MOUNT	2					***	90° ANGLE MOUNT PLUMBIZER
	1-1	MAST ARM (END)	2	-	-	-	-		STRAIGHT MOUNT PLUMBIZER
İ	6-2	MAST ARM (MID)	6	•	•		•		STRAIGHT MOUNT PLUMBIZER
	6-1	POLE MOUNT	6	•	•		•		180° ANGLE MOUNT PLUMBIZER
MA-4B	P6-2	POLE MOUNT	6					***	180° ANGLE MOUNT PLUMBIZER
İ	8-3	POLE MOUNT	8	•	•		•		90° ANGLE MOUNT PLUMBIZER
İ	P4-1	POLE MOUNT	4					***	90° ANGLE MOUNT PLUMBIZER


TYPICAL 4-SECTION SIGNAL HEAD PHA	ASING WITH FLASHING YELLOW ARROW
SIGNAL FACE 1-1 AND 1-2	SIGNAL FACE 5-1 AND 5-2
Ø1 (Y) Ø2 (Y) FYA (G)	Ø5 (R) Ø5 (Y) Ø6 (Y) Ø7 (Y) Ø5 (G)

	SIGNAL STRUC	TURE LO	CATIONS				
NO.	LOCATION	LOCATION NO. LOCATION					
HH-1	226+55.31 - 26.77 (LT)	HH-6	226+39.85 - 54.76 (LT)				
HH-2	226+57.36 - 32.60 (RT)	CAC-1C	226+43.00 - 45.46 (LT)				
HH-3	225+78.62 - 38.57 (RT)	SC-1C	226+42.81- 50.27 (LT)				
HH-4	225+95.78 - 36.65 (LT)						
HH-5	226+38.10 - 41.02 (LT)	SOP-1C	INPLACE				
			225+81.80 - 44.05 (RT)				
PBS-1	226+48.25 - 29.95 (LT)	PBS-5					
PBS-2	226+48.27 - 40.00 (RT)	PBS-6					
PBS-3	226+44.27 - 48.00 (RT)	PBS-7	225+86.79 - 32.37 (LT)				
PBS-4	225+91.83 - 51.40 (RT)	PBS-8	226+44.25 - 35.94 (LT)				
	LOC	ATION		MAST			
NO.	FOUNDATION (1)	T	AIM ARM TO	ARM			
MA-1B	226+43.79 - 39.68 (LT)	226+27.2	29 - 39.71 (LT)	15'			
MA-2B	226+50.50 - 36.88 (RT)	226+50.4	49 - 5.38 (RT)	30'			
MA-3B	225+83.67 - 48.21 (RT)	226+10.:	17 - 48.39 (RT)	25'			
MA-4B	225+78.28 - 20.93 (LT)	225+78.2	225+78.28 - 5.60 (RT)				

(1) TO THE CENTER OF THE HANDHOLE OR CONCRETE FOUNDATION. ALL STATIONS AND OFFSETS ARE REFERENCED FROM LYNDALE SB ALIGNMENT

1. ITEMS DENOTED WITH AN * ARE INCLUDED IN PAYMENT FOR THE EVP SYSTEM PAY ITEM

*** INTERNATIONAL SYMBOLS IN A DUAL FACE SINGLE HOUSING WITH PEDESTRIAN COUNTDOWN TIMER.

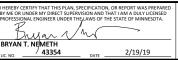



12224 NICOLLET AVENUE BURNSVILLE, MINNESOTA 55337 Phone: (952) 890-0509 Email: Burnsville@bolton-menk.com www.bolton-menk.com



)	DESIGNED
Lield	DRAWN
Hometown	CHECKED
	CLIENT PR

ld	DESIGNED
	ZAI
	DRAWN
	KM
	CHECKED
	BTI
	CLIENT PROJ. NO
	T16114

SIGNAL SYSTEM B CITY OF RICHFIELD. MINNESOTA S.A.P. 157-363-032, LYNDALE AVENUE RECONSTRUCTION SIGNAL PLANS

POLE NOTES

C7.16

- LED LUMINAIRES SHALL BE INSTALLED ON LUMINAIRE SHAFT EXTENSIONS ON MAST ARMS 1, 2, 3 AND 4. ALL HANDHOLES SHALL BE PVC TYPE WITH METAL FRAMES AND COVERS (SEE SPECIAL PROVISIONS).
- THE CONTRACTOR SHALL INSTALL AND PROGRAM ALL APS EQUIPMENT.
 ALL PEDESTRIAN PUSHBUTTONS SHALL BE APS PUSHBUTTONS WITH SIGNS (SEE SPECIAL PROVISIONS). ONE APS PUSHBUTTON AND SIGN (LT ARROW) SHALL BE FURNISHED AND INSTALLED ON PBS-2, 4, 6 AND 8.

 ONE APS PUSHBUTTON AND SIGN (RT ARROW) SHALL BE FURNISHED AND INSTALLED ON PBS-1, 3, 5 AND 7. INTERNATIONAL SYMBOLS SHALL BE USED FOR ALL PEDESTRIAN INDICATIONS (HAND AND WALKING PERSON). ALL PEDESTRIAN INDICATIONS SHALL HAVE COUNTDOWN TIMERS (SEE SPECIAL PROVISIONS).
- ALL VEHICULAR AND PEDESTRIAN INDICATIONS SHALL USE LED TECHNOLOGY (SEE SPECIAL PROVISIONS).
- THE ENGINEER SHALL LOCATE ALL POLES AND HANDHOLES PRIOR TO ANY CONSTRUCTION. ALL SIGNAL FACES SHALL HAVE BACKGROUND SHIELDS.
- THE CONTRACTOR SHALL FURNISH AND INSTALL VIDEO CAMERAS. VIDEO CAMERAS 1, 2, 3, AND 4 SHALL BE MOUNTED ON LUMINAIRES (SEE SPECIAL PROVISIONS).
- THE CONTRACTOR SHALL RESTORE ALL DISTURBED TURF, CONCRETE OR BITUMINOUS WALK, ETC.
- TO ITS ORIGINAL CONDITION OR BETTER (SEE SPECIAL PROVISIONS).
- SEE SPECIAIL PROVISIONS FOR EMERGENCY VEHICLE PRE-EMPTION (EVP) SYSTEM, VIDEO DETECTION SYSTEM, BATTERY BACK-UP SIGNAL SERVICE CABINET, ACCESSIBLE PEDESTRIAN SIGNAL (APS), AND COUNTY FURNISHED ITEMS. COMMON BACKFILL AT SIGNAL STRUCTURES AS DIRECTED BY THE ENGINEER INCLUDED AS INCIDENTAL TO THE
- SIGNAL SYSTEM PAY ITEM.


 11) OVERHEAD MAST ARM MOUNTED TYPE "D" SIGN PANELS SHALL BE INCLUDED IN THE SIGNAL SYSTEM PAY
- ITEM (SEE SPECIAL PROVISIONS).

 12) ALL ITEMS SHOWN ARE FURNISH AND INSTALL UNLESS NOTED OTHERWISE.
- THE CONTRACTOR SHALL FURNISH AND INSTALL 2 R10-X12 (36" X 42") SIGN ADJACENT TO
- SIGNAL INDICATIONS 1-1, AND 5-1.

NOTES:

- ** INDICATES ITEMS TO BE INCLUDED IN THE EVP SYSTEM PAY ITEM.


 ** INDICATES ITEMS TO BE INCLUDED IN THE INTERCONNECT SYSTEM PAY ITEM.
- THE REMOVAL AND DISPOSAL OF THE EXISTING SIGNAL SHALL BE INCLUDED IN THE REMOVE SIGNAL SYSTEM
- A PAT TIEM.
 SALVAGE BUS STOP SIGNS (2) FROM EXISTING POLE MA-1A AND FROM EXISTING SIGN POST IN SE CORNER.
 THE CONTRACTOR SHALL INSTALL SALVAGED BUS STOP SIGNS (2), ON POLE MA-1B FACING NORTH (STOPID 3420) AND
 ON POLE MA-3B FACING SOUTH (STOPID 3363).

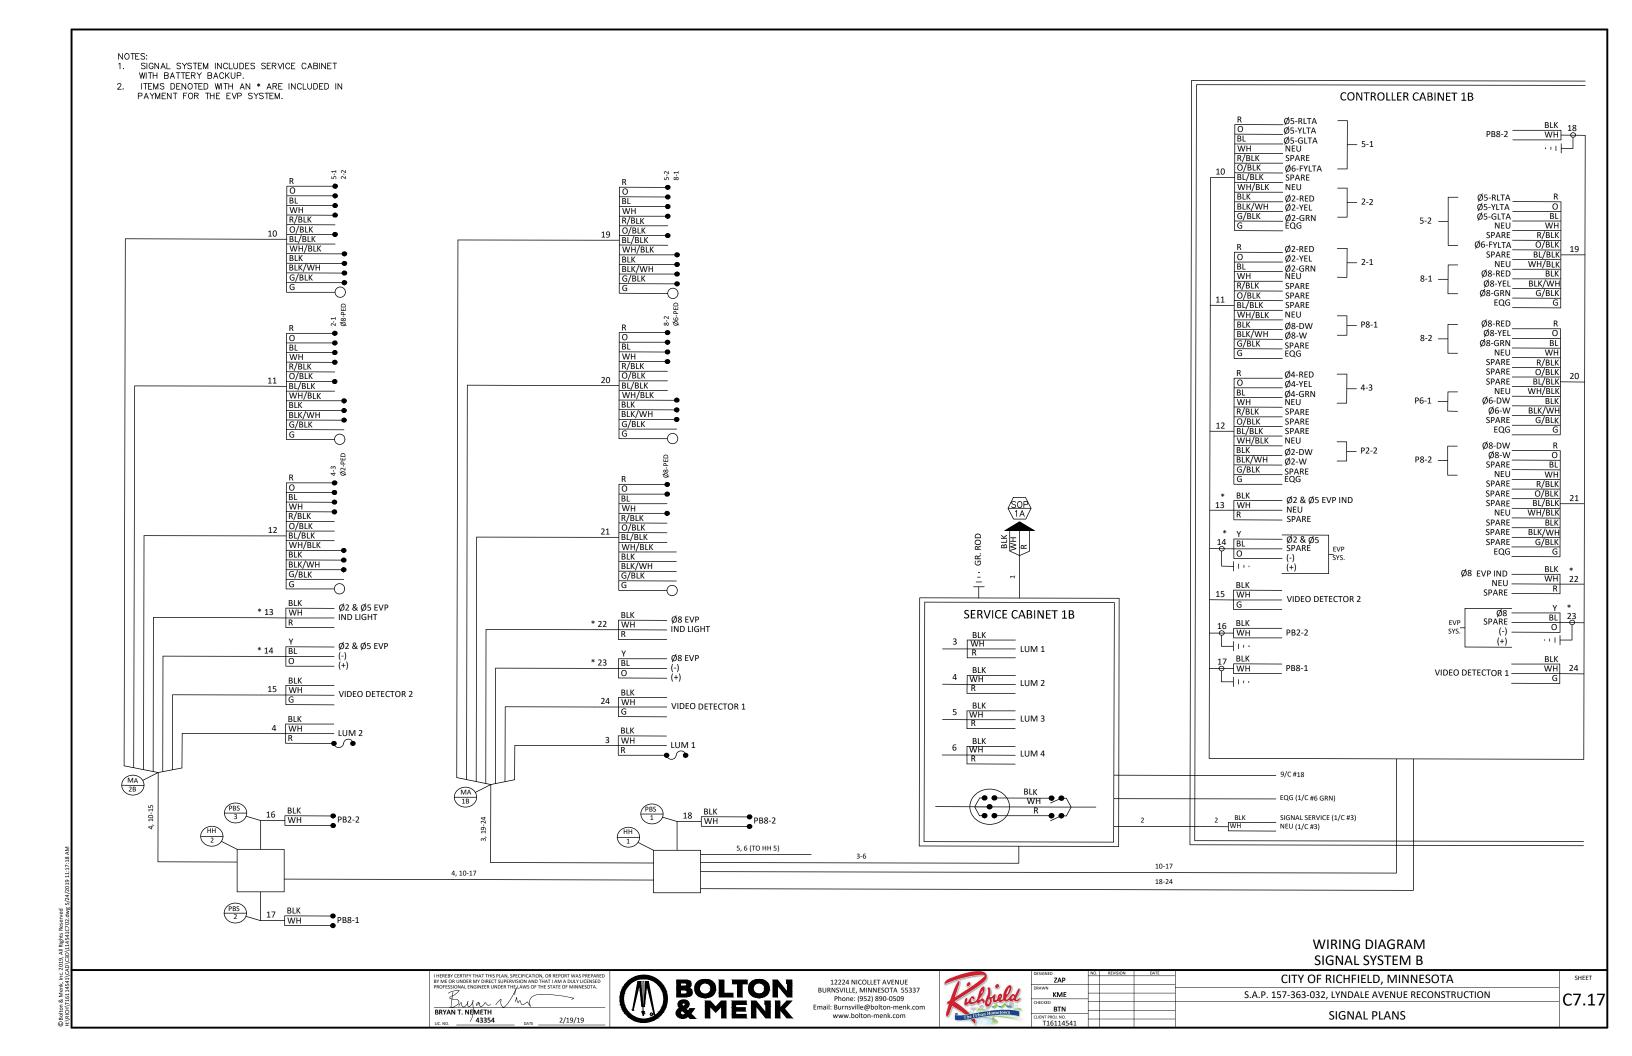



- 1. SIGNAL SYSTEM INCLUDES SERVICE CABINET
- WITH BATTERY BACKUP.

 ITEMS DENOTED WITH AN * ARE INCLUDED IN PAYMENT FOR THE EVP SYSTEM.

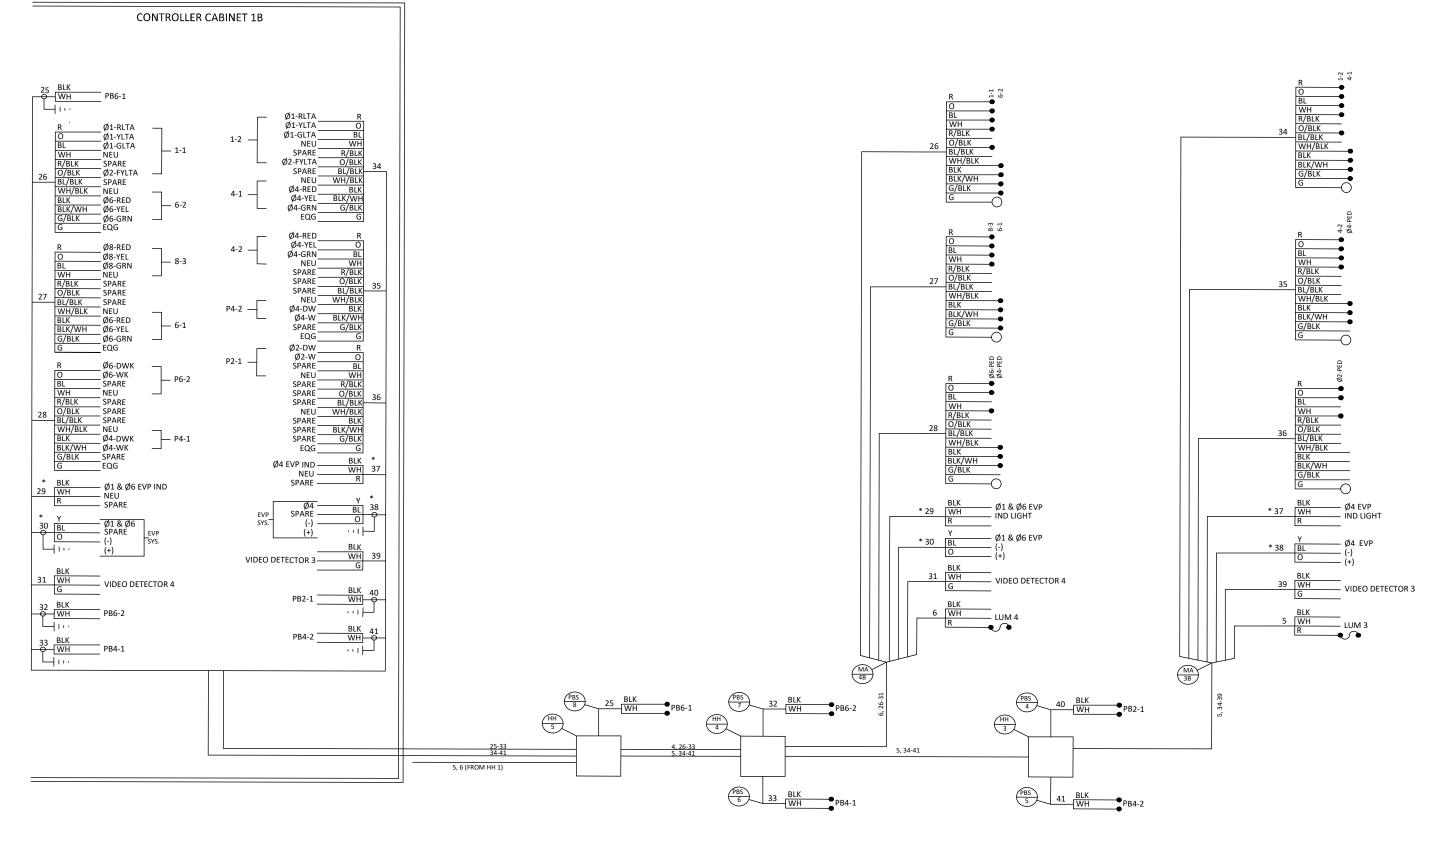

WIRING DIAGRAM SIGNAL SYSTEM B








	E
01:01	E
chould	(
The Urban Hometown	(
	1

				31311112		
DESIGNED	NO.	REVISION	DATE	CITY OF BUOLIFIED AND DESCRIP		
ZAP				CITY OF RICHFIELD, MINNESOTA	SHEET	
DRAWN				•		
KME	\vdash			S.A.P. 157-363-032, LYNDALE AVENUE RECONSTRUCTION		
CHECKED	┙			5.7.11 · 157 565 652, ETTE / TETTO E RECONSTRUCTION	(/ TXI	
BTN					[C / . ± O]	
	-			SIGNAL PLANS		
T16114541	-			SIGNAL FLANS		

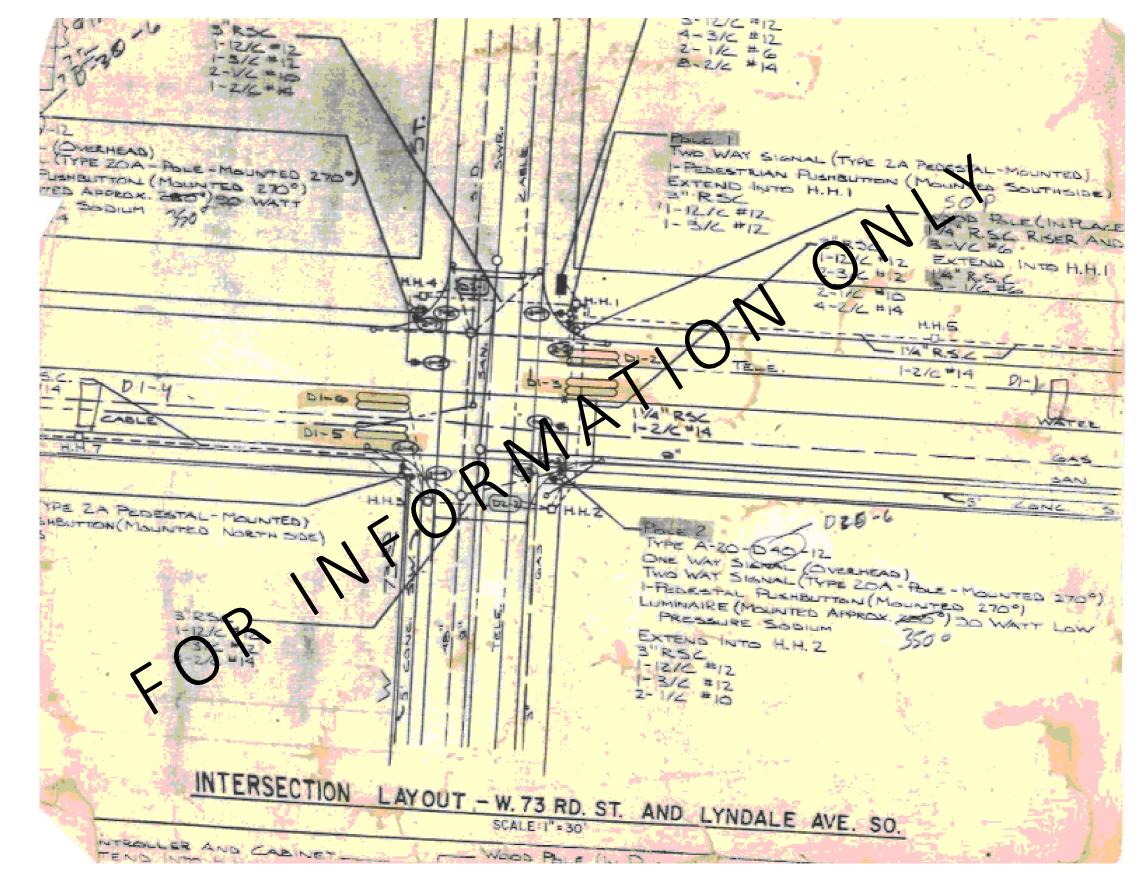


FOR INFORMATION ONLY SIGNAL SYSTEM B

BY ME DR UNDER MY DIRECT SUPERVISION AND PROFESSIONAL ENGINEER UNDER HELAWS OF THE METAL OF THE






	DESIGNED	NO.	RE
	ZAP		
4	DRAWN		
6	KME		
	CHECKED	-	
100	BTN	\vdash	
	CLIENT PROJ. NO.		
	T16114541		

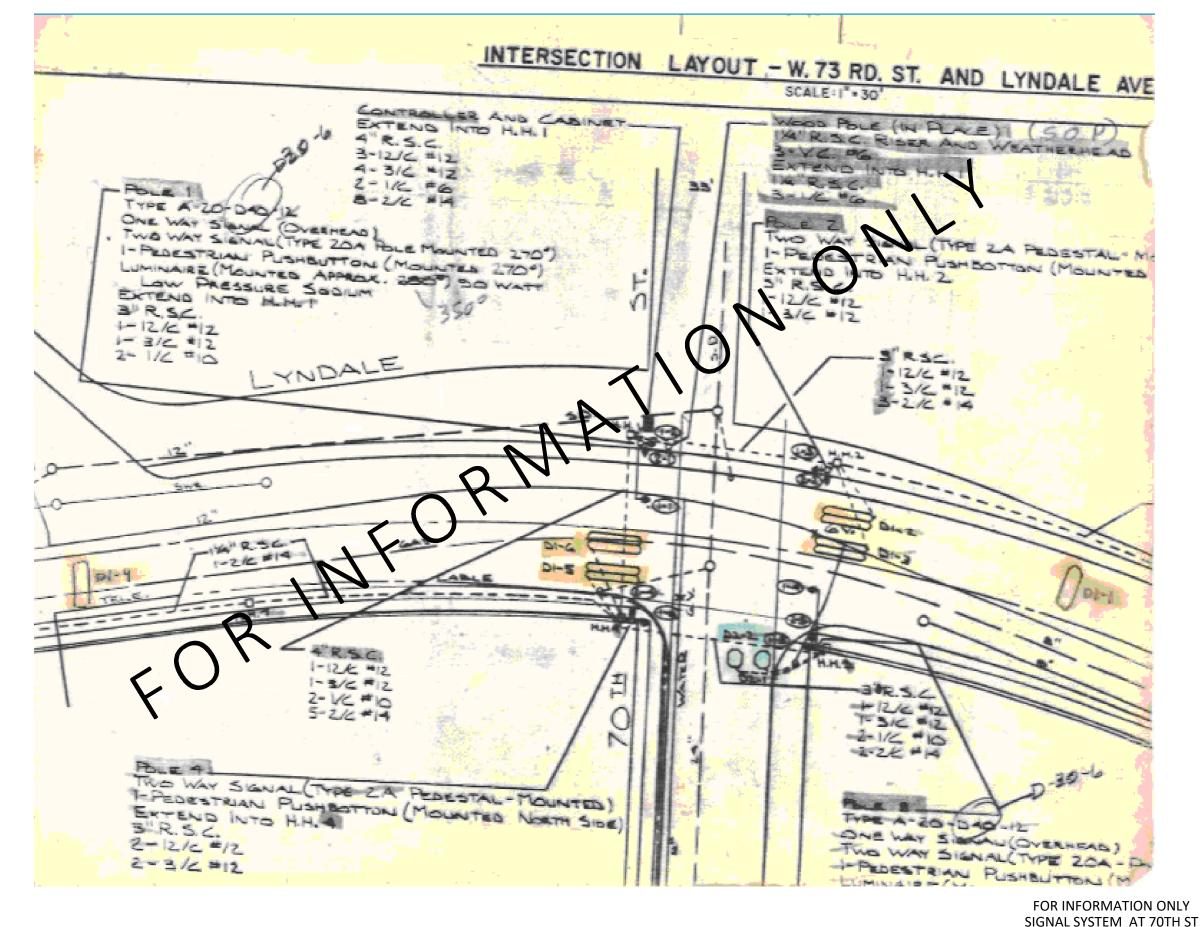

0 20 40 SCALE FEET

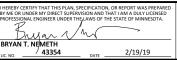



12224 NICOLLET AVENUE BURNSVILLE, MINNESOTA 55337 Phone: (952) 890-0509 Email: Burnsville@bolton-menk.com www.bolton-menk.com


		DI
Die Od	1	DI
Con Octavi		CI
The Urban Hometown	•	CI

NED	NO.	REVISION	DATE	
ZAP				
/N				
KME	-			
KED				
BTN				
	1			
T PROJ. NO.	_			

CITY OF RICHFIELD, MINNESOTA


S.A.P. 157-363-032, LYNDALE AVENUE RECONSTRUCTION


SIGNAL PLANS

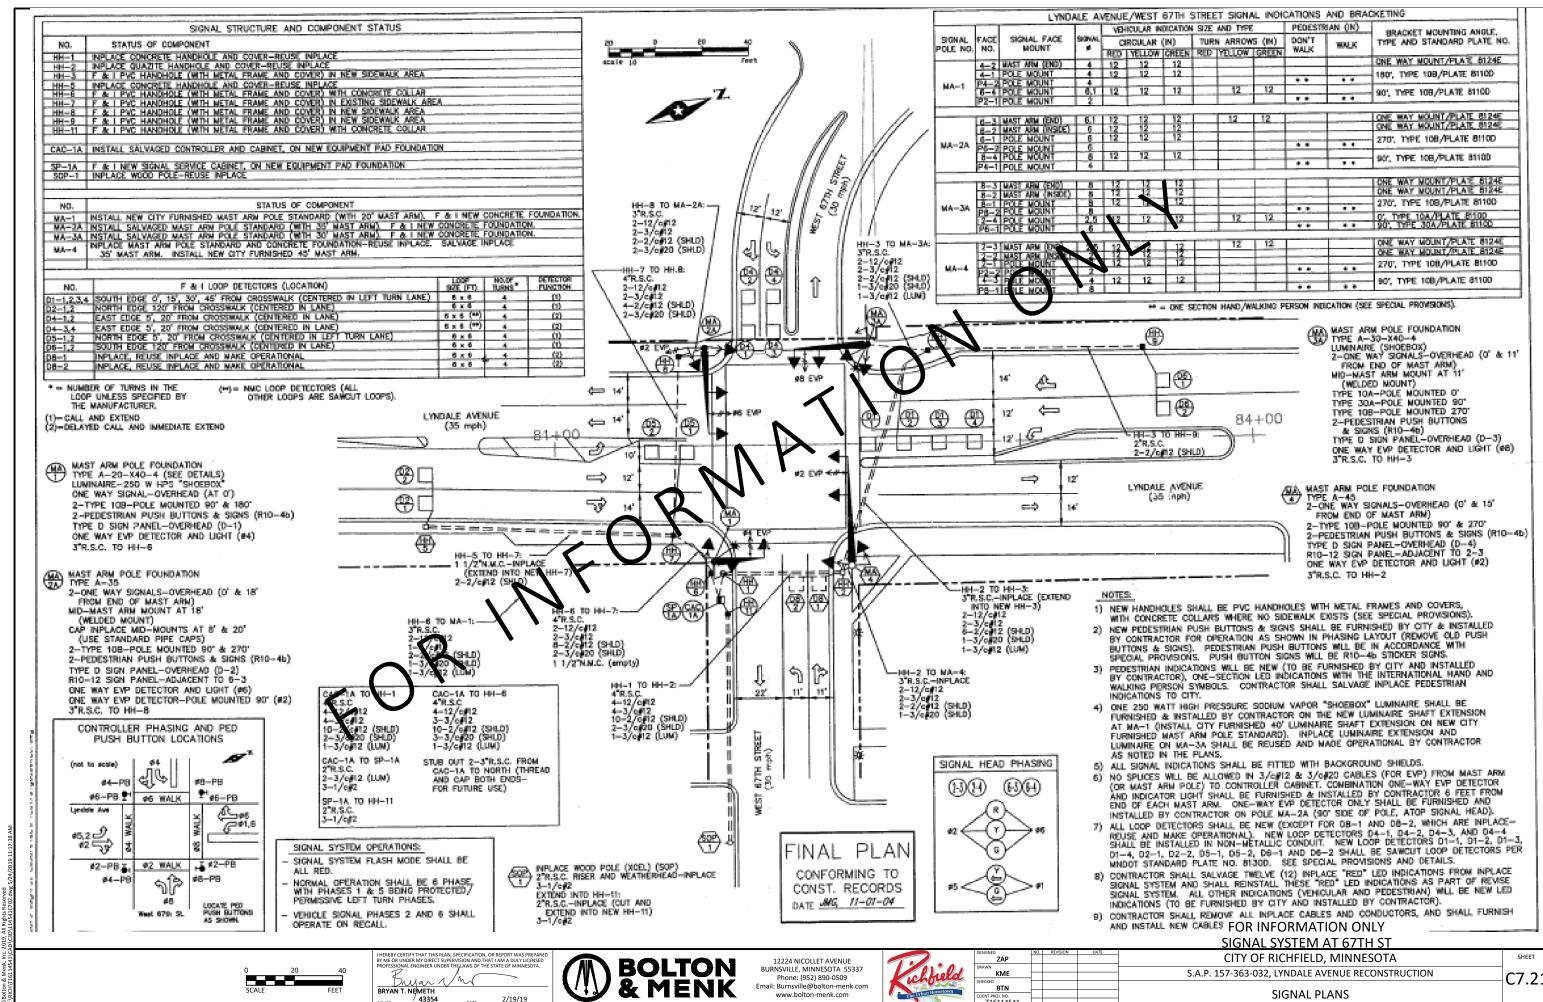



C7.21

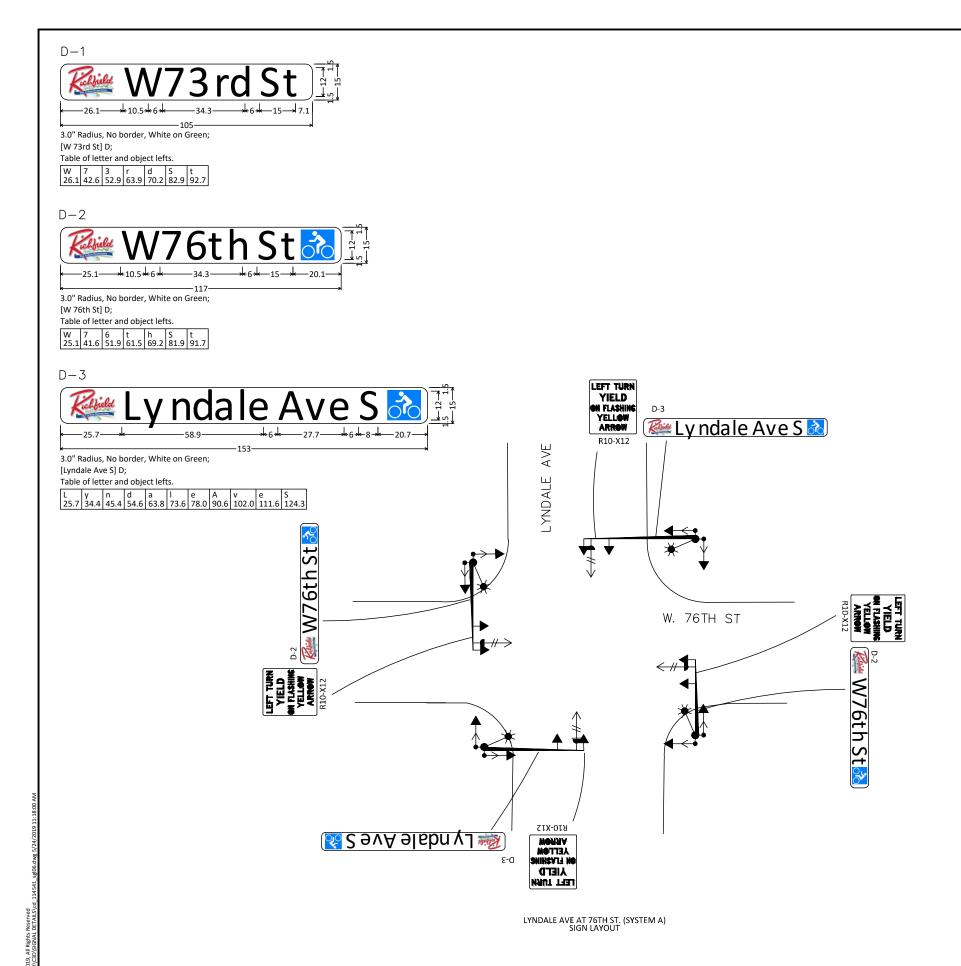

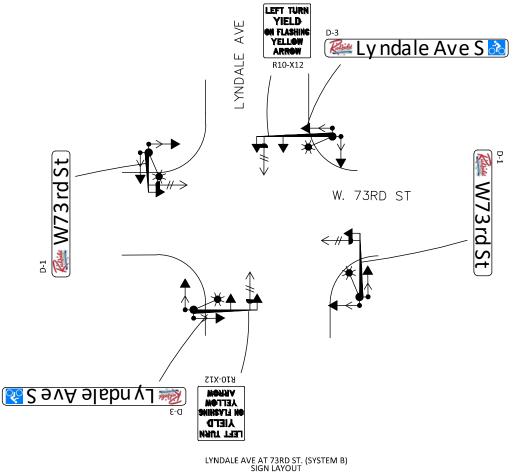

- NOTES:

 1. SEE SIGNAL PLAN DETAIL SHEET FOR SIGN MOUNTING PLATE LOCATIONS.

 2. CONTRACTOR TO COORDINATE WITH CITY OF RICHFIELD FOR CREATION OF SIGNS.

C7.22

BRYAN T. NEMETH 43354




12224 NICOLLET AVENUE BURNSVILLE, MINNESOTA 55337 Phone: (952) 890-0509 Email: Burnsville@bolton-menk.com www.bolton-menk.com




DESIGNED	NO.	REVISION	DATE	OUTY OF BUOUFIELD ASSISTED
ZAP				CITY OF RICHFIELD, MINNESOTA
DRAWN				, , , , , , , , , , , , , , , , , , , ,
KME	\vdash			S.A.P. 157-363-032, LYNDALE AVENUE RECONSTRUCTION
	- 1			3.A.I : 137-303-032, ETNOALE AVENUE RECONSTRUCTION
CHECKED				
BTN	-			CICNIAL DI ANIC
CLIENT PROJ. NO.	\vdash			SIGNAL PLANS

TYPICAL PAD WITH RURAL LIGHTING AND FLASHER CABINET


SEE INTERSECTION LAYOUT FOR CABLE INFORMATION (NOT TO SCALE)

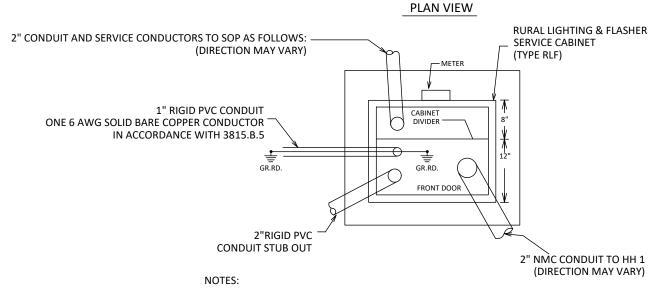


- 1. BRUSH ON ANTI-SEIZE LUBRICANT MUST BE APPLIED TO ALL ANCHOR ROD THREADS PROTRUDING ABOVE THE CONCRETE PAD BEFORE THE CABINET IS PLACED.
- 2. THE OUTER EDGE OF THE ENTIRE EQUIPMENT PAD AND CONCRETE WALK SHALL BE BEVELED OR CHAMFERED IN A NEAT MANNER AS DIRECTED BY THE ENGINEER.
- 3. THE TOP OF THE CONDUITS SHALL BE CAPPED AFTER PLACEMENT (UNTIL CABLES ARE PLACED).
- 4. CONDUIT SHALL PROJECT A MINIMUM OF 2" WITH END BELLS ABOVE THE CONCRETE AND SHALL BE LOCATED INSIDE THE CABINET WHERE DIRECTED BY THE ENGINEER, BUT SHALL NOT INTERFERE WITH THE CABINET FUNCTIONS (SUPPORTING MEMBERS, ETC.).
- 5. AFTER CONDUCTORS ARE PLACED, SEAL CONDUITS IN ACCORDANCE WITH 2565.3D.2b
- 6. SUPPLY TWO 15 FOOT LONG GROUND ROD ELECTRODES IN ACCORDANCE WITH 2545.3.R. PLACE ONE OF THE GROUND RODS IN THE EQUIPMENT PAD IN ACCORDANCE WITH 2545.3 F.3 AND THE OTHER OUTSIDE OF THE PAD WITH A MINIMUM OF 6 FEET OF SEPARATION BETWEEN ELECTRODES. BOND THE TWO GROUND RODS TOGETHER WITH ONE CONTINUOUS LENGTH UN-SPLICED CONDUCTOR FROM THE OUTER MOST GROUND ROD TO THE GROUND BUS BAR IN THE CABINET. USE NRTL LISTED CLAMPS SUITABLE FOR DIRECT BURIAL OR EXOTHERMICALLY WELD THE 6 AWG SOLID CONDUCTOR TO THE GROUND RODS. PLACE THE BONDING CONNECTION TO THE EQUIPMENT PAD GROUND ROD ABOVE THE CONCRETE. APPLY DE-OX COMPOUND TO THE GROUNDING CONNECTIONS AFTER FINAL ASSEMBLY.
- 7. CONCRETE MIX 3A32 OR EQUAL SHALL BE USED FOR THE EQUIPMENT PAD.
- 8. THE EXACT LOCATION OF CONDUITS WITHIN THE PAD SHALL BE DETERMINED BY THE ENGINEER IN THE FIELD.
- 9. ANCHOR RODS SHALL PROJECT A MINIMUM OF 3" ABOVE THE CONCRETE BUT SHALL NOT INTERFERE WITH THE CABINET FUNCTIONS (SUPPORTING MEMBERS, ETC.)
- 10. CABINET TO BE CENTERED ON THE PAD.

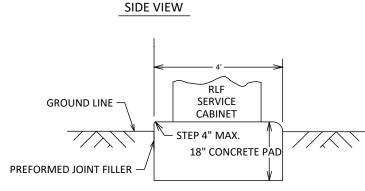

FRONT VIEW

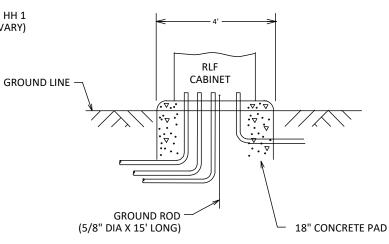

R.L.F. SERVICE CABINET **BOLT PATTERN**

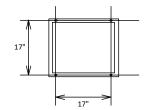


DIMENSION SHOWN ARE CENTER ROD TO CENTER ROD





79	01001
100	freld
THE STATE OF THE S	an Hometown
The Url	an Hometown

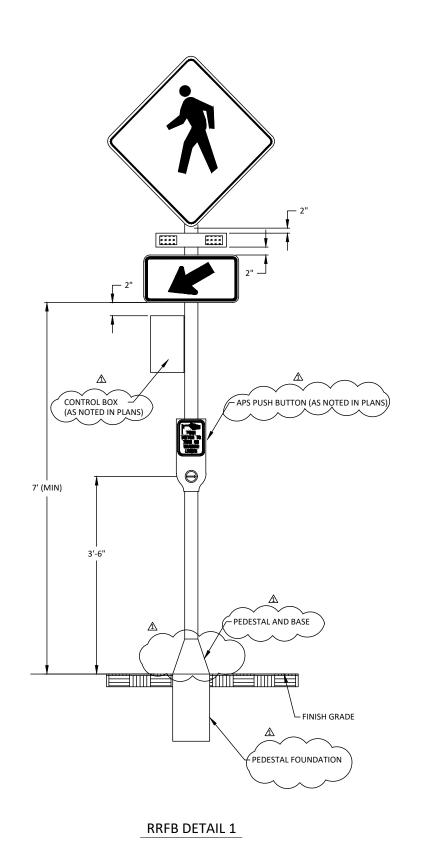

 Δ 1 OR 2 SIDED
(AS SPECIFIED IN PLANS)

 \triangle CONTROL BOX
(AS NOTED IN PLANS) APS PUSH BUTTON (AS NOTED IN PLANS) Θ 7' (MIN) 3'-6" Λ PEDESTAL AND BASE FINISH GRADE PEDESTAL FOUNDATION ⚠

RRFB DETAIL 2


BRYAN T. NEMETH
43354






	2000
	chareld
1	
	The Urban Hometown

DESIGNED ZAP	NO.	REVISION	03/15/19	CITY OF RICHFIELD, MINNESOTA	SHEET
DRAWN KME				S.A.P. 157-363-032, LYNDALE AVENUE RECONSTRUCTION	C7 24D
BTN				CICNIAL DI ANIC	C7.24N
CLIENT PROJ. NO.	-			SIGNAL PLANS	

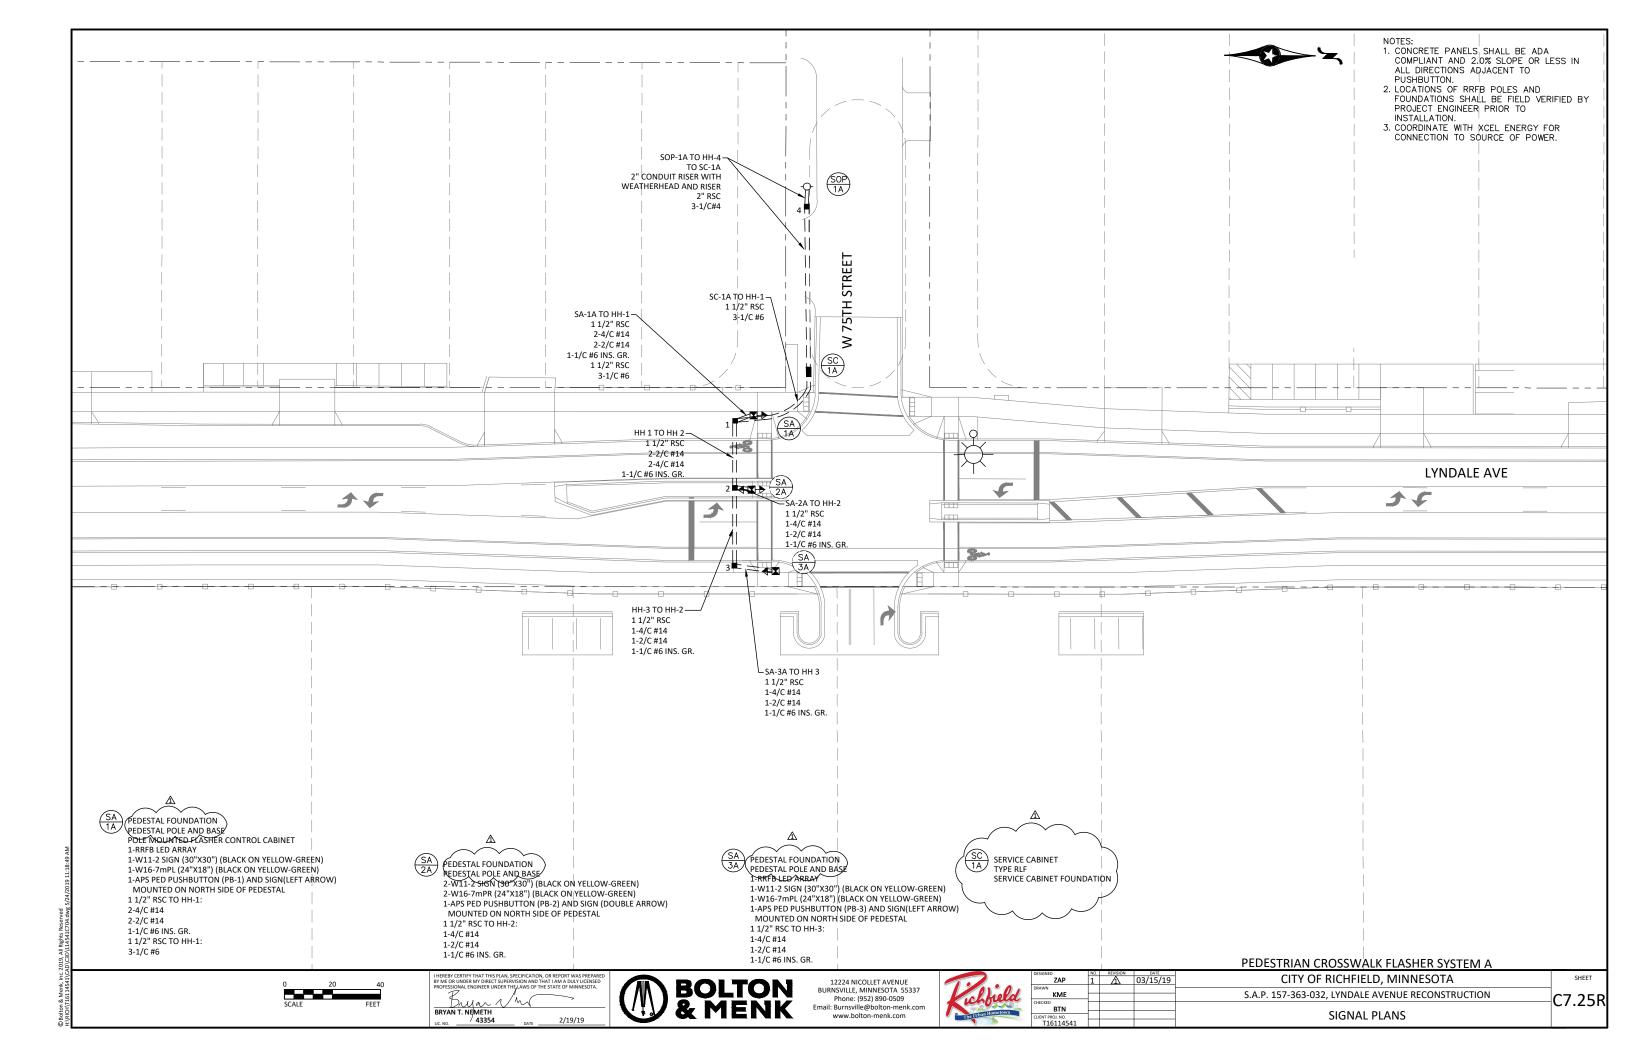

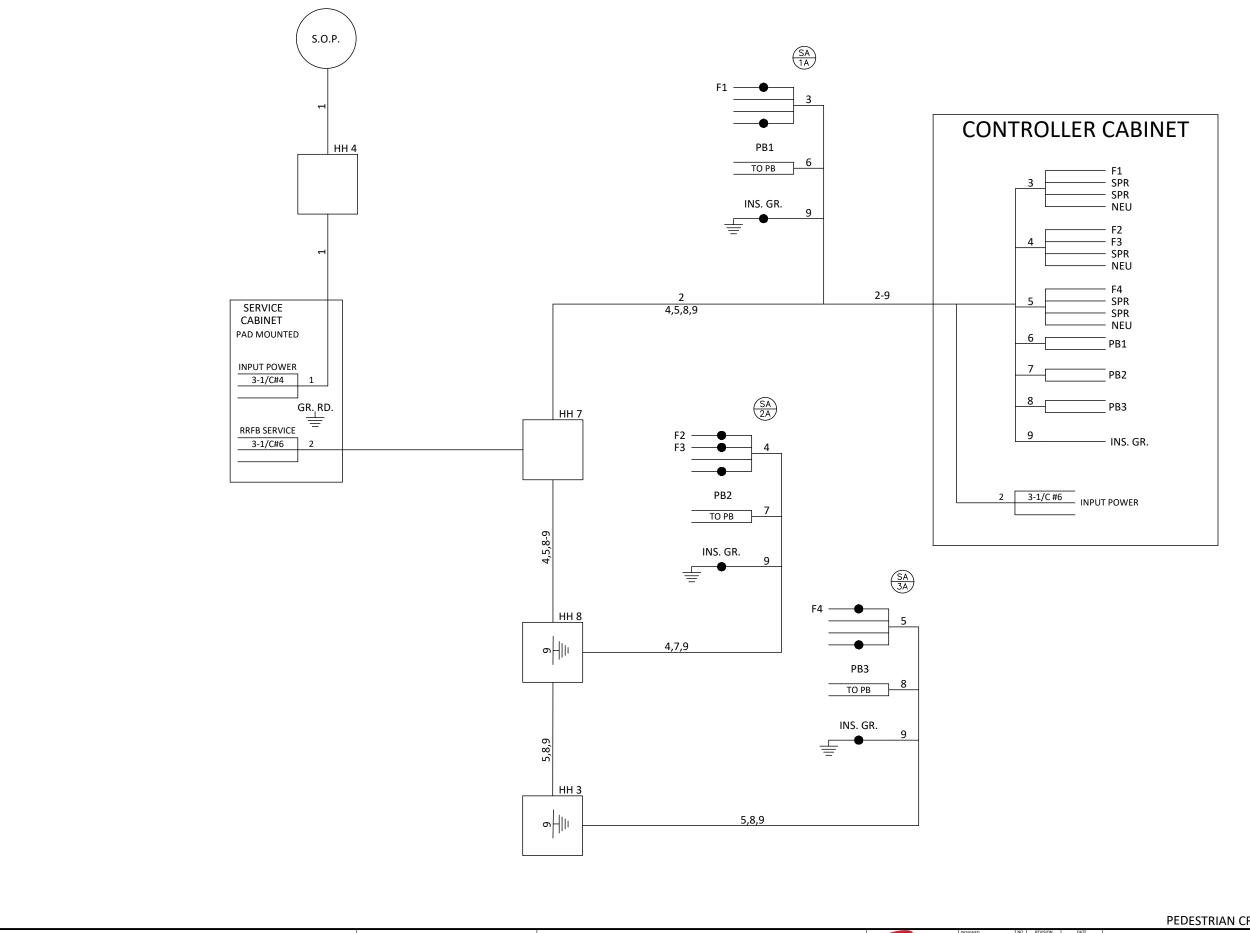


PEDESTRIAN CROSSWALK FLASHER SYSTEM A










DESIGNED	NO.	REVISION	DATE	OUTY OF BUOUFIELD A MANAGEMENT	
ZAP				CITY OF RICHFIELD, MINNESOTA	SHEET
DRAWN				· · · · · · · · · · · · · · · · · · ·	•
KME				S.A.P. 157-363-032, LYNDALE AVENUE RECONSTRUCTION	
CHECKED	Т_			5 137 565 562) 2	(/ /hl
BTN					C7.20
	-			SIGNAL PLANS	
CLIENT PROJ. NO.	\vdash			SIGNAL FLANS	

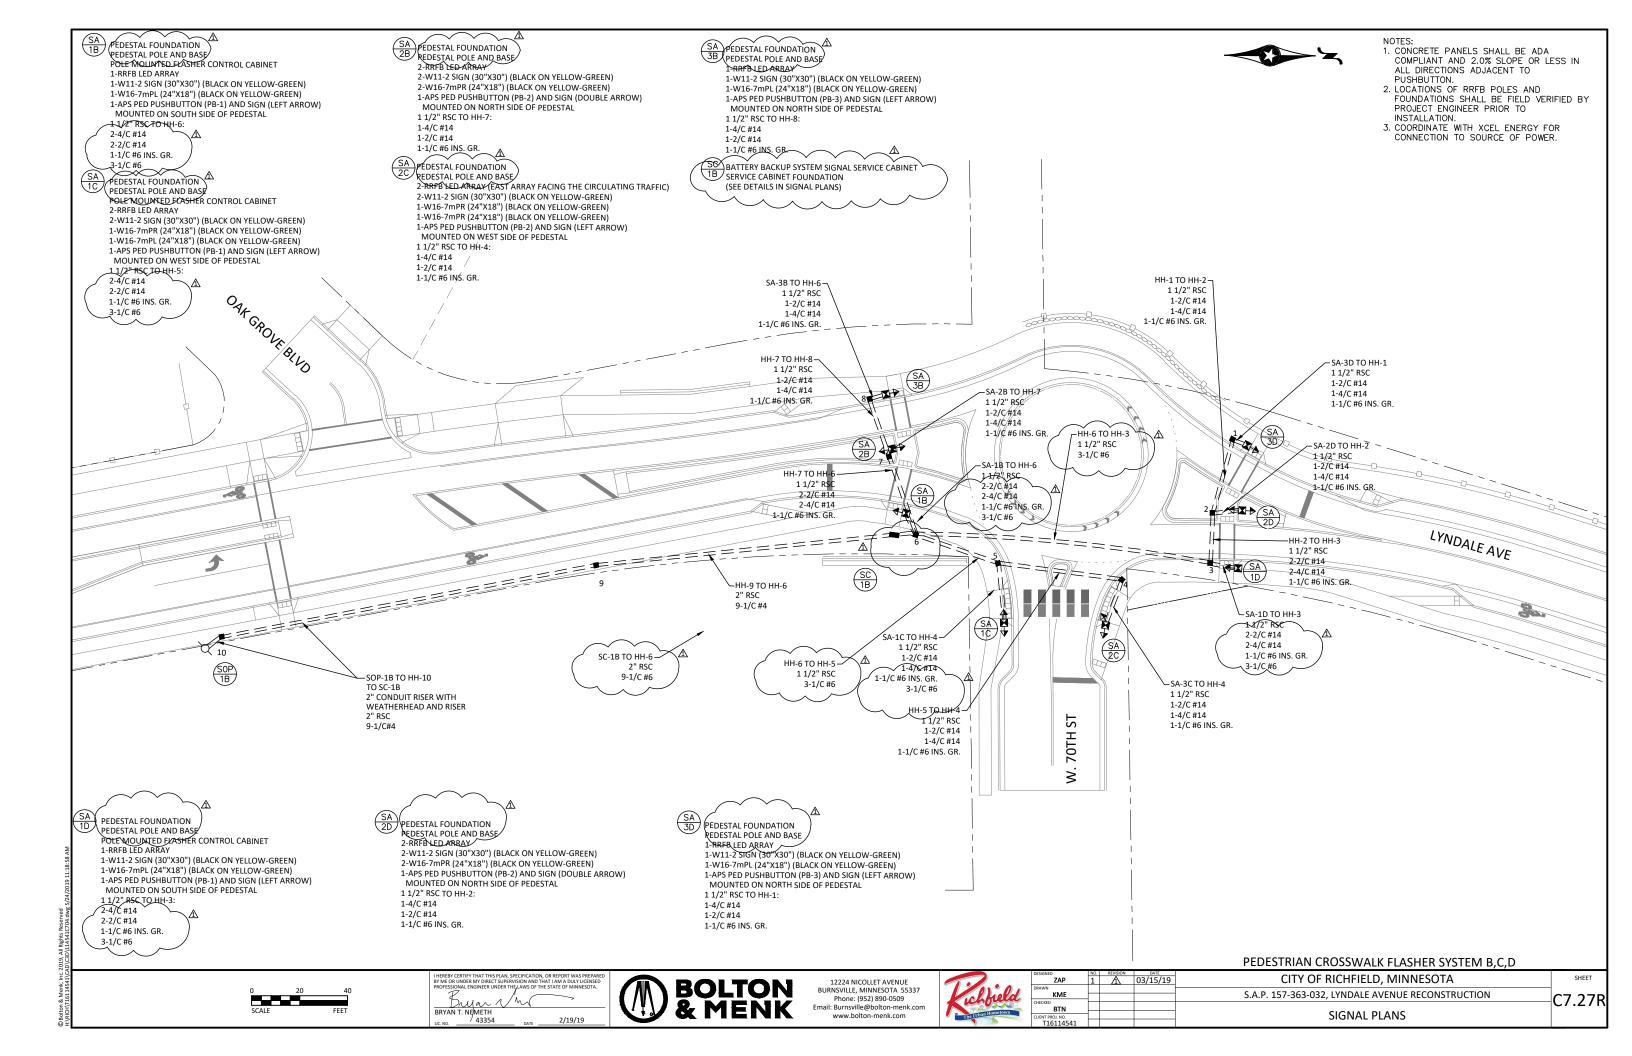

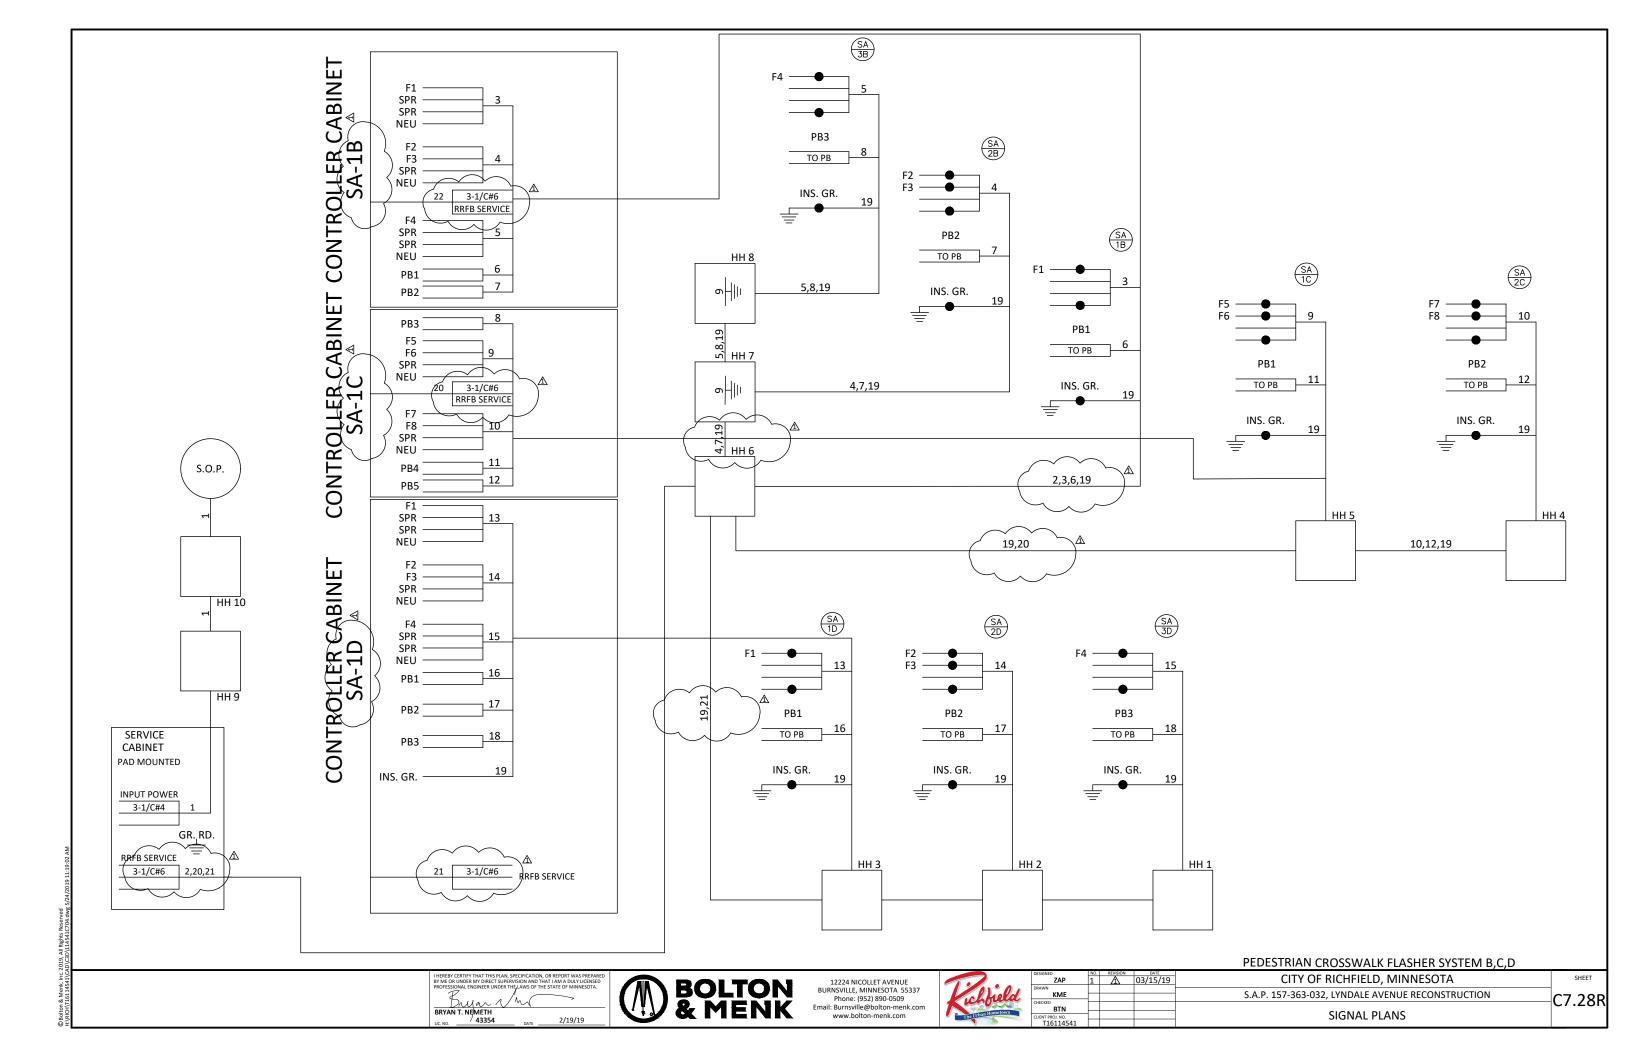

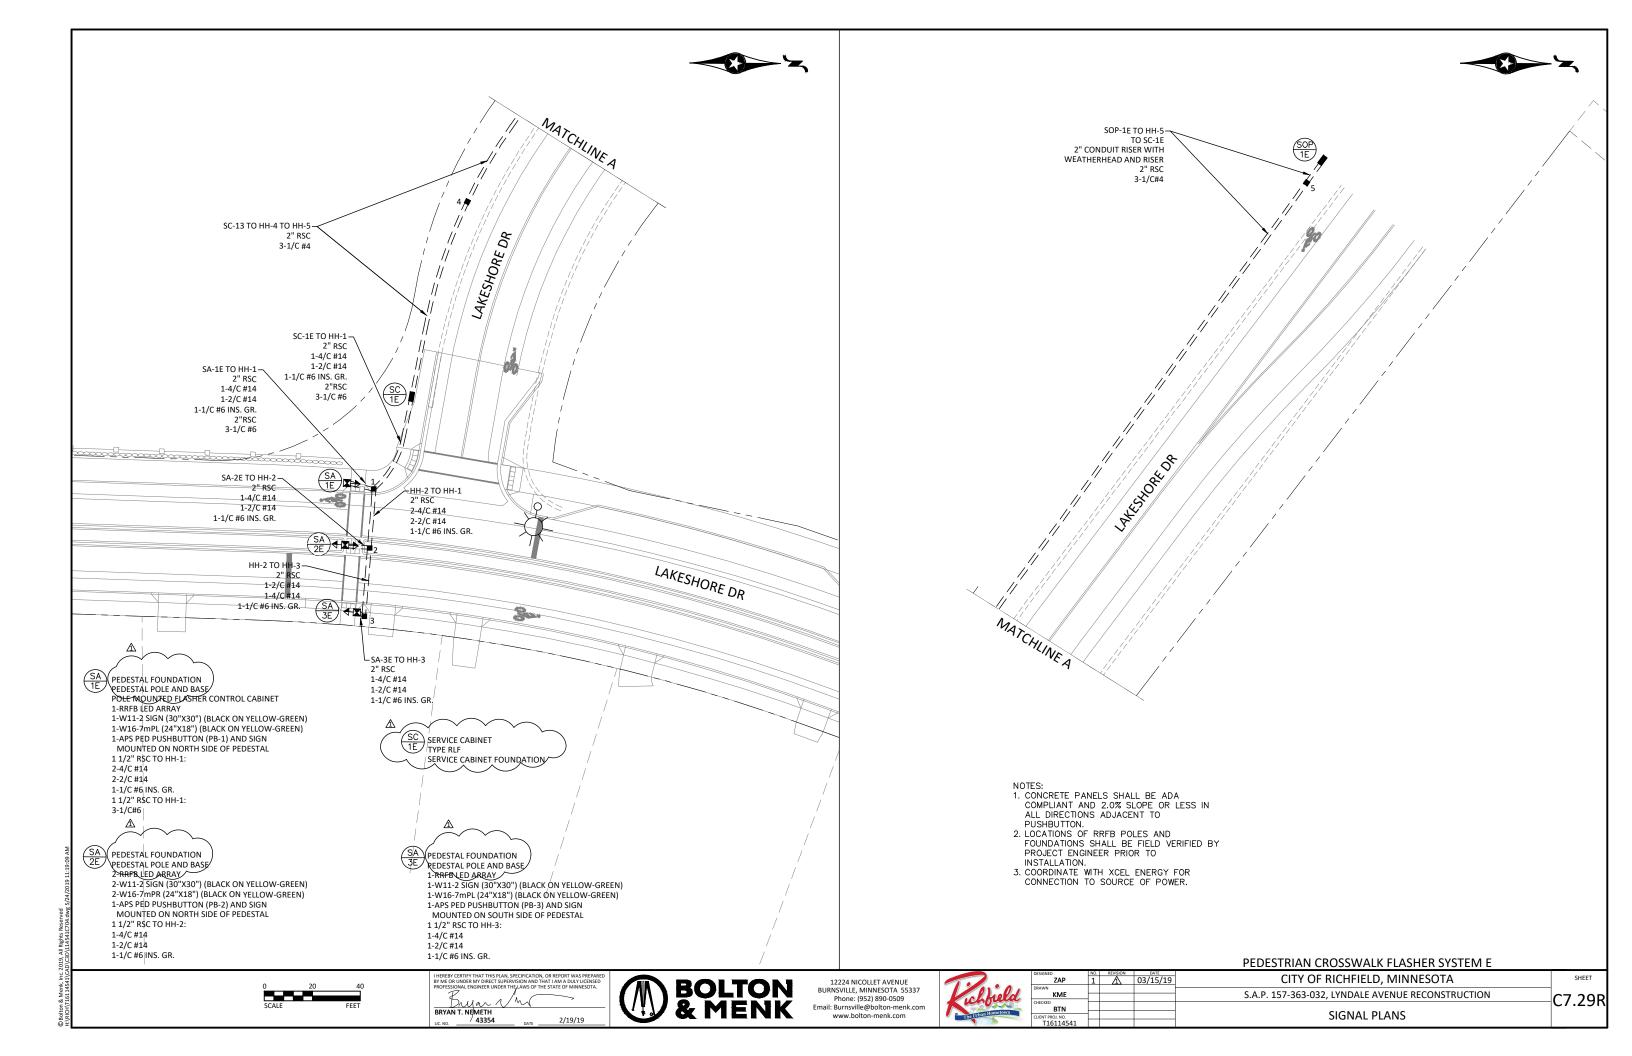

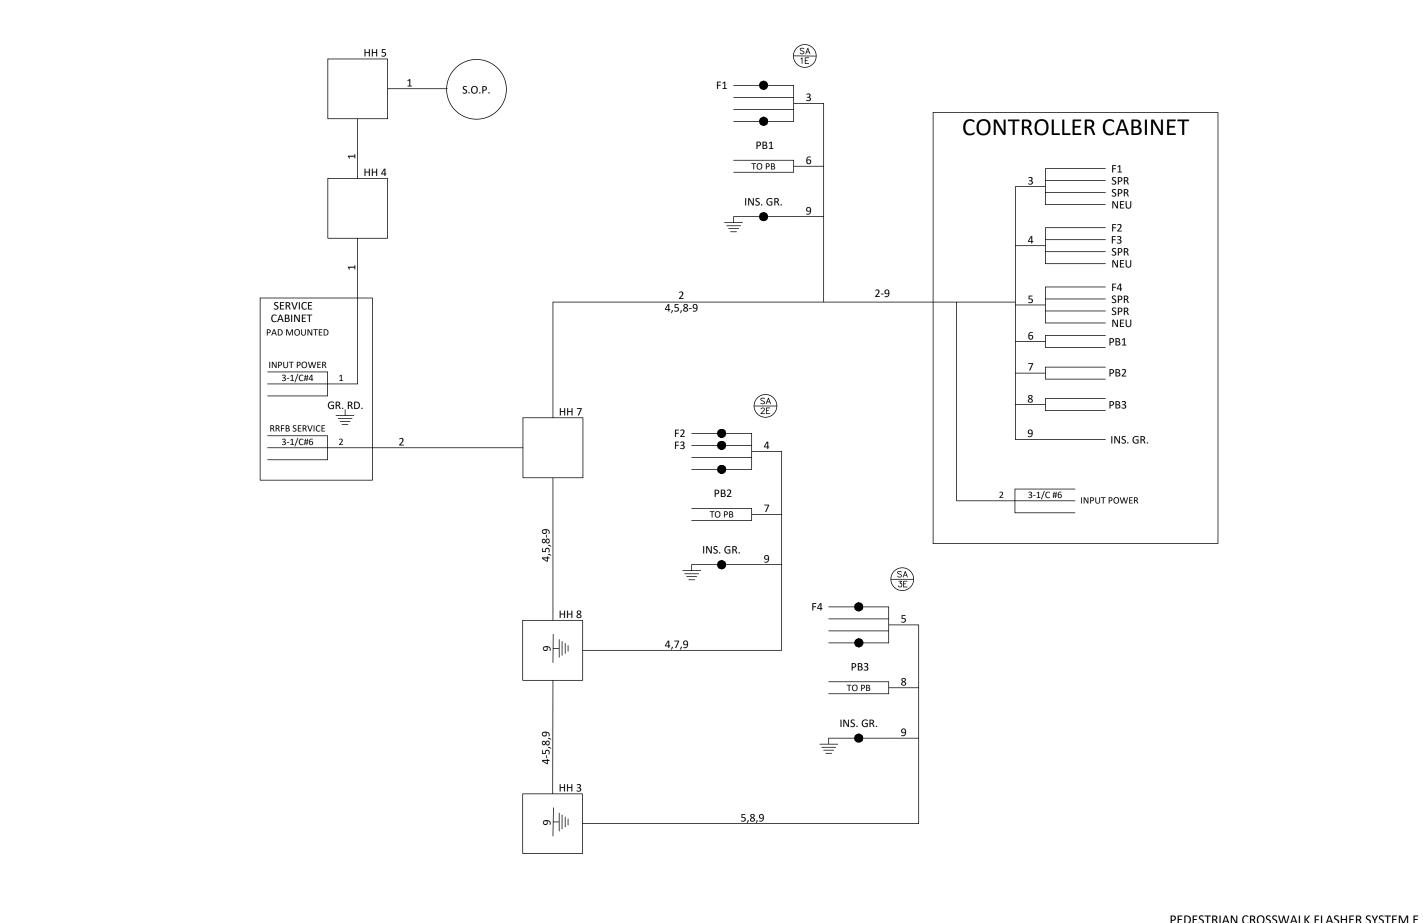

I HEBEBY CERTIFY THAT THIS PLAN, SPECIFICATION, OR REPORT WAS PREPARED BY ME OR UNDER MY DIRECT SUPERVISION AND THAT I AM A DULY LICENSED PROFESSIONAL ENGINEER UNDER THE LAWS OF THE STATE OF MINNESOTA.

BRYAN T. NEMETH


LIC. NO. 43354 DATE 2/19/19






	DESIGNED
	Z
	DRAWN
ovel.	KN
	CHECKED
metown	B
III CLOWN	CLIENT PROJ.
100	T161:

FEDESTRIAIN CROSSWALK FEASITER STSTEIN E						
DESIGNED	NO.	REVISION	DATE	CITY OF DICHFIELD AMAINECOTA		
ZAP				CITY OF RICHFIELD, MINNESOTA	SHEET	
DRAWN						
KME				S.A.P. 157-363-032, LYNDALE AVENUE RECONSTRUCTION		
CHECKED	\vdash				L/.50I	
BTN	ш					
CLIENT PROJ. NO.	1			SIGNAL PLANS		
T16114541				3.3.1.2.1.2.1.0		

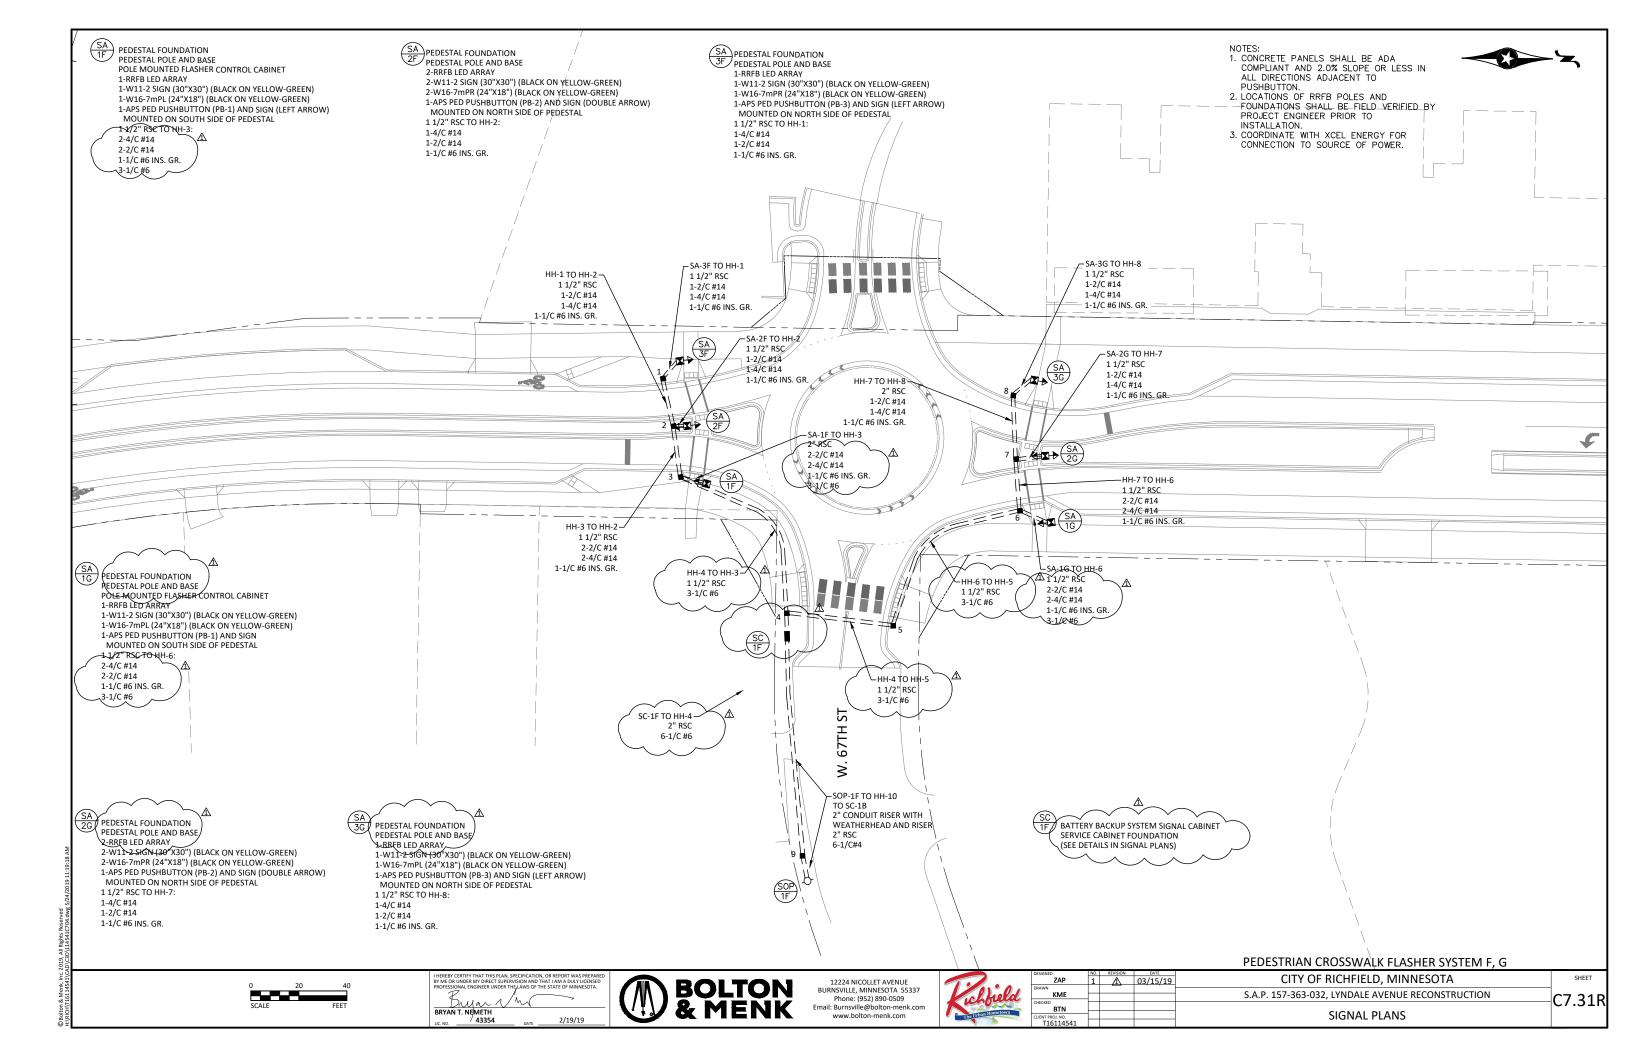

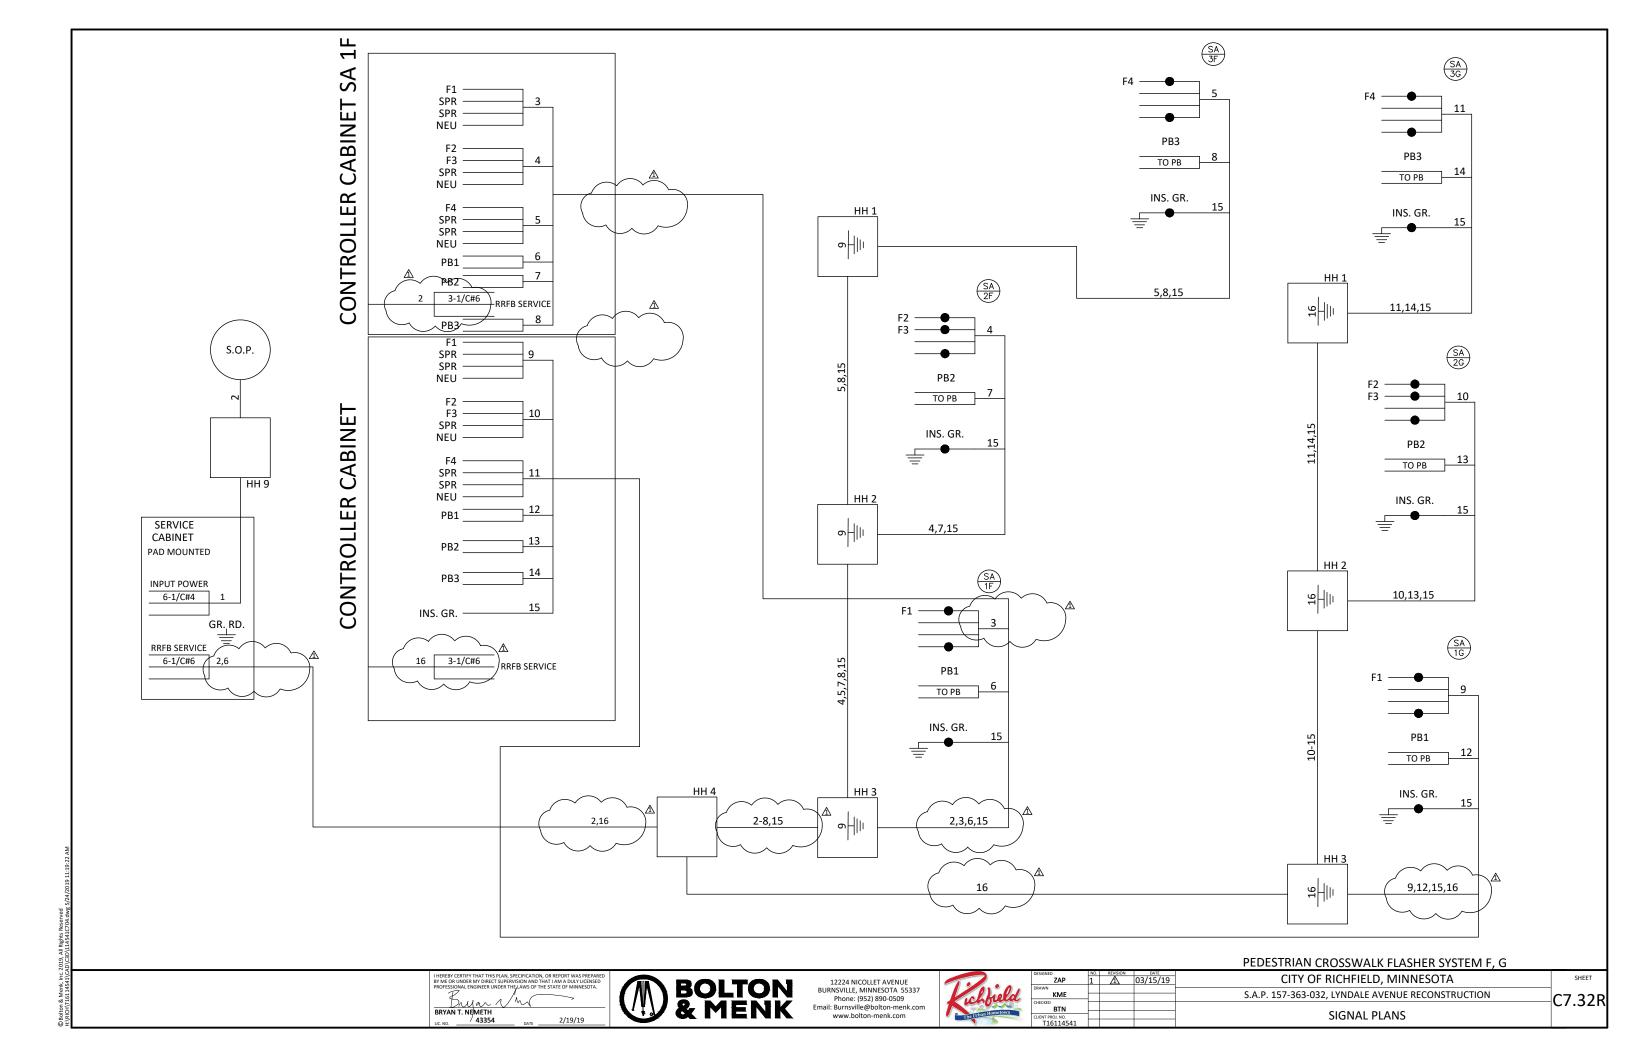

PERMANENT SIGNING AND PAVEMENT MARKING PLAN

NOTES & GUIDELINES

GENERAL INFORMATION:

THE ENGINEER'S INVOLVEMENT IN THE APPLICATION OF THE MATERIAL SHALL BE LIMITED TO FIELD CONSULTATION AND INSPECTION. THE CONTRACTOR WILL PLACE NECESSARY "SPOTTING" AT APPROPRIATE POINTS TO PROVIDE HORIZONTAL CONTROL FOR STRIPING AND TO DETERMINE NECESSARY STARTING AND CUTOFF POINTS. LONGITUDINAL JOINTS, PAVEMENT EDGES AND EXISTING MARKINGS MAY SERVE AS HORIZONTAL CONTROL WHEN SO DIRECTED.

EDGE LINES AND LANE LINES ARE TO BE BROKEN ONLY AT INTERSECTIONS WITH PUBLIC ROADS AND AT PRIVATE ENTRANCES IF THEY ARE CONTROLLED BY A AGENCY PLACED YIELD SIGN, STOP SIGN OR TRAFFIC SIGNAL. THE BREAK POINT IS TO BE AT THE START OF THE RADIUS FOR THE INTERSECTION OR AT MARKED STOP LINES OR CROSSWALKS.

A TOLERANCE OF 1/4 INCH UNDER OR 1/4 INCH OVER THE SPECIFIED WIDTH WILL BE ALLOWED FOR STRIPING PROVIDED THE VARIATION IS GRADUAL AND DOES NOT DETRACT FROM THE GENERAL APPEARANCE. BROKEN LINE SEGMENTS MAY VARY UP TO 3 INCHES FROM THE SPECIFIED LENGTHS PROVIDED THE OVER AND UNDER VARIATIONS ARE REASONABLY COMPENSATORY. ALIGNMENT DEVIATIONS FROM THE CONTROL GUIDE SHALL NOT EXCEED 1 INCH. MATERIAL SHALL NOT BE APPLIED OVER LONGITUDINAL JOINTS. ESTABLISHMENT OF APPLICATION TOLERANCES SHALL NOT RELIEVE THE CONTRACTOR OF THEIR RESPONSIBILITY TO COMPLY AS CLOSELY AS PRACTICABLE WITH THE PLANNED DIMENSIONS.

JUST PRIOR TO THE PLACEMENT OF PAVEMENT MARKINGS THE ROAD SURFACE SHALL BE CLEANED AND FREE OF CONTAMINATION AS RECOMMENDED BY THE MATERIAL MANUFACTURER AND ACCEPTABLE TO THE ENGINEER, PORTLAND CEMENT CONCRETE SURFACES SHALL BE SANDBLAST CLEANED TO REMOVE ANY SURFACE TREATMENTS AND/OR LAITANCE.

APPLY ALL PAVEMENT MARKINGS AS RECOMMENDED BY THE MATERIAL MANUFACTURER.

PERMANENT PAVEMENT MARKINGS SHALL NOT BE PLACED OVER TEMPORARY TAPE MARKINGS.

THE FILLING OF TANKS, POURING OF MATERIALS OR CLEANING OF EQUIPMENT SHALL NOT BE PERFORMED ON UNPROTECTED PAVEMENT SURFACES UNLESS ADEQUATE PROVISIONS ARE MADE TO PREVENT SPILLAGE OF MATERIAL.

REFER TO SPECIAL PROVISIONS OR SPEC BOOK FOR GROUND IN/RECESSED PAVEMENT MARKING APPLICATION REQUIREMENTS.

MULTI-COMPONENT LIQUID:

THE ROAD SURFACE SHALL BE CLEANED AT THE DIRECTION OF THE ENGINEER JUST PRIOR TO APPLICATION. PAVEMENT CLEANING SHALL CONSIST OF AT LEAST BRUSHING WITH A ROTARY BROOM (NON-METALLIC) OR AS RECOMMENDED BY THE MATERIAL MANUFACTURER AND ACCEPTABLE TO THE ENGINEER. NEW PORTLAND CEMENT CONCRETE SURFACES SHALL BE SANDBLAST CLEANED TO REMOVE ANY SURFACE TREATMENTS AND/OR LAITANCE.

THE MULTI-COMPONENT MARKING APPLICATION SHALL IMMEDIATELY FOLLOW THE PAVEMENT CLEANING. GLASS BEADS SHALL BE APPLIED IMMEDIATELY AFTER APPLICATION OF THE MULTI-COMPONENT LIQUID PAVEMENT MARKING.

APPLY MULTI-COMPONENT LIQUID MARKINGS WITH A MINIMUM THICKNESS OF 20 MILS, GLASS BEADS SHALL BE APPLIED AT A RATE OF AT LEAST 25 LB/GAL. THE "NO-TRACKING" CONDITION SHALL BE DETERMINED ON AN APPLICATION OF SPECIFIED THICKNESS TO THE PAVEMENT AND COVERED WITH GLASS BEADS AT THE RATE OF AT LEAST 25 LB/GAL

PAVEMENT MARKINGS SHALL ONLY BE APPLIED IN SEASONABLE WEATHER WHEN AIR AND PAVEMENT SURFACE TEMPERATURES ARE 40° F OR HIGHER AND SHALL NOT BE APPLIED WHEN THE WIND OR OTHER CONDITIONS CAUSE A FILM OF DUST TO BE DEPOSITED ON THE PAVEMENT SURFACE AFTER CLEANING AND BEFORE THE MARKING MATERIAL CAN BE APPLIED.

PAINT:

GLASS BEADS SHALL BE APPLIED AT A RATE OF AT LEAST 8 LBS/GAL IMMEDIATELY AFTER APPLICATION OF THE PAINT LINE.

PAVEMENT MARKINGS SHALL ONLY BE APPLIED IN SEASONABLE WEATHER WHEN AIR AND PAVEMENT SURFACE TEMPERATURES IS 50°F OR HIGHER AND SHALL NOT BE APPLIED WHEN THE WIND OR OTHER CONDITIONS CAUSE A FILM OF DUST TO BE DEPOSITED ON THE PAVEMENT SURFACE AFTER CLEANING AND BEFORE THE MARKING MATERIAL CAN BE APPLIED.

PERMANENT SIGNING AND PAVEMENT MARKING PLAN INDEX

C7.33 TITLE SHEET

C7.34 SIGNING AND STRIPING TABULATIONS

C7.35-C7.47 STANDARD DETAILS

C7.48-C7.55 SIGNING AND STRIPING LAYOUT

SYMBOLS & MATERIALS LEGEND

CROSSWALK BLOCK WHITE PREFORM THERMOPLASTIC (GROUND IN)



CROSSWALK BLOCK GREEN PREFORM THERMOPLASTIC (GROUND IN)



PAVEMENT MESSAGE (LT ARROW) WHITE PREFORM THERMOPLASTIC (GROUND IN)



PAVEMENT MESSAGE (RT ARROW) WHITE PREFORM THERMOPLASTIC (GROUND IN)




PAVEMENT MESSAGE (TRHU/LT ARROW) WHITE PREFORM THERMOPLASTIC (GROUND IN)



PAVEMENT MESSAGE WHITE CENTERED ON A BLACK RECTANGULAR BACKGROUND PREFORM THERMOPLASTIC (GROUND IN)

STRIPING KEY

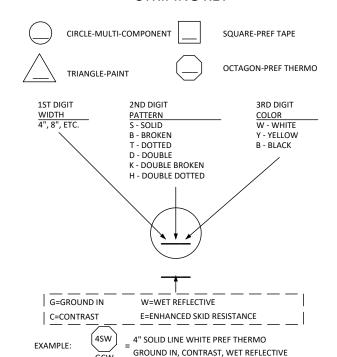

I HEREBY CERTIFY THAT SHEETS C7.33 THROUGH C7.55 OF THIS PLAN WERE PREPARED BY ME OR UNDER MY DIRECT SUPERVISION AND THAT I AM A DULY LICENSED

PRINT NAME: BRYAN T. NEMETH

LICENSE # ,43354

DATE: 01/11/2019

SIGNATURE:

C7.33

DESIGNER: ZAP

CITY OF RICHFIELD. MINNESOTA

S.A.P. 157-363-032, LYNDALE AVENUE RECONSTRUCTION SIGNING AND

SALVAGE & INST	ALL SIGN TY	PE SPECIAL
SIGN	QUANTITY	DESCRIPTION
NUMBER		
	EACH	
S-201	12	METRO BUS STOP
S-202	1	NEIGHBORHOOD CRIME WATCH
TOTALS	13	

OBJECT MARKER							
CODE	SIZE	SIZE COLOR					
NUMBER	INCH	COLOR	EACH				
X4-4R	12 X 36	BLACK ON YELLOW	24				
X4-2	18 X 18	YELLOW ON BLACK	25				

		P	OST		SI	GN PANI	ELS			
SIGN	QUANTITY	NO.	LENGTH	MTG. HT.		SIZE		AREA	TOTAL AREA	PANEL
NUMBER	(2)	AND		(3) (4)	1					LEGEND
	EACH	TYPE	(FT)	(FT)		(IN)		(SQ FT)	(SQ FT)	
S-1	22	18	19	9	9	Х	69	4.31	94.88	LYNDALE AVE S W/ BIKE
S-2	2	1S	16	9	12	X	40	3.33	6.67	W 75TH ST
S-3	2	1S	16	9	12	X	40	3.33	6.67	W 74TH ST
S-4	2			9	12	Х	40	3.33	6.67	W 72ND ST
S-5	4	18	16	9	12	Х	40	3.33	13.33	W 71ST ST
S-6	2	18	17	9	12	Х	48	4.00	8.00	OAK GROVE BLVD
S-7	4	1S	16	9	12	Х	40	3.33	13.33	W 70TH ST W/ BIKE
S-8	2	18	16	9	12	Х	40	3.33	6.67	W 69TH ST
S-9	4	18	16	9	12	Х	40	3.33	13.33	W 68TH ST
S-10	2	18	17	9	12	Х	48	4.00	8.00	LAKESHORE DR W/ BIKE
S-11	4	18	16	9	12	Х	40	3.33	13.33	W 67TH ST
S-12	2	1S	17	9	24	Х	50	8.33	16.67	VFW DELIVERY
S-13	2	18	19	9	9	Х	69	4.31	8.63	LYNDALE AVE S W/ BIKE
								TOTALS	216.17	

BRYAN T. NEMETH 43354

NOTES:

- (2) QUANTITIES ARE DOUBLED FOR BACK TO BACK SIGNS.
- (3) SEE SIGN SHEET C7.37 -C7.38 FOR MOUNTING DETAILS.
- (4) MOUNTING HEIGHT IS MINIMUM.
- (5) MOUNT ON LIGHT POLE

GENERAL NOTES:

- 1. POST LENGTHS ARE APPROXIMATE AND INCLUDE EMBEDMENT, BUT DO NO INCLUDE ADDITIONAL LENGTH REQUIRED FOR SPLICE.
- 2. SEE SIGNING DETAIL SHEETS FOR STRUCTURAL DETAILS.
- 3. SEE STANDARD SIGNS MANUAL FOR PUNCHING CODE AND DETAILED DRAWINGS OF TYPE C SIGN PANELS.
- 4. FOR MOUNTING DETAILS, SEE SIGNING DETAIL SHEETS.

			SIG	N PANEL	S TYP	E C	;					A
			POST		MTG.	SIG	N PAN	ELS				
SIGN NUMBER	QUANTITY	NO. AND TYPE	KNEE BRACES	LENGTH	HT. (1)		SIZE		AREA	TOTAL AREA	PANEL CODE NUMBER	DESCRIPTION
	EACH		EACH	(FT)	(FT)		(IN)		(SQ FT)	(SQ FT)		
C-1		2S			7						X4-4R	OBJECT MARKER
	24		1	16		24	Х	30	5.00	120.00	R4-7	KEEP RIGHT
	1										X4-2	OBJECT MARKER
C-2		2S			7	36	Х	12	3.00	3.00	R6-1R	ONE WAY RIGHT
	1		1	13		36	Х	12	3.00	3.00	R6-1R	ONE WAY RIGHT
C-3	11	18	1	14	7	12	Х	18	1.50	16.50	R7-9a	NO PARKING BIKE LANE
C-4	2				7	24	Х	30	5.00	10.00	R2-1	SPEED LIMIT 35
C-5	3	2U	1	14	7	24	Х	36	6.00	18.00	R3-9b	CENTER LEFT TURN LANE
C-6	2	1U	1	12	7	24	Х	18	3.00	6.00	R3-17	BIKE LANE
C-7	7	2U-1A	1	14	7	36	Х	36	9.00	63.00	R1-5bL	STOP HERE FOR PEDESTRIANS
C-8	9	2S	1	13	7	30	Х	30	6.25	56.25	R1-1	STOP
C-9	2	2S	1	13	7	30	Х	30	6.25	12.50	R5-1	DO NOT ENTER
C-10	5	1S	1	13	7	24	Х	18	3.00	15.00	R3-17	BIKE LANE
C-10		13			,	24	Х	8	1.33	6.67	R3-17bP	ENDS
C-11	1	2S	1	13	7	24	Х	30	5.00	5.00	R2-1	SPEED LIMIT 35
	9	2S		17		36	X	12	3.00	27.00	W16-17P	ROUNDABOUT PLAQUE
C-12			1		7	30	Х	30	6.25	56.25	W2-6a	ROUNDABOUT
						18	Х	18	2.25	20.25	W13-1P	15 MPH
C-13	7				7	24	Х	36	6.00	42.00	R3-9b	CENTER LEFT TURN LANE
C-14	2				7	36	Х	36	9.00	18.00	R1-5bL	STOP HERE FOR PEDESTRIANS
C-15	19	2S	1	11	7	36 X 36 X 36			4.50	85.50	R1-2	YIELD
						30	Х	30	6.25	118.75	W2-6a	ROUNDABOUT
C-16	10	28	1	14	7	12	Х	36	3.00	30.00	R1-6a	STATE LAW STOP FOR PED
C-17	1				7	12	Х	18	1.50	1.50	R7-9a	NO PARKING BIKE LANE
C-18	3	2S	1	12	7	36	Х	12	3.00	9.00	R6-1R	ONE WAY RIGHT
C-19	1	1s	1	13	7	24	Х	18	3.00	3.00	R3-17	BIKE LANE
		1 -5		1 2		24	Х	8	1.33	1.33	R3-17aP	AHEAD
C-20	1	2S	1	13	7	24	Х	30	5.00	5.00	R4-7	KEEP RIGHT
		25		10							X4-2	OBJECT MARKER
C-21	1	1s	1	14	7	24	X	12	2.00	2.00	R3-9dP	END
O 21		10		1-1		24	X	24	4.00	4.00	R8-3	NO PARKING
C-22	1	1s	1	14	7	24	X	12	2.00	2.00	R3-9cP	BEGIN
U 22		10		1.1		24	X	24	4.00	4.00	R8-3	NO PARKING
-23									11.25	11.25	W4-2R	MERGE LEFT
-24	1	28	1	12	7	36	Х	12	3.00	3.00	R3-8ACA	LEFT THRU RIGHT ARROW

NOTES:

(1) MOUNTING HEIGHT IS MINIMUM. SEE SIGNING DETAIL SHEEET FOR TYPICAL MOUNTING.

(2) SEE OBJECT MARKER TABULATIO

(3) MOUNT BACK TO BACK

(4) MOUNT ON LIGHT POLE

GENERAL NOTES:

1. POST LENGTHS ARE APPROXIMA TE AND INCLUDE EMBEDMENT

BUT DO NO INCLUDE ADDITIONAL LENGTH REQUIRED FOR SPLICE.

ATION, OR REPORT WAS PREPARED AND THAT I AM A DULY LICENSED OF THE STATE OF MINNESOTA.






	DESIG
Lield	DRAV
n Hometown	CHEC
n Hometown	CLIEN


GNED	NO.	REVISION	DATE	CITY OF BIGUEIELD AMBINECOTA
ZAP				CITY OF RICHFIELD, MINNESOTA
WN				,
KME	\vdash			S.A.P. 157-363-032, LYNDALE AVENUE RECONSTRUCTION
KED				S.A.I. 137 303 032, ETNOALE AVENUE RECONSTRUCTION
BTN				SIGNING AND
				SIGNING AND
NT PROJ. NO.	\vdash			STRIDING DI ANS
T1C11AEA1				

C7.34

3. SEE STANDARD SIGNS MANUAL FOR PUNCHING CODE AND

TWO-WAY LEFT-TURN LANE

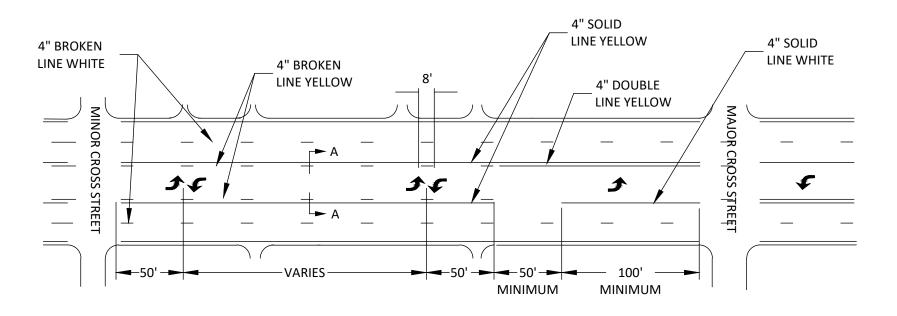

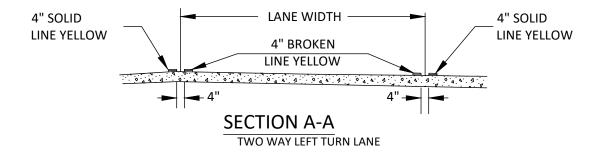


12224 NICOLLET AVENUE BURNSVILLE, MINNESOTA 55337 Phone: (952) 890-0509 Email: Burnsville@bolton-menk.com www.bolton-menk.com


PUBLISHED BY OTST: 14 OCT 2016



TURN LANE WITH ARROW MESSAGE

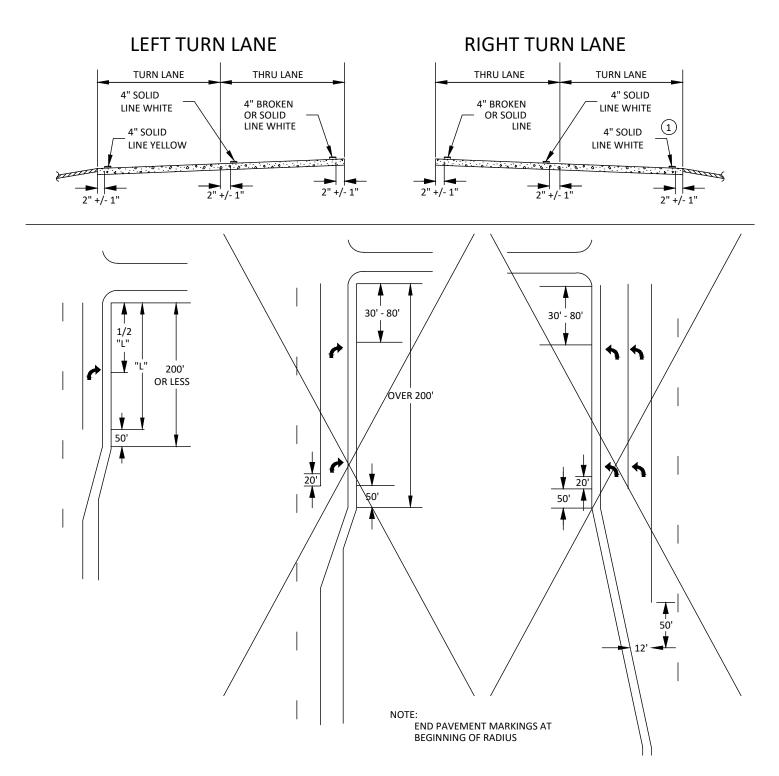

14 OCT 2016 (MOD 6 NOV 2017)

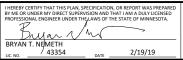






12224 NICOLLET AVENUE BURNSVILLE, MINNESOTA 55337 Phone: (952) 890-0509 Email: Burnsville@bolton-menk.com www.bolton-menk.com

DESIGNED	NO.	REVISION	DATE	CITY OF DICHELL D. MAININESCOTA	SHEET
ZAP				CITY OF RICHFIELD, MINNESOTA	SHEET
DRAWN				6 4 5 457 969 999 1000 415 415 415 415 415 415 415	C7 2C
KME				S.A.P. 157-363-032, LYNDALE AVENUE RECONSTRUCTION	L/.3b
CHECKED BTN				SIGNING AND	
CLIENT PROJ. NO.	1				
T16114541				STRIPING PLANS	

LEFT TURN LANE ISLAND

NOTE:


END PAVEMENT MARKINGS AT BEGINNING OF RADIUS

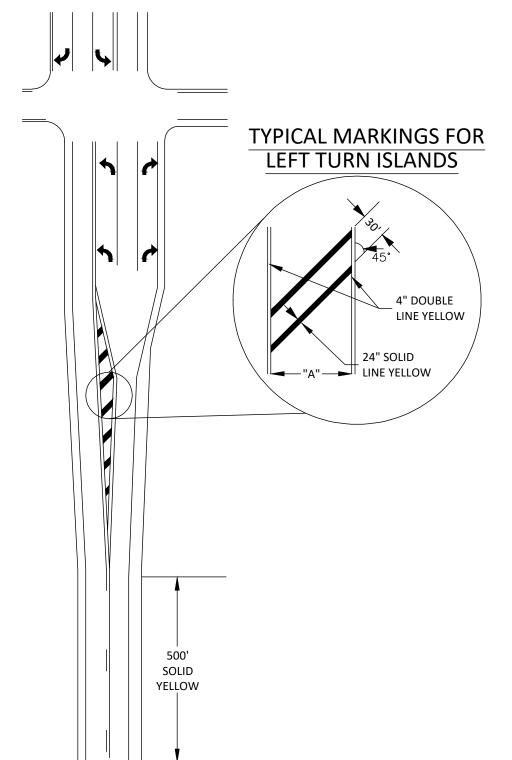

14 OCT 2016





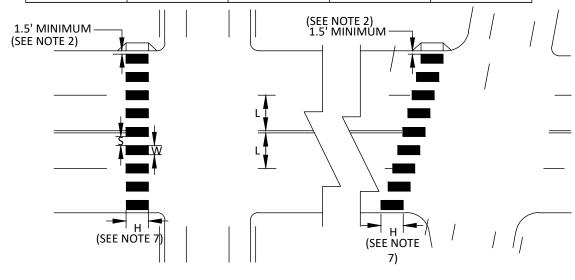

NOTES:


- 1. PAINTED AREAS TO BE CENTERED ON CENTERLINE AND LANE LINES.
- 2. A MINIMUM OF 1.5 FT. CLEAR DISTANCE SHALL BE LEFT ADJACENT TO THE CURB FACE. IF LAST PAINTED AREA FALLS INTO THIS DISTANCE IT MUST BE OMITTED.
- 3. ON TWO LANE TWO WAY STREETS, USE SPACING SHOWN FOR AN 11 FT. INSIDE LANE.
- 4. FOR DIVIDED ROADWAYS, ADJUSTMENTS IN SPACING OF THE BLOCKS SHOULD BE MADE IN THE MEDIAN SO THAT THE BLOCKS ARE MAINTAINED IN THEIR PROPER LOCATION ACROSS THE TRAVELED PORTION OF THE ROADWAY.
- 5. AT SKEWED CROSSWALKS, THE BLOCKS ARE TO REMAIN PARALLEL TO THE LANE LINES AS SHOWN.
- 6. THE BLOCKS SHALL BE PLACED SO THAT THEY ARE NOT LOCATED IN THE WHEEL PATH OF THE VEHICLES.
- 7. THE BLOCKS SHALL BE A MINIMUM OF 6' LONG AND AT LEAST AS LONG AS THE TRUNCATED DOMES, FOR FANNED TRUNCATED DOMES THE BLOCKS SHALL BE AT LEAST AS LONG AS THE APPROACHING SIDEWALK OR SHARED USE PATH.
- 8. THE ALTERNATE (W) AND (S) MAY BE USED WHEN BLOCKS LONGER THAN 6' (H) ARE USED.

PUBLISHED BY OTST: 20 NOV 2015



C7.38

STOP LINE AT UNSIGNALIZED MID BLOCK CROSSWALKS

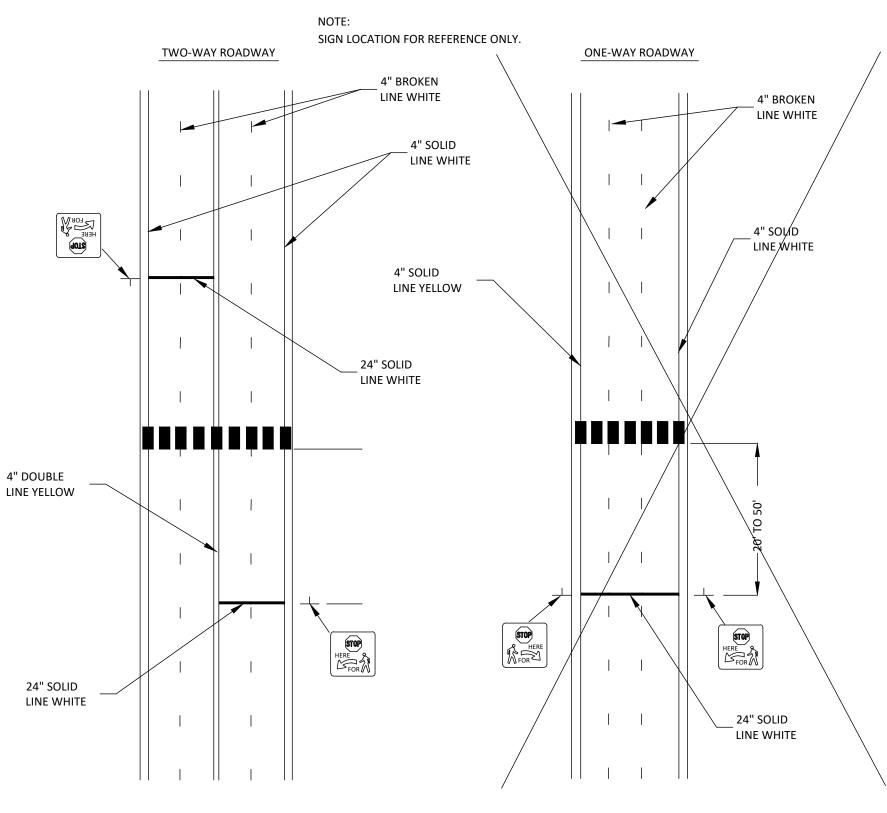

PUBLISHED BY OTST: 20 NOV 2015

I HEREBY CERTIFY THAT THIS PLAN, SPECIFICATION, OR REPORT WAS PREPARED BY ME OR DIVIDED WIS MOD NATH I HAVE DAY DEVELORED PROFESSIONAL ENGINEER UNDER THE LAWS OF THE STATE OF MINNESOTA.

BRYANT T. NEMETH

UC NO. 43354

DATE 2/19/19





12224 NICOLLET AVENUE
BURNSVILLE, MINNESOTA 55337
Phone: (952) 890-0509
Email: Burnsville@bolton-menk.com
www.bolton-menk.com

	DESIGNED
)	ZAP
	DRAWN
Lova.	KME
0)	CHECKED
Hometown	BTN
hometon	CLIENT PROJ. NO.
7750	T1611/

CITY OF RICHFIELD, MINNESOTA

S.A.P. 157-363-032, LYNDALE AVENUE RECONSTRUCTION
SIGNING AND
STRIPING PLANS

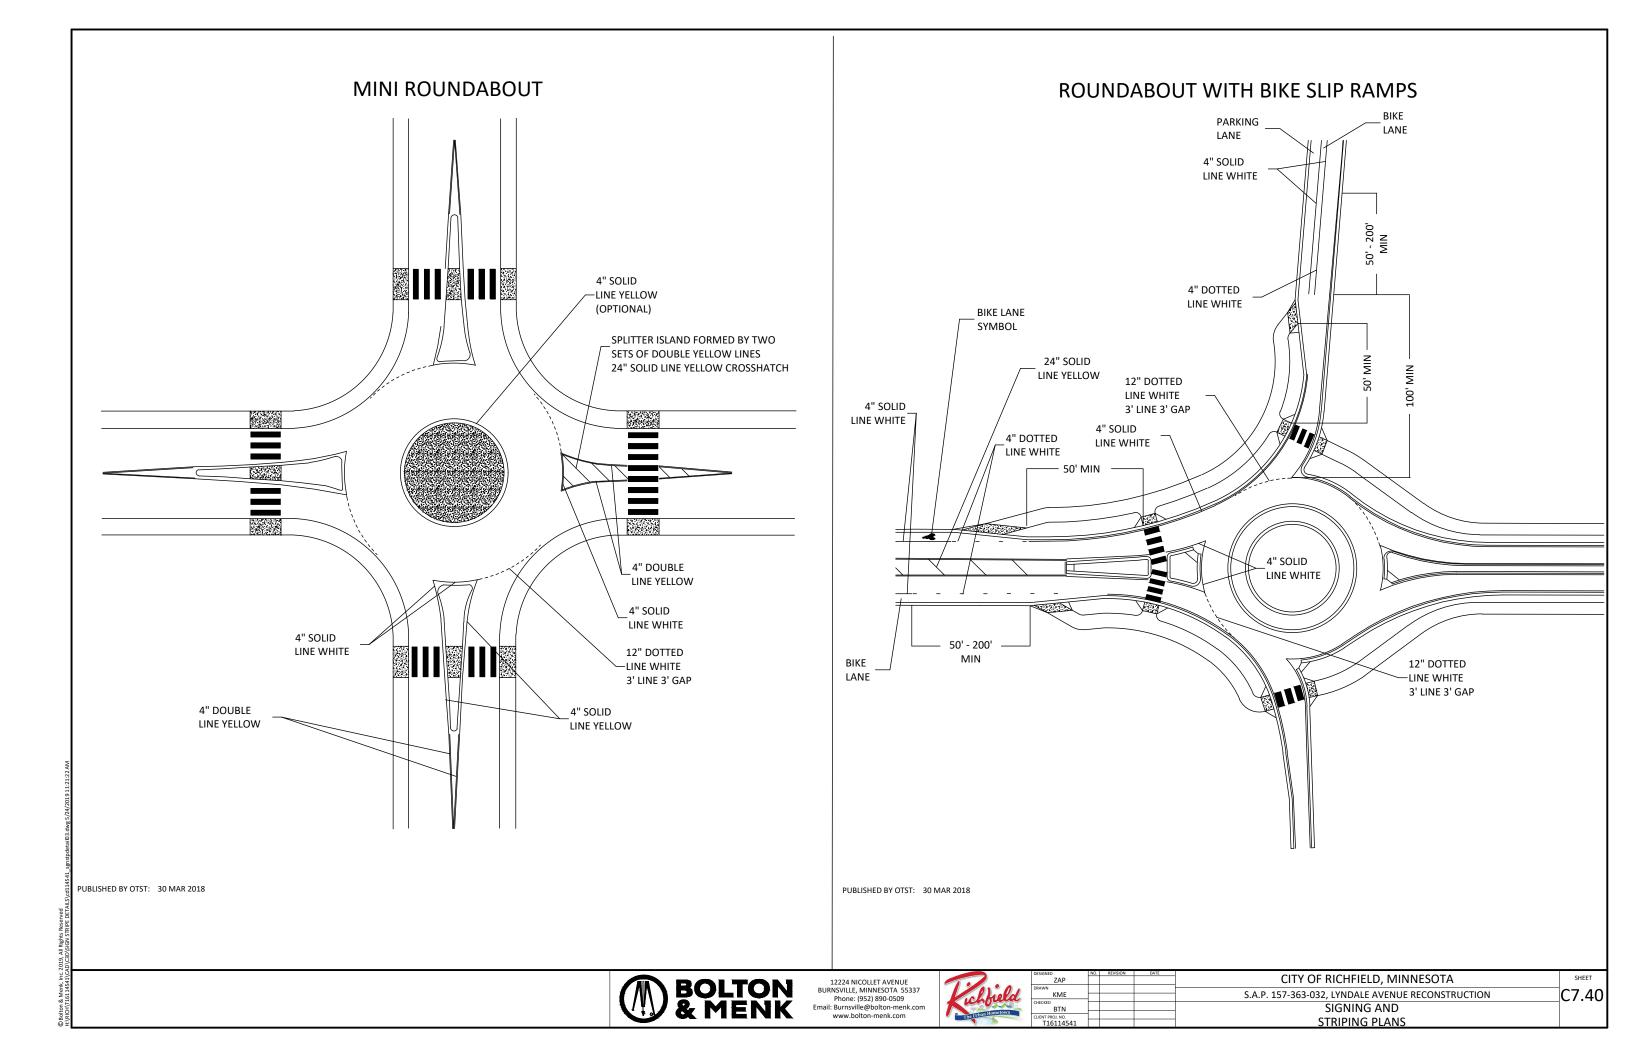

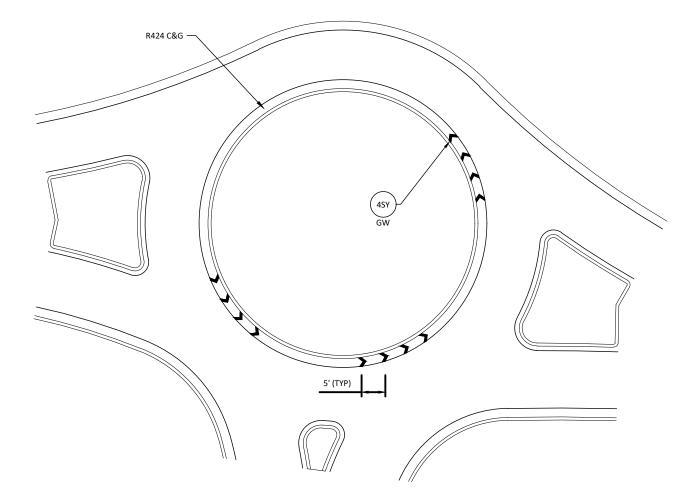


ROUNDABOUT ISLAND STRIPING DETAIL


NOT TO SCALE

BOLTON & MENK 12224 NICOLLET AVENUE
BURNSVILLE, MINNESOTA 55337
Phone: (952) 890-0509
Email: Burnsville@bolton-menk.com
www.bolton-menk.com


	DESIGNED ZAP	NO.	REVISION	DATE	CITY OF RICHFIELD, MINNESOTA	SHEET
ld	KME	\vdash			S.A.P. 157-363-032, LYNDALE AVENUE RECONSTRUCTION	C7.41
town	BTN				SIGNING AND	
	T16114541				STRIPING PLANS	

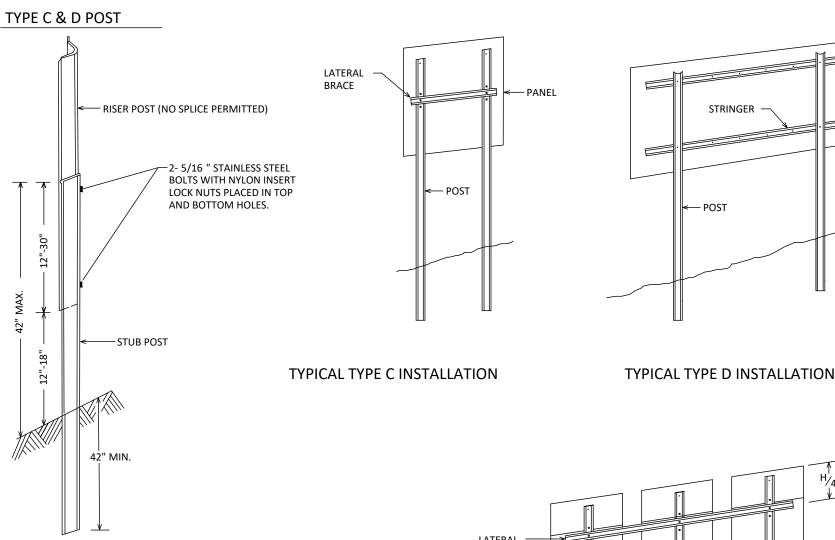

U POST BREAKAWAY SPLICE

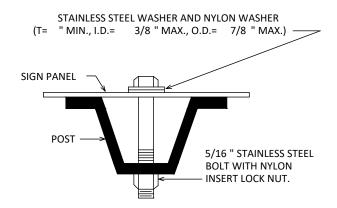

U POST MOUNTING
TYPE C SIGNS

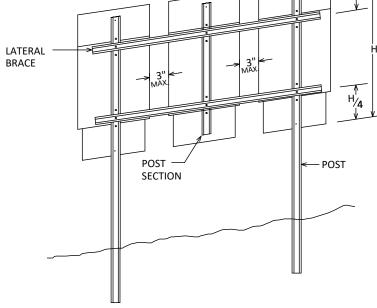

MODIFIED TYPE C INSTALLATION

NOTE

— PANEL

- 1. USE 3 LB/FT STUB POSTS. SHALL CONFORM TO MNDOT 3401.
- USE 2.5 LB/FT RISER POSTS, STRINGERS, KNEE BRACES AND LATERAL BRACES. ALL SHALL CONFORM TO MNDOT 3401.
- SEE SIGN DATA SHEETS FOR NUMBER OF POSTS, KNEE BRACES, POST LENGTHS AND SPACINGS, AS DETERMINED FROM TEM CHARTS 6.3 AND 6.4.
- 4. IF MORE THAN TWO POSTS ARE NEEDED, THE MINIMUM SPACING SHALL BE 45" BETWEEN POSTS.
- TYPE D SIGN PANELS SHALL BE BOLTED TO STRINGERS
 AT 24" MAXIMUM INTERVALS IN ACCORDANCE WITH
 THE TYPE D STRINGER AND PANEL-JOINT DETAIL
 (SEE MNDOT STANDARD SIGNS AND MARKINGS MANUAL).
- MOUNTING (PUNCH CODE) FOR TYPE C SIGN PANELS SHALL BE AS INDICATED IN THE MNDOT STANDARD SIGNS AND MARKINGS MANUAL UNLESS OTHERWISE SPECIFIED.
- 7. ALL RISER (VERTICAL) U POSTS SHALL BE SPLICED. DRIVEN STUB POSTS SHALL BE AT LEAST 7' LONG.
- 8. USE STAINLESS STEEL 5/16" BOLTS, WASHERS AND NYLON INSERT LOCK NUTS AS SHOWN FOR ALL GROUND MOUNTED AND OVERHEAD MOUNTED SIGNS.
- STAINLESS STEEL WASHER WITH SAME DIMENSIONS SHALL BE PROVIDED BETWEEN ALL NYLON WASHERS AND BOLT HEADS.
- 10. BRACING STUBS SHALL BE NO MORE THAN 4" ABOVE GROUND AND EMBEDDED AT LEAST 42".
- A-FRAME BRACKET SHALL BE STEEL CONFORMING TO MNDOT 3306 AND GALVANIZED IN ACCORDANCE WITH MNDOT 3394.
- COLLARS SHALL BE USED TO SHIM OVERLAYS AND LEGEND COMPONENTS AWAY FROM PANEL WHERE INTERFERENCE WITH BOLT HEADS IS ENCOUNTERED. MNDOT 3352.2A6.
- 13. 2 POST TYPE C SIGNS SHALL BE REINFORCED WITH AT LEAST ONE LATERAL BRACE. INSTALLATIONS WHERE THE TOTAL PANEL HEIGHT IS 60" OR MORE SHALL HAVE TWO LATERAL BRACES LOCATED APPROXIMATELY AT THE QUARTER POINTS.
- 14. WHERE 2 SINGLE POST TYPE C SIGNS ARE INSTALLED SIDE BY SIDE, THEY SHALL BE REINFORCED LATERALLY BY AT LEAST 2 BRACES, BOLTED AT EACH POST AND LOCATED APPROXIMATELY AT THE QUARTER POINTS.
- 15. WHERE 3 OR MORE TYPE C SIGNS ARE INSTALLED
 SIDE BY SIDE, THEY SHALL BE REINFORCED LATERALLY
 BY AT LEAST 2 BRACES, BOLTED AT EACH POST AND POST
 SECTION AND LOCATED APPROXIMATELY AT THE QUARTER
 POINTS AS SHOWN IN MODIFIED TYPE C INSTALLATION.

TYPE C & D SIGN

STRUCTURAL DETAILS

Sheet 1 of 2


05 MAY 2017


C7.42








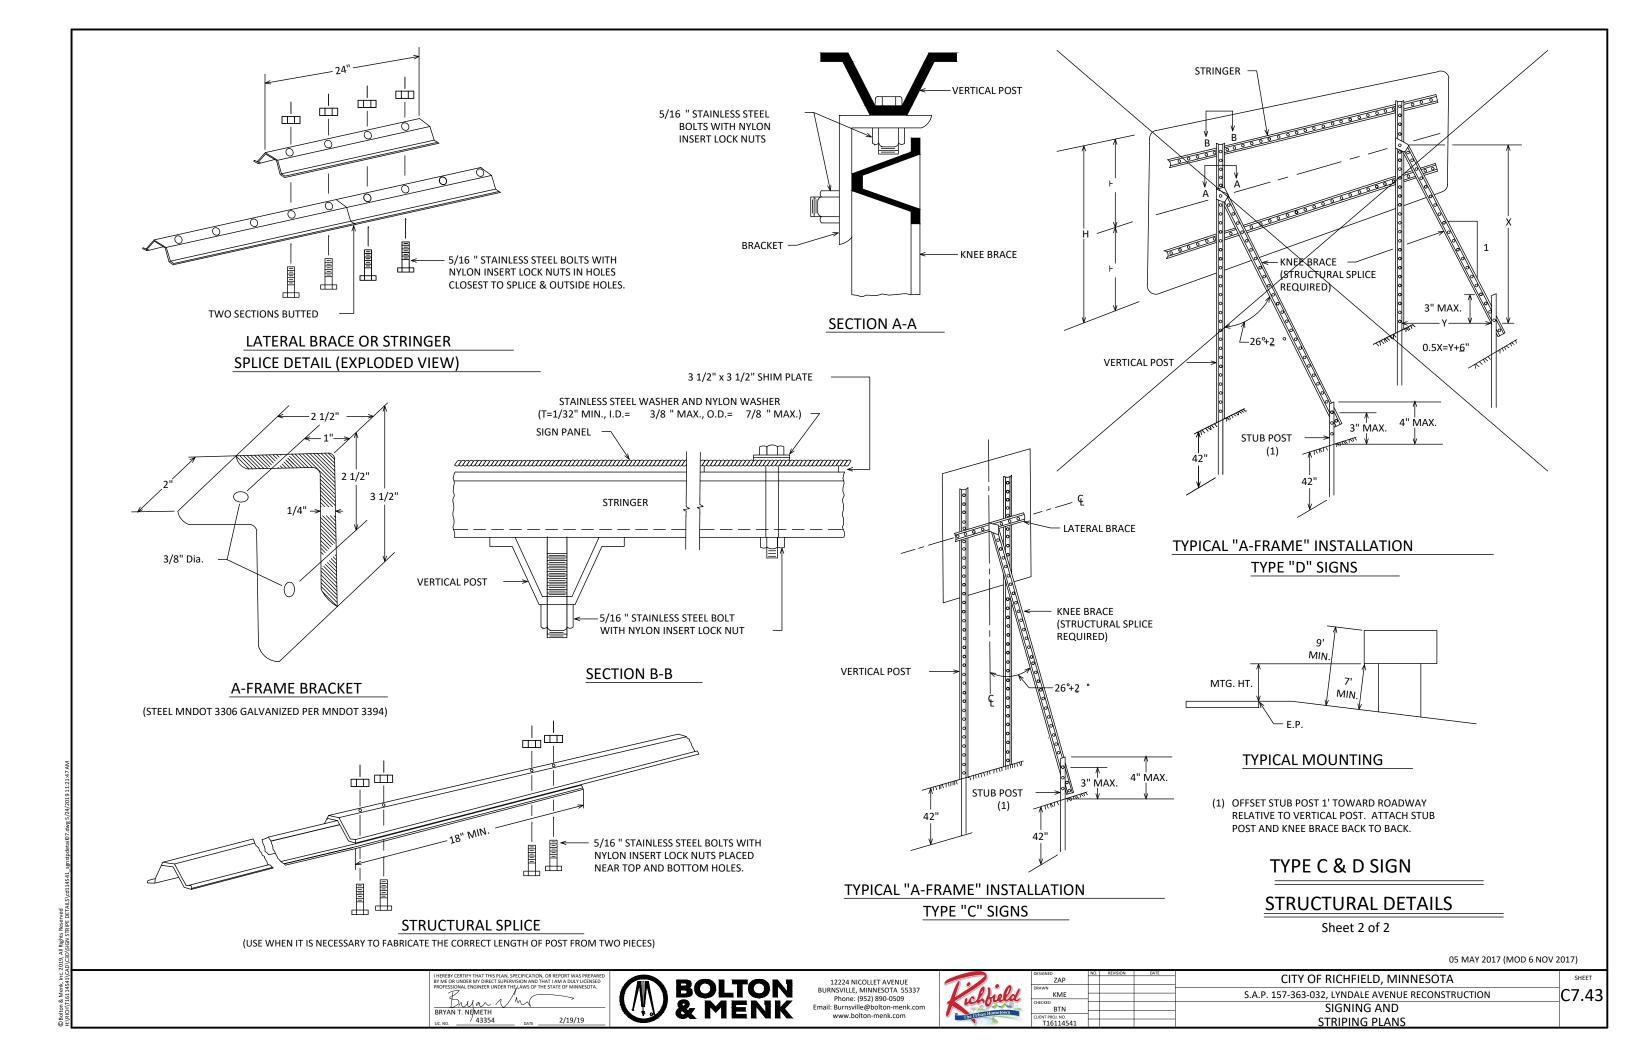

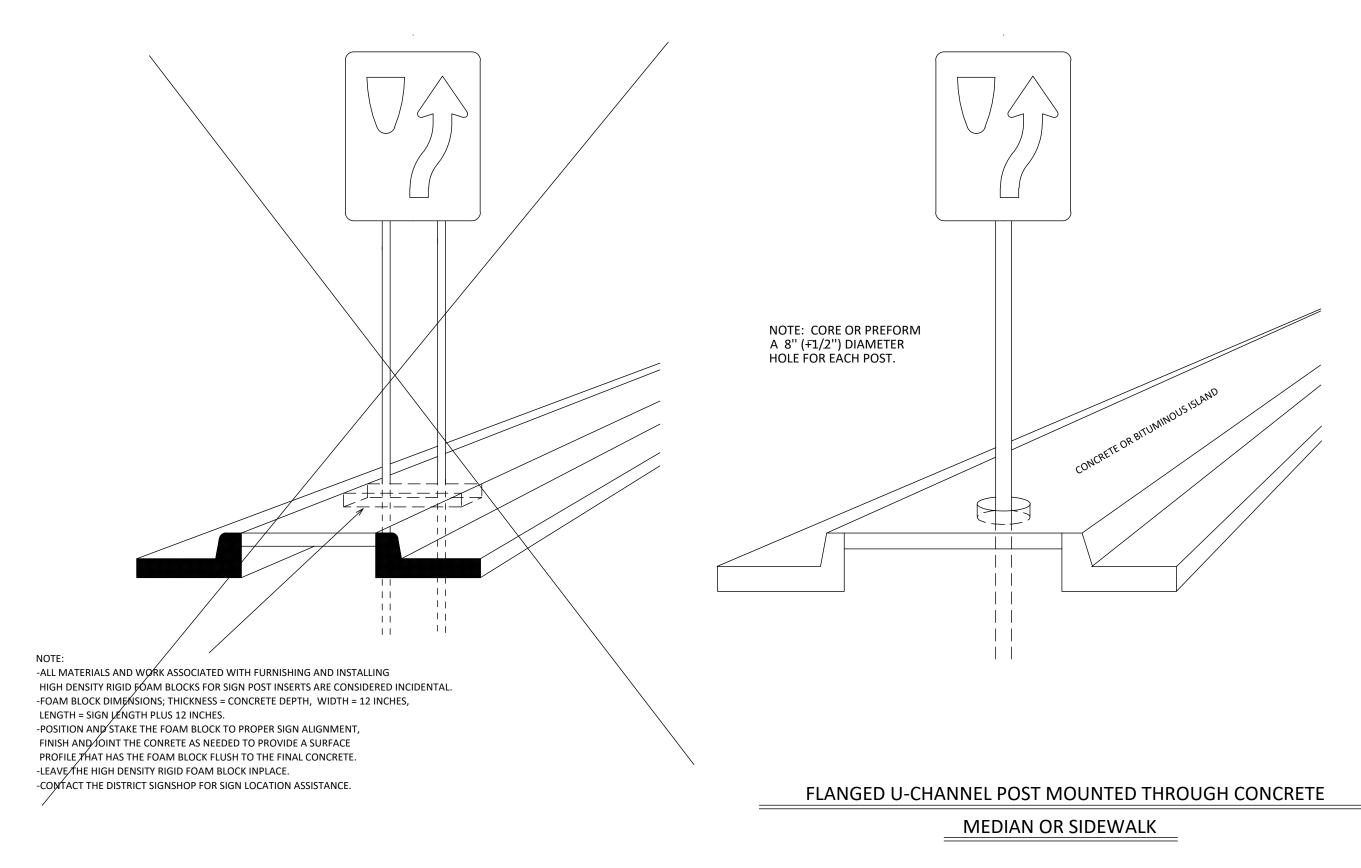

REVISED: 5-28-2015

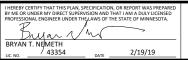






Lich hield
The Urban Hometown
The Old


GNED	NO.	REVISION	DATE	CITY OF DICHFIELD AMAINIFECTA	CHEET
ZAP				CITY OF RICHFIELD, MINNESOTA	SHEET
WN					C7 44
KME				S.A.P. 157-363-032, LYNDALE AVENUE RECONSTRUCTION	(./.44]
CKED				SIGNING AND	0,
BTN				SIGINING AND	
NT PROJ. NO.	\vdash			STRIPING PLANS	
T16114541			I	3 I KIPING PI ANS	

TOP VIEW 2 POSTS SIGN WITH 2 KNEE BRACES

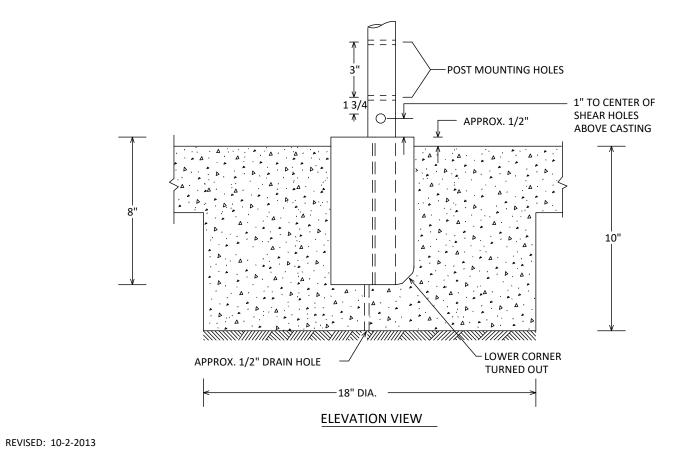

ROADSIDE OR MEDIAN PLACEMENT FOR ROUND AND U CHANNEL SOCKETS

THE AXIS OF THE SIGNPOST SUPPORT WEDGE SHOULD ALIGN PARALLEL TO THE ROAD FOR MAXIMUM RESISTANCE TO IMPACT AS SHOWN BELOW:

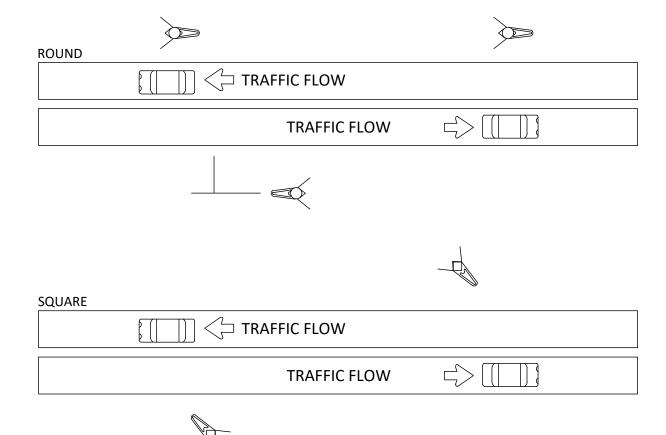



GENERAL NOTES:


- SEAL BOTTOM OF SIGNPOST SUPPORT WITH DUCT TAPE BEFORE INSTALLATION IN NEW CONCRETE.
- 2. SIGNPOST SUPPORTS SHALL BE INSTALLED PLUMB AND APPROXIMATELY 1/2" ABOVE THE TOP OF THE CONCRETE SURFACE.


SIGNPOST SUPPORT IN CONCRETE







DESIGNED	NO.	REVISION	DATE	CITY OF RICHFIELD, MINNESOTA	SHEET
DRAWN	\vdash			CITTOT METITLES, WINNIESOTA	
KME				S.A.P. 157-363-032, LYNDALE AVENUE RECONSTRUCTION	C7.45
BTN				SIGNING AND	
T16114541				STRIPING PLANS	

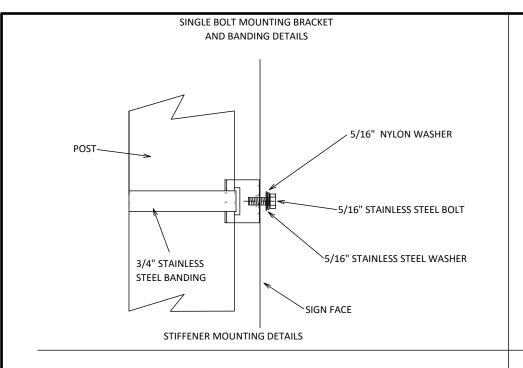


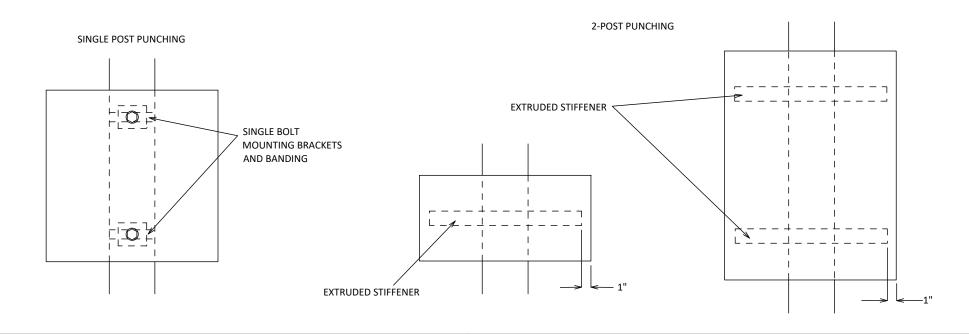

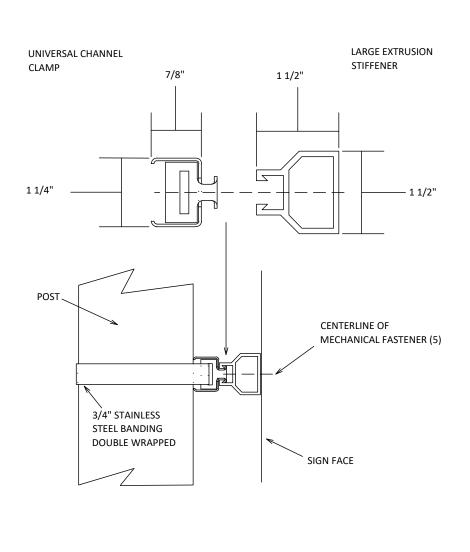

REVISED: 1-25-2016

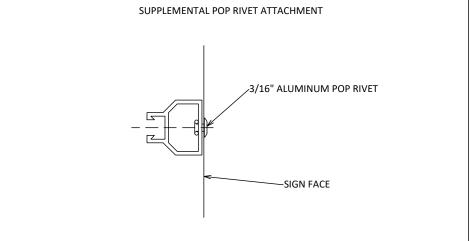

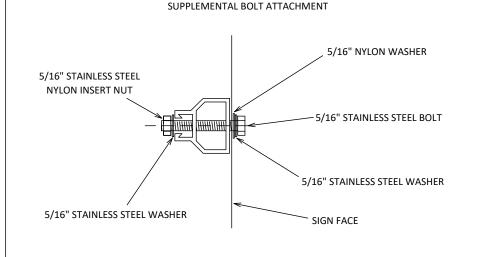

NOTES:

- 1. FOR DETAILS AND NOTES NOT SHOWN, SEE TYPE "C" AND "D" SIGN DETAILS.
- 2. FOR BACK TO BACK INSTALLATION, ROTATE STIFFENERS FOR ONE PANEL 180 DEGREES SUCH THAT PANELS CAN BE MOUNTED AT THE SAME ELEVATION.
- 3. HORIZONTAL SPACING OF STIFFENERS SHALL BE ACCORDING TO THE PUNCH CODES AS SHOWN IN THE MNDOT STANDARD SIGNS AND MARKINGS MANUAL.
- 4. MOUNTING HOLES ARE NOT REQUIRED ON SIGNS SMALLER THAN 6.3 SQUARE FEET, EXCEPT ON SINGLE POST PUNCHED SIGNS.
- 5. STIFFENERS SHALL BE ATTACHED TO SIGNS USING EITHER 3/16" DIAMETER POP-RIVETS OR 5/16" DIAMETER BOLTS.
- 6. USE .75" X .030" BANDING STRAPS OF TYPE 201 "1/4 HARD" STAINLESS STEEL, DOUBLE-WRAPPED AROUND THE POLE IN ACCORDANCE WITH THE MANUFACTURER'S INSTRUCTIONS.
- 7. BAND PRETENSION SHALL NOT EXCEED 1300 POUNDS.
- 8. ALL HARDWARE SHALL BE COMPATIBLE WITH STIFFENER AND MOUNTING SYSTEMS.


SIGN TYPE C AND D EXTRUDED ALUMINUM MOUNTING SYSTEM FOR ROUND SUPPORTS




12224 NICOLLET AVENUE
BURNSVILLE, MINNESOTA 55337
Phone: (952) 890-0509
Email: Burnsville@bolton-menk.com
www.bolton-menk.com


0100
La La La Col
The Urban Hometown
Theory


GNED ZAP	NO.	REVISION	DATE	CITY OF RICHFIELD, MINNESOTA	SHEET
WN				CITI OF MICHIELD, WINVINGSOTA	
KME				S.A.P. 157-363-032, LYNDALE AVENUE RECONSTRUCTION	C7.46
BTN				SIGNING AND	
NT PROJ. NO. T16114541				STRIPING PLANS	
110114541				JIMFING FLAND	

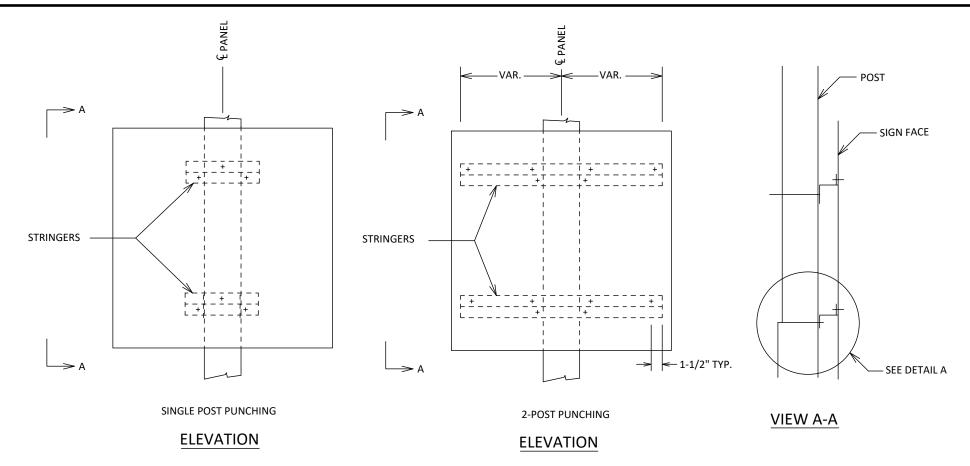

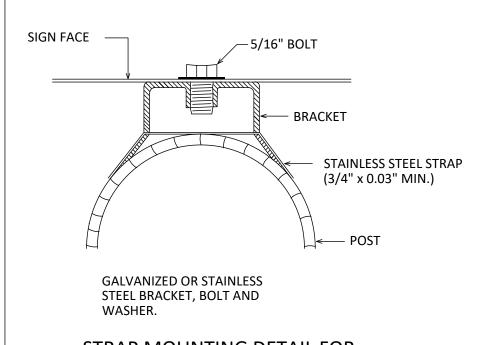

STRAP MOUNTING DETAIL FOR OVERHEAD IDENTIFICATION AND LIGHTING SYSTEM IDENTIFICATION PLATES

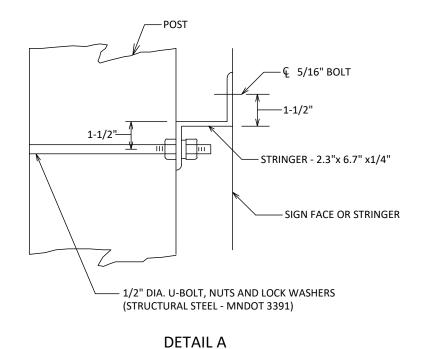

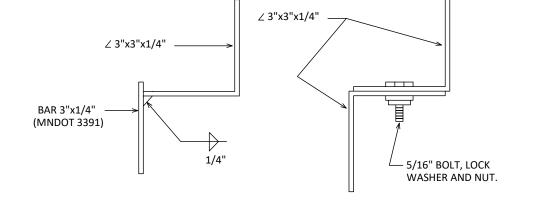

DETAIL A STRINGER ALTERNATES

NOTES:

- 1. FOR DETAILS AND NOTES NOT SHOWN SEE "C" & "D" SIGN DETAILS.
- 2. FOR BACK TO BACK MOUNTINGS, ROTATE STRINGERS FOR ONE PANEL 180 FRÔM WHAT IS SHOWN SUCH THAT PANELS CAN BE MOUNTED AT SAME ELEVATION.
- 3. DETAIL A STRINGER MAY BE ONE OF THE THREE DESIGNS DETAILED OR AN APPROVED EQUAL. STRUCTURAL STEEL SHALL BE IN ACCORDANCE WITH MNDOT 3306 AND GALVANIZED IN ACCORDANCE WITH MNDOT 3394. FASTENERS SHALL BE IN ACCORDANCE WITH MNDOT 3391.2B AND SHALL BE GALVANIZED EITHER BY THE HOT-DIP PROCESS IN ACCORDANCE WITH ASTM A153, OR BY THE MECHANICAL PROCESS IN ACCORDANCE WITH ASTM B695, CLASS 50 OR GREATER.

SIGN TYPE C AND D STRUCTURAL

STEEL MOUNTING SYSTEM

FOR ROUND SUPPORTS


REVISED: 1-21-2016





12224 NICOLLET AVENUE BURNSVILLE, MINNESOTA 55337 Phone: (952) 890-0509 Email: Burnsville@bolton-menk.com www.bolton-menk.com





DESIGNED	NO.	REVISION	DATE	CITY OF DICUFFED AMAINIFCOTA	SHEET
ZAP				CITY OF RICHFIELD, MINNESOTA	SHEET
DRAWN				CAR 457 262 022 IVAIDALE AVENUE RECONSTRUCTION	C7 47
KME				S.A.P. 157-363-032, LYNDALE AVENUE RECONSTRUCTION	C/.4/
BTN				SIGNING AND	
CLIENT PROJ. NO.					
T16114541				STRIPING PLANS	

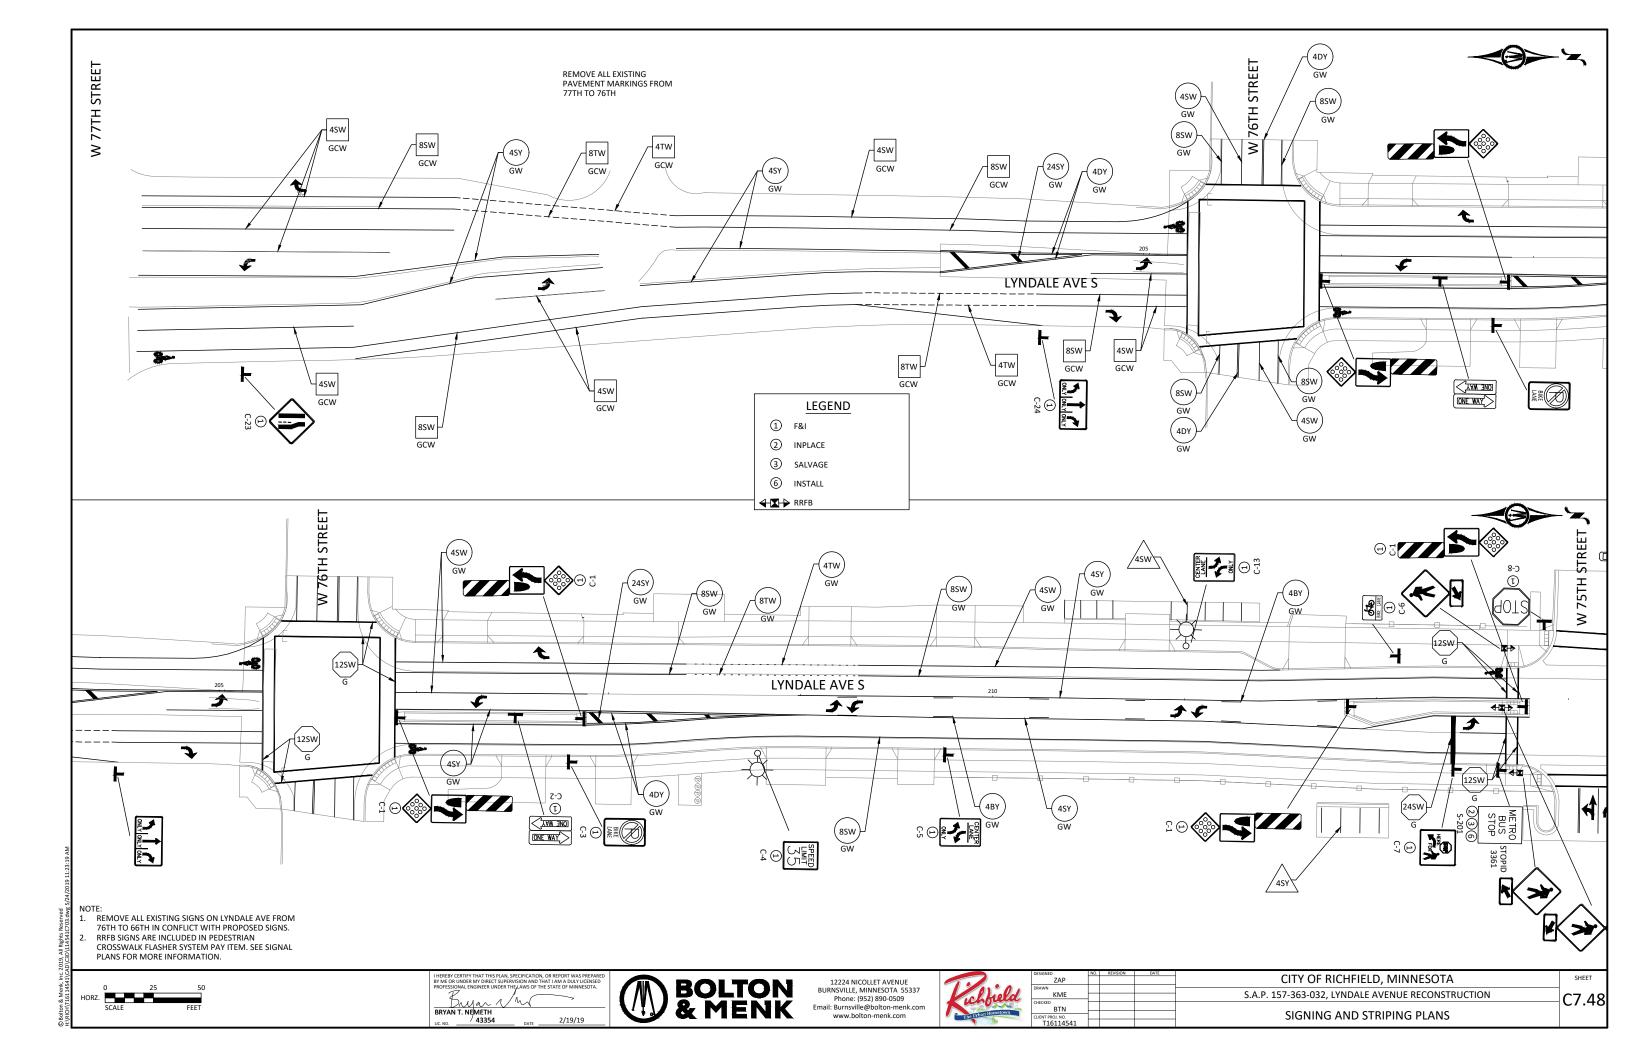

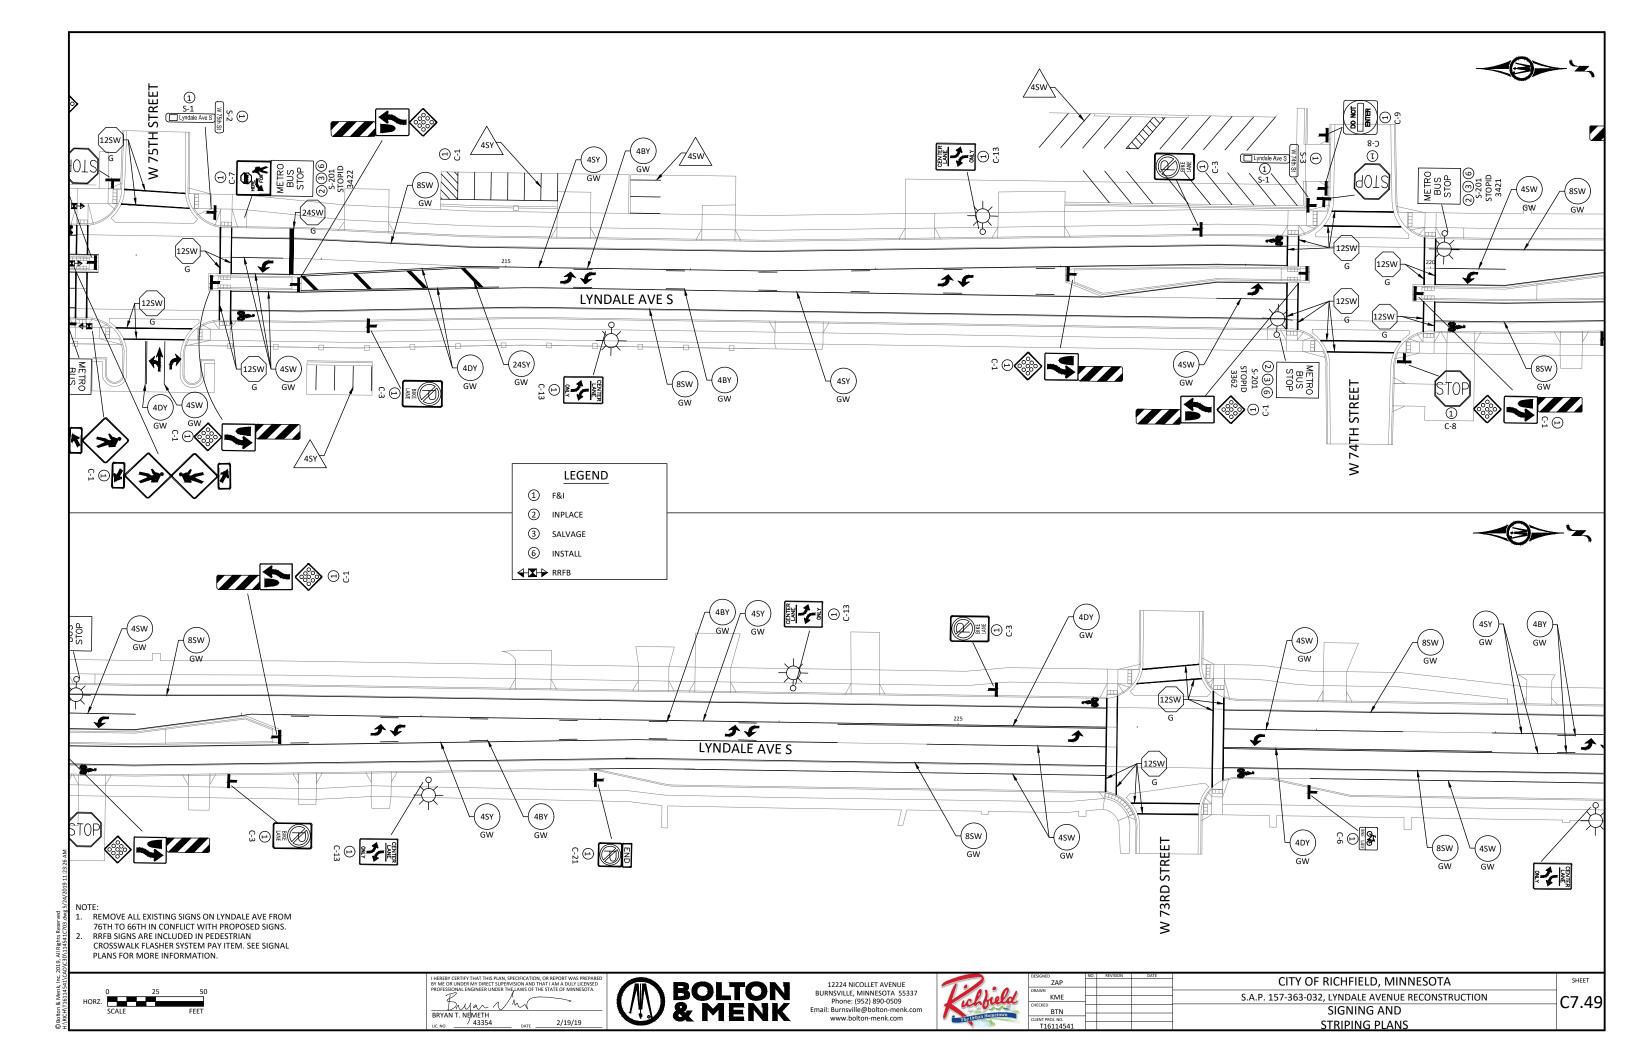

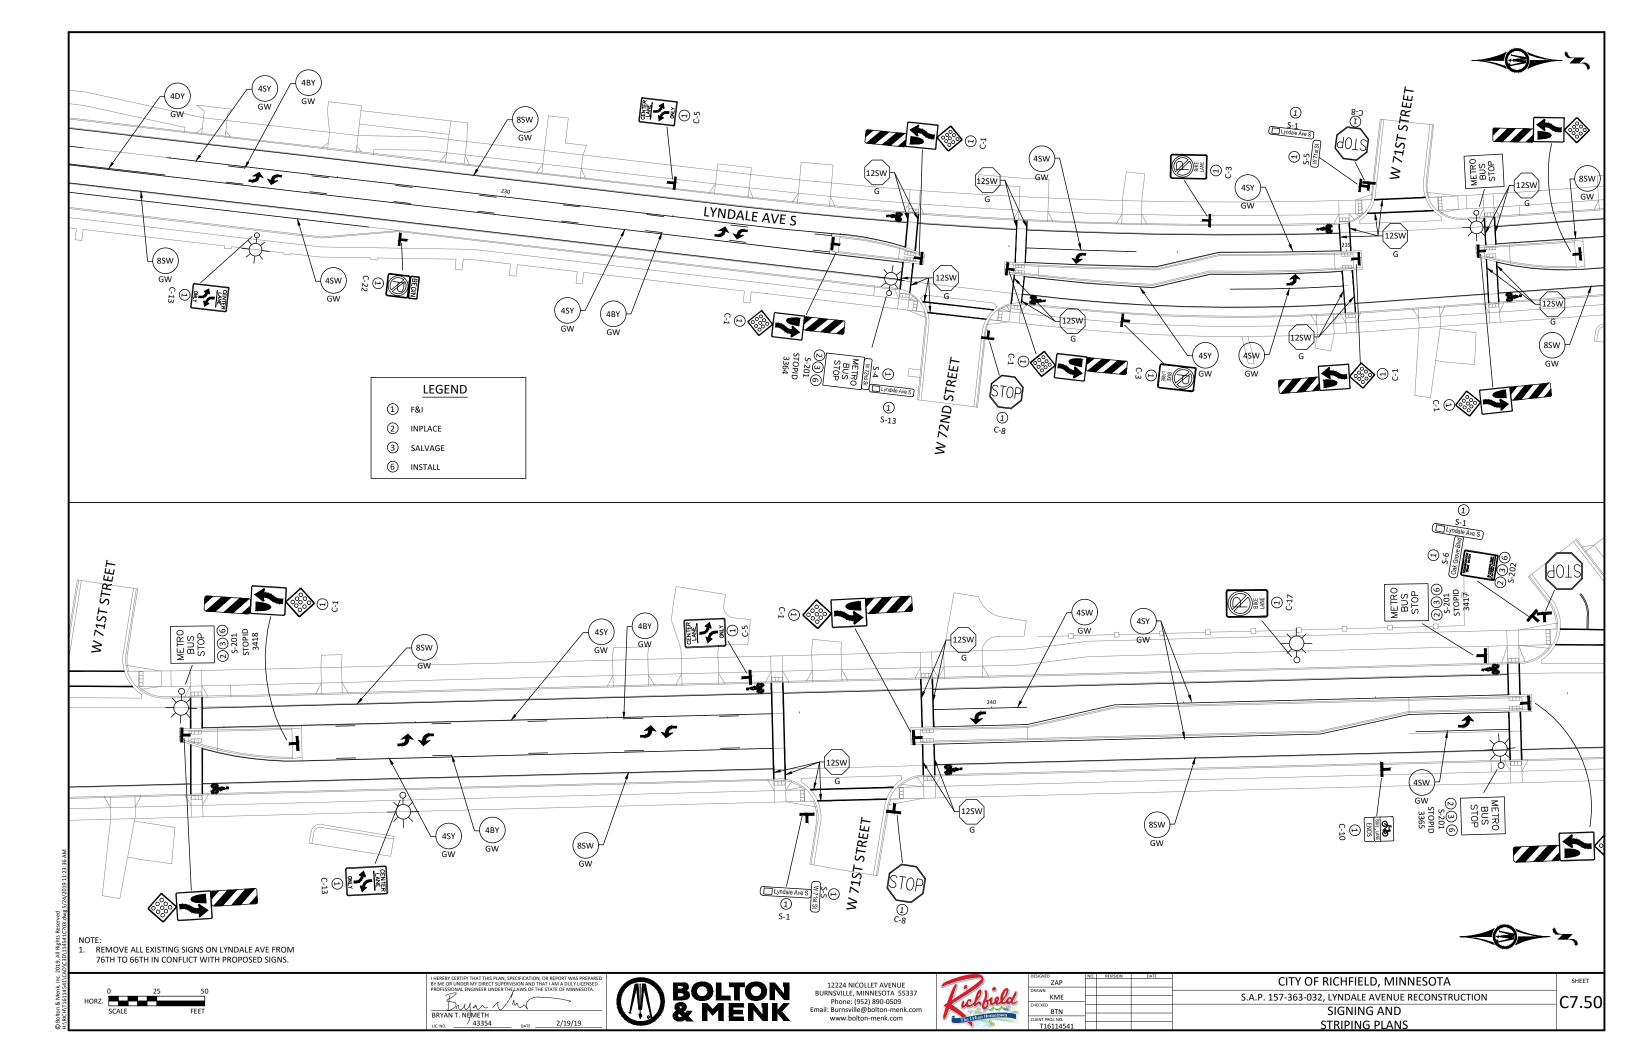

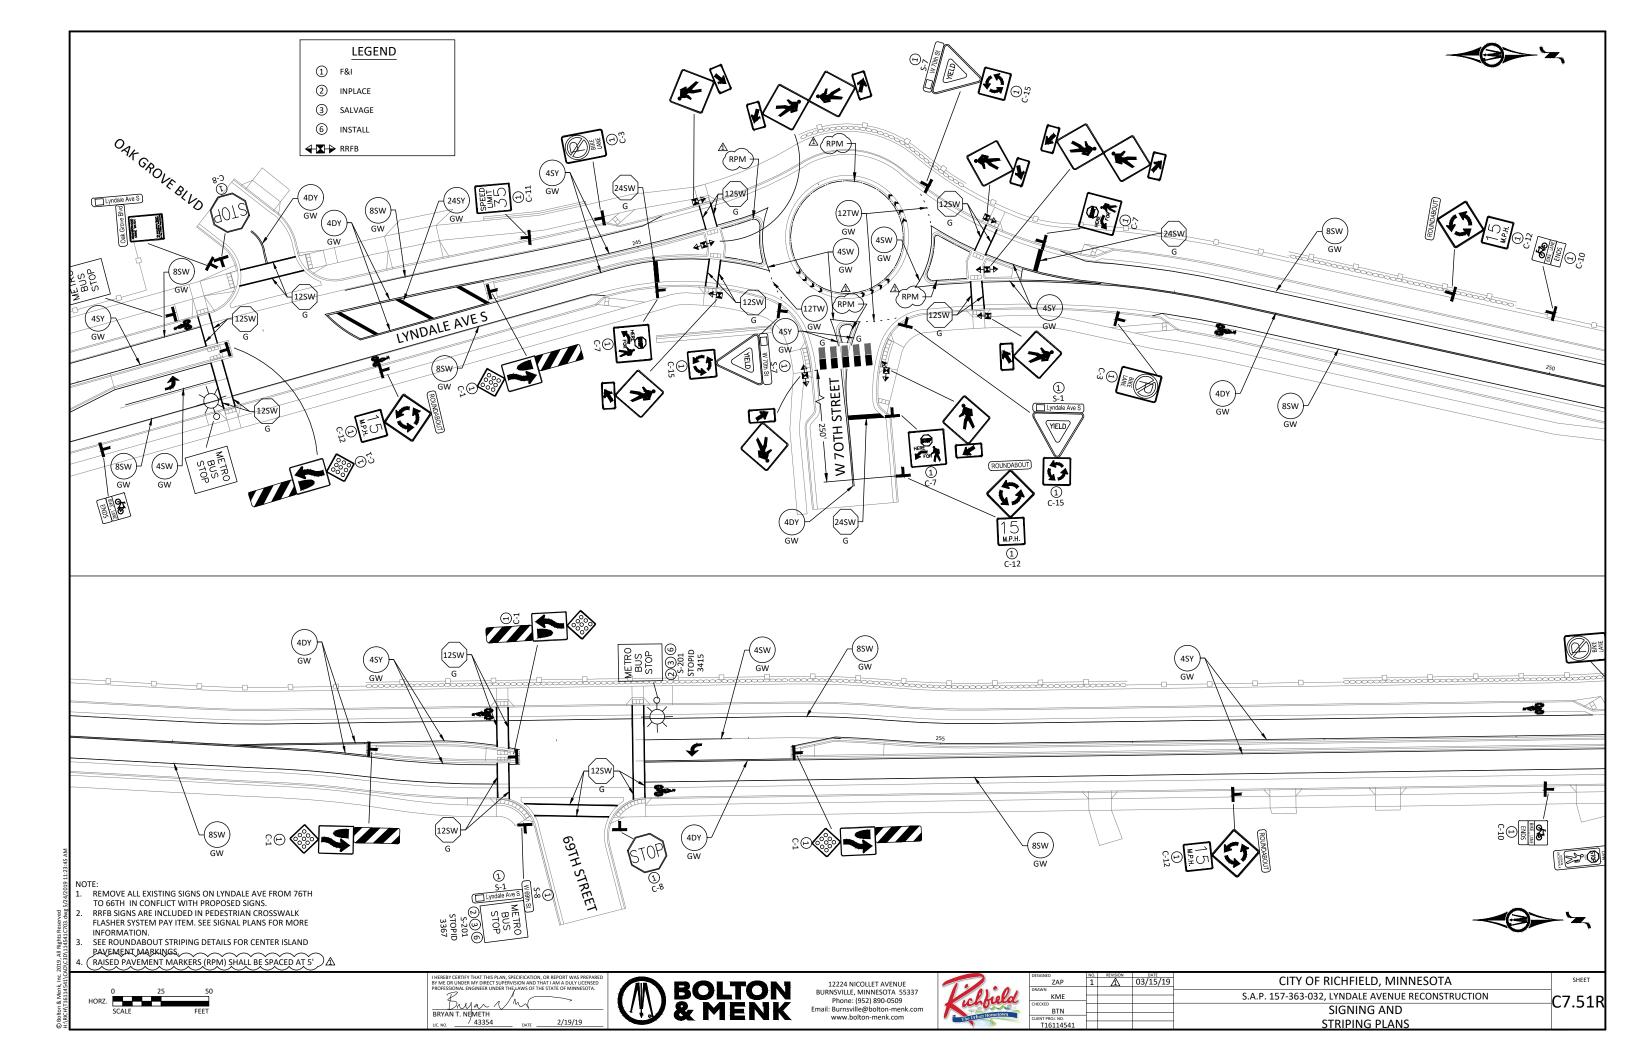

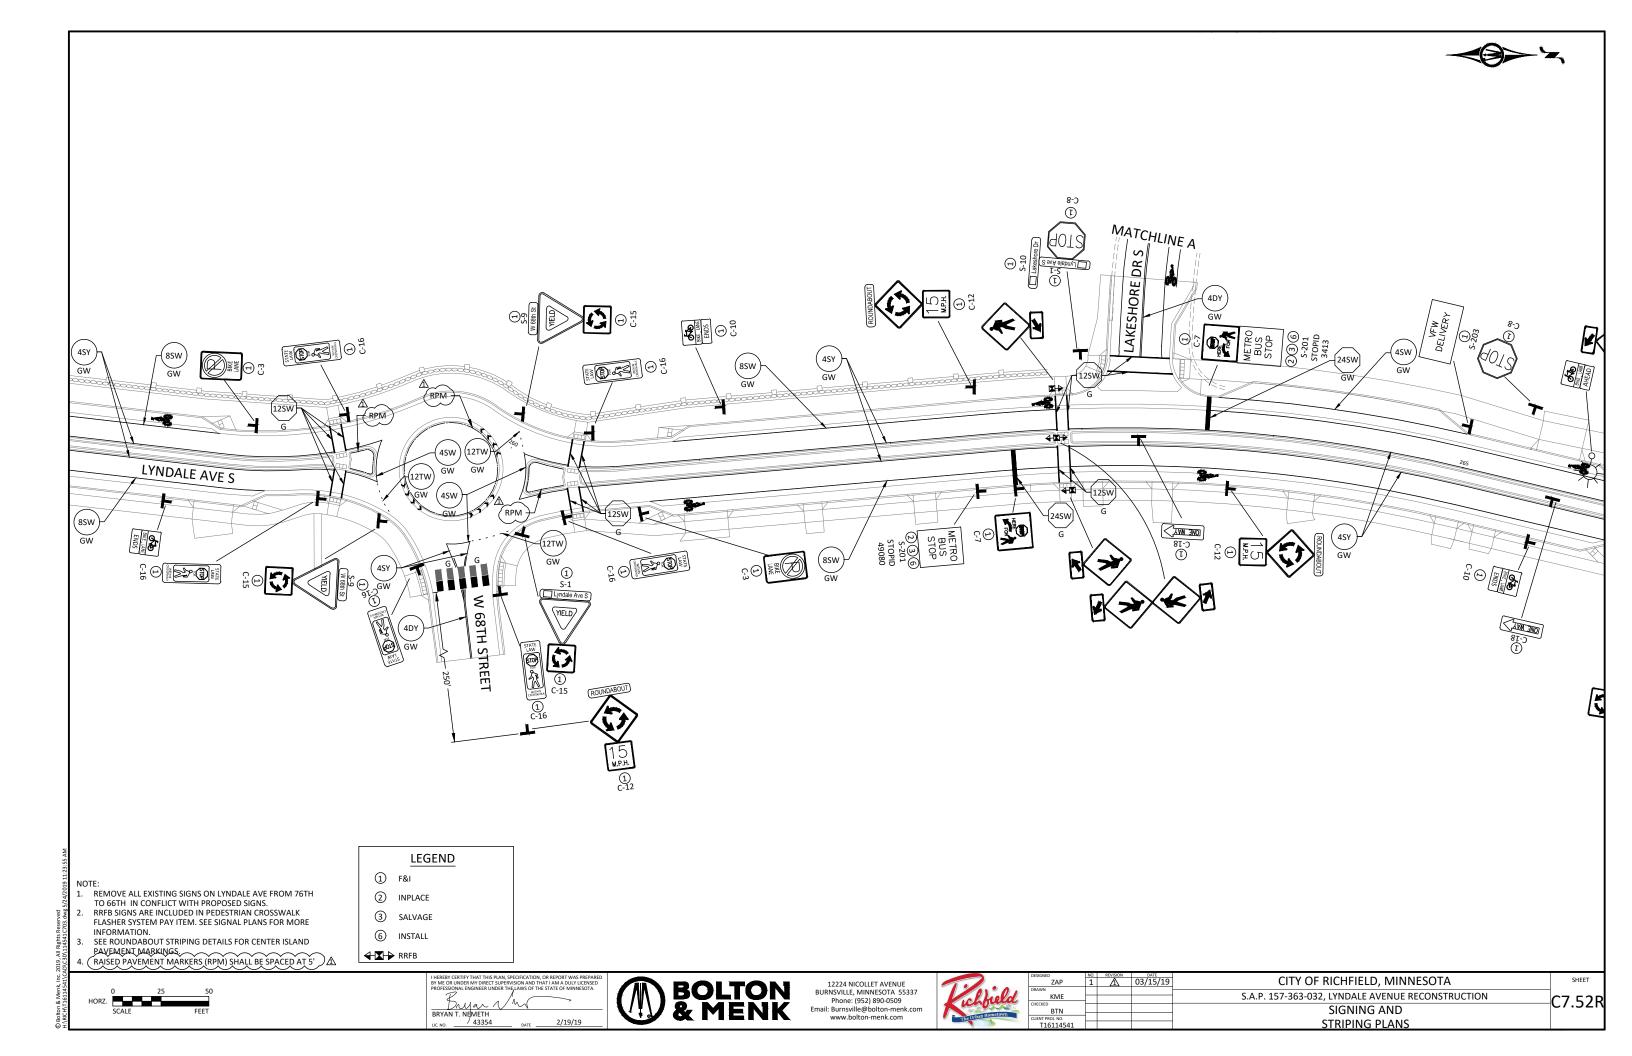




S.A.P. 157-363-032, LYNDALE AVENUE RECONSTRUCTION
SIGNING AND
STRIPING PLANS

C7.53R


KME

BTN T PROJ. NO.

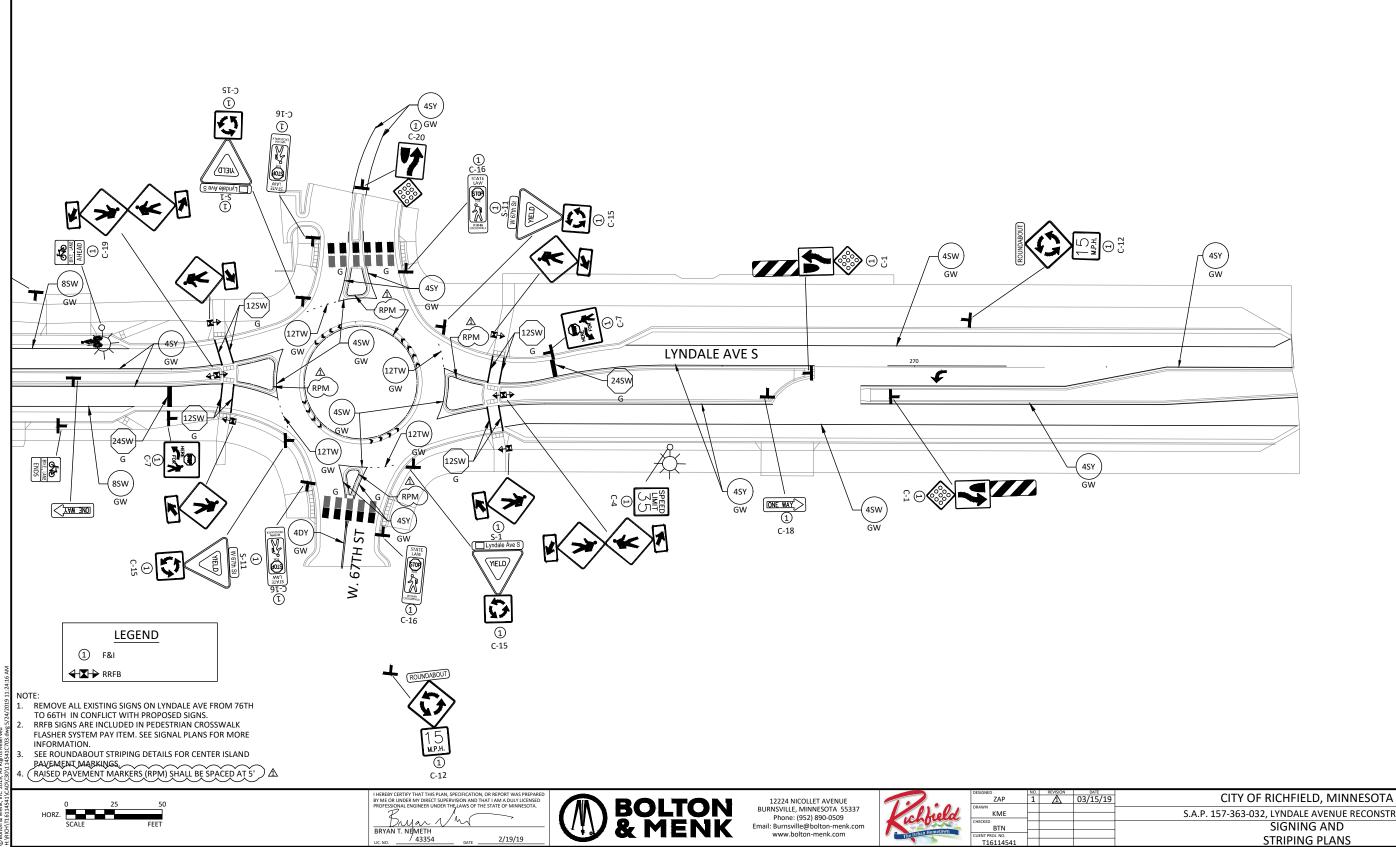



C7.54

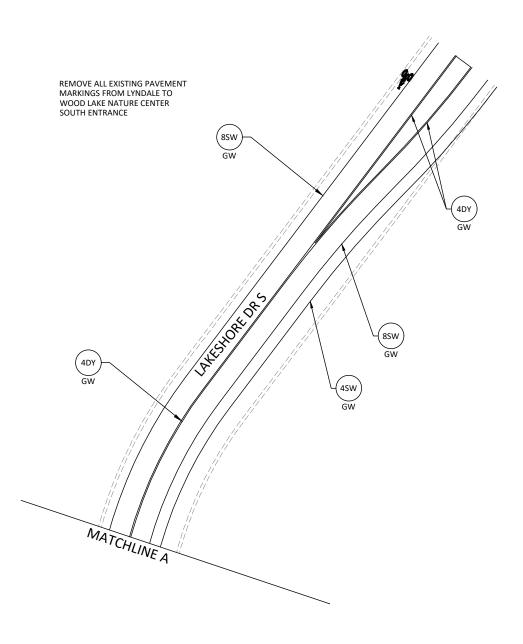

HORZ. SCALE







12224 NICOLLET AVENUE BURNSVILLE, MINNESOTA 55337 Phone: (952) 890-0509 Email: Burnsville@bolton-menk.com www.bolton-menk.com


The Urban Hometown


ED	NO.	REVISION	DATE	OUTLY OF BLOUESELD AND DESCRIP
ZAP L				CITY OF RICHFIELD, MINNESOTA
				,
KME				C A D 157 363 033 LVNDALE AVENUE DECONSTRUCTION
KIVIE				S.A.P. 157-363-032, LYNDALE AVENUE RECONSTRUCTION
n				0.00.00.00
BTN				SIGNING AND
				31311111371113
PROJ. NO.				CTDIDING DI ANG
16114541				STRIPING PLANS

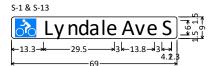

1.0" Radius, No border, White on Green;

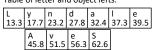

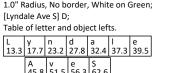

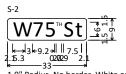


1.0" Radius, No border, White on Green; [W 75THSt] D;

Table of letter and object lefts.

W 2.1

17	5	lт	н	ς	+
I ′	,	l '		5	١.
110 /	15 5	1203	21 5	23 /	28.3
10.7	15.	20.5	21.5	25.	20.5

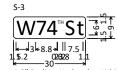


1.0" Radius, No border, White on Green; [W 74THSt] D;

Table of letter and object lefts.



7	4	Т	Н	S	t
9.3	13.7	18.4	19.6	21.4	26.3

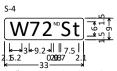


1.0" Radius, No border, White on Green; [W 72NDSt] D;

Table of letter and object lefts.

W 2.1


7	2	N	D	S	t
10.3	15.5	20.4	21.7	23.4	28.3

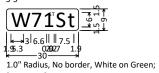

[W 71STSt] D;

Table of letter and object lefts.

7	1	S	Т	S	t
10.2	15.3	17.7	19.0	20.6	25.5

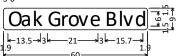


1.0" Radius, No border, White on Green; [Oak Grove Blvd] D;

Table of letter and object lefts.

O a k 1.9 7.2 12.1

2 14	12.1									
G	r	o	v	e						
18.4	23.8	26.9	31.2	36.0						
B	l	v	d							
42.4	47.9	50.0	54.8							

S-7

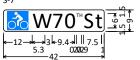

1.0" Radius, No border, White on Green; [W 70THSt] D;

Table of letter and object lefts.

W 12.0

2						
	7	0	T	Н	S	t
	20.3	25.5	30.4	31.6	33.5	38.3



1.0" Radius, No border, White on Green; [W 69THSt] D;

Table of letter and object lefts.

6	9	Т	Н	S	t
10.4	15.5	20.3	21.5	23.4	28.3




1.0" Radius, No border, White on Green; [W 68THSt] D;

Table of letter and object lefts.

W 2.1

6	8	T	Н	S	t
10.4	15.5	20.3	21.5	23.4	28.3

S-10

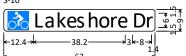


1.0" Radius, No border, White on Green; [Lakeshore Dr] D;

Table of letter and object lefts.

rable of letter and object letts.									
L 12.4	a k 16.9 21.		e 26.0	s 30.2	h 34.8	o 39.4	r 44.1	e 47.3	
	D 53.6	r 59.0							

S-11

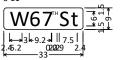

1.0" Radius, No border, White on Green; [W 67THSt] D;

Table of letter and object lefts.

W 2.4

_	7	-		(
ь	/		н	5	τ
106	150	20.0	21 2	22 1	20 0
10.0	13.6	20.0	21.2	23.1	20.0

 CONTRACTOR TO COORDINATE WITH CITY OF RICHFIELD FOR CREATION OF SIGNS.

BRYAN T. NEMETH 43354





12224 NICOLLET AVENUE BURNSVILLE, MINNESOTA 55337 Phone: (952) 890-0509 Email: Burnsville@bolton-menk.com www.bolton-menk.com





GNED	NO.	REVISION	DATE	OUTLY OF BUSINESS A MAINTERS TA
ZAP				CITY OF RICHFIELD, MINNESOTA
WN KA 45				CAR 457 3C3 033 IVAIDALE AVENUE RECONCERUCTION
KME				S.A.P. 157-363-032, LYNDALE AVENUE RECONSTRUCTION
BTN				SIGNING AND
NT PROJ. NO.				
T16114541				STRIPING PLANS


C7.55

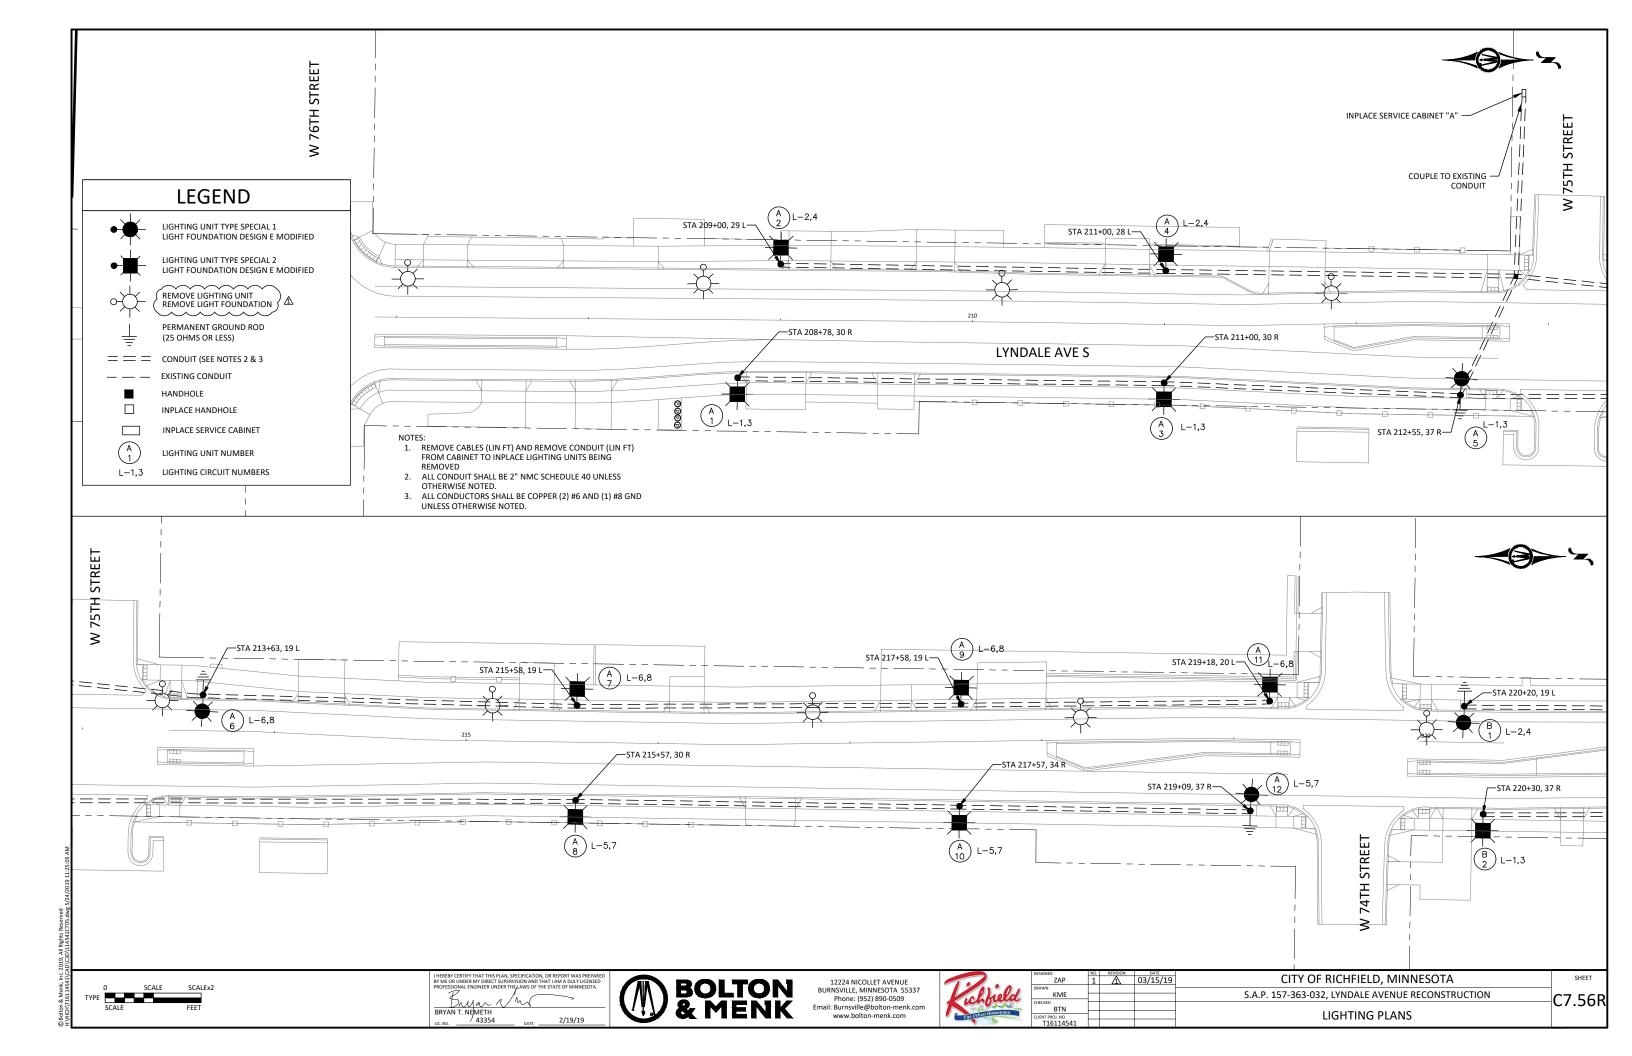

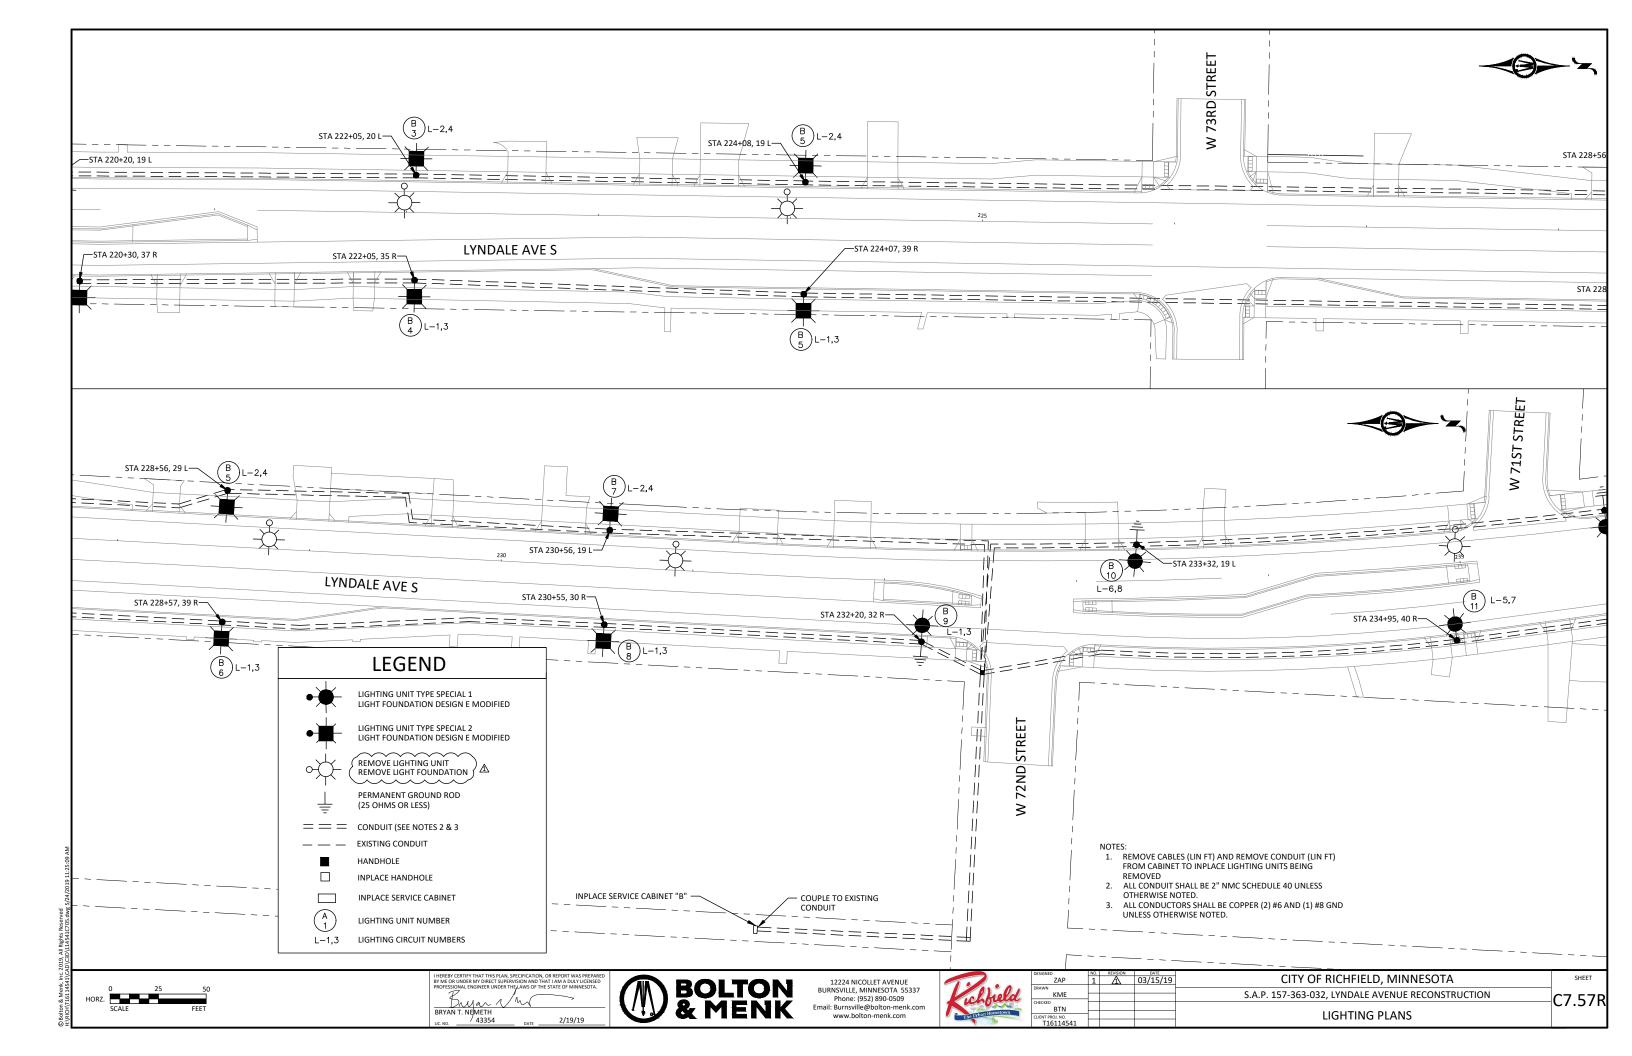

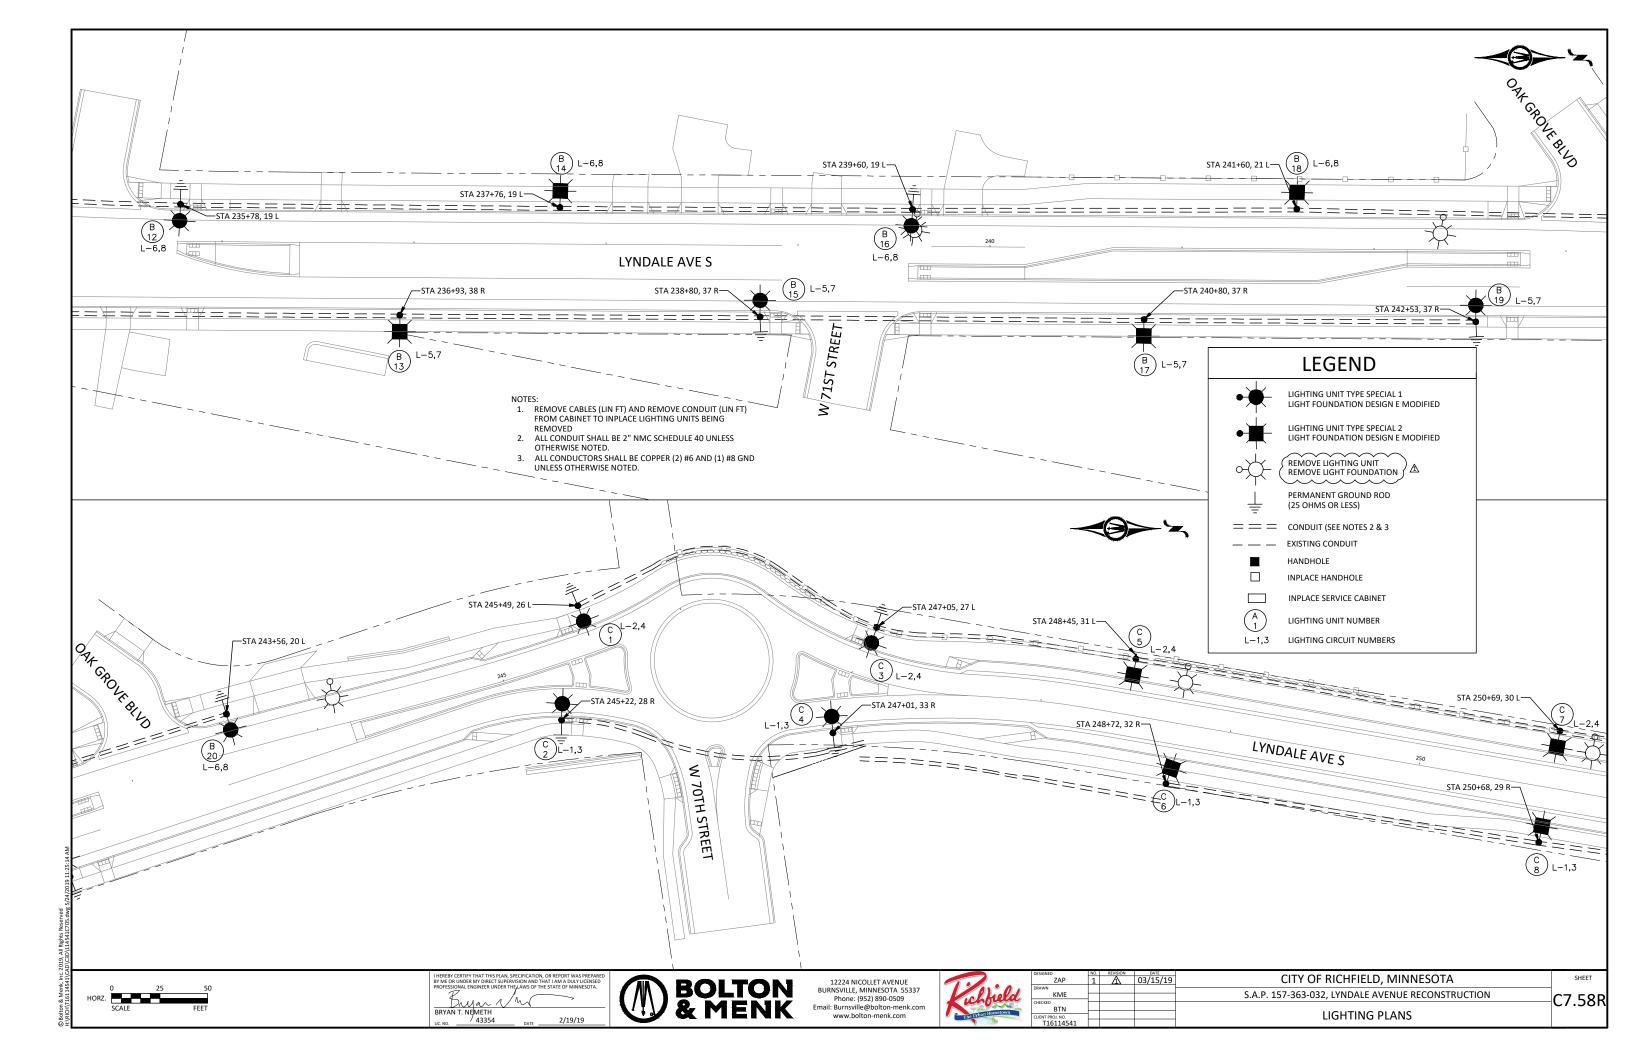

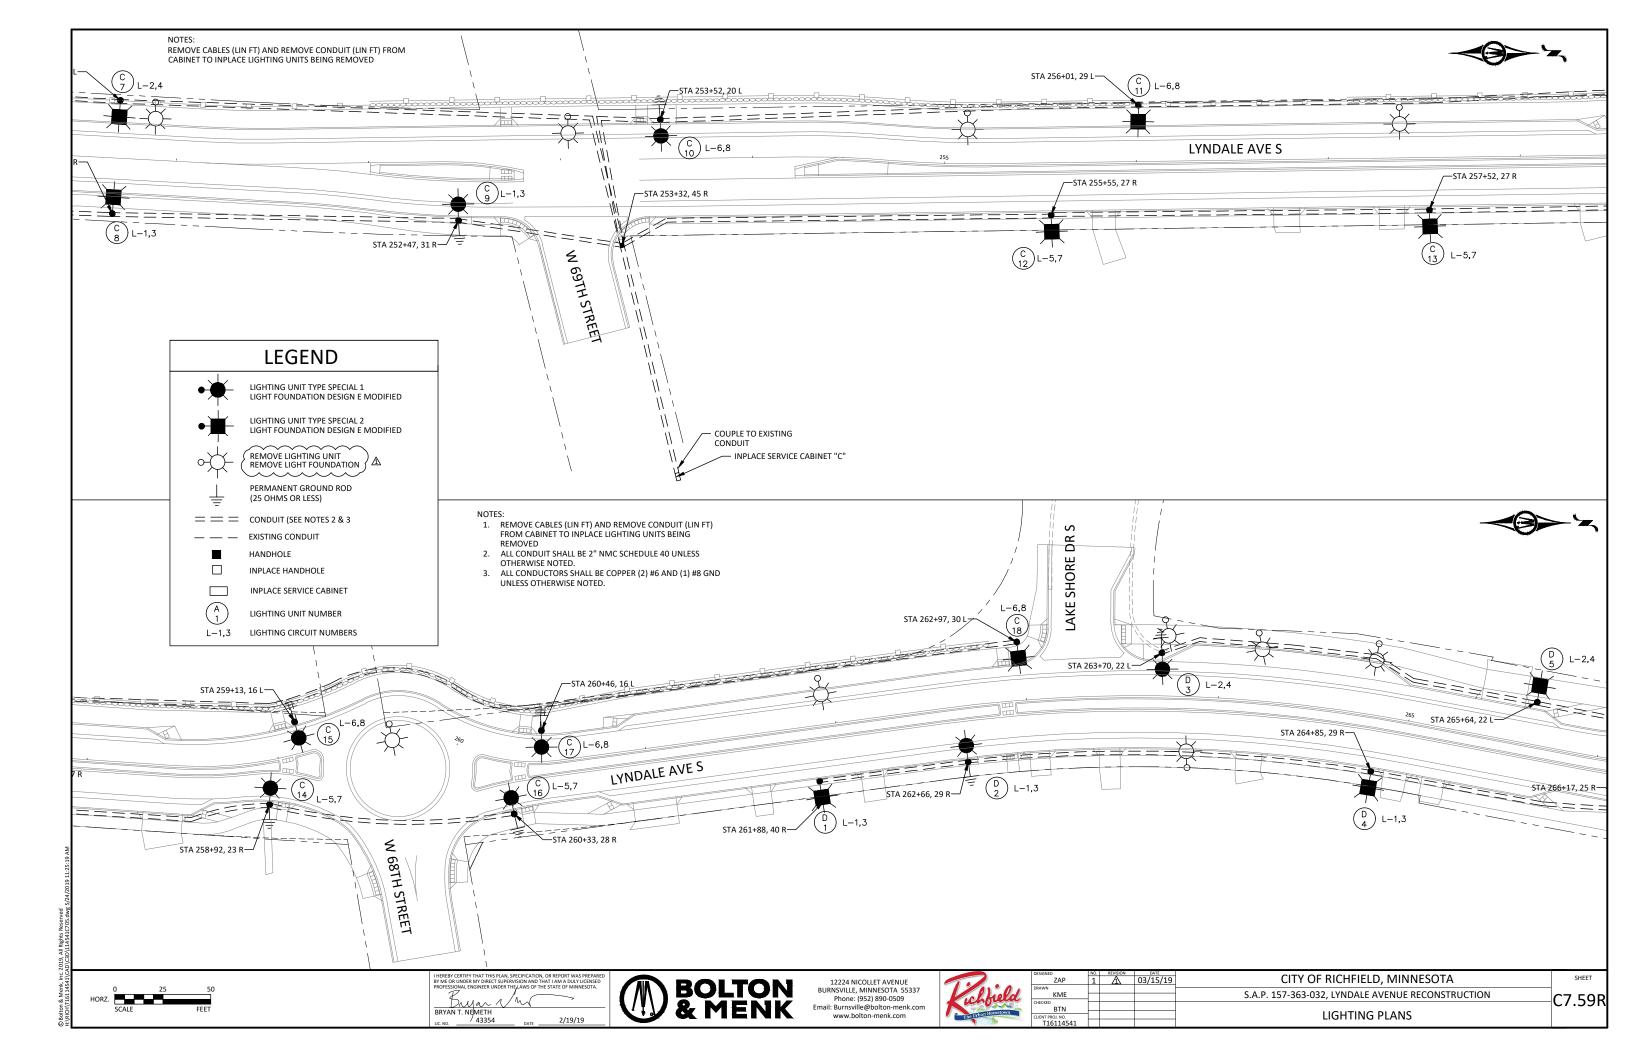

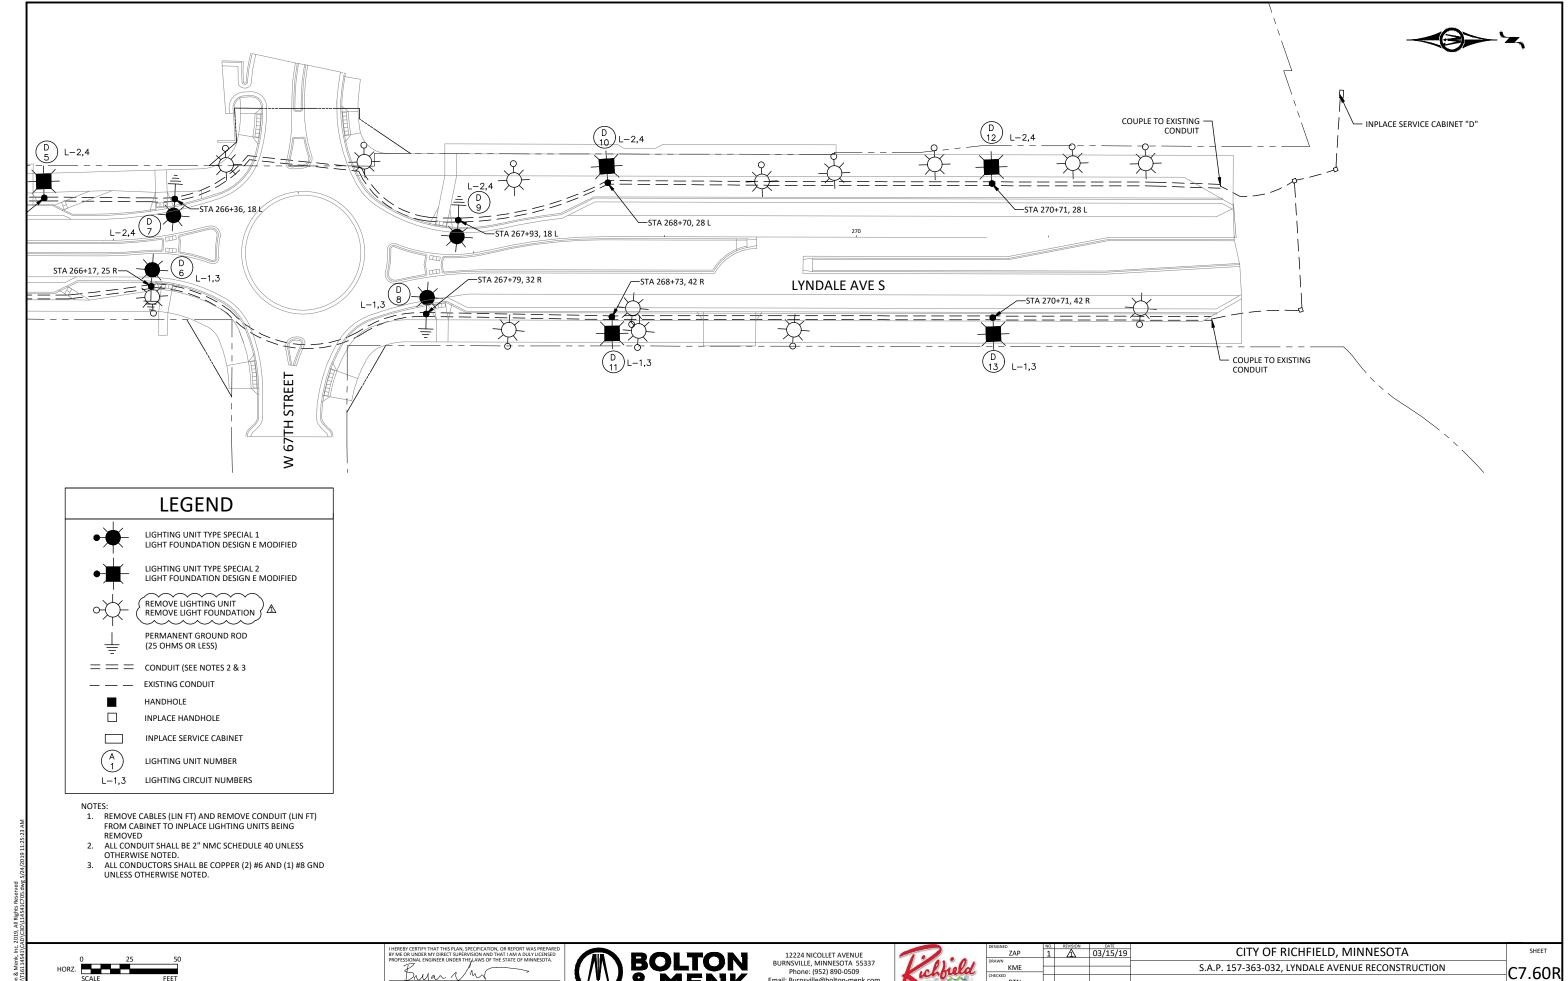

HORZ. SCALE

BRYAN T. NEMETH 43354



Phone: (952) 890-0509
Email: Burnsville@bolton-menk.com
www.bolton-menk.com

n	Richbielo The Urban Hometown


ESIGNED	NO.	REVISION	DATE	CITY OF PLOUFIE P. AMPLIES OF A
ZAP	1	Λ	03/15/19	CITY OF RICHFIELD, MINNESOTA
RAWN				
KME				S.A.P. 157-363-032. LYNDALE AVENUE RECONSTRUCTION
KIVIE	1			3.A.P. 137-303-032, LTINDALE AVENUE RECONSTRUCTION
HECKED	_			
BTN				
DIIN				LICHTING DI ANG
LIENT PROJ. NO.				LIGHTING PLANS
T1011111				


LIGHTING UNIT TYPE SPECIAL 1


LEOTEK LUMINAIRE: AR18-30M-MV-NW-3-BK-530-PCR7-SC-RPA HAPCO POLE: RTA30C7BF-BA

LIGHTING UNIT TYPE SPECIAL 2

CYCLONE LUMINAIRE:
CNM56P1-GAL-3-100W-4K-120-GCN15-DIM-CP4052-RAL9005TX
CYCLONE POLE:
PM43-16-SA-BM11-T40-CP4341-RAL9005TX
CYCLONE BRACKET:
M230-C1-S40-CP3731-RAL9005TX-7 PIN PC RECEPTACLE-SHORTING CAP

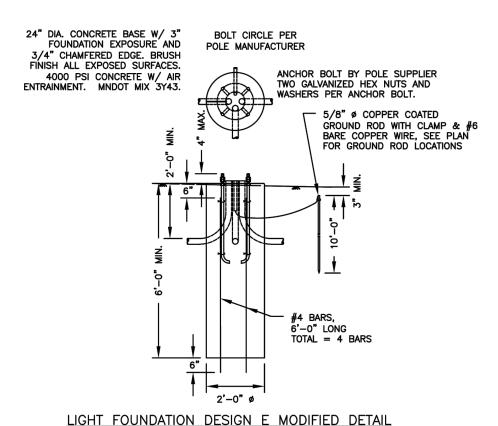

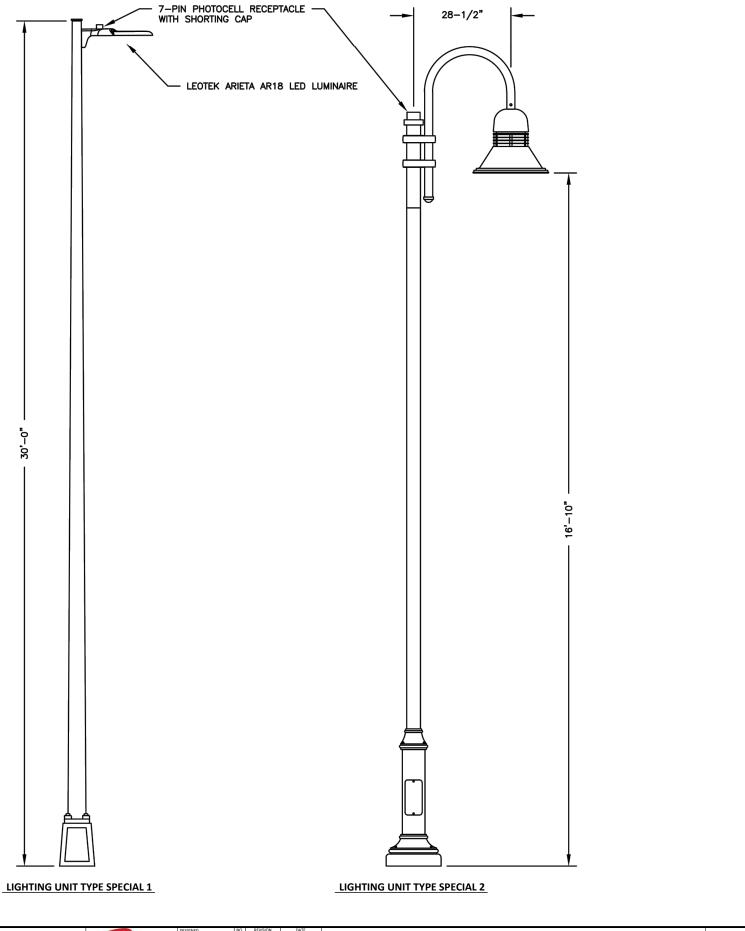


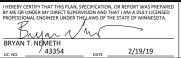






	DESIGNED	NO.	REVISION	DATE	CITY OF DICHEIELD MINNESOTA	SHEET
	ZAP				CITY OF RICHFIELD, MINNESOTA	SHEET
-0-1	DRAWN KME				S.A.P. 157-363-032, LYNDALE AVENUE RECONSTRUCTION	
eld	CHECKED	ш			3.A.F. 137-303-032, ETNDALE AVENUE RECONSTRUCTION	(7.61)
	BTN					۱۳۰۰۰
etown	CLIENT PROJ. NO. T16114541				LIGHTING PLANS	

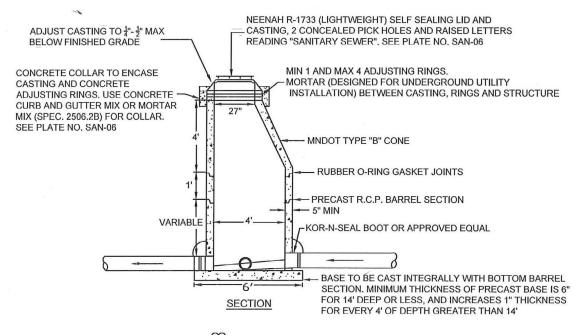

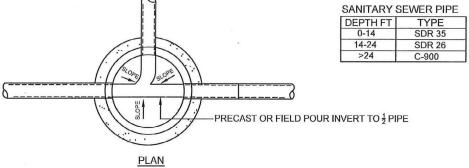

NOTES: 1, A MINIMUM FALL OF ,10' ON MANHOLES THROUGH STRUCTURES AND A MINIMUM FALL OF .20' ON MANHOLES WITH 90 DEGREE BENDS IS REQUIRED.

- 2. MANHOLES SHALL BE INSTALLED AT DISTANCES NO GREATER THAN 400' APART.
- 3. GROUT ALL INTERIOR DOGHOUSES AND LIFT HOLES TO INSPECTORS APPROVAL
- 4. MARKING POSTS SHALL BE SUPPLIED AND INSTALLED BY THE CONTRACTOR AT ALL MANHOLES LOCATED OUTSIDE OF THE STREET SECTION.
- 5. SERVICES SHALL NOT ENTER MANHOLES UNLESS APPROVED BY THE CITY ENGINEER.
- 6. NO MANHOLE STEPS ALLOWED.
- 7. 2", 4" AND 6" ADJUSTING RINGS ARE ACCEPTABLE.

STANDARD DETAIL NO. SAN-01

SANITARY STANDARD APPROVAL 12/6 20 17 **MANHOLE**

CITY ENGINEER

Lim Lau

CITY OF RICHFIELD **ENGINEERING** DIVISION













SANITARY DROP

MANHOLE



S.A.P. 157-363-032, LYNDALE AVENUE RECONSTRUCTION

14-24 **SDR 26** >24 C-900 GROUT TO PIPE PLAN SECTION HORSESHOE DETAIL **PLAN**

DEPTH FT

0-14

SANITARY SEWER PIPE

TYPE

SDR 35

NEENAH R-1733 (LIGHTWEIGHT) SELF SEALING LID AND

READING "SANITARY SEWER", SEE PLATE NO. SAN-06

MIN 1 AND MAX 4 ADJUSTING RINGS.

-MNDOT TYPE "B" CONE

5" MIN-

2' MIN PAY

SECTION

LENGTH

VARIABLE

- CASTING, 2 CONCEALED PICK HOLES AND RAISED LETTERS

MORTAR (DESIGNED FOR UNDERGROUND UTILITY

RUBBER O-RING GASKET JOINTS

PRECAST R.C.P. BARREL SECTION

INSTALLATION) BETWEEN CASTING, RINGS AND STRUCTURE

-KOR-N-SEAL BOOT OR APPROVED FOUAL

DIRECTED BY THE ENGINEER)

8" 90 DEGREE DIP ELBOW

DEPTH GREATER THAN 14'

-COMPACTED GRANULAR BACKFILL

8" DUCTILE IRON PIPE TO UNDISTURBED

CONCRETE HORSESHOES WITH MORTAR JOINTS

BASE TO BE CAST INTEGRALLY WITH BOTTOM

INCREASES 1" OF THICKNESS FOR EVERY 4' OF

BARREL SECTION. MINIMUM THICKNESS OF PRECAST BASE IS 6" FOR 14' DEEP OR LESS, AND

- SOIL OR MIN. 20 FT (POLY ENCASEMENT WHEN

ADJUST CASTING TO 4"- 1" MAX

BELOW FINISHED GRADÉ

CONCRETE COLLAR TO ENCASE

ADJUSTING RINGS. USE CONCRETE

CURB AND GUTTER MIX OR MORTAR

MIX (SPEC. 2506.2B) FOR COLLAR

CASTING AND CONCRETE

SEE PLATE NO. SAN-06

- 1. A MINIMUM FALL OF .10' ON MANHOLES THROUGH STRUCTURES AND A MINIMUM FALL OF .20' ON MANHOLES WITH 90 DEGREE BENDS IS REQUIRED.
- 2. MANHOLES SHALL BE INSTALLED AT DISTANCES NO GREATER THAN 400' APART.
- 3. GROUT ALL INTERIOR DOGHOUSES AND LIFT HOLES TO INSPECTOR'S APPROVAL
- 4. MARKING POSTS SHALL BE SUPPLIED AND INSTALLED BY THE CONTRACTOR AT ALL MANHOLES LOCATED OUTSIDE OF STREET SECTION.
- 5. SERVICES SHALL NOT ENTER MANHOLES UNLESS APPROVED BY THE CITY ENGINEER.
- 6. NO INSIDE DROPS ALLOWED.
- 7. HORSESHOES SHALL BE FILLED WITH CONCRETE MORTAR ON ALL SIDES.
- 8. NO MANHOLE STEPS ALLOWED.
- 9. 2", 4" AND 6" ADJUSTING RING ARE ACCEPTABLE.

CITY OF RICHFIELD **ENGINEERING** DIVISION

CITY OF RICHFIELD. MINNESOTA


C8.01


CITY ENGINEER

STANDARD

DETAIL NO.

SAN-02

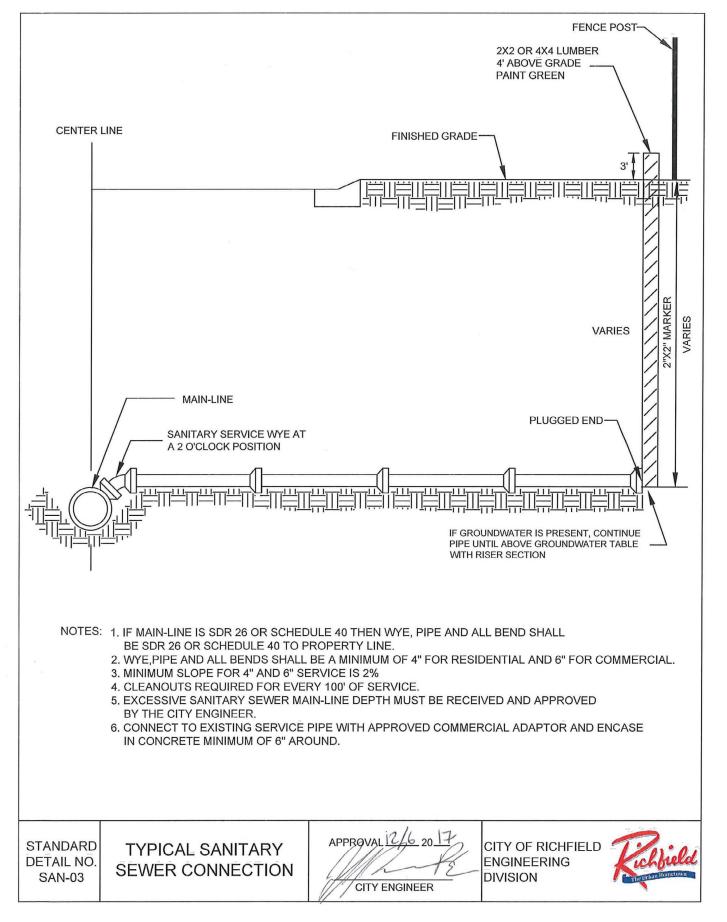

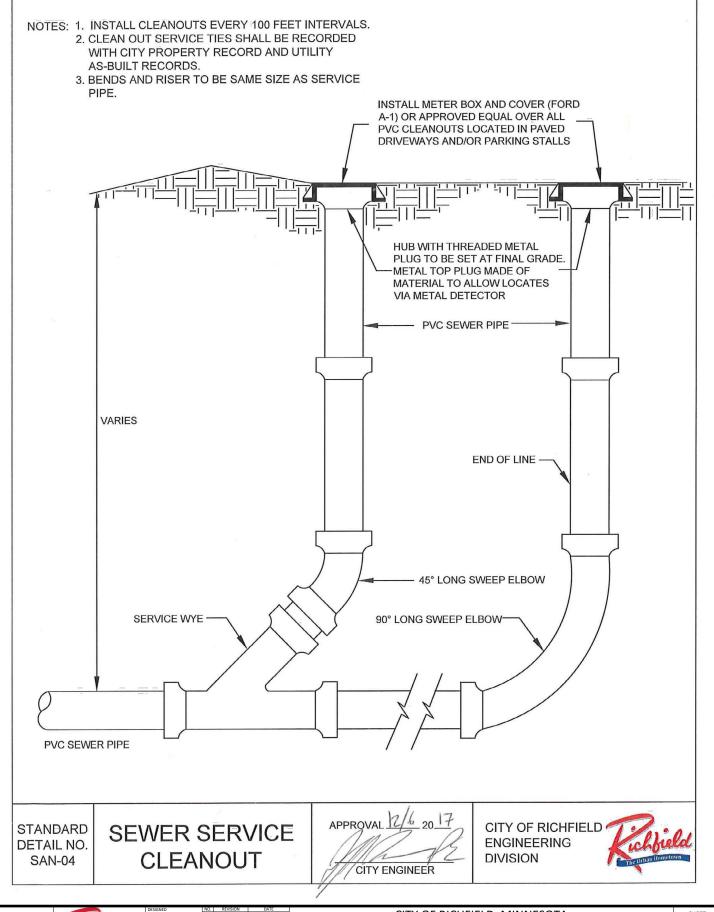












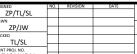

CITY OF RICHFIELD, MINNESOTA
S.A.P. 157-363-032, LYNDALE AVENUE RECONSTRUCTION

STANDARD PLAN

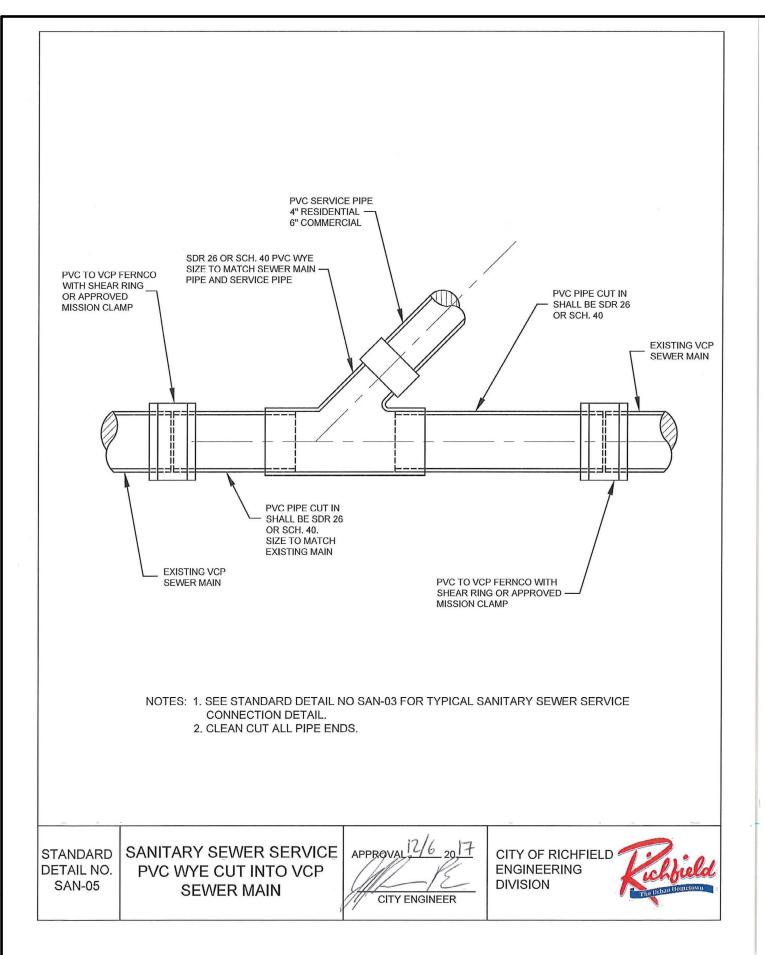

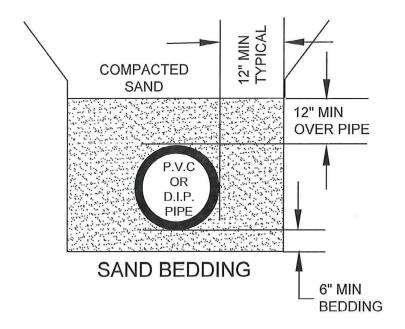

NOTES: 1. BEDDING SHALL BE CONSIDERED INCIDENTAL TO THE PIPE UNLESS MODIFIED IN THE CONTRACT DOCUMENTS.

2. BEDDING REQUIRED FOR ALL MAINS AND SERVICES.

STANDARD DETAIL NO. SAN-07

SANITARY SEWER BEDDING APPROVAL 12/7 20 17 CITY ENGINEER

CITY OF RICHFIELD ENGINEERING DIVISION



I HEREBY CERTIFY THAT THIS PLAN, SPECIFICATION, OR REPORT WAS PREPARED BY ME OR UNDER MY DIRECT SUPERVISION AND THAT I AM A DULY LICENSED PROFESSIONAL ENGINEER INDER THE LAWS OF THE STATE OF MINISEOTIA.

TIM LAMKIN JR.

LIC NO. 47099


DATE 2/19/19






	DESIGN
Lield	DRAW
an Hometown	CHECK
an Hometown	CLIENT

NED	NO.	REVISION	DATE
ZP/TL/SL			
/N /			
ZP/JW			
KED .			
TL/SL	\vdash		
T PROJ. NO.			

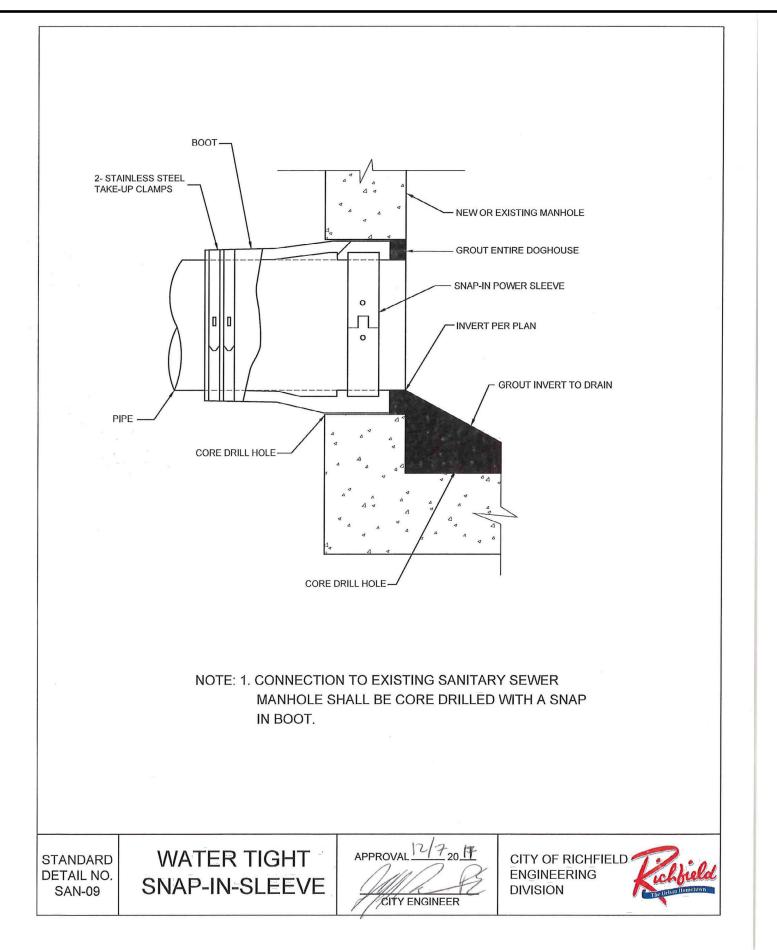

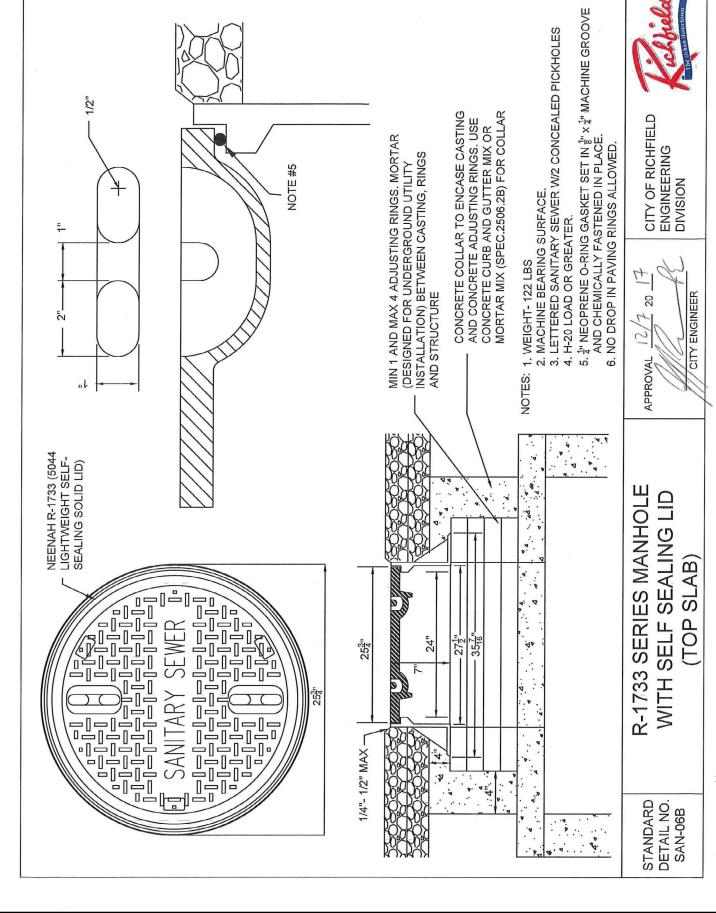

TIM LAMKIN JR.











CITY OF RICHFIELD, MINNESOTA

S.A.P. 157-363-032, LYNDALE AVENUE RECONSTRUCTION STANDARD PLAN

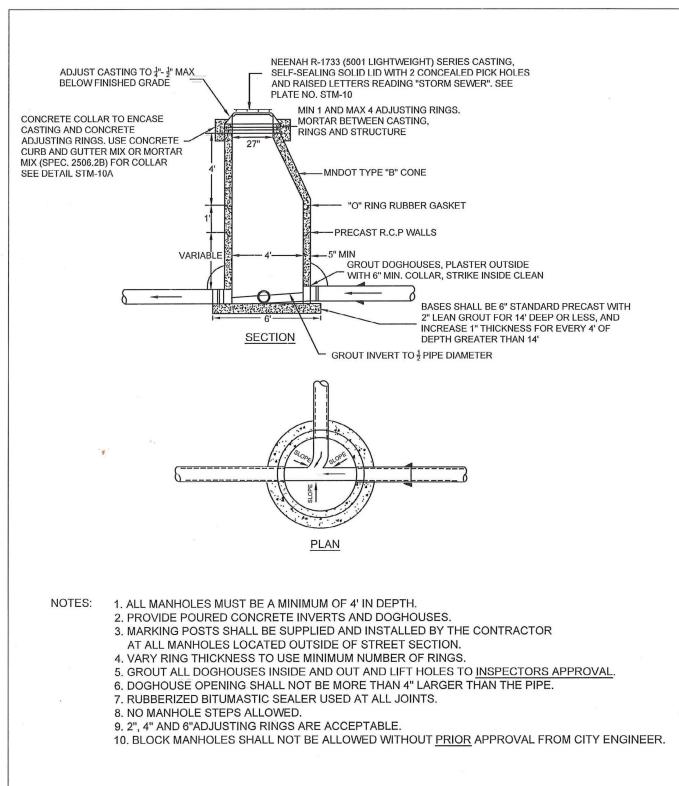

12224 NICOLLET AVENUE BURNSVILLE, MINNESOTA 55337 Phone: (952) 890-0509 www.bolton-menk.com

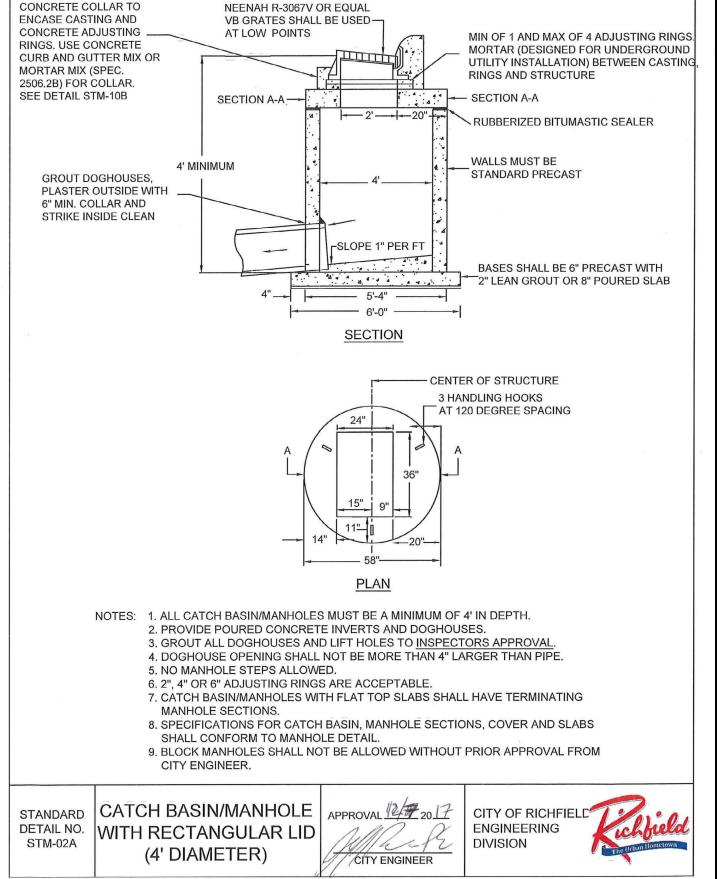



CITY ENGINEER

APPROVAL 17/7/201



CITY OF RICHFIELD

ENGINEERING

DIVISION



STANDARD PLAN


STANDARD


DETAIL NO.

STM-01

STORM STANDARD

MANHOLE

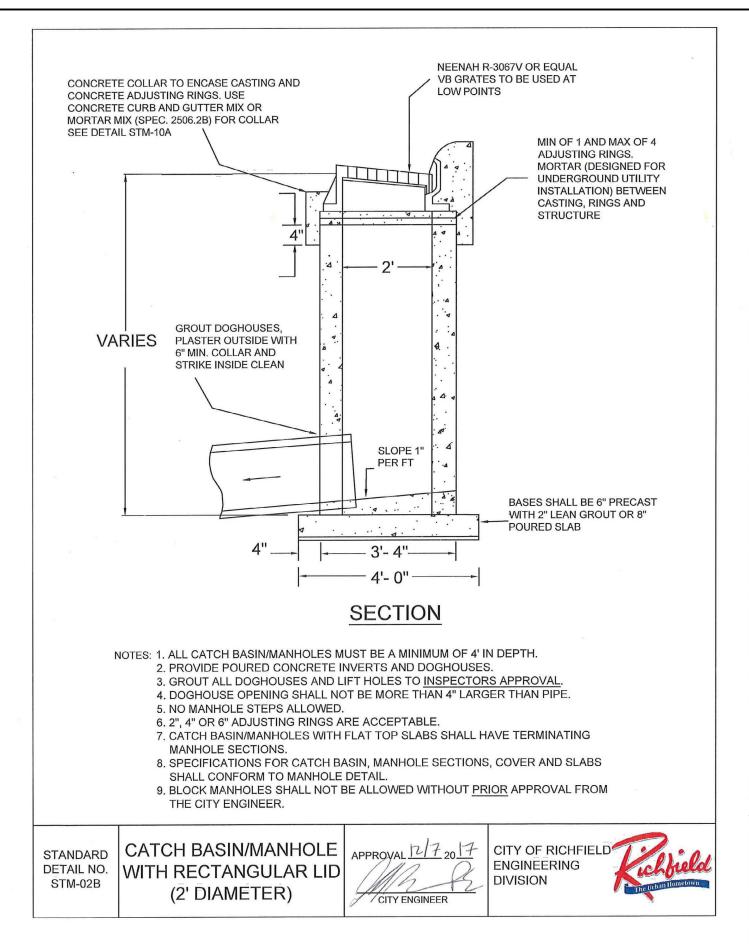

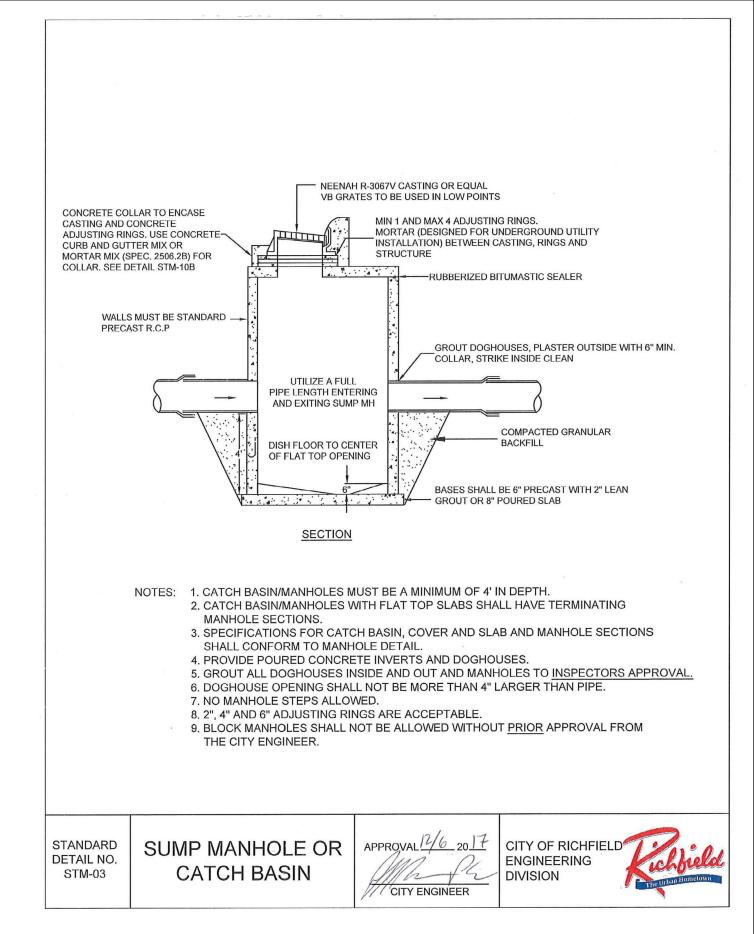











DESIGNED	NO.	REVISION	
ZP/TL/SL			
DRAWN			
ZP/JW			
CHECKED			
TL/SL			
LIENT PROJ. NO.			

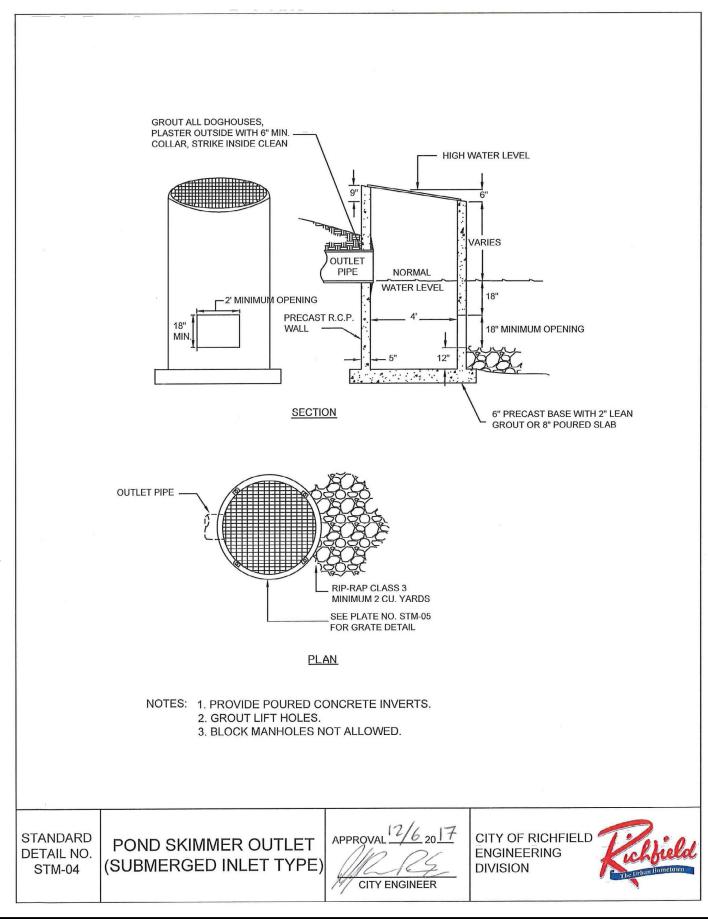

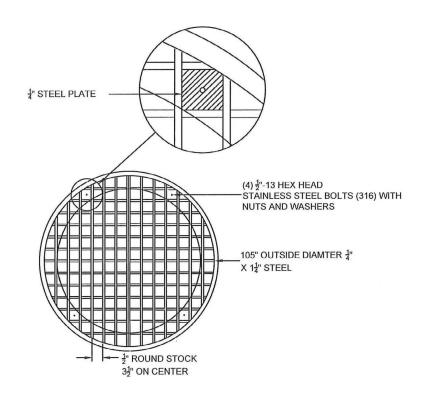

NOTES: 1. GRATE TO BE TWO PIECES.

2. ALL METAL TO BE HOT-DIPPED GALVANIZED.

STANDARD DETAIL NO. STM-05 POND SKIMMER GRATĒ APPROVAL 2017

CITY ENGINEER

CITY OF RICHFIELD ENGINEERING DIVISION



I HEREBY CERTIFY THAT THIS PLAN, SPECIFICATION, OR REPORT WAS PREPARED BY ME OR UNDER MY DIRECT SUPERVISION AND THAT I AM A DULY LICENSED PROFESSIONAL ENGINEER UNDER THE LAWS OF THE STATE OF MINISCOTA.

TIM LAMKIN JR.

UC NO. 47099

DATE

2/19/19



12224 NICOLLET AVENUE BURNSVILLE, MINNESOTA 55337 Phone: (952) 890-0509 Email: Burnsville@bolton-menk.com www.bolton-menk.com



DESIGNED
ZP/TL/S
DRAWN
ZP/JW
CHECKED
TL/SL
CLIENT PROJ. NO.

	NO.	REVISION	DATE	
/TL/SL				
P/JW				
L/SL				
436				

....

SHEET C8.07


STANDARD PLAN

CITY OF RICHFIELD, MINNESOTA

S.A.P. 157-363-032, LYNDALE AVENUE RECONSTRUCTION

Bolton & Menk, Inc. 2019, All \RICH\T16114541\CAD\C3D\

I A N

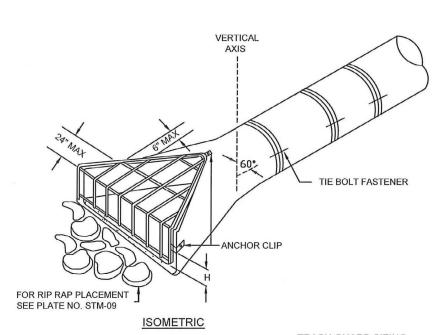



TIE BOLT & FASTENER ASSEMBLY SEE PLATE NO. STM-08

TRASH GUARD SIZING

PIPE	BOLT		
0.00			
SIZE	DIAMETER	BARS	Н
(IN.)	(IN.)	(IN.)	(IN.)
15	5/8	3/4	4
18	5/8	3/4	4
21	3/4	1	6
24	3/4	1	6
27	3/4	1	6
30	3/4	1	6
36	3/4	1	6
42	3/4	1	6
48	1	1 1/4	12

NOTES: 1. USE TWO TIE BOLT FASTENERS PER JOINT INSTALLED AT 60 DEGREES FROM TOP OF PIPE.

- 2. LAST THREE JOINTS SHALL BE TIED.
- 3. TYING AND TRASH GUARD SHALL BE INCLUDED IN THE UNIT PRICE BID FOR APRON SECTION.
- 4. BARS AND PLATES ARE HOT-ROLLED STEEL.
- 5. BARS, PLATES, PIPE AND BOLTS ARE GALVANIZED.
- 6. MARKING POSTS SHALL BE SUPPLIED AND INSTALLED BY THE CONTRACTOR.


STANDARD DETAIL NO. STM-07

STANDARD FLARED **END SECTION AND** TRASH GUARD

APPROVAL 12/6 2017 ///CITY ENGINEER

CITY OF RICHFIELD **ENGINEERING** DIVISION



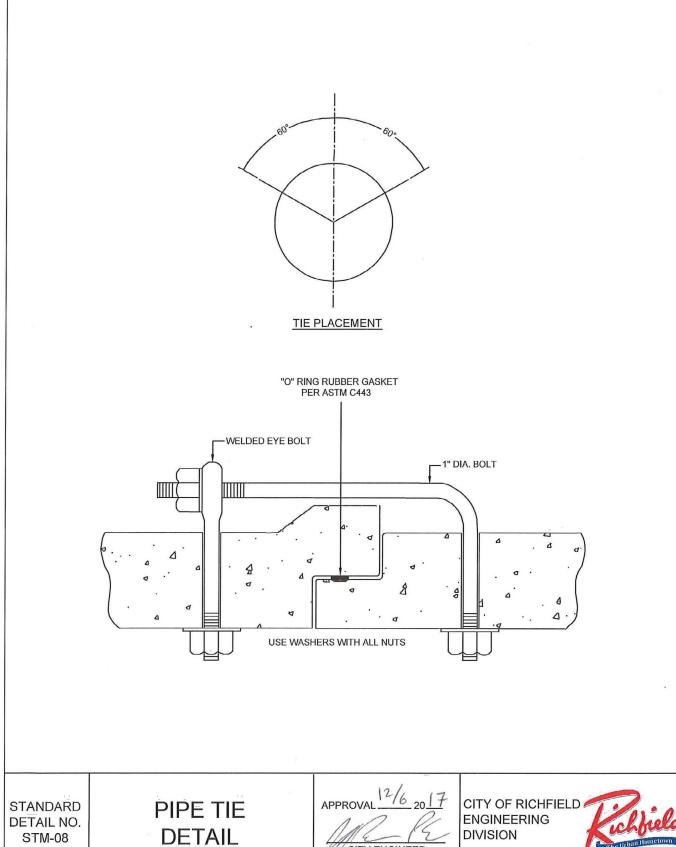

BOLTON & MENK

12224 NICOLLET AVENUE BURNSVILLE, MINNESOTA 55337


Phone: (952) 890-0509 Email: Burnsville@bolton-menk.com

www.bolton-menk.com



STANDARD PLAN

CITY ENGINEER

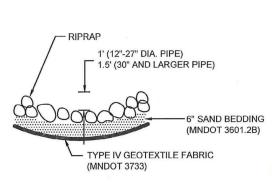


MINIMUM RIPRAP REQUIRED					
DIA. OF PIPE (IN.)	L (FT.)	QUANTITY (C.Y.)	CLASS		
12	8	5	Ш		
15	8	5	Ш		
18	10	6	III		
24	12	8	III 。		
30	14	12	III		
36	16	14	Ш		
42	18	22	IV		
48	20	26	IV		
>48	22-28	30-40	IV		

SECTION B-B

STANDARD

DETAIL NO.

STM-09

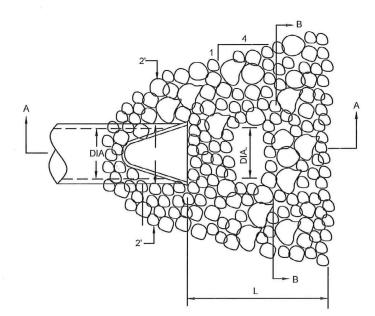

RIPRAP DETAIL FOR

FLARED END SECTIONS


TIE THE LAST 3 JOINTS ON INLET AND OUTLET PIPES AND BED IN GRANULAR MATERIAL. ANY COVER LESS THAN 2' OVER TOP OF PIPE SHALL BE GRANULAR MATERIAL.


FLARED END SECTION SHALL BE INSTALLED ON RIP RAP FOR THE LAST 2'.

CITY OF RICHFIELD

ENGINEERING

DIVISION

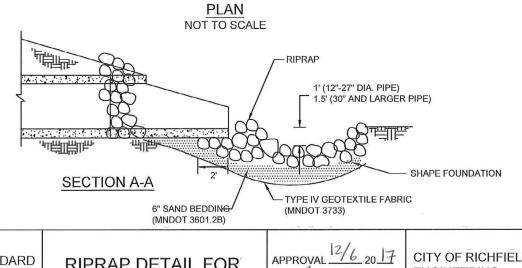

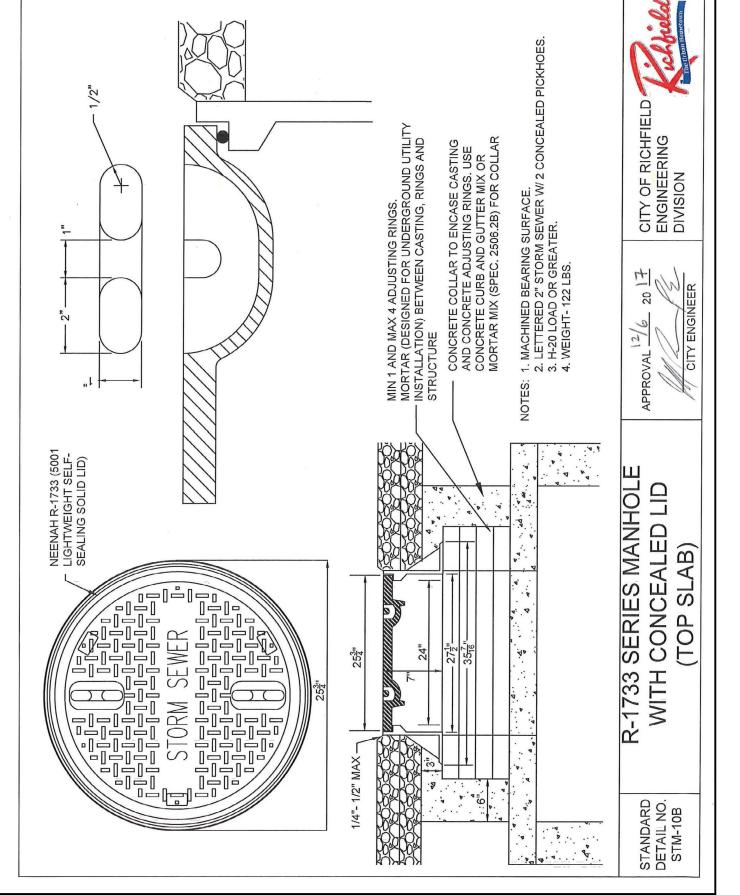



CITY ENGINEER





12224 NICOLLET AVENUE BURNSVILLE, MINNESOTA 55337 Phone: (952) 890-0509 Email: Burnsville@bolton-menk.com www.bolton-menk.com



CITY OF RICHFIELD, MINNESOTA S.A.P. 157-363-032, LYNDALE AVENUE RECONSTRUCTION

STANDARD PLAN

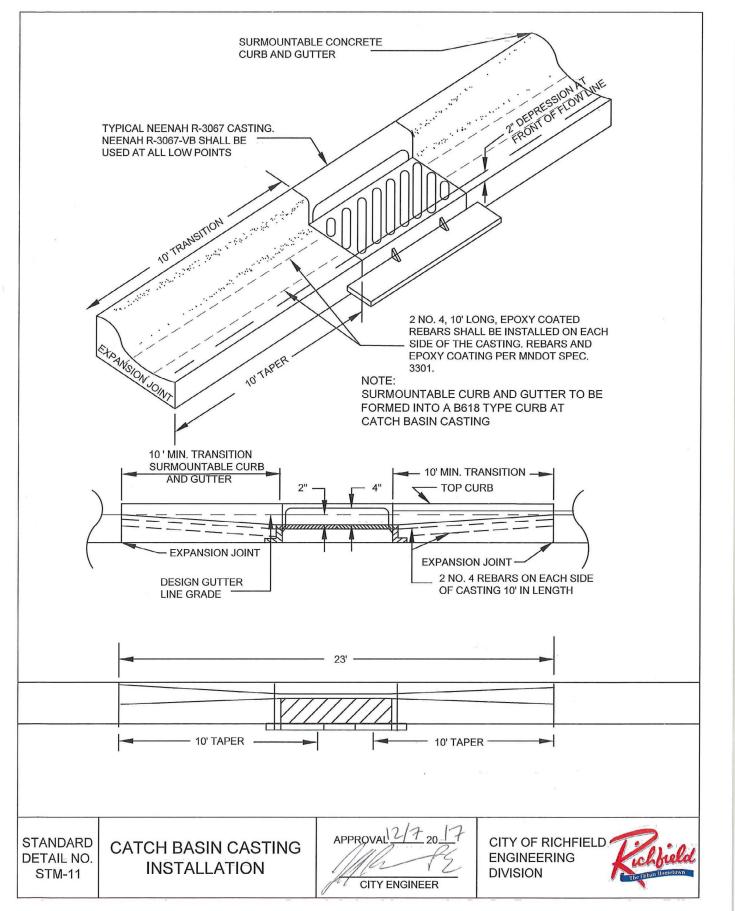

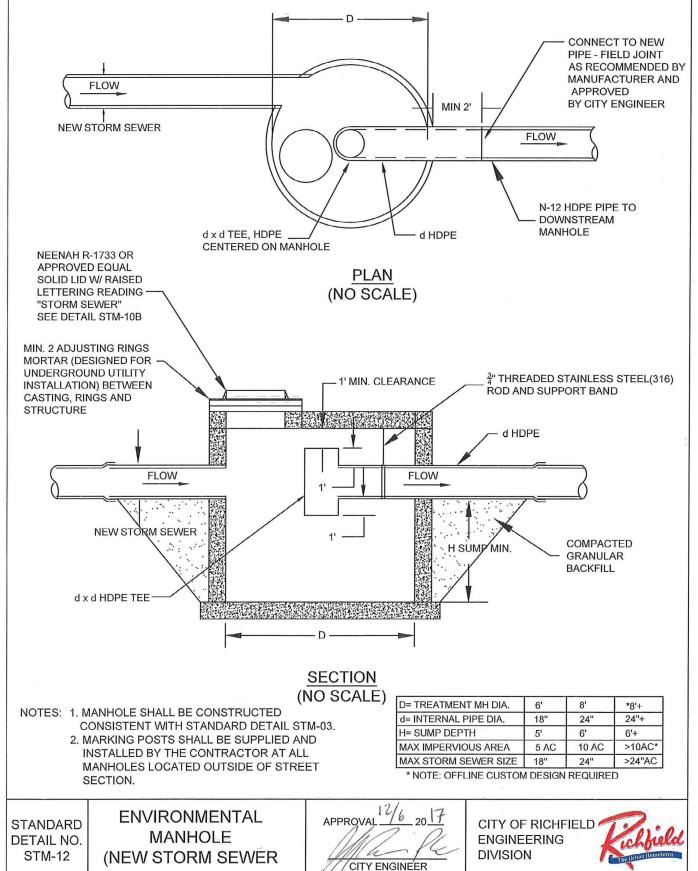

Lim Lan



12224 NICOLLET AVENUE BURNSVILLE, MINNESOTA 55337 Phone: (952) 890-0509 www.bolton-menk.com



DESIGNED	NO.	REVISION
ZP/TL/SL		
DRAWN		
ZP/JW		
CHECKED	\vdash	
TL/SL		
CLIENT PROJ. NO.		





CITY OF RICHFIELD, MINNESOTA

S.A.P. 157-363-032, LYNDALE AVENUE RECONSTRUCTION

C8.10

STANDARD PLAN

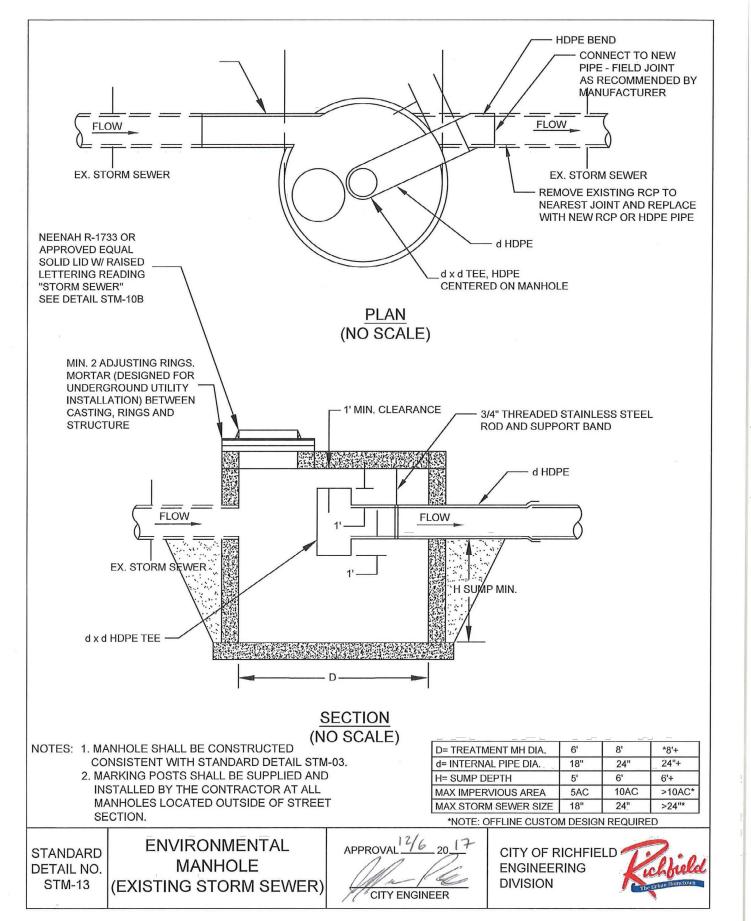

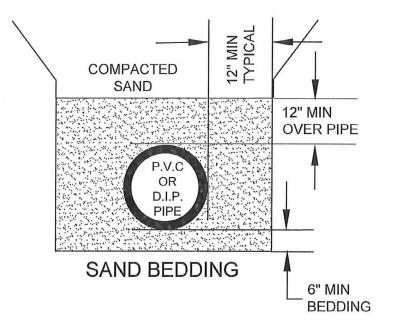

NOTES: 1. BEDDING SHALL BE CONSIDERED INCIDENTAL TO THE PIPE UNLESS MODIFIED IN THE CONTRACT DOCUMENTS.

2. BEDDING REQUIRED FOR ALL MAINS AND SERVICES.

STANDARD DETAIL NO. STM-14

STORM SEWER BEDDING

APPROVAL 27 20 17

CITY ENGINEER

CITY OF RICHFIELD ENGINEERING DIVISION



HEREBY CERTIFY THAT THIS PLAN. SPECIFICATION, OR REPORT WAS PREPARED BY ME OR UNDER MY DIRECT SUPERVISION AND THAT I AM A DULY LICENSED PROFESSIONAL ENGINEER UNDER THE LAWS OF THE STATE OF MINNESOTA.

TIM LAMKIN JR.

47099

DATE

2/19/19



12224 NICOLLET AVENUE
BURNSVILLE, MINNESOTA 55337
Phone: (952) 890-0509
Email: Burnsville@bolton-menk.com
www.bolton-menk.com



ld	DESIGNED ZP/TL
	DRAWN ZP/J
	CHECKED TL/S
	CLIENT PROJ. N


	NO.	REVISION	DATE	
TL/SL				
/JW				S.A.P. 1
	\vdash			
/SL	\vdash			
	1	1	1	


The Urban Hometown

SHEET

C8.11

CITY OF RICHFIELD, MINNESOTA

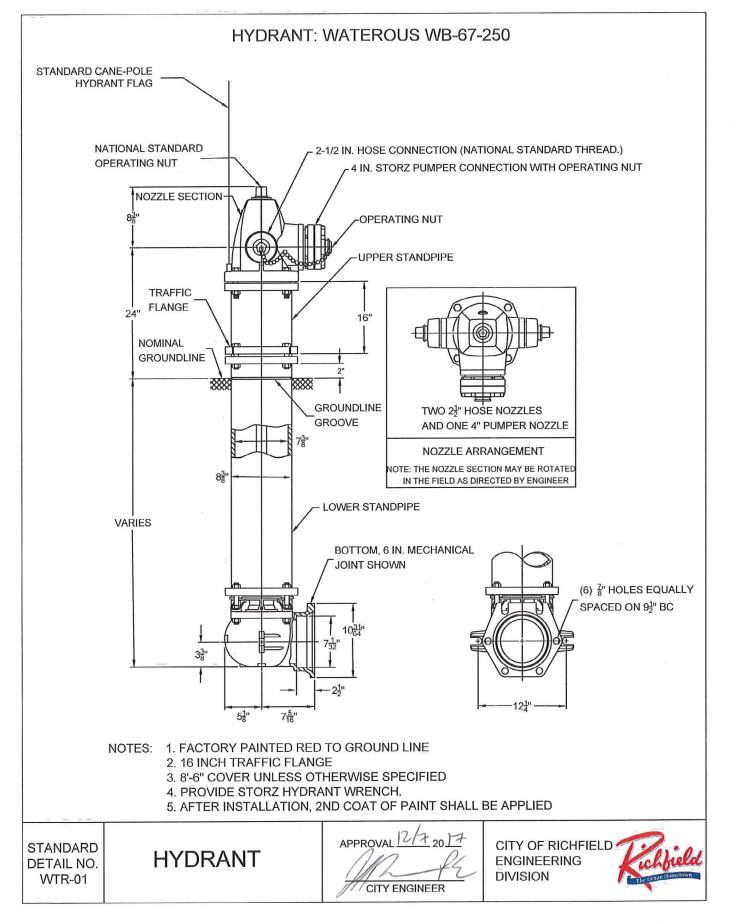

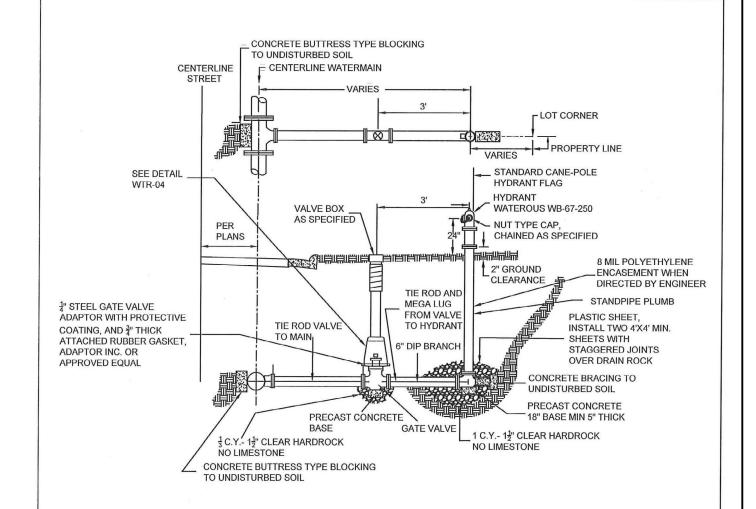

NOTES: 1. ALL HYDRANTS MUST BE 8.5' BURY UNLESS SHOWN OTHERWISE.


- 2. ALL HYDRANT VALVES TO BE LOCATED IN THE BOULEVARD WHEN POSSIBLE.
- 3. AMERICAN FLOW CONTROL 2500 SERIES RESILIENT WEDGE TYPE GATE OR APPROVED EQUAL
- 4. TIE RODS TO BE $\frac{3}{4}$ " DIAMETER THREADED (316) STAINLESS STEEL. SEE DETAIL WTR-11.
- 5. ALL WATERMAIN BOLTS SHALL BE COR-BLUE OR APPROVED EQUAL
- 6. POURED CONCRETE OR PRECAST BLOCKS TO BE USED FOR BRACING (NO WOOD, CURBING, SIDEWALK, ETC.) PER INSPECTORS APPROVAL.
- 7. ALL JOINTS MUST BE RESTRAINED.
- 8. ALL HYDRANT BARRELS SHALL BE WRAPPED WITH POLYETHYLENE ENCASEMENT AS DIRECTED BY THE ENGINEER.
- 9. WHERE HYDRANT BASE IS IN OR NEAR WATER TABLE, THE WEEPHOLE SHALL BE PLUGGED. AFFIX "PUMP AFTER USE" TAG TO HYDRANT.
- 10.ALL EXPOSED WATERMAIN SHALL BE WRAPPED IN POLYETHYLENE IN ACCORDANCE WITH AWWA C105 AS DIRECTED BY THE ENGINEER.
- 11. HYDRANT TO BE SECURELY COVERED WITH PLASTIC WRAP OR TAGGED TO INDICATE IT IS OUT OF SERVICE.
- 12. ALL COMPONENTS OF PIPE FITTINGS, VALVES, HYDRANTS, ETC, SHALL BE CERTIFIED AS LEAD-FREE AS PER SECTION 1417 OF THE FEDERAL SAFE DRINKING WATER ACT.

STANDARD DETAIL NO. WTR-02

HYDRANT INSTALLATION CITY ENGINEER

CITY OF RICHFIEL **ENGINEERING** DIVISION



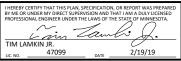




12224 NICOLLET AVENUE BURNSVILLE, MINNESOTA 55337 Phone: (952) 890-0509 www.bolton-menk.com




	DESIGNED
	ZP/TL/SL
	DRAWN
/	ZP/JW
	CHECKED
95	TL/SL
	CLIENT PROJ. NO.
	TACAAAFAA

CITY OF RICHFIELD. MINNESOTA S.A.P. 157-363-032, LYNDALE AVENUE RECONSTRUCTION

STANDARD PLAN

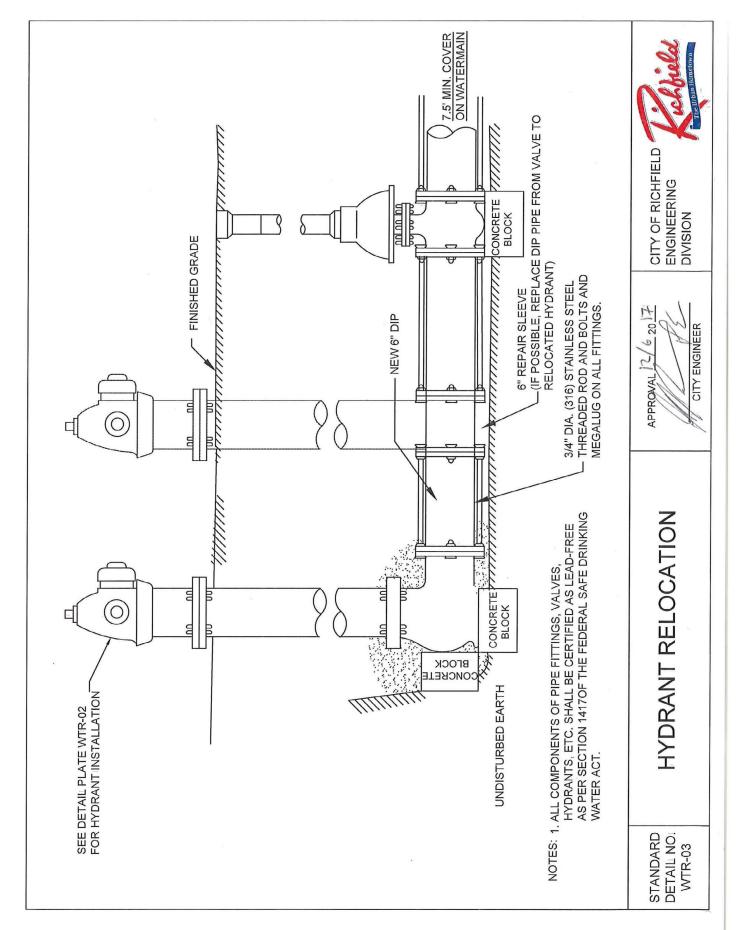

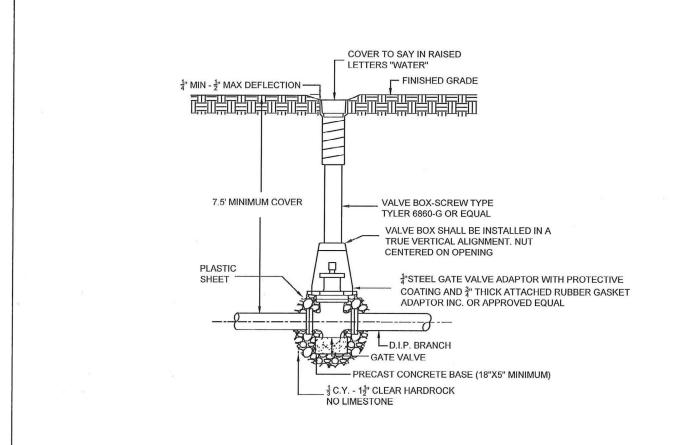


NOTES: 1. HYDRANT, STUB & SERVICE VALVES SHALL BE RODDED TO THE MAIN AND MEGALUG ON ALL FITTINGS.

- 2. AMERICAN FLOW CONTROL 2500 SERIES RESILIENT WEDGE TYPE OR APPROVED EQUAL.
- 3. TIE RODS AND MEGALUG FROM VALVE TO HYDRANT.
- 4. TIE RODS TO BE 3" DIAMETER THREADED (316) STAINLESS STEEL SEE DETAIL WTR-11...
- 5. ALL WATERMAIN BOLTS SHALL BE COR-BLUE OR APPROVED EQUAL.
- 6. NO INSIDE ADJUSTMENT SECTIONS ALLOWED (I.E. NO INSERTS)
- 7. CONTRACTOR TO PROVIDE A FENCE T-POST AND SHALL BE INSTALLED BY THE CONTRACTOR AT ALL GATE VALVES LOCATED OUTSIDE OF STREET SECTIONS. PAINT BLUE.
- 8. ALL COMPONENTS OF PIPE FITTINGS, VALVES, HYDRANTS, ETC. SHALL BE CERTIFIED AS LEAD-FREE AS PER SECTION 1417 OF THE FEDERAL SAFE DRINKING WATER ACT.

STANDARD DETAIL NO. WTR-04

VALVE BOX INSTALLATION

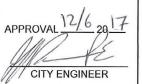

CITY OF RICHFIELD **ENGINEERING** DIVISION



Lim Zan



12224 NICOLLET AVENUE BURNSVILLE, MINNESOTA 55337 Phone: (952) 890-0509 www.bolton-menk.com





	DESIGNED
	ZP/TL/SL
	DRAWN
	ZP/JW
-	CHECKED
	TL/SL
	CLIENT PROJ. NO.
	T1C11AFA1

CITY OF RICHFIELD, MINNESOTA

S.A.P. 157-363-032, LYNDALE AVENUE RECONSTRUCTION

STANDARD PLAN

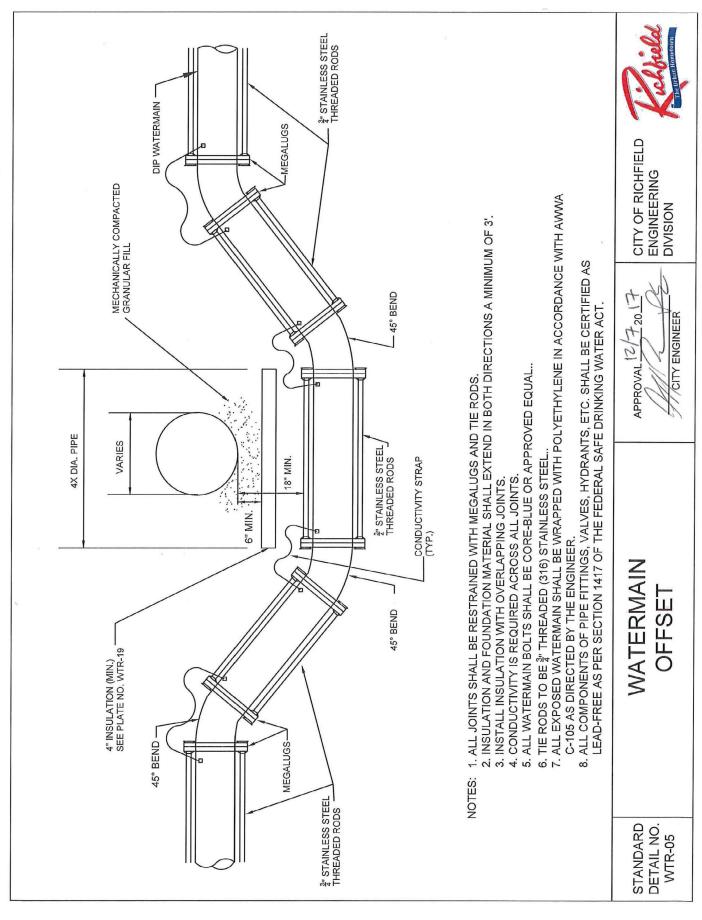

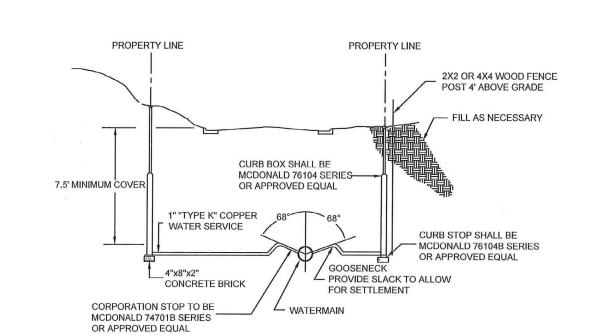

NOTES: 1. ALL IRRIGATION SERVICES TO BE 4" DIP UNLESS DIRECTED BY THE ENGINEER.

- 2. NO COPPER TO COPPER CONNECTIONS SHALL BE MADE IN THE PUBLIC RIGHT-OF-WAY.
- 3. MCDONALD TYPE A STYLE RECESSED COVER FRAME, 674M SERIES (4" BURY DEPTH) OR APPROVED EQUAL FOR CURB BOXES IN DRIVEWAYS, SIDEWALKS, OR PARKING AREAS.
- 4. ADJUST CURB STOP TOP 1" BELOW FINISHED GRADE.
- 5. CAP OR PIGTAIL HOUSE SIDE OF THE CURB STOP TO KEEP CLEAN.
- 6. STATIONARY RODS (CURB STOP) ARE NOT ALLOWED.
- 7. CURB STOP BOX SHALL BE TURNED TO BE READ FROM THE STREET.
- 8. SADDLES ON 6" DIP OR SMALLER MAINS.
- 9. ALL COMPONENTS OF PIPE FITTINGS, VALVES, HYDRANTS, ETC. SHALL BE CERTIFIED AS LEAD-FREE AS PER SECTION 1417 OF THE FEDERAL SAFE DRINKING WATER ACT

STANDARD DETAIL NO. WTR-06

TYPICAL RESIDENTIAL WATER SERVICE

CITY ENGINEER

CITY OF RICHFIELD **ENGINEERING** DIVISION



TIM LAMKIN JR.




12224 NICOLLET AVENUE BURNSVILLE, MINNESOTA 55337 Phone: (952) 890-0509 www.bolton-menk.com




	DESIGNED
	ZP/TI
1	DRAWN
Val wn	ZP/.
	CHECKED
	TL/
	CLIENT PROJ. N
	T1611

SIGNED	NO.	REVISION	D.
ZP/TL/SL			
AWN			
ZP/JW			
ECKED	\vdash		
TL/SL	_		
ENT PROJ. NO.			
T16114E41	$\overline{}$		

CITY OF RICHFIELD, MINNESOTA

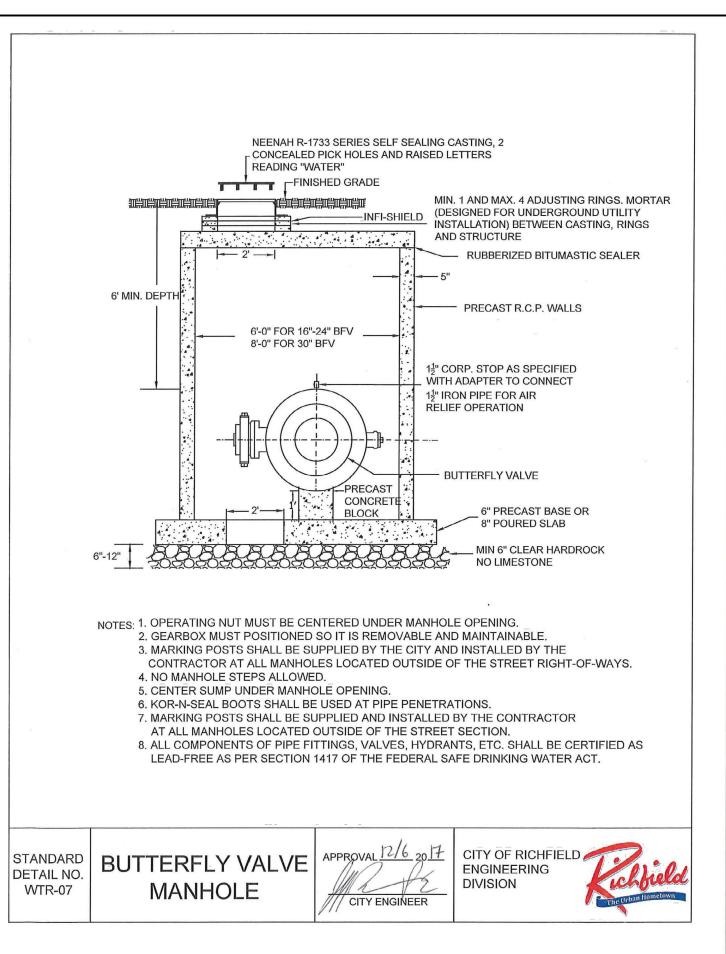

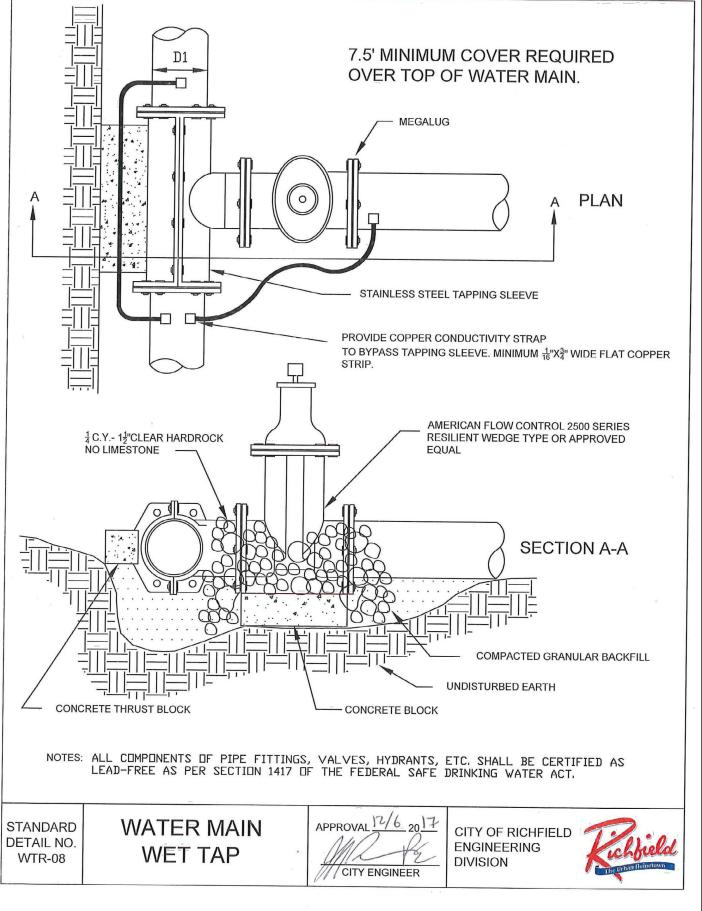













NOTES:


- 1. SHAPE OF BACK OF BUTTRESS MAY VARY AS LONG AS POURED AGAINST FIRM UNDISTURBED EARTH.
- 2. DIMENSION C1, C2, C3 SHOULD BE LARGE ENOUGH TO MAKE ANGLE θ EQUAL TO OR LARGER THAN 45°.
- 3. DIMENSION A1, A2, A3 SHOULD BE AS LARGE AS POSSIBLE WITHOUT INTERFERING WITH MJ BOLTS.
- $4. \theta = 45^{\circ} MINIMUM.$
- 5. PLACE POLYETHYLENE BETWEEN CONCRETE AND PIPE.


	BUT	TRESS	DIMENS	SIONS		
PIPE SIZE	22½° BEND		45° BEND		90° BEND	
	B ₁	D ₁	В2	D ₂	В3	D ₃
6"	1'-5"	1'-5"	1'-5"	1'-5"	2'-1"	1'-5"
8"	1'-5"	1'-5"	2'-1"	1'-6"	2'-8"	2'-0"
12"	1'-10"	1'-10"	3'-4"	2'-0"	4'-9"	2'-6"
16"	3'-0"	2'-0"	3'-10"	3'-0"	6'-2"	3'-6"
20"	3'-6"	2'-8"	5'-6"	3'-4"	8'-4"	4'-0"
24"	4'-4"	3'-0"	6'-10"	3'-10"	9'-8"	5'-0"
30"			9'-3"	6'-0"	17'-0"	6'-0"

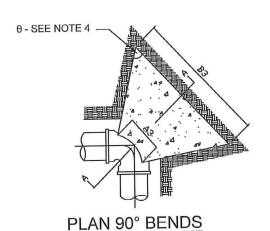

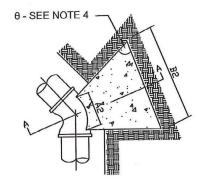

PLAN 45° BENDS

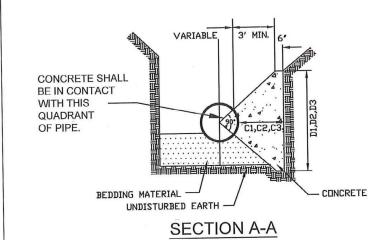

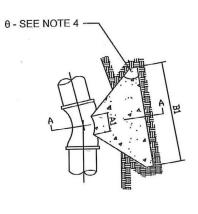

PLAN 22¹/₂ BENDS

STANDARD DETAIL NO. **WTR-09**

CONCRETE THRUST BLOCK



CITY OF RICHFIELD **ENGINEERING**



12224 NICOLLET AVENUE BURNSVILLE, MINNESOTA 55337 **BOLTON** & MENK Phone: (952) 890-0509 www.bolton-menk.com



STANDARD

DETAIL NO.

WTR-11





TYPICAL MEGALUG/

ROD LOCATIONS

TIE ALL

RODS

VERTICAL BENDS W/S.S.

90° BENDS

BE USED

NEED PRIOR APPROVAL TO

> **DENOTES MEGALUGS**

> > **BENDS**

BELOW GRADE SHALL BE ASTM F593 STAINLESS STEEL

BE USED AT ALL MECHANICAL JOINTS.

TEES

CROSSES

SLEEVES



MEGALUGS, MANUFACTURED BY EBAA IRON, INC. OR APPROVED EQUAL, SHALL

ALL BOLTS, EYE-BOLTS, T-BOLTS, WASHERS, NUTS AND RODDING INSTALLED

PLACE CONCRETE BLOCK UNDER ALL GATE VALVES AND HYDRANTS. THRUST BLOCKING REQUIRED BEHIND ALL TEES, BENDS AND HYDRANTS.

RODDING SHALL MEET APPROVAL OF CITY ENGINEER OR INSPECTOR. ALL COMPONENTS OF PIPE FITTINGS, VALVES, HYDRANTS, ETC. SHALL

BE CERTIFIED AS LEAD-FREE AS PER SECTION 1417 OF THE FEDERAL

HYDRANT LEADS




CITY ENGINEER

CITY OF RICHFIELD, MINNESOTA

S.A.P. 157-363-032, LYNDALE AVENUE RECONSTRUCTION

STANDARD PLAN

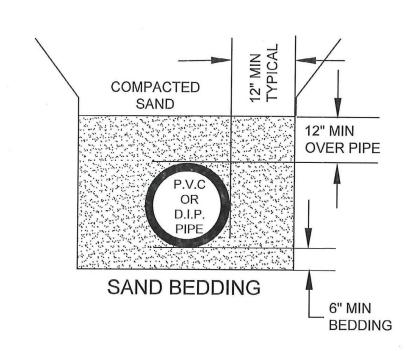

NOTES: 1. BEDDING SHALL BE CONSIDERED INCIDENTAL TO THE PIPE UNLESS MODIFIED IN THE CONTRACT DOCUMENTS.

STANDARD DETAIL NO. **WTR-12**

WATERMAIN **BEDDING**

APPROVAL 12/7 2017 **CITY ENGINEER**

CITY OF RICHFIELD ENGINEERING DIVISION









DRAWING NOT TO SCALE

	DESIGNED
	ZP/TL/
1	DRAWN
Wol.	ZP/JV
	CHECKED
town	TL/S
	CLIENT PROJ. NO.
	T16114

SET BACK 2/3 OF THE WAY TO BACK OF CABINET

CITY OF RICHFIELD, MINNESOTA S.A.P. 157-363-032, LYNDALE AVENUE RECONSTRUCTION STANDARD PLAN

C8.17

12224 NICOLLET AVENUE BURNSVILLE, MINNESOTA 55337 Phone: (952) 890-0509 Email: Burnsville@bolton-menk.com www.bolton-menk.com

LANGE CONNECTION

POWER IN

VARIES AS NEEDED

A COMPLETE DESIGN. EACH SYSTEM TO BE CUSTOM DESIGNED FOR EACH APPLICATION AND APPROVED BY THE ENGINEER.

POWER AND WATER TO BE SUPPLIED TO CABINET.

SEE WTR-13 FOR ADDITIONAL IRRIGATION CABINET, CONTROLLER, THREADED PLUG FOR VALVES, PIPE, AND WIRING DETAILS.

THREADED PLUG FOR BLOWOUT CONNECTION

TWO 3/4" DIA. STAINLESS STEEL (316) THREADED ROD AND BOLTS

GATE VALVE-

SEE DETIAL WTR-04

2' MIN TO PVC PIPE CONNECTION

/O 3/4" DIA. STAINLESS STEEL (316) READED ROD AND BOLTS SYSTEM

IRRIGATION


(DIP)

CITY OF RICHFIELD ENGINEERING DIVISION

PVC PIPE

SILFLOSS ALL COPPER JOINTS

STANDARD DETAIL NO. WTR-13B

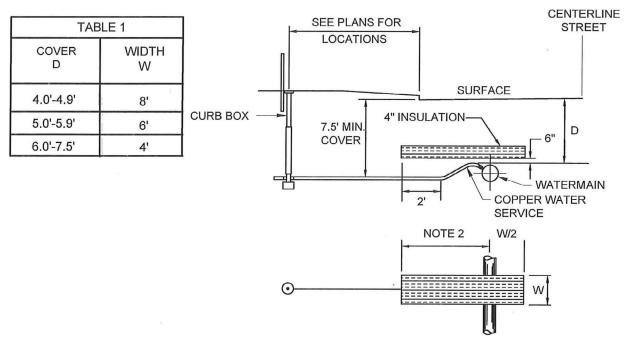

NOTE S: 1. WATERMAIN AND SERVICE LINES SHALL BE INSTALLED WITH 7.5' OF COVER. WHERE THE PLANS REQUIRE OR THE ENGINEER ORDERS AN INSTALLATION WITH LESS THAN 7.5' OF COVER, TABLE 1 SHALL BE USED TO DETERMINE THE WIDTH OF INSULATION REQUIRED.

- 2. INSULATION SHALL BE CARRIED OUT 2' BEYOND THE POINT WHERE 7.5' OF COVER HAS BEEN RE-ESTABLISHED.
- 3. INSULATING MATERIAL SHALL BE PLACED ON A SMOOTH, LEVEL FOUNDATION WHICH HAS BEEN FIRMLY COMPACTED WITH A HAND-OPERATED, VIBRATORY COMPACTOR. SEPARATE LAYERS USED TO MAKE UP THE 4" THICKNESS SHALL HAVE STAGGERED JOINTS TO ENSURE CONTINUITY. AFTER PLACING THE INSULATION, BACKFILL WITH 12" OF LOOSE MATERIAL AND COMPACT WITH A NON-VIBRATORY ROLLER THEN RETURN TO STANDARD BACKFILL PROCEDURES OUTLINED IN THE SPECIFICATIONS. USE EXTREME CAUTION WHEN WORKING NEAR THE CORPORATION STOP TO ENSURE THE CONNECTION TO THE MAIN IS NOT DAMAGED.
- 4. INSULATION SHALL BE EXTRUDED POLYSTYRENE (XEPS) INSULATION BOARD. INSULATION BOARD SHALL BE "CERTIFOAM 40", OR "STYROFOAM HI-35 OR HI-40", OR EQUIVALENT.
- 5. BASIS FOR PAYMENT: WHERE THERE IS NO BID ITEM TO FURNISH AND INSTALL INSULATION, PAYMENT WILL BE MADE FOR MATERIAL COST ONLY BASED ON APPROVED INVOICES. INSTALLATION SHALL BE INCIDENTAL.


STANDARD DETAIL NO. WTR-14

WATER SERVICE INSTALLATION

CITY ENGINEER

CITY OF RICHFIELD **ENGINEERING** DIVISION



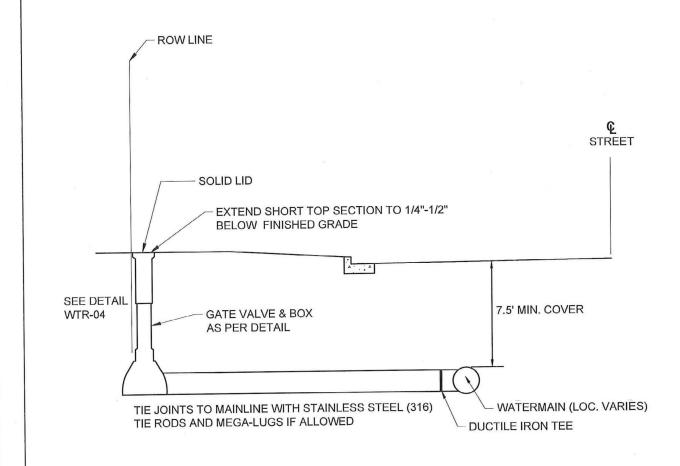

NOTES: 1. SEE PLANS FOR SIZE & TYPE OF MATERIALS.

2. MAINTAIN 18" VERTICAL & 24" HORIZONTAL SEPERATION BETWEEN SEWER AND WATER SERVICES LINES.

- 3. WATER SERVICES SHALL NOT BE MORE THAN 10' DEEP. PROVIDE EXTENSION PIECES AS REQUIRED. PAYMENT FOR EXTENSION PIECES SHALL BE FOR MATERIALS ONLY, BASED ON APPROVED CHOICES.
- 4. PROVIDE GATE VALVE BOX WITH LID MARKED "WATER".
- 5. ALL COMPONENTS OF PIPE FITTINGS, VALVES, HYDRANTS, ETC. SHALL BE CERTIFIED AS LEAD-FREE AS PER SECTION 1417 OF THE FEDERAL SAFE DRINKING WATER ACT.

STANDARD DETAIL NO. **WTR-15**

COMMERCIAL WATER SERVICE CONNECTION

APPROVAL 12/6 20 17 CITY ENGINEER

CITY OF RICHFIELD **ENGINEERING** DIVISION



Lin



BURNSVILLE, MINNESOTA 55337 Phone: (952) 890-0509 www.bolton-menk.com


Т	
	- VIAOVO
	u amotowo
	The Urban Hometown


	DESIGNED
	ZP/TL/S
	DRAWN
	ZP/JW
	CHECKED
and the second	TL/SL
	CLIENT PROJ. NO.

	NO.	REVISION	DATE	
/SL				
W				S.A.P. 15
VV				3.A.P. 15
	-			
SL				

CITY OF RICHFIELD, MINNESOTA 7-363-032, LYNDALE AVENUE RECONSTRUCTION

STANDARD PLAN

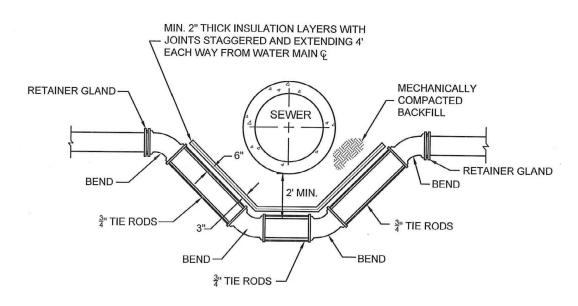

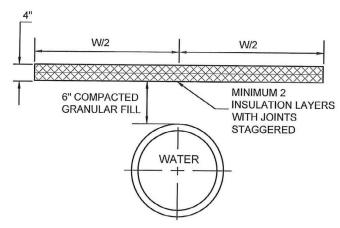

COVER	WIDTH W
4.0'- 4.9'	8'
5.0'- 5.9'	6'
6.0'- 7.5'	4'

NOTES: 1. INSULATION SHALL BE EXTRUDED POLYSYRENE (XEPS) INSULATION BOARD. INSULATION BOARD SHALL BE "CERTIFOAM 40" OR "STYROFOAM HI-35 OR HI-40"

- 2. INSULATION MATERIAL SHALL BE PLACED ON A SMOOTH, LEVEL FOUNDATION WHICH HAS BEEN FIRMLY COMPACTED WITH A HAND-OPERATED, VIBRATORY COMPACTOR. SEPARATE LAYERS USED TO MAKE UP THE 4" THICKNESS SHALL HAVE STAGGERED JOINTS TO ENSURE CONTINUITY. AFTER PLACING THE INSULATION, BACKFILL WITH 12" OF LOOSE MATERIAL AND COMPACT WITH A NON-VIBRATORY ROLLER THEN RETURN TO STANDARD BACKFILL PROCEDURES OUTLINED IN THE SPECIFICATIONS. USE EXTREME CAUTION WHEN WORKING NEAR THE CORPORATION STOP TO ENSURE THE CONNECTION TO THE MAIN IS NOT DAMAGED.
- 3. LENGTH AND WIDTH OF INSULATION SHOWN ON PLANS IS APPROXIMATE. SEE TABLE 1 FOR ACTUAL WIDTH REQUIRED ONCE THE ACTUAL DEPTH OF WATER MAIN IS KNOWN.

STANDARD DETAIL NO. WTR-17

WATER MAIN INSULATION

CITY ENGINEER

CITY OF RICHFIELD **ENGINEERING** DIVISION



12224 NICOLLET AVENUE BURNSVILLE, MINNESOTA 55337 Phone: (952) 890-0509 www.bolton-menk.com



STANDARD

DETAIL NO.

WTR-18



VALVE BOX

INSTALLATION

BASE

DROP LID

TYLER 6860

TOP- C.I.P.

TYLER NO. 6860 16"

EXTENSION- D.I.P.

TYLER NO. 58 14"

BOTTOM- D.I.P.

TYLER NO. 6860 65"

NO. 59 18"

NO. 60 24"

WATER

(14" AND ABOVE) CITY ENGINEER

MEGALUGS (TYP.)

CITY OF RICHFIELD **ENGINEERING** DIVISION

- 8" CONCRETE BLOCK

ALL WATERMAIN BOLTS ARE TO BE

CORE-BLUE OR APPROVED EQUAL

ADJUST TOP TO 4" MIN- 1" MAX

BELOW GRADE. BOX TO BE SET

TO PROVIDE 12" OF ADJUSTMENT

OR APPROVED EQUAL

RESILIANT WEDGE VALVE AMERICAN FLOW

CONTROL 2500 SERIES CONFORMING TO AWWA C-509-80 STANDARD

VALVE BOX- SCREW TYPE TYLER 6860

GATE VALVE ADAPTER:

1" STEEL WITH PROTECTIVE

INSTALLED BETWEEN THE GATE VALVE AND GATE

VALVE ADAPTOR

COATING, 1 RUBBER GASKET

COURSE FILTER AGGREGATE

PER MNDOT SPEC. 3149.2H

COVER WITH MINIMUM 4 MIL.

THICKNESS POLYETHYLENE

COPPERSTRIP

PROVIDE CONDUCTIVITY

STRAP (TYP.). MINIMUM 16" X 3" WIDE FLAT

7.5' MINIMUM COVER REQUIRED

OVER TOP OF WATER MAIN

GRADE




C8.19

CITY OF RICHFIELD, MINNESOTA

STANDARD PLAN

ZP/TL/SI S.A.P. 157-363-032, LYNDALE AVENUE RECONSTRUCTION

Lim Lan

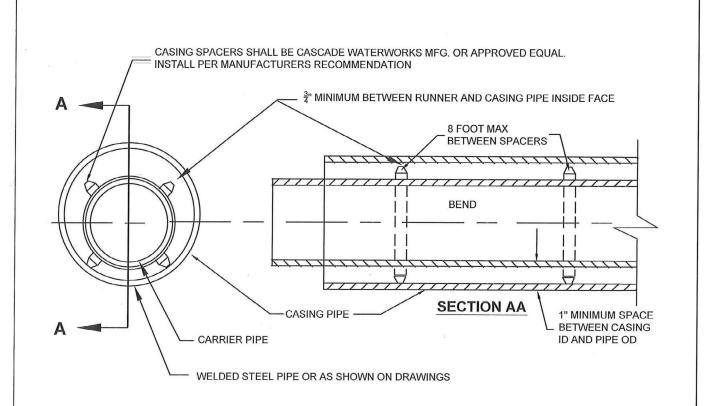

- NOTES: 1. CASING PIPE SHALL BE WELDED STEEL PIPE, AND GAUGE SHALL BE AS SHOWN ON DRAWINGS. CASING PIPE SHALL BE DESIGNED FOR ALL LOADS FOR EACH APPLICATION.
 - 2. INSTALL CASING SPACERS A MAXIMUM OF ONE FOOT (1') FROM EACH SIDE OF EACH PIPE JOINT. CASING SPACERS SHALL BE CASCADE WATERWORKS MFG. STAINLESS STEEL WITH POLYETHYLENE RUNNERS OR APPROVED EQUAL.
 - 3. ENDS OF CASING PIPE SHALL BE GROUTED WITH 4" BLOW PIPE. CASING SHALL BE WATERTIGHT. END CAPS MAY BE DELETED BY THE ENGINEER.
 - 4. CARRIER PIPE SHALL BE RESTRAINED ENTIRE LENGTH OF CASING PIPE AND AT A MINIMUM SHALL EXTEND ONE FULL PIPE LENGTH BEYOND END OF CASING.
 - 5. JOINT BONDS OR THAW WIRES SHALL BE INSTALLED THE ENTIRE LENGTH OF CARRIER PIPE.
 - 6. CORROSION ANALYSIS SHALL BE PERFORMED FOR CASING PIPE.
 - 7. PARTIALLY FILL ANNULAR SPACE BETWEEN CASING AND CARRIER PIPE WITH DRY BLOWN SAND. SPACE SHALL BE CONSIDERED FILLED WHEN DRY SAND BLOWS OUT OF OPPOSITE END OF CASING PIPE.
 - 8. SEAL EACH END OF THE CASING WITH A CONCRETE BULKHEAD AFTER THE SAND HAS BEEN DEPOSITED.
 - 9. VOIDS CREATED BY CASING INSTALLATION ON OUTSIDE OF CASING SHALL BE PRESSURE GROUTED.

STANDARD DETAIL NO. WTR-19

PIPE **ENCASEMENT** APPROVAL 12/6 20 17 CITY ENGINEER

CITY OF RICHFIELD **ENGINEERING** DIVISION



Lim Zan



BURNSVILLE, MINNESOTA 55337 Phone: (952) 890-0509 Email: Burnsville@bolton-menk.com www.bolton-menk.com



	DESIGNED
	ZP/TL/SL
0	DRAWN
o Vol.	ZP/JW
	CHECKED
etown	TL/SL
	CLIENT PROJ. NO.
	T1611454

CITY OF RICHFIELD, MINNESOTA S.A.P. 157-363-032, LYNDALE AVENUE RECONSTRUCTION STANDARD PLAN

C8.20

				MODULAR	BLOCK RE	TAINING WALL	S		
						2411	2411	2451	2557
ROADWAY	WALL	STATION TO STATION		LOCATION	PREFABRICATED MODULAR BLOCK WALL	STRUCTURE EXCAVATION CLASS U	STRUCTURAL BACKFILL	WIRE FENCE DESIGN W-1 VINYL COATED	
					SQ FT	CU YD	CU YD	LIN FT	
	WALL 1	246+01.82	TO	246+96.55	LT	663	223	200	95
LYNDALE AVENUE	WALL 2	248+53.88	TO	249+75.33	LT	426	161	143	121
LINDALE AVENUE	WALL 3	251+98.83	TO	255+97.82	LT	2264	845	756	400
	WALL 4	257+10.24	TO	262+79.18	LT	4019	1438	1290	569
	-	TOTALS			-	7372	2667	2389	1185

HERREY CERTIFY THAT THIS PLAN, SPECIFICATION, OR REPORT WAS PREPARED BY ME OR UNDER MY DIRECT SUPERVISION AND THAT I AM A DULY LICENSED PROFESSIONAL ENGINEER UNDER THE LAWS OF THE STATE OF MEINNESOTA.


RYAN R. EVANS

UC. NO. DATE 2/19/19





	DESIGNED	NO.	ISSUED FOR	
	RRE			
1/	DRAWN			
	JMB			
2	CHECKED			
M	RRF			
	CLIENT PROJ. NO.			
	T16.114541			

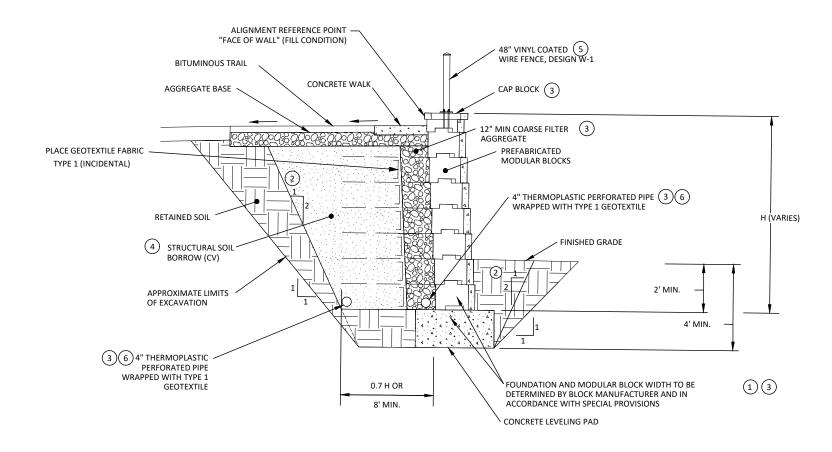

TYPICAL MODULAR BLOCK WALL (PMBW) WITH SOIL REINFORCEMENT

SPECIFIC NOTES:

- 1 DIMENSION MAY VARY DEPENDING ON ACTUAL MODULAR BLOCK MANUFACTURER. CENTER WALL ON FOOTING. FOOTING TO BE INCLUDED IN PRICE BID FOR ITEM "PREFABRICATED MODULAR BLOCK WALL" (FOOTING AREA IS NOT MEASURED OR INCLUDED IN PAYMENT QUANTITY)
- 2 LINE REPRESENTS THE MINIMUM EXCAVATION LIMITS AND THE PAY LIMITS FOR STRUCTURE EXCAVATION CLASS U AND EMBANKMENT AND IS NOT MEANT TO BE ACTUAL EXCAVATION LIMITS. ACTUAL EXCAVATION LIMITS SHALL BE DETERMINED BY THE CONTRACTOR BASED ON EXISTING SOIL CHARACTERISTICS AND OSHA SAFETY REQUIREMENTS. EXCAVATION AND EMBANKMENT BEYOND THE PAY LIMIT LINE IS INCIDENTAL.
- TO BE INCLUDED IN PRICE BID FOR ITEM "PREFABRICATED MODULAR BLOCK WALL" CAP BLOCK IS INCLUDED IN SQ FT PAY AREA.
- (4) MATERIAL SHALL MEET "REINFORCED AND BACKFILL SOIL" REQUIREMENTS IN PROJECT PMBW SPECIAL PROVISIONS.
- 5 FENCE TO BE ATTACHED TO CENTER OF CAP. ALL WORK ASSOCIATED WITH ATTACHING THE FENCE TO THE CAP TO BE INCLUDED IN PRICE BID FOR ITEM "WIRE FENCE DESIGN W-1 VINYL COATED."
- 6 CONNECT TO DRAINAGE SYSTEM OR OUTLET THROUGH WALL USING 6" T.P.-NON-PERFORATED PIPE WITH RODENT SCREEN. ALL WORK INCIDENTAL.

RYAN R. EVANS 53920



12224 NICOLLET AVENUE BURNSVILLE, MINNESOTA 55337 www.bolton-menk.com

1200	. 0 .
John H	rela
	MAL
	ichb The Urban Ho

DESIGNED	NO.	ISSUED FOR	
RRE			
DRAWN			
JMB			
CHECKED			_
RRF			
CLIENT PROJ. NO.			
			_
T16 114541			

REINFORCED LEVELING PAD DETAIL

FOR PIPES WITHIN 5' OF FOOTING


NOTES:

THIS DETAIL SHALL BE USED FOR ALL LOCATIONS WHERE A PIPE TRAVERSES A WALL FOUNDATION (WITHIN 5' OF BOTTOM OF FOOTING). ALL ADDITIONAL COSTS ASSOCIATED WITH PLACING THE REINFORCED LEVELING PAD, INCLUDING OBTAINING AND PLACING REINFORCEMENT, SHALL BE CONSIDERED INCIDENTAL TO THE PRICE BID FOR 'PREFABRICATED MODULAR BLOCK WALL'.

FOOTING SHALL BE FULL-DEPTH CONCRETE AS SHOWN. STRUCTURAL CONCRETE MIX NO. 1G52 SHALL BE USED.

REINFORCEMENT SHALL BE GRADE 60. PROVIDE BENT BARS AS NEEDED FOR LOCATIONS WITH LONGITUDINAL FOOTING STEPS.


TOTAL MIN. LENGTH 'L' REQUIRED SHALL BE BASED ON DEPTH OF PIPE TO PROVIDE THE MINIMUM END DISTANCE SHOWN, WITH THE EXCEPTION OF FOOTINGS LOCATED AT END OF WALL.

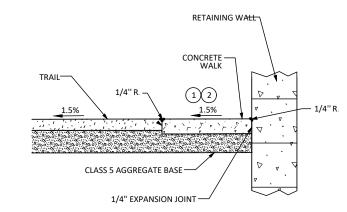

NOTES:


- 1 ALL LONGITUDINAL JOINTS SHALL BE TROWELED
 WHILE THE RATIO OF TRANSVERSE JOINT
 SPACING TO LONGITUDINAL SPACING SHOULD
 NOT EXCEED 1.5
- 2) PAID FOR AS CONCRETE WALK

CONCRETE STRIP-BETWEEN WALK AND RETAINING WALL

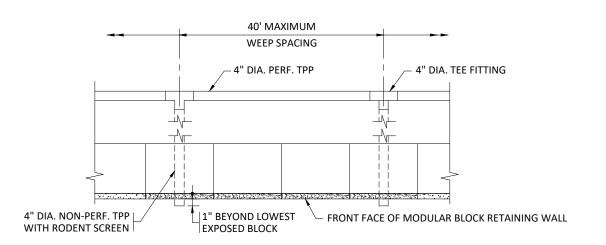

WALL DRAINAGE DETAIL

NOTE: USE THIS DETAIL IF WALL DRAINAGE CANNOT TIE INTO A DRAINAGE SYSTEM

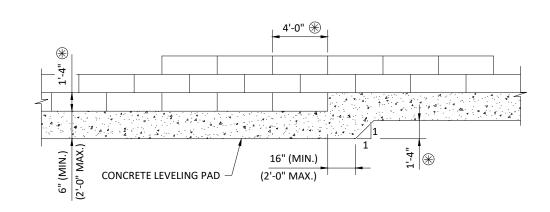

WALL BASE STEP DETAIL

** DIMENSIONS MAY VARY DEPENDING ON ACTUAL BLOCK MANUFACTURER

HEREBY CERTIFY THAT THIS PLAN, SPECIFICATION, OR REPORT WAS PREPARED WHO GOT UNDER WYD PROJECT SUPERVISION AND THAT THAT AD ULY LICENSED NOFESSIONAL ENGINEER UNDER THE LAWS OF THE STATE OF MINNESOTA.

RYAN R. EVANS

C. NO. 53920 DATE 2/19/19




12224 NICOLLET AVENUE BURNSVILLE, MINNESOTA 55337 Phone: (952) 890-0509 Email: Burnsville@bolton-menk.com www.bolton-menk.com

0100
L'EL MOLOL
The Urban Hometown

NED	NO.	ISSUED FOR	DATE	OUT V OF BLOWERE B. AND DESCRIPT
RRE				CITY OF RICHFIELD, MINNESOTA
N				, ,
JMB				S.A.P. 157-363-032, LYNDALE AVENUE RECONSTRUCTION
ED	\vdash			·
RRE				
PROJ. NO.	i I			RETAINING WALL PLAN & PROFILE
46 44 45 44	-			11217 11111111 2 117 122 1 2 117 0 1 110 1 122

C9.03

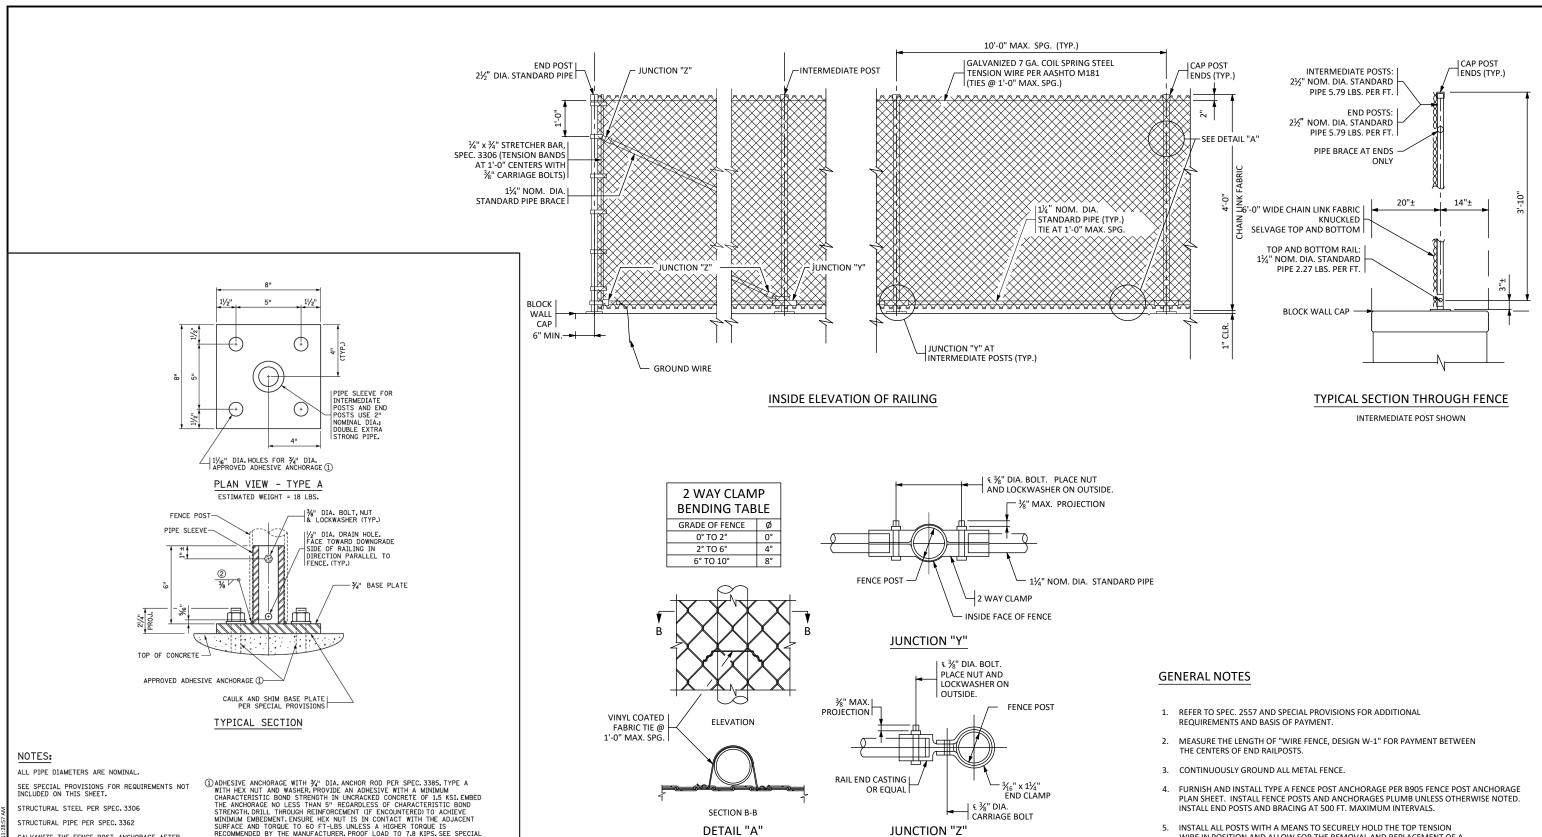

STRUCTURAL PIPE PER SPEC. 3362

GALVANIZE THE FENCE POST ANCHORAGE AFTER FABRICATION PER SPEC. 3394. GALVANIZE THE FASTENERS PER SPEC. 3392.

FURNISHING AND INSTALLING FENCE POST ANCHORAGES IS INCIDENTAL TO THE WIRE FENCE.

(1) ADHESIVE ANCHORAGE WITH 3/" DIA. ANCHOR ROD PER SPEC. 3385, TYPE A WITH HEX NUT AND WASHER. PROVIDE AN ADHESIVE WITH A MINIMUM CHARACTERISTIC BOND STRENGTH IN UNCRACKED CONCRETE OF 1.5 KSI. EMBED THE ANCHORAGE NO LESS THAN 5" RECARDLESS OF CHARACTERISTIC BOND STRENGTH. DRILL THROUGH REINFORCEMENT (IF ENCOUNTERED) TO ACHIEVE MINIMUM EMBEDMENT. ENSURE HEX NUT IS IN CONTACT WITH THE ADJACENT SURFACE AND TORQUE TO GO FT-LBS UNLESS A HIGHER TORQUE IS RECOMMENDED BY THE MANUFACTURER. PROOF LOAD TO 7.8 KIPS. SEE SPECIAL PROVISIONS FOR ADDITIONAL REQUIREMENTS. PROVISIONS FOR ADDITIONAL REQUIREMENTS.

②E70X ELECTRODES FOR 3/8" POST TO BASE PLATE WELD.

DOUBLE EXTRA STRONG PIPE WEIGHTS; 2" NOMINAL DIA. = 9.03 LBS./FT.

APPROVED: JANUARY 05, 2017 Western STATE BRIDGE ENGINEER

STATE OF MINNESOTA
DEPARTMENT OF TRANSPORTATION FENCE POST ANCHORAGE

DETAILS NOT TO SCALE

REVISION DETAIL NO. B905 (TYPE A)

RYAN R. EVANS

53920

WIRE FENCE (DESIGN W-1)

- INSTALL ALL POSTS WITH A MEANS TO SECURELY HOLD THE TOP TENSION WIRE IN POSITION AND ALLOW FOR THE REMOVAL AND REPLACEMENT OF A POST WITHOUT DAMAGING THE TOP TENSION WIRE.
- PROVIDE WIRE TIES WITH 9 GA. (0.148" CORE) ALUMINUM PER ASTM B 211, ALLOY 1100 H18 WITH VINYL COATING (6 GA. AFTER COATING) OR 10 GA. (0.135" CORE) STEEL CL. 3 GALV. WIRE WITH FUSION BONDED VINYL COATING (9 GA. AFTER COATING). USE SAME VINYL THICKNESS COATING REQUIREMENTS AS VINYL COATED FABRIC.
- 7. USE 12 GA. GALVANIZED STEEL OR 9 GA. ALUMINUM ALLOY 1350-H19 HOG RINGS FOR TENSION WIRE TIES.



BURNSVILLE, MINNESOTA 55337 Phone: (952) 890-0509 Email: Burnsville@bolton-menk.com www.bolton-menk.com





DESIGNED	NO.	ISSUED FOR	DATE	
RRE				
DRAWN				
JMB				
CHECKED	H			
RRE	ш			
CLIENT PROLING	1			


CITY OF RICHFIELD, MINNESOTA


S.A.P. 157-363-032, LYNDALE AVENUE RECONSTRUCTION **RETAINING WALL PLAN & PROFILE**


C9.04

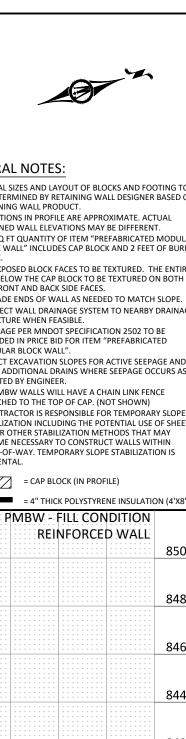


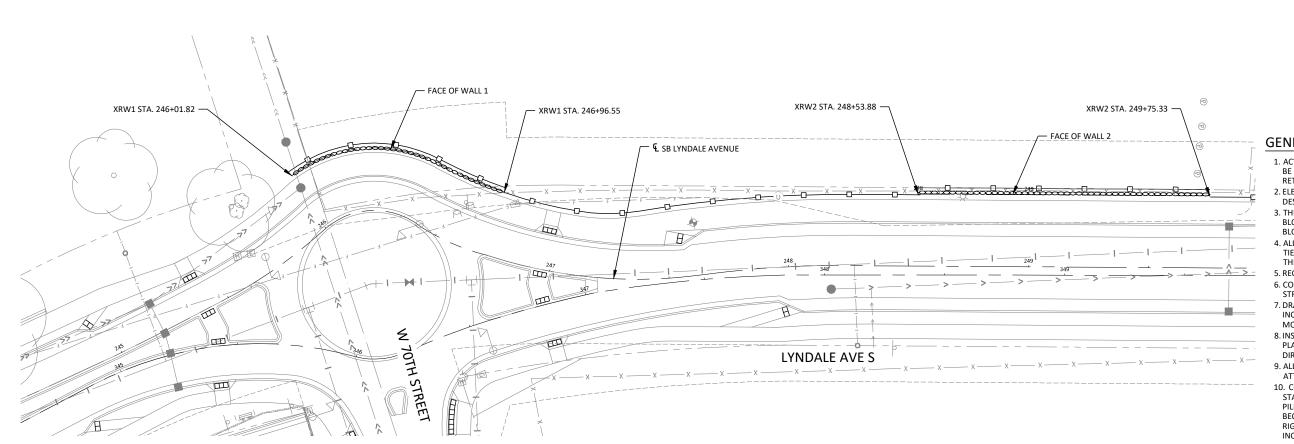


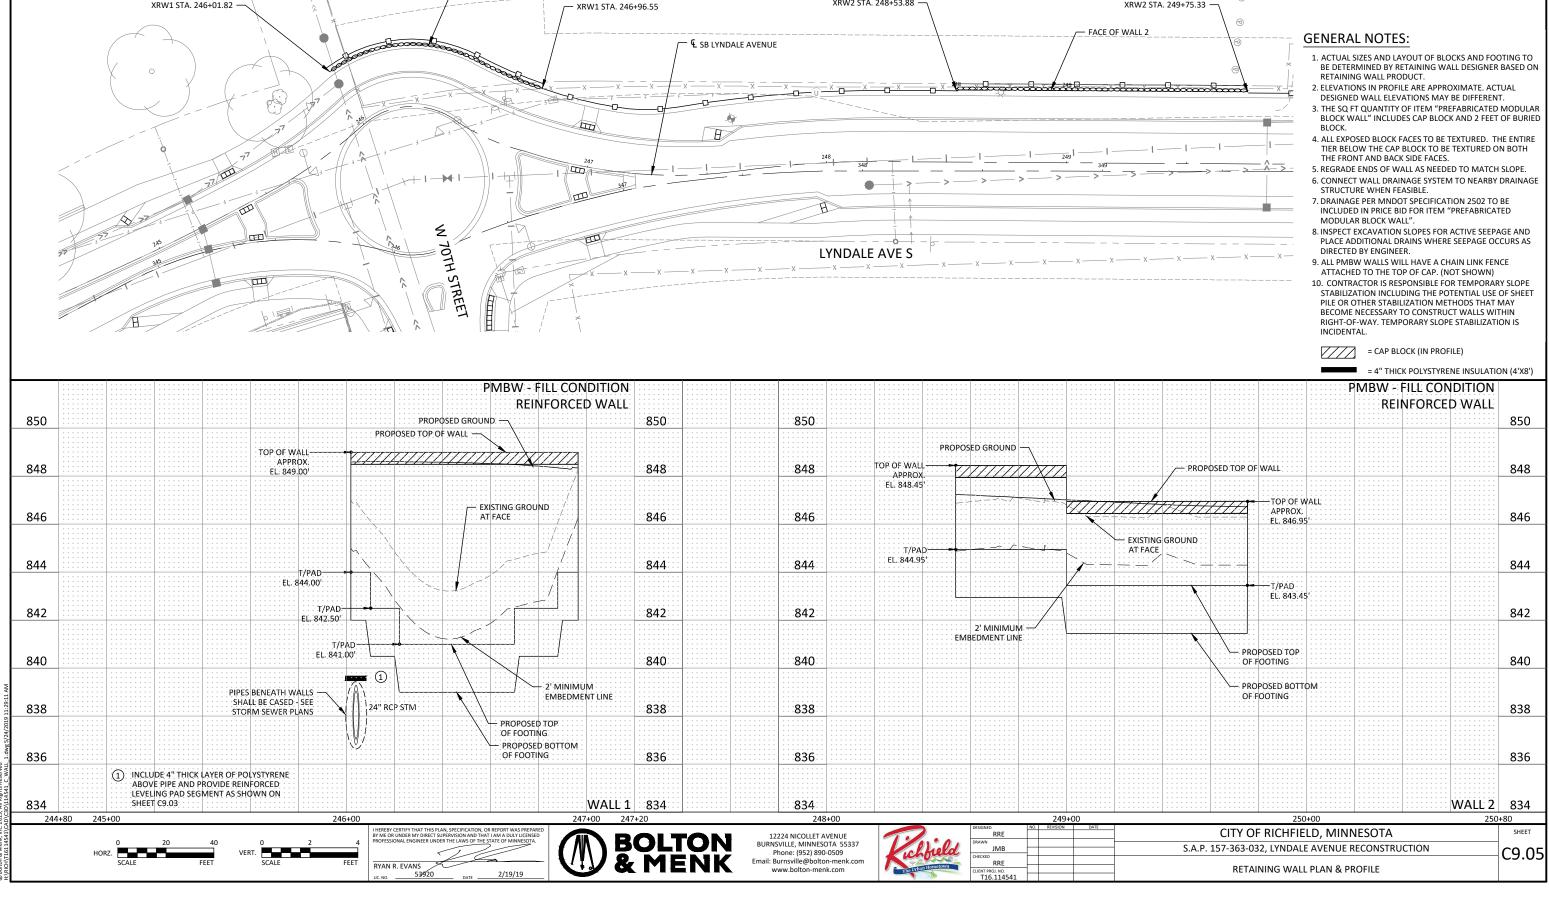


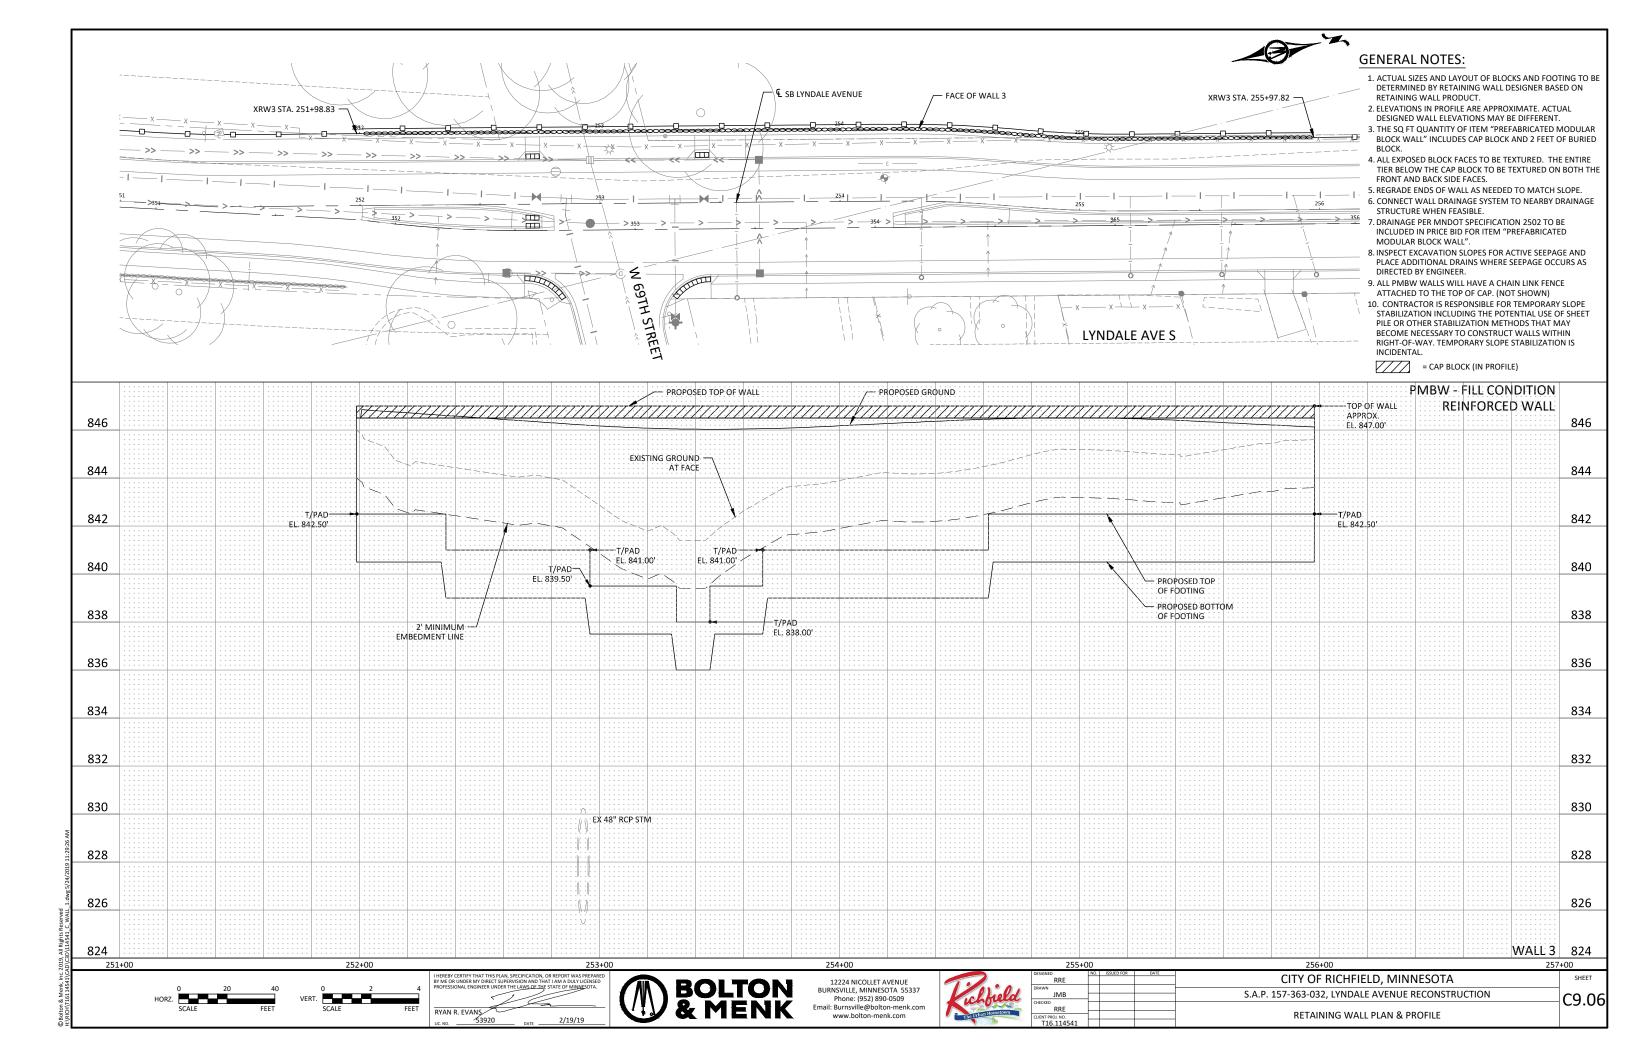


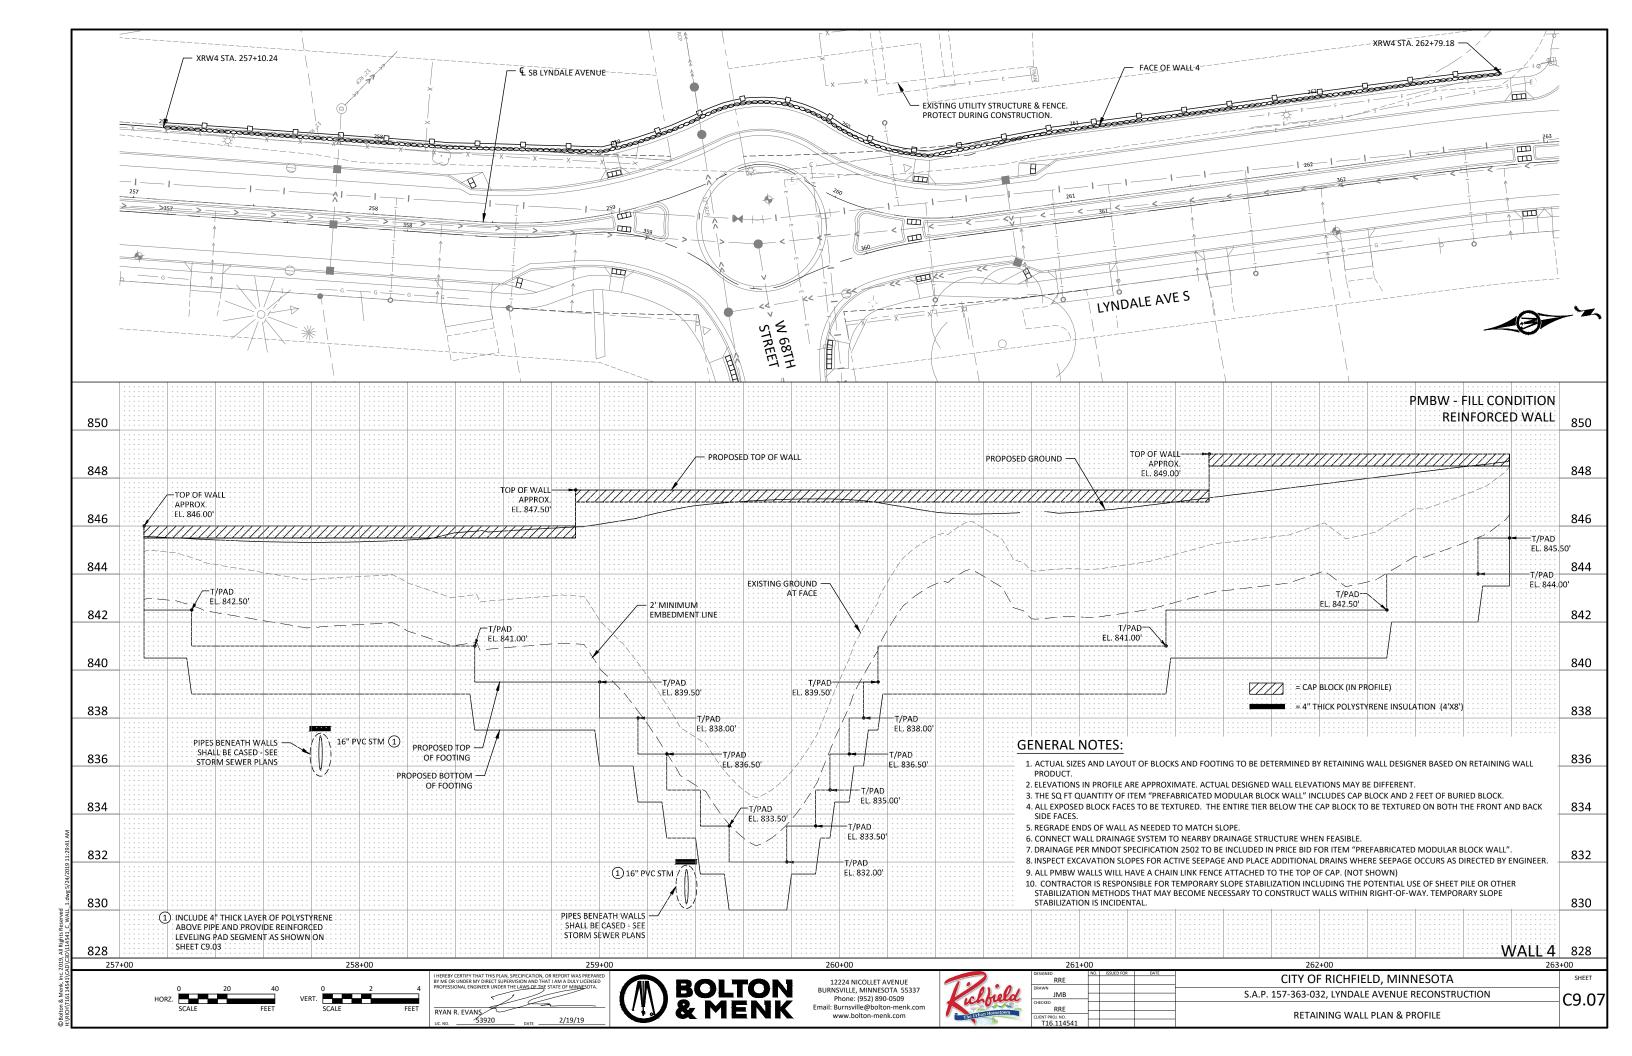


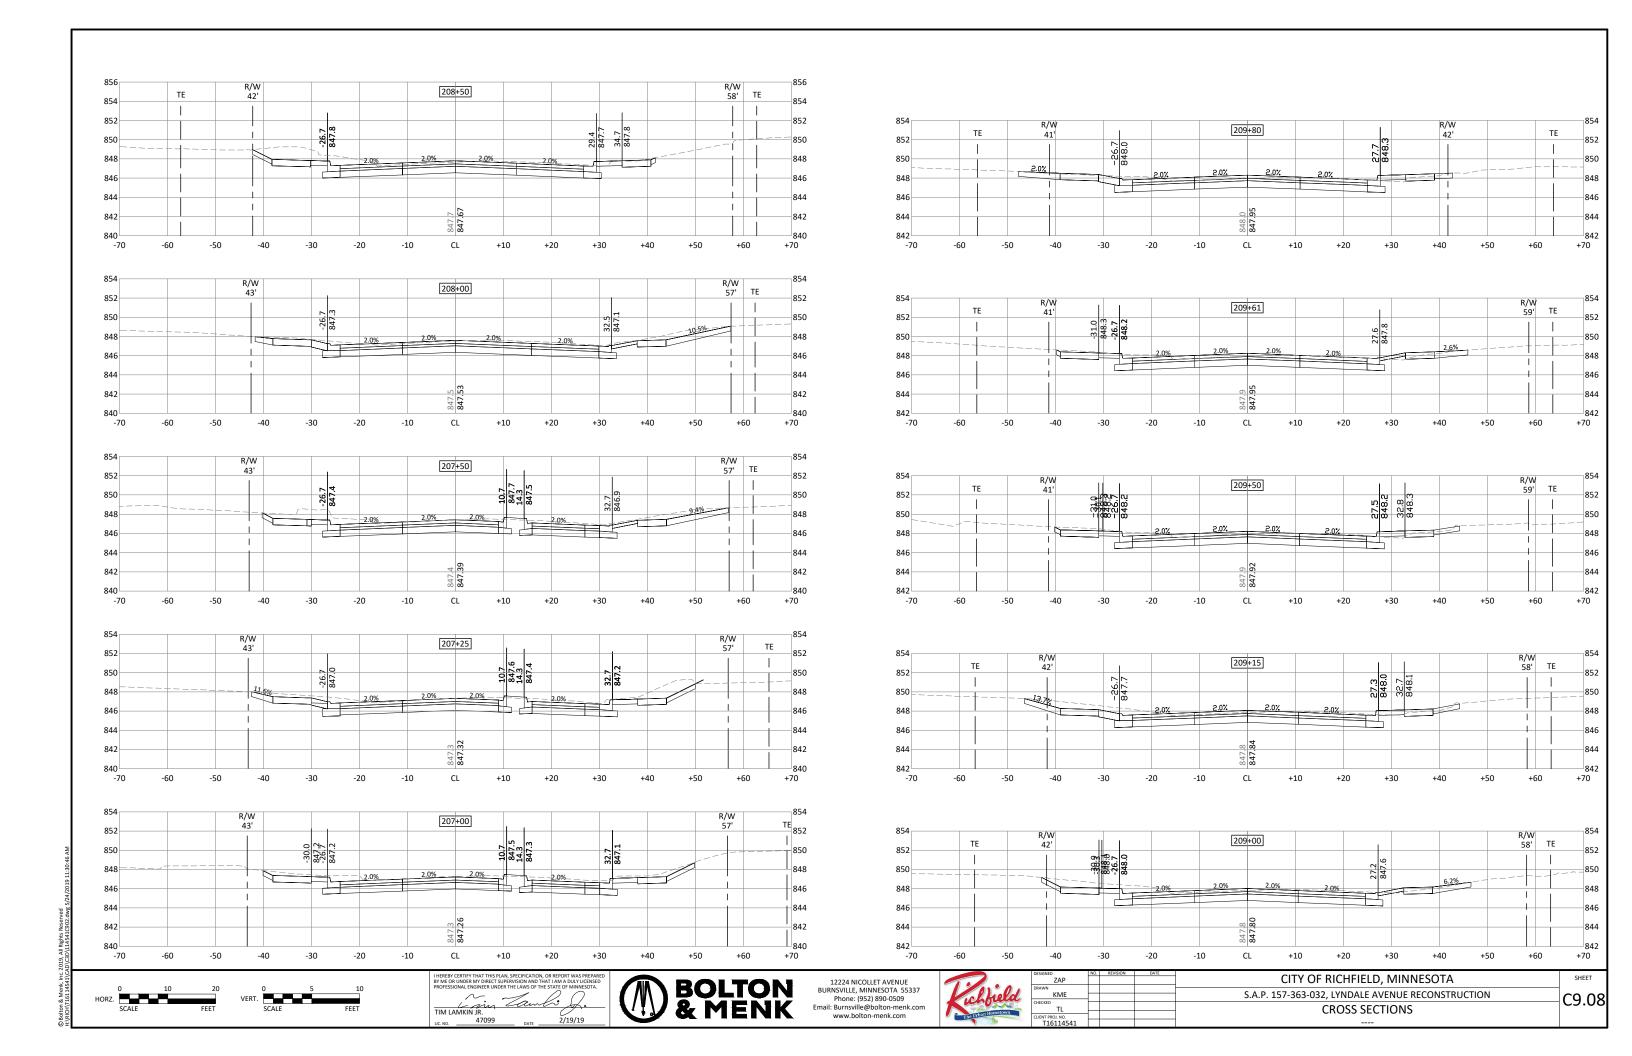


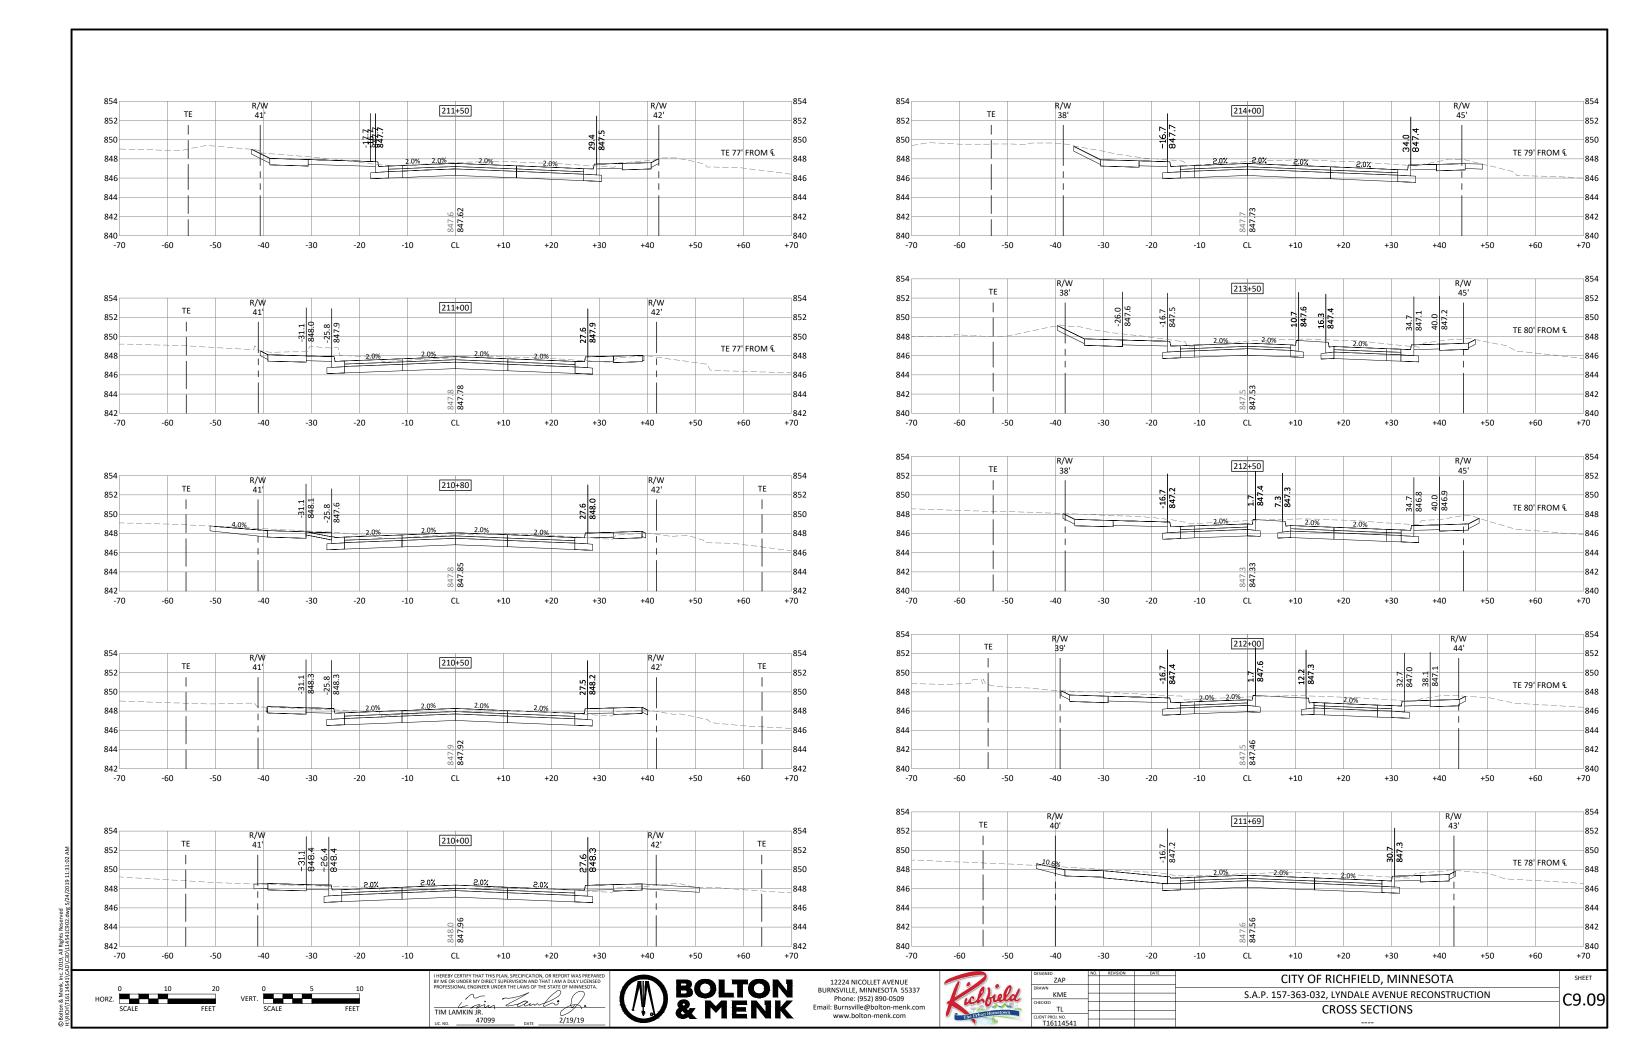


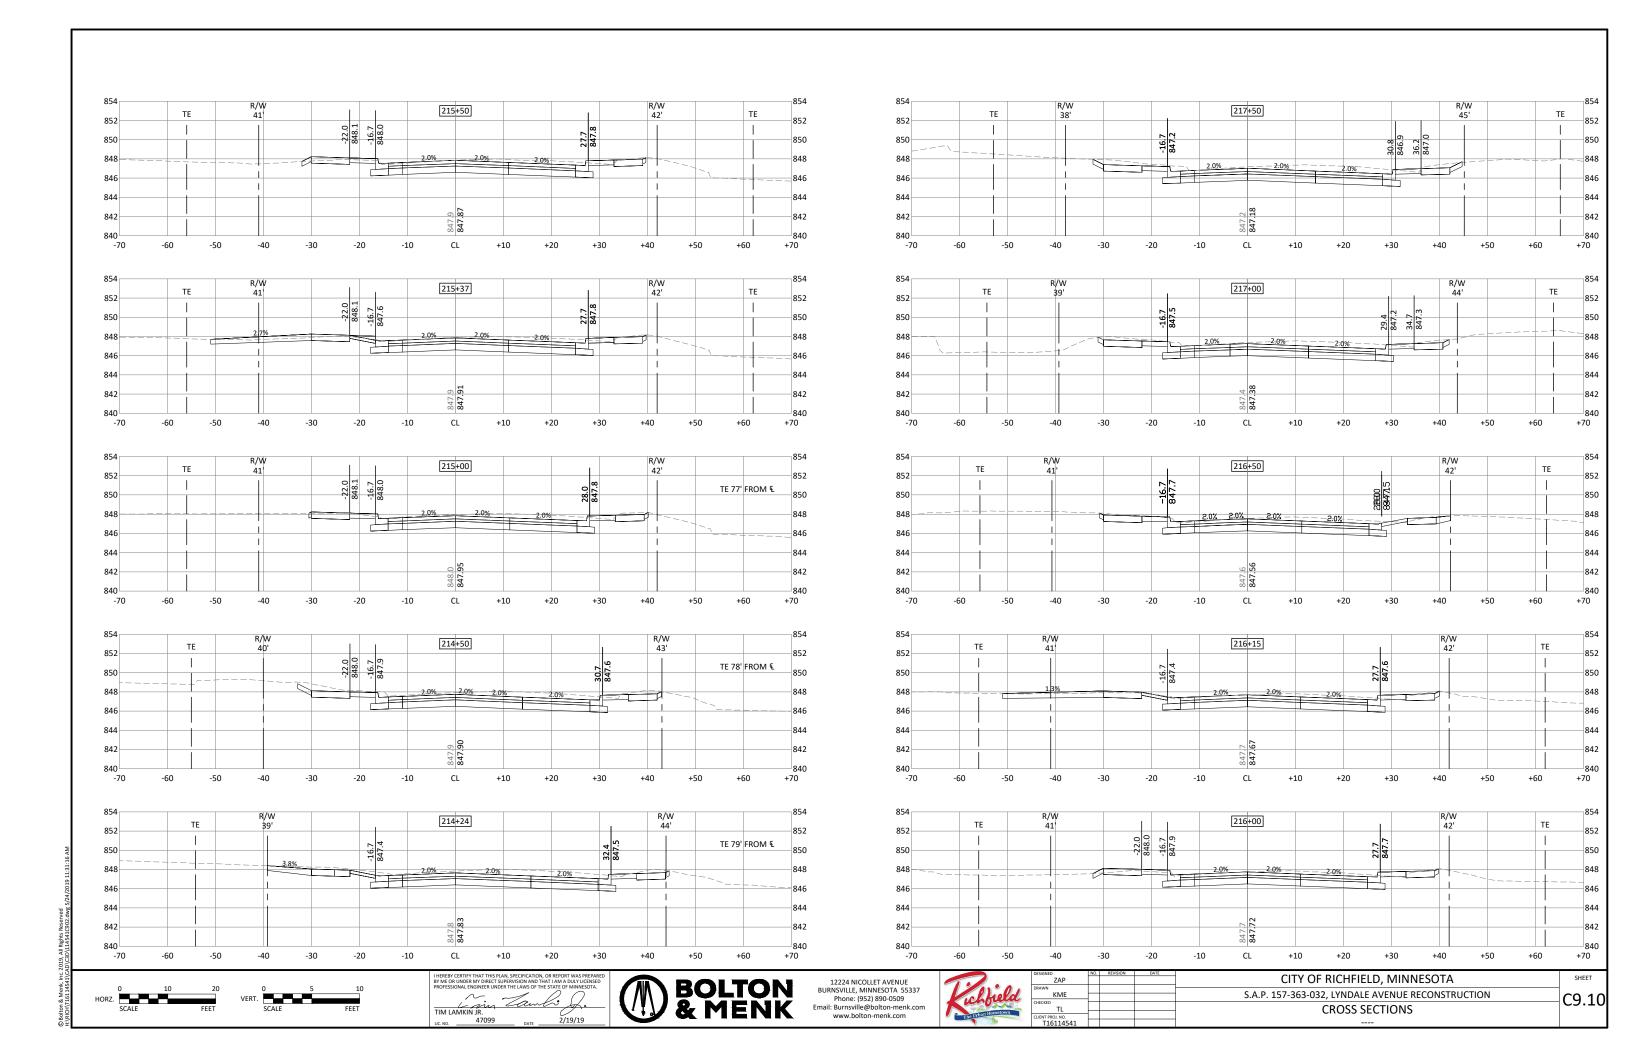


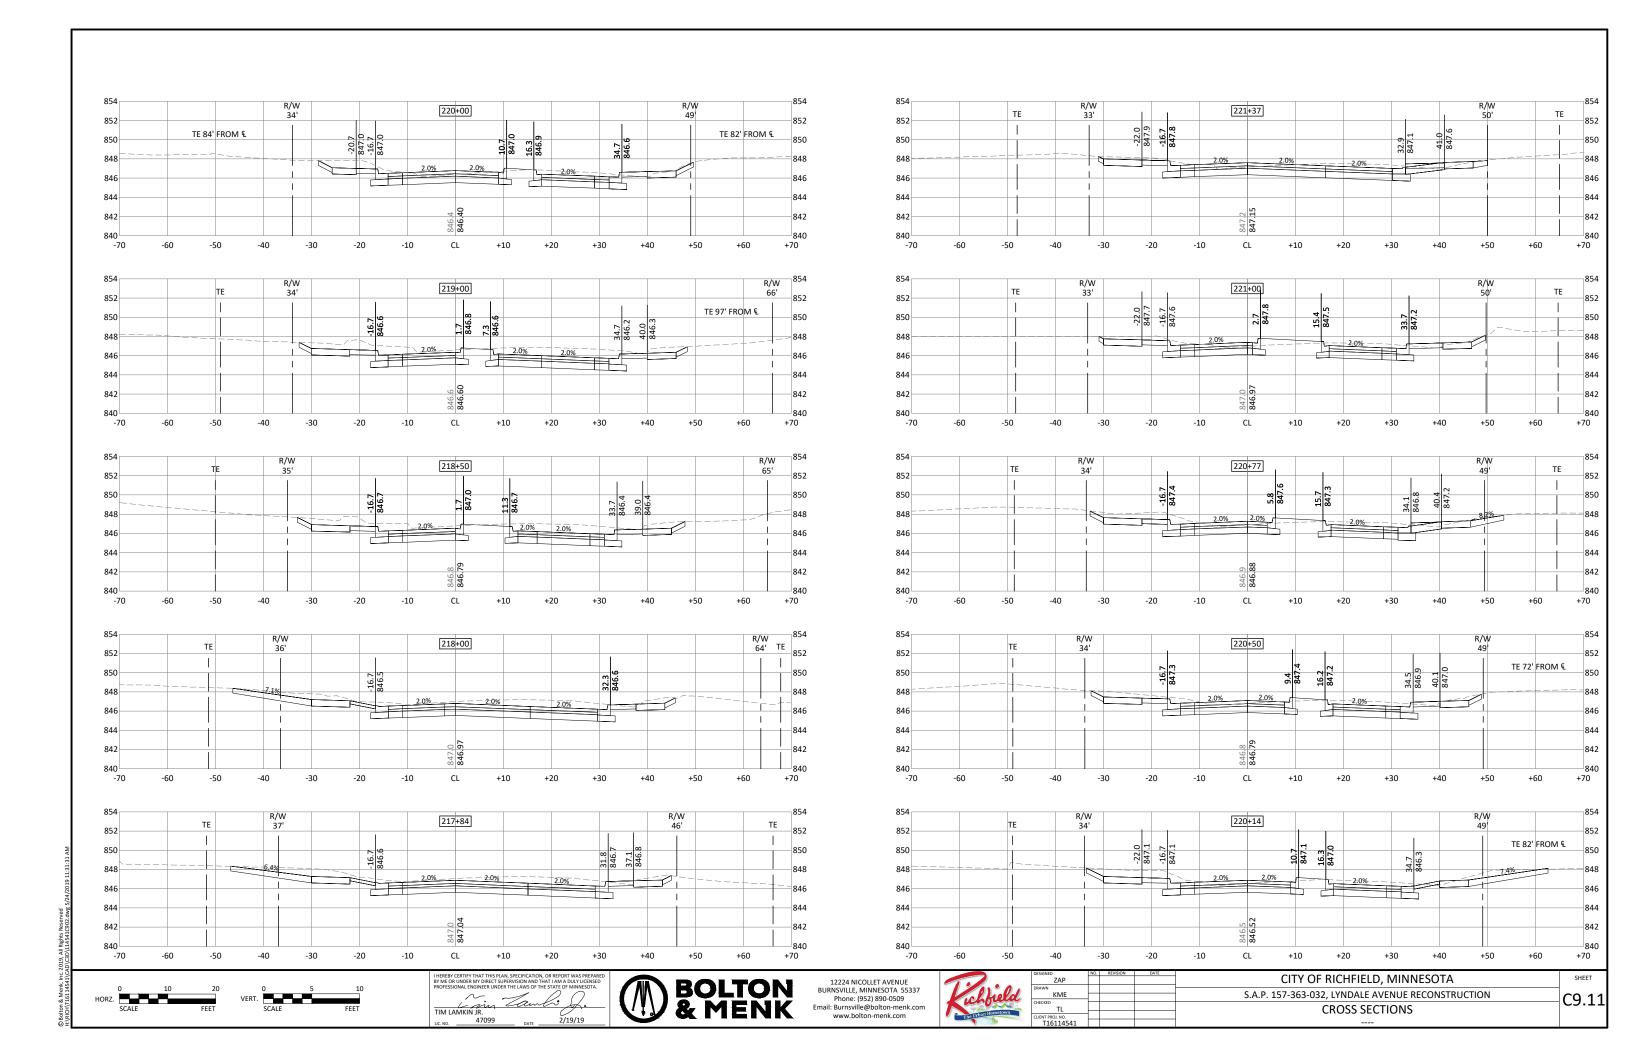


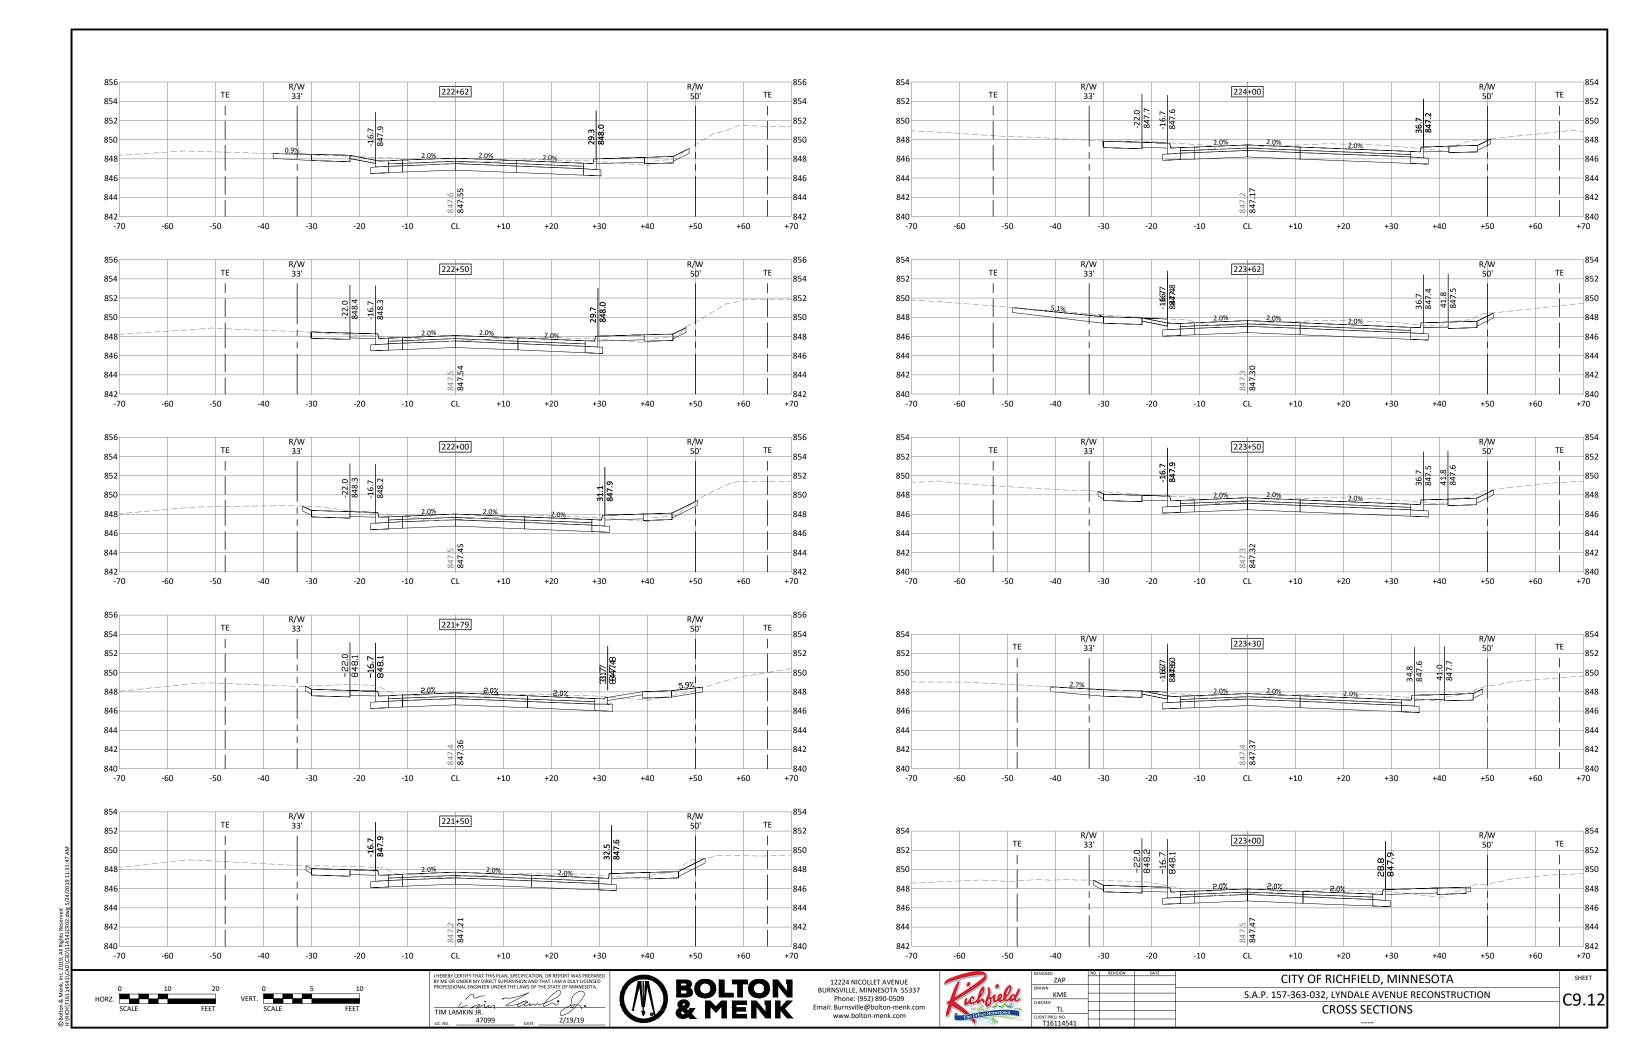


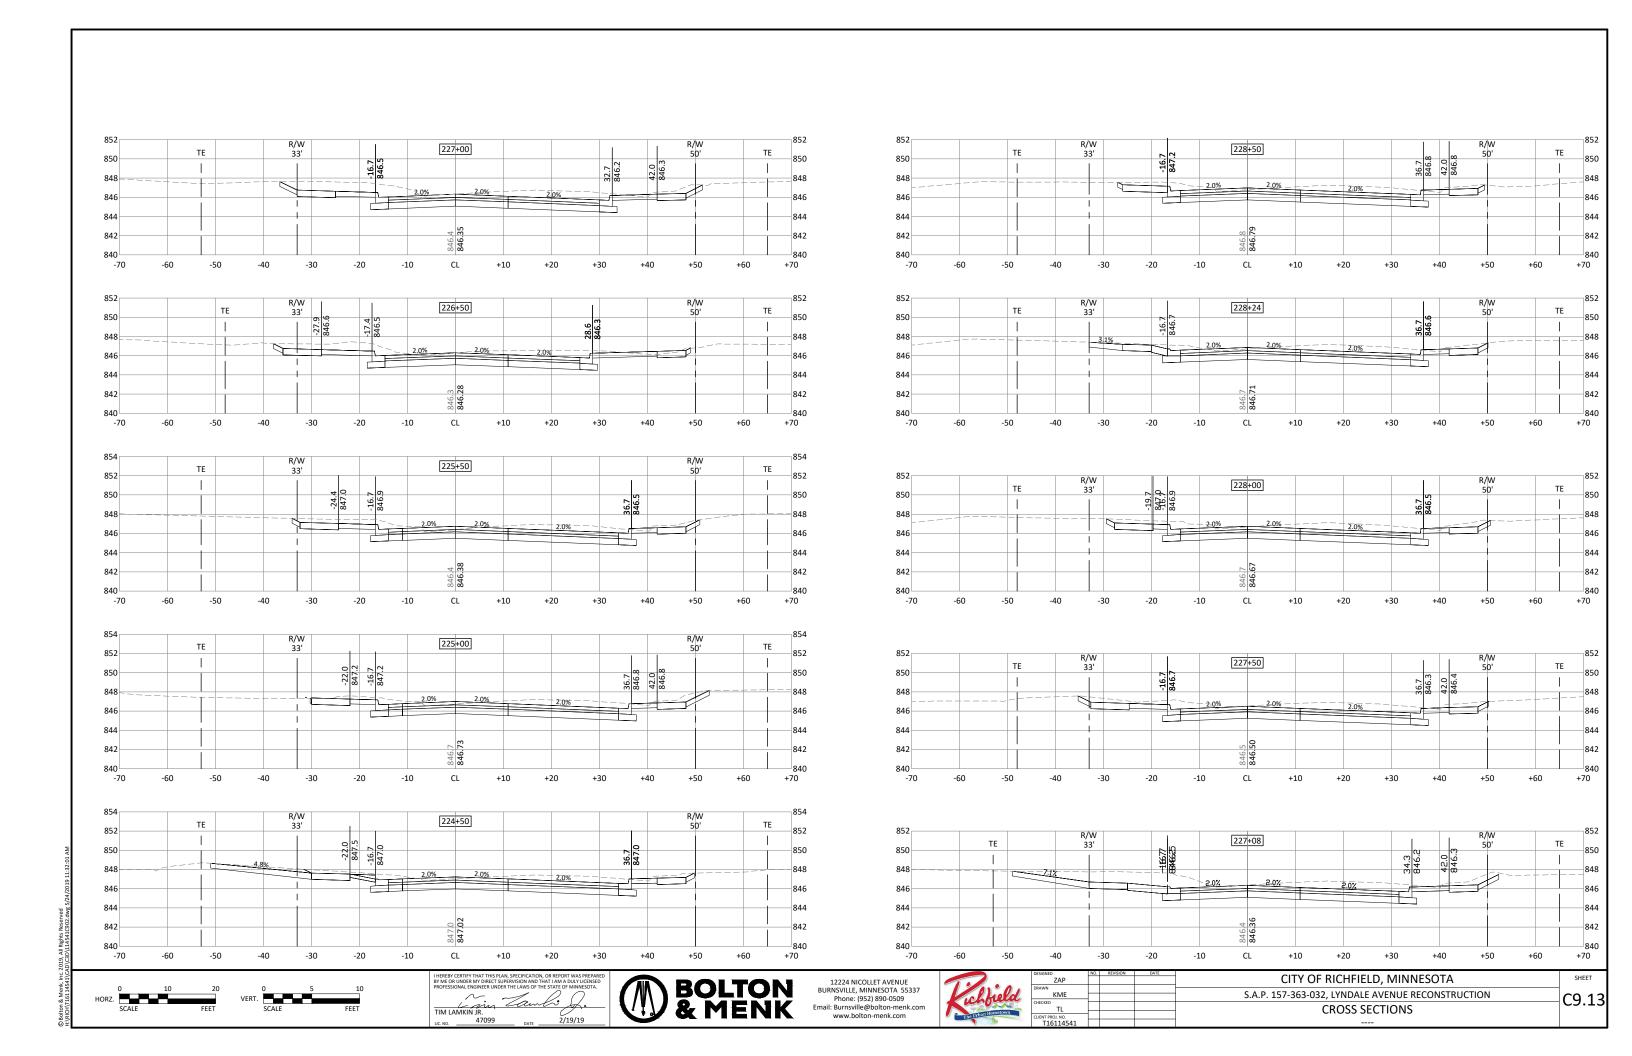


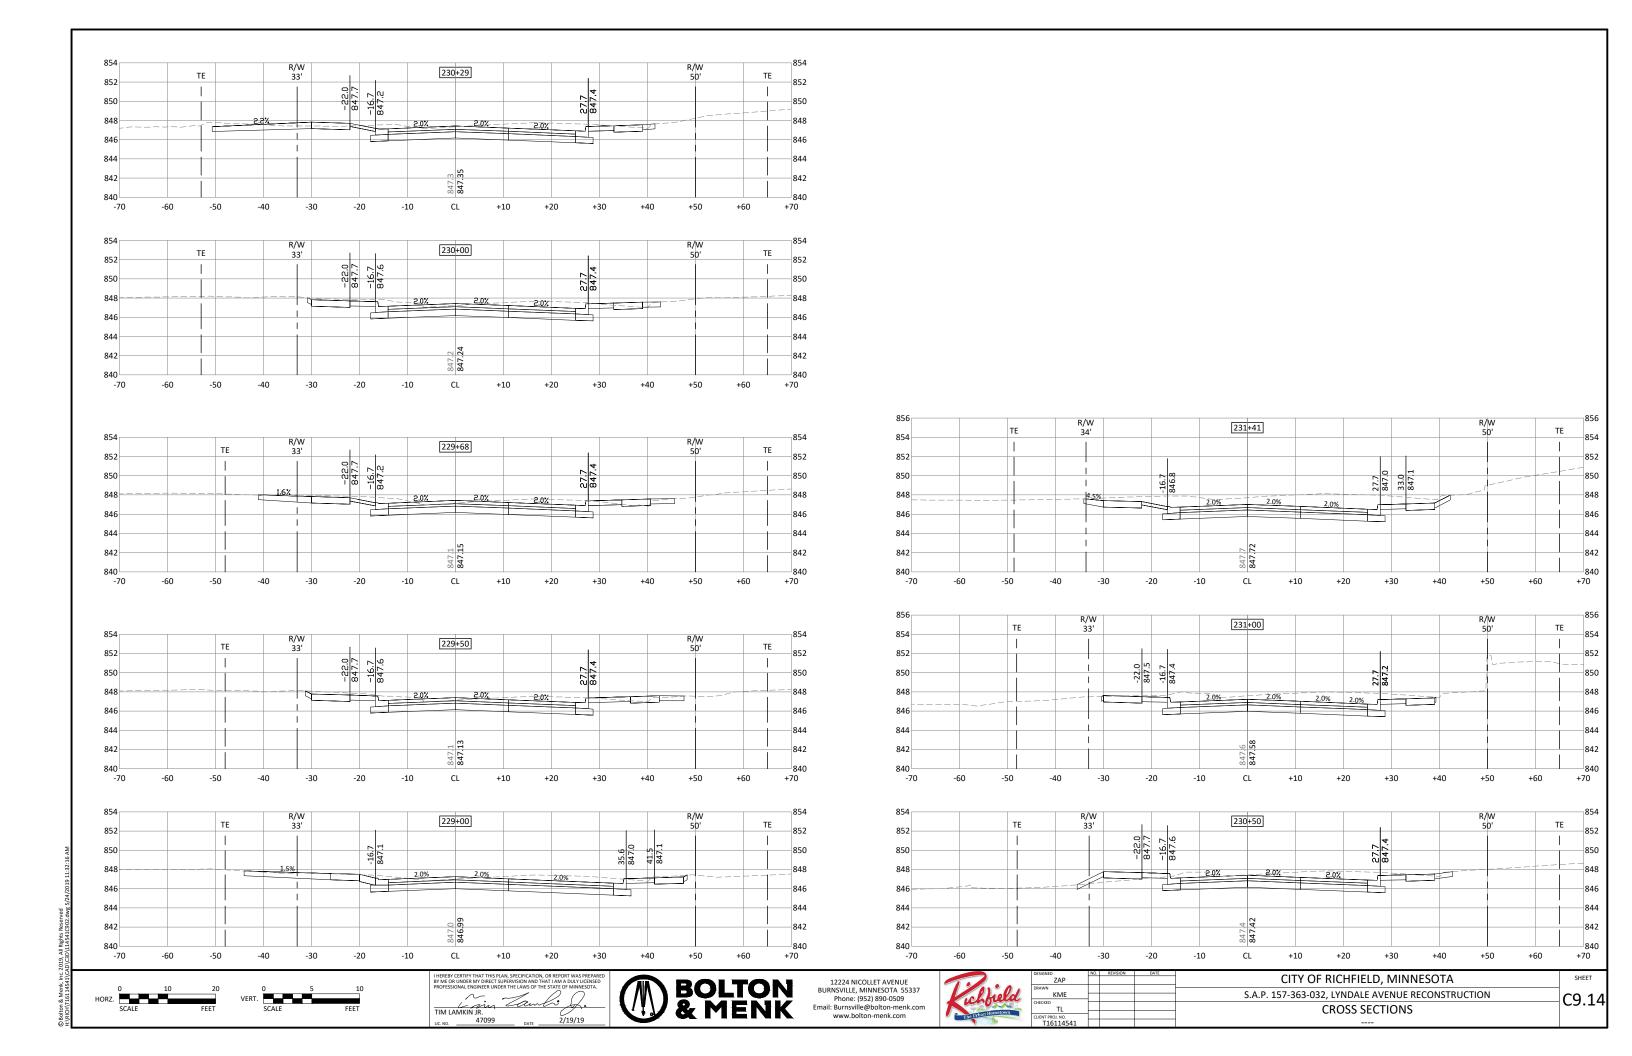


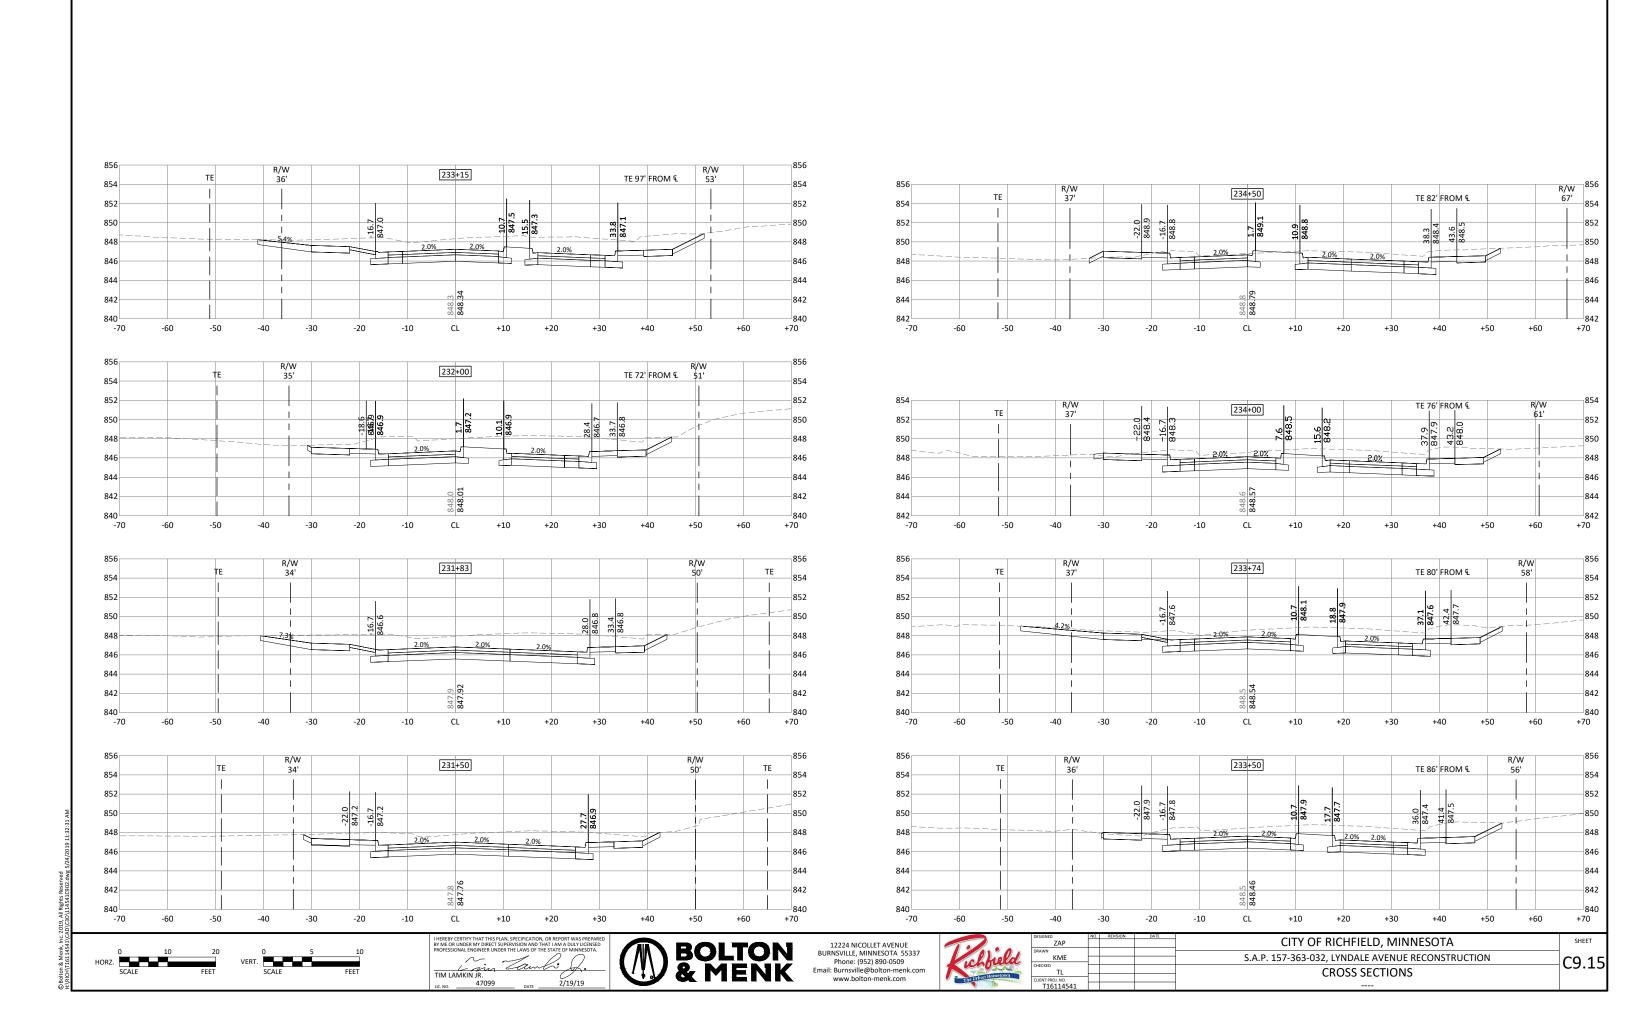


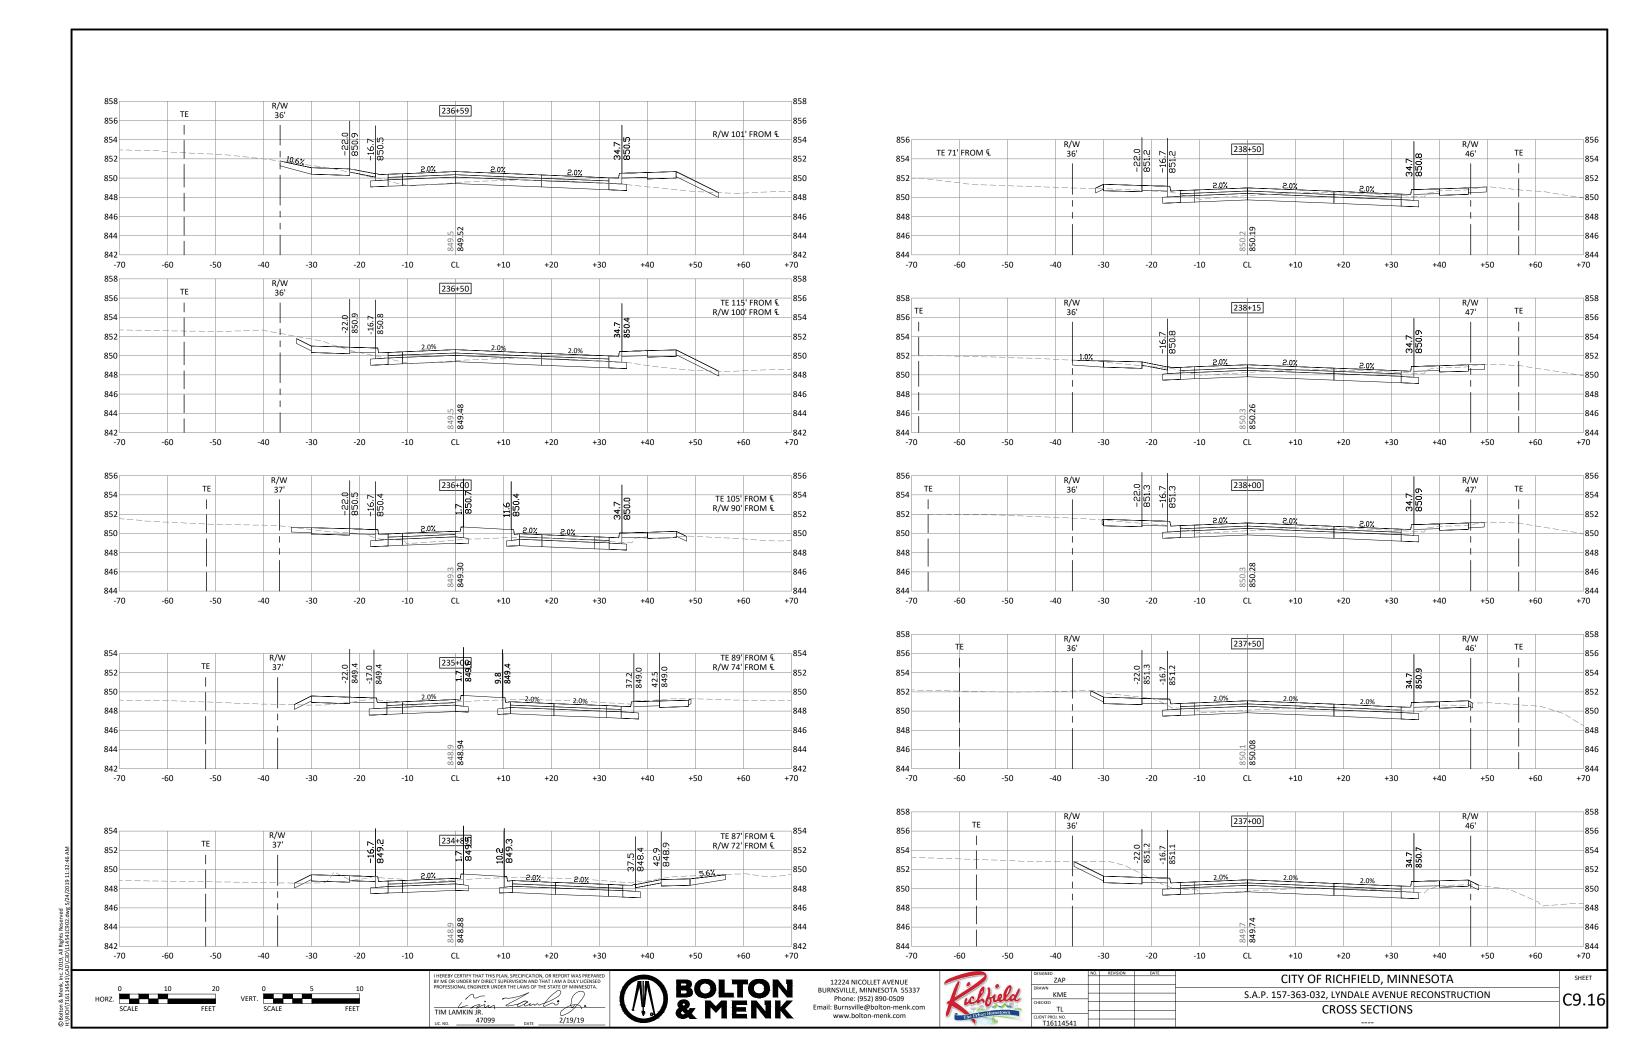


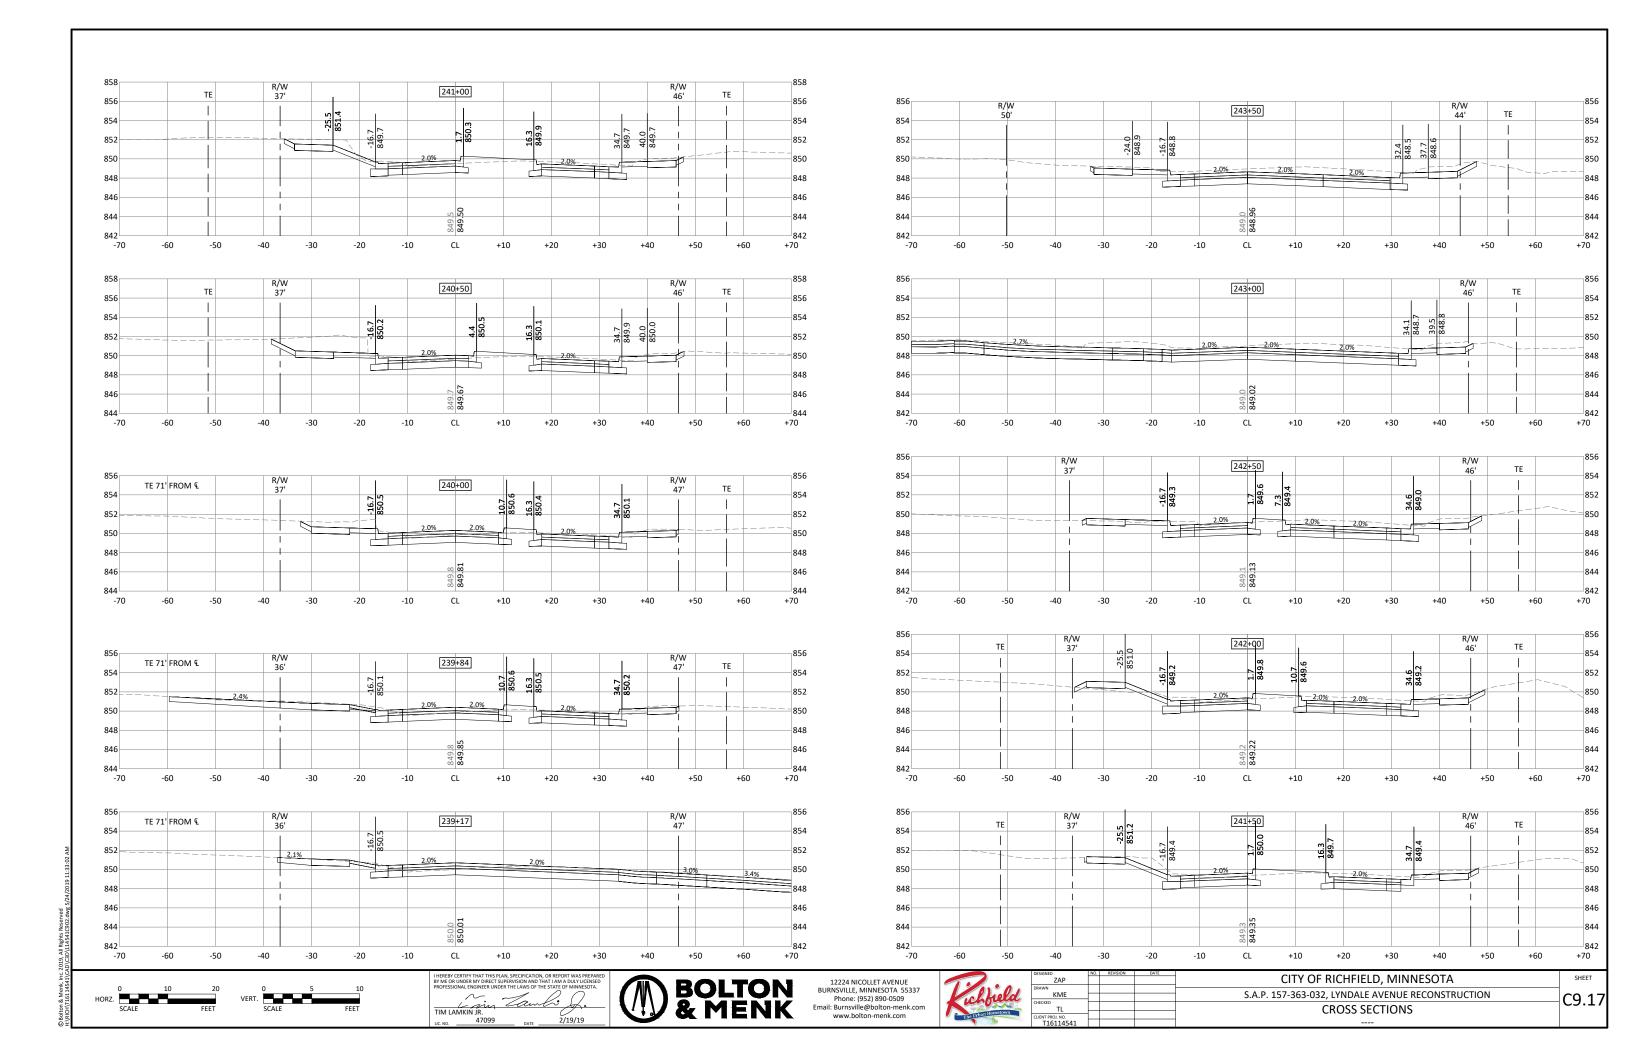


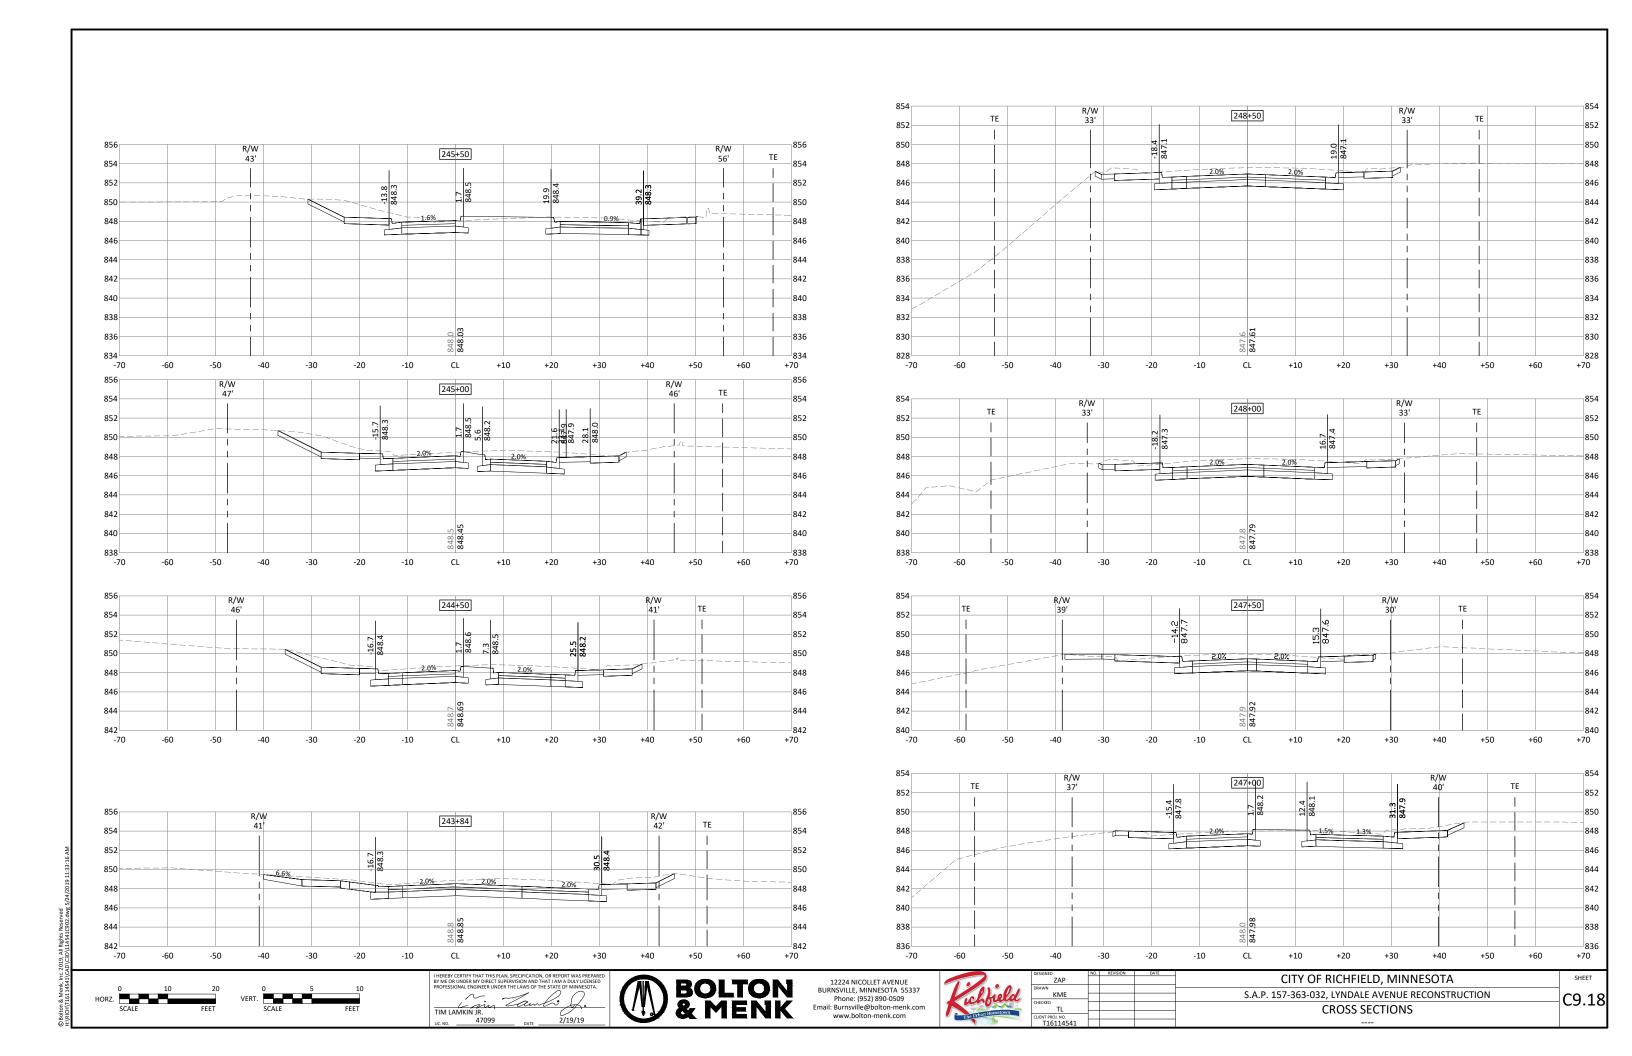


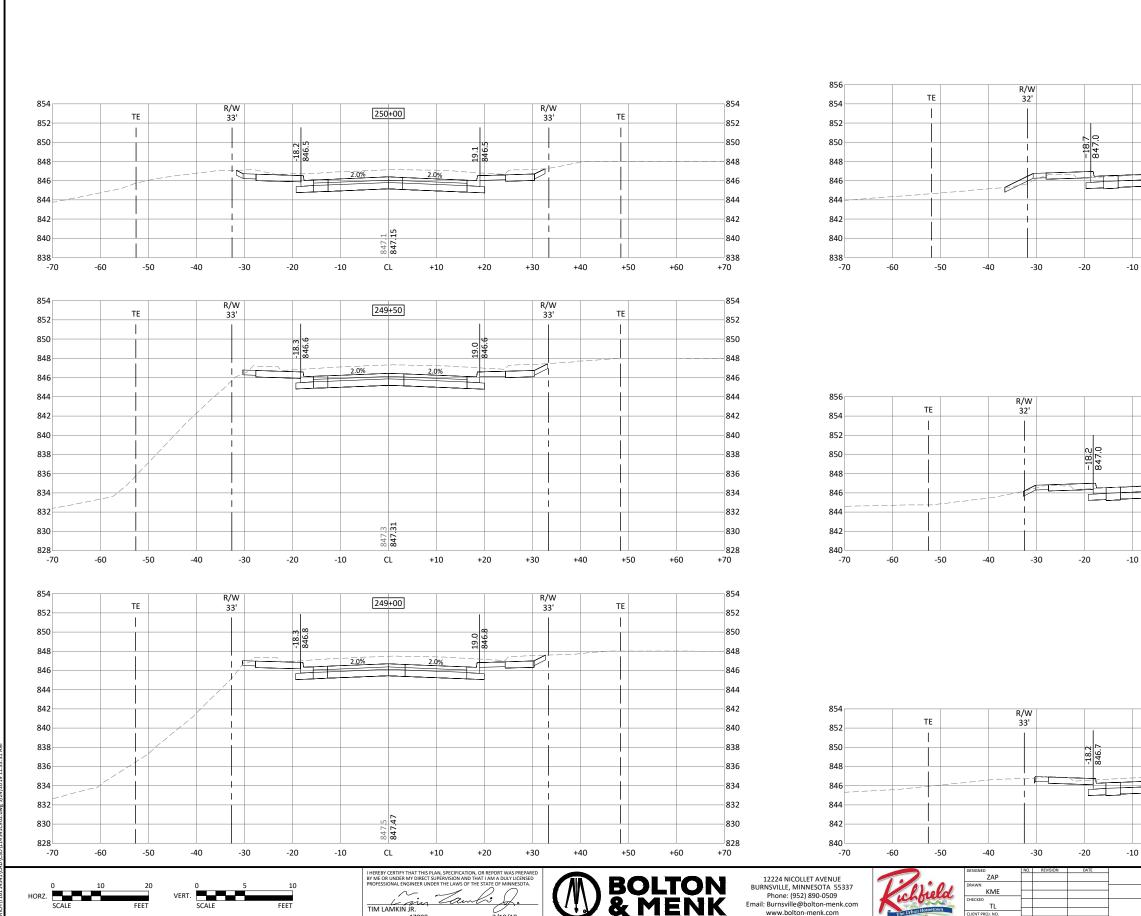

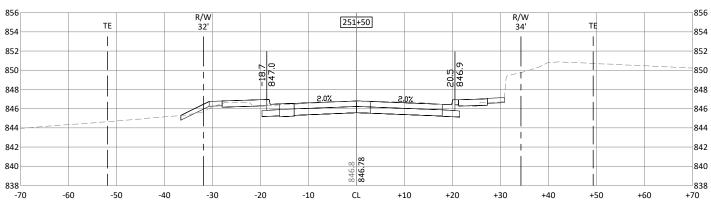

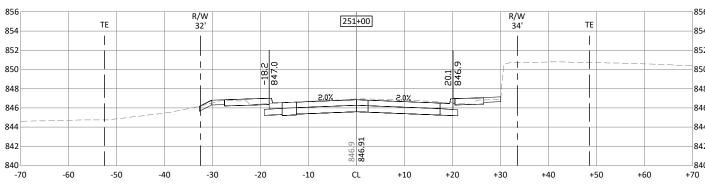

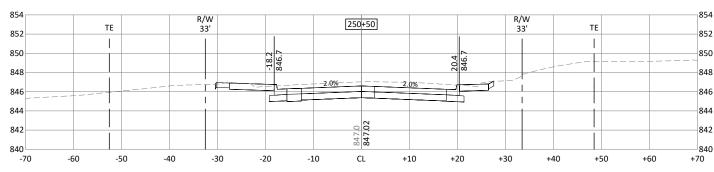

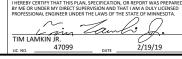





www.bolton-menk.com





IED	NO.	REVISION	DATE	0.7
ZAP				L CIT
4				
KME				S.A.P. 157-36
D TI				
PROJ. NO.				
16114541				


Y OF RICHFIELD, MINNESOTA 363-032, LYNDALE AVENUE RECONSTRUCTION C9.19 **CROSS SECTIONS**

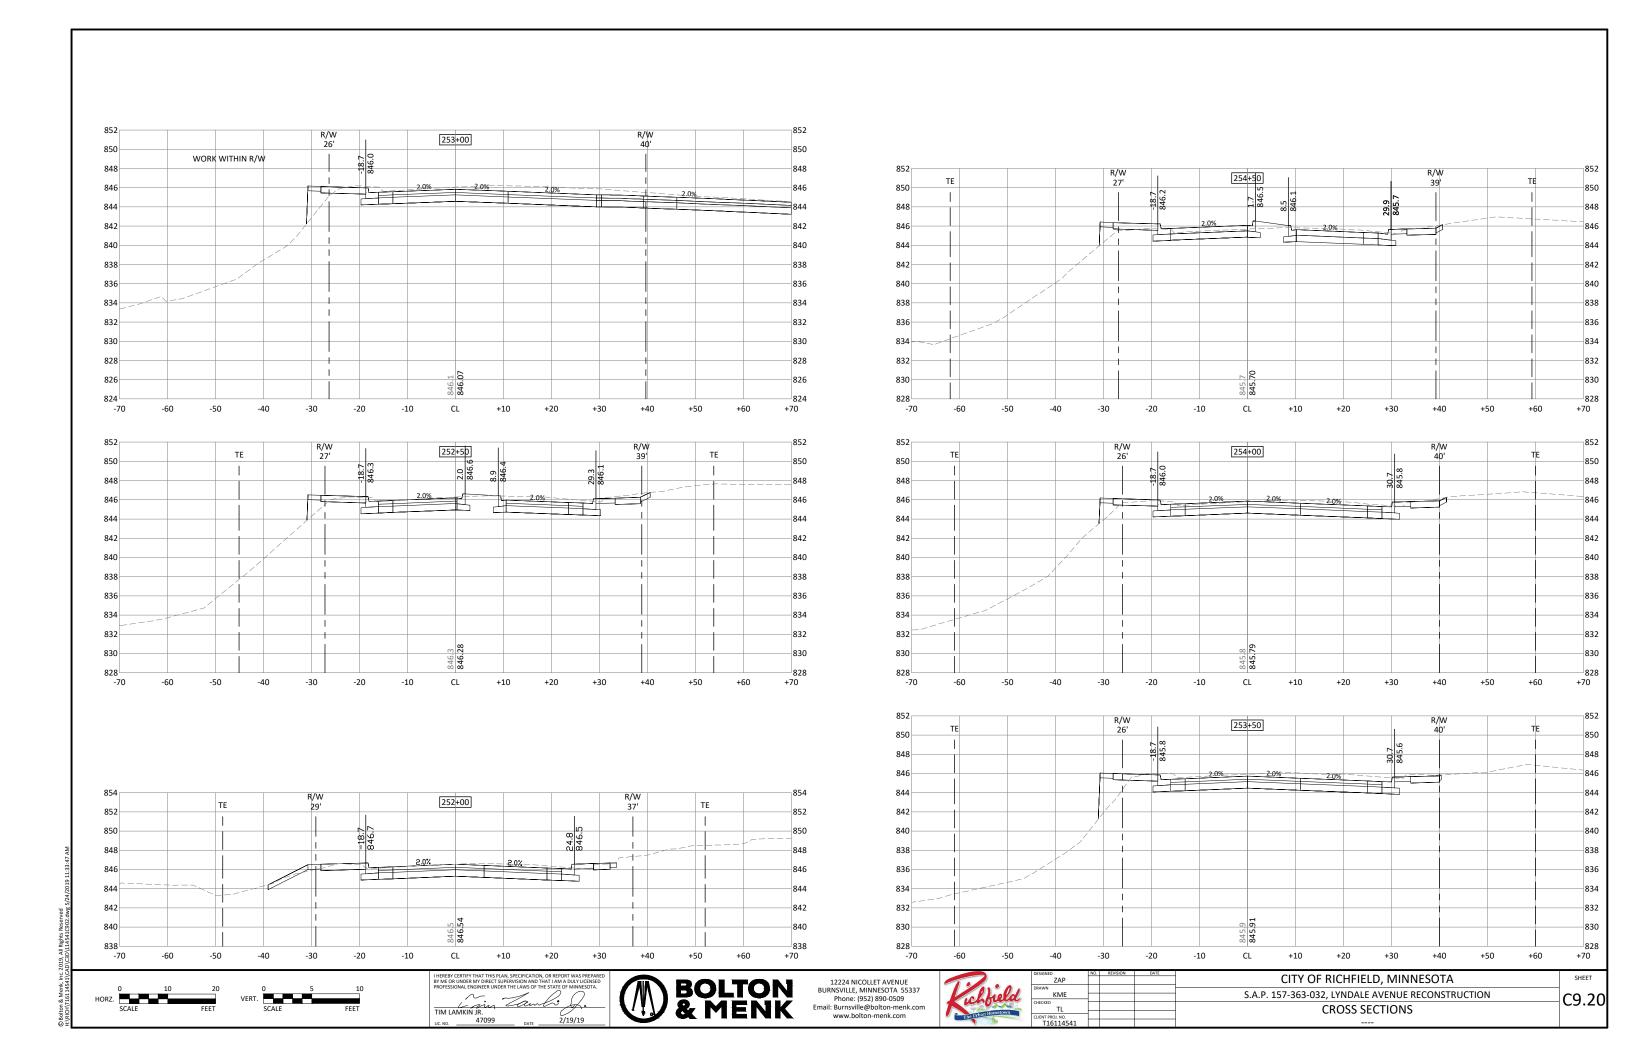


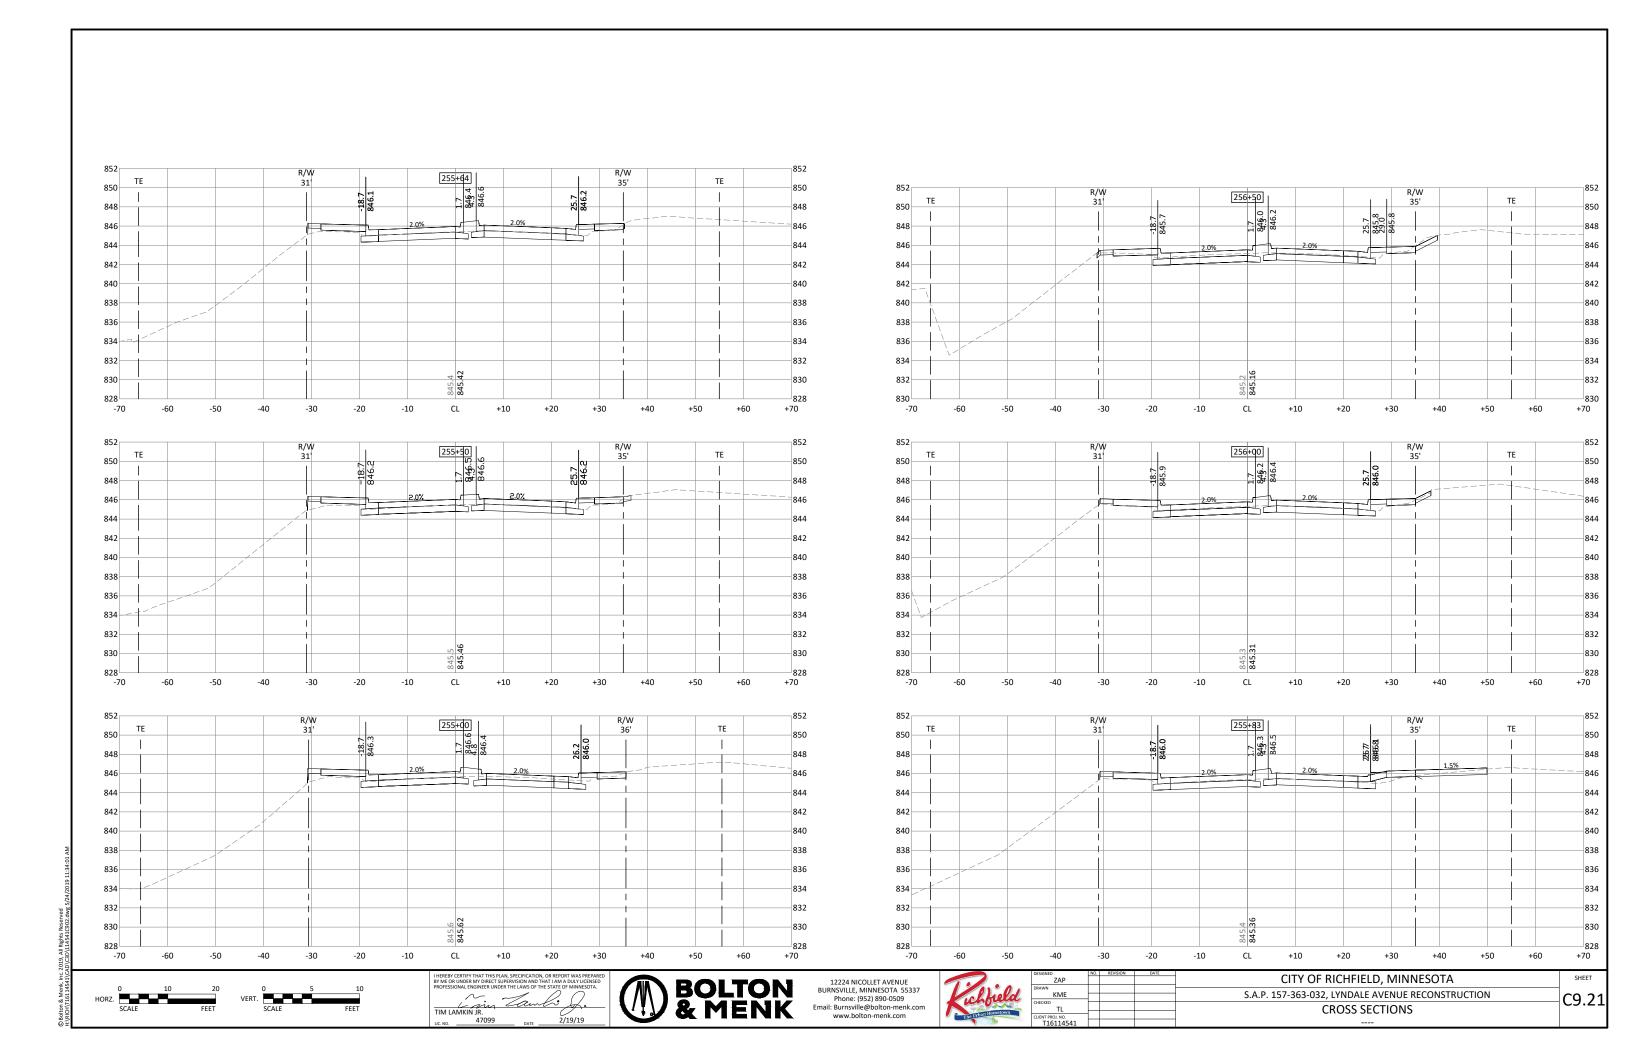


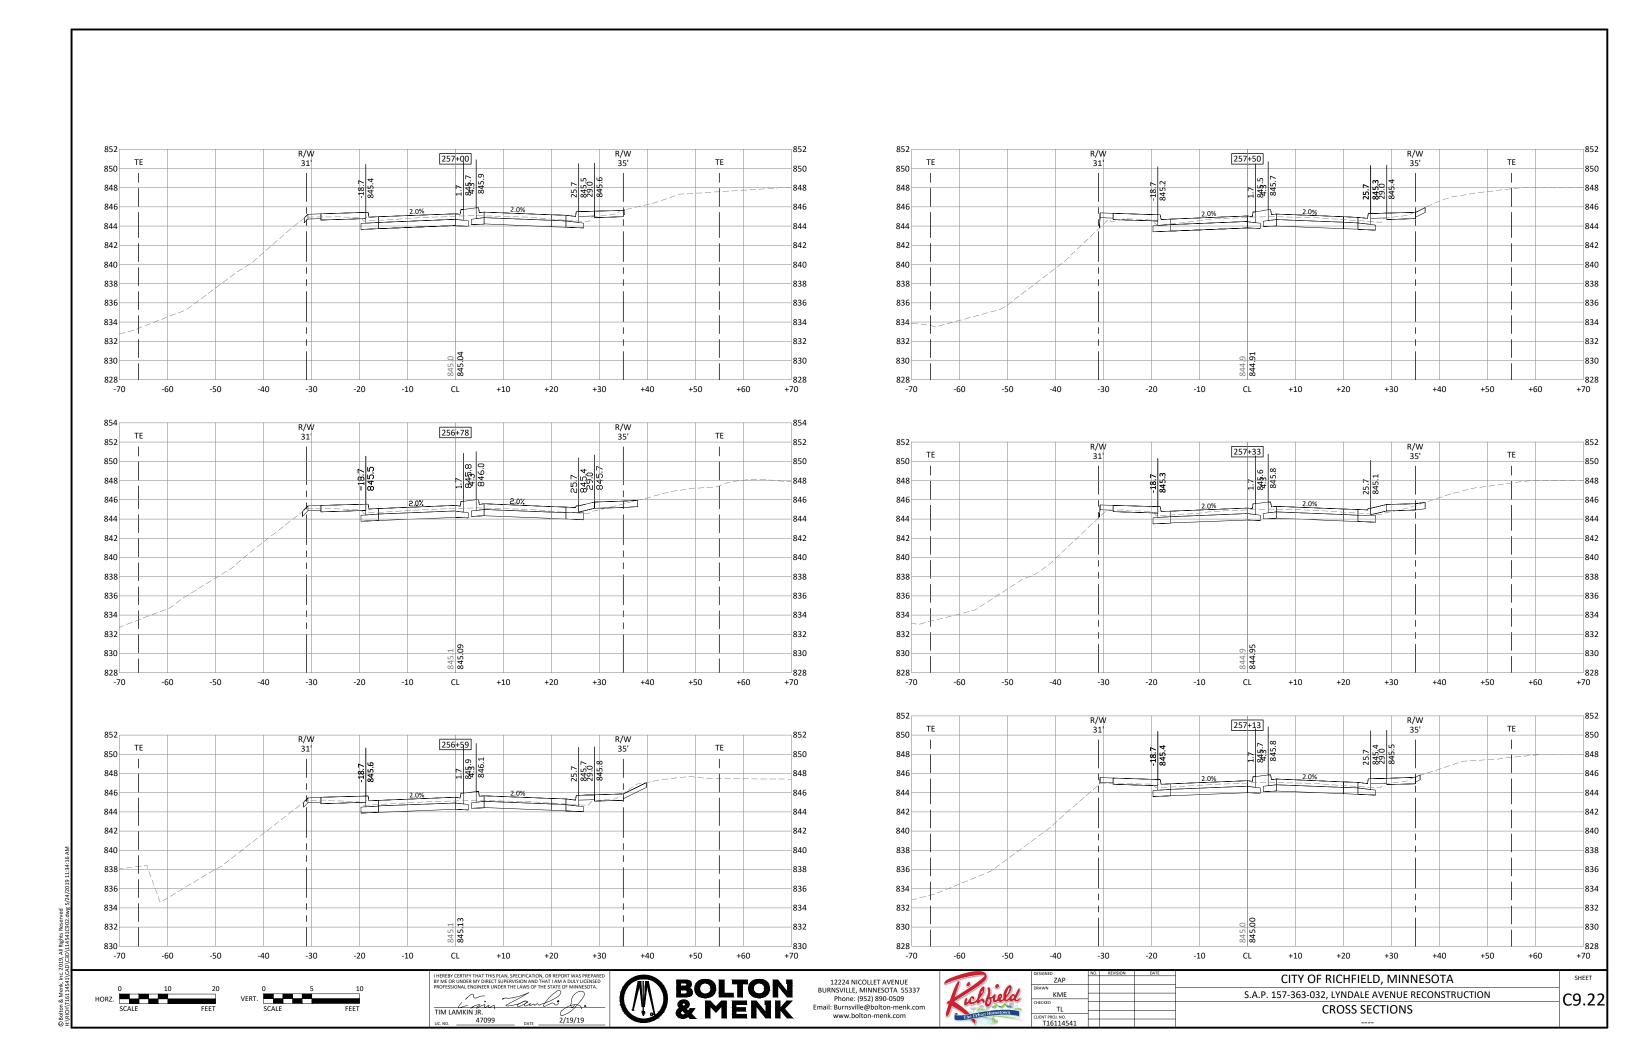


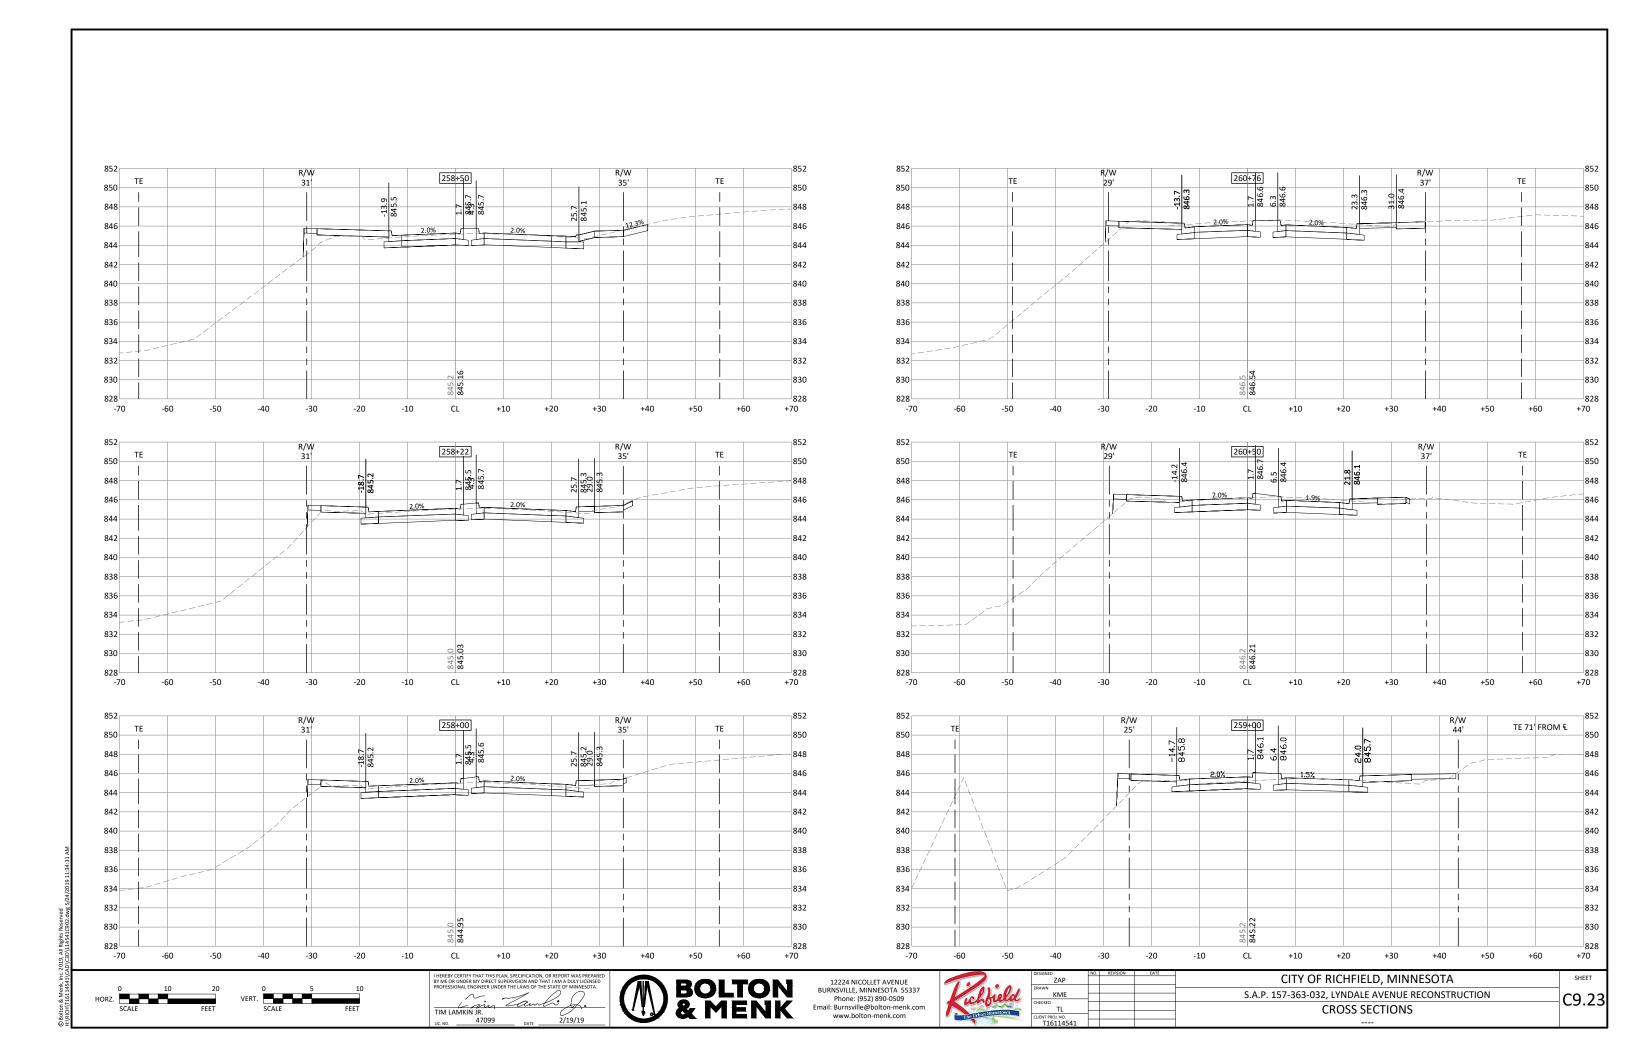


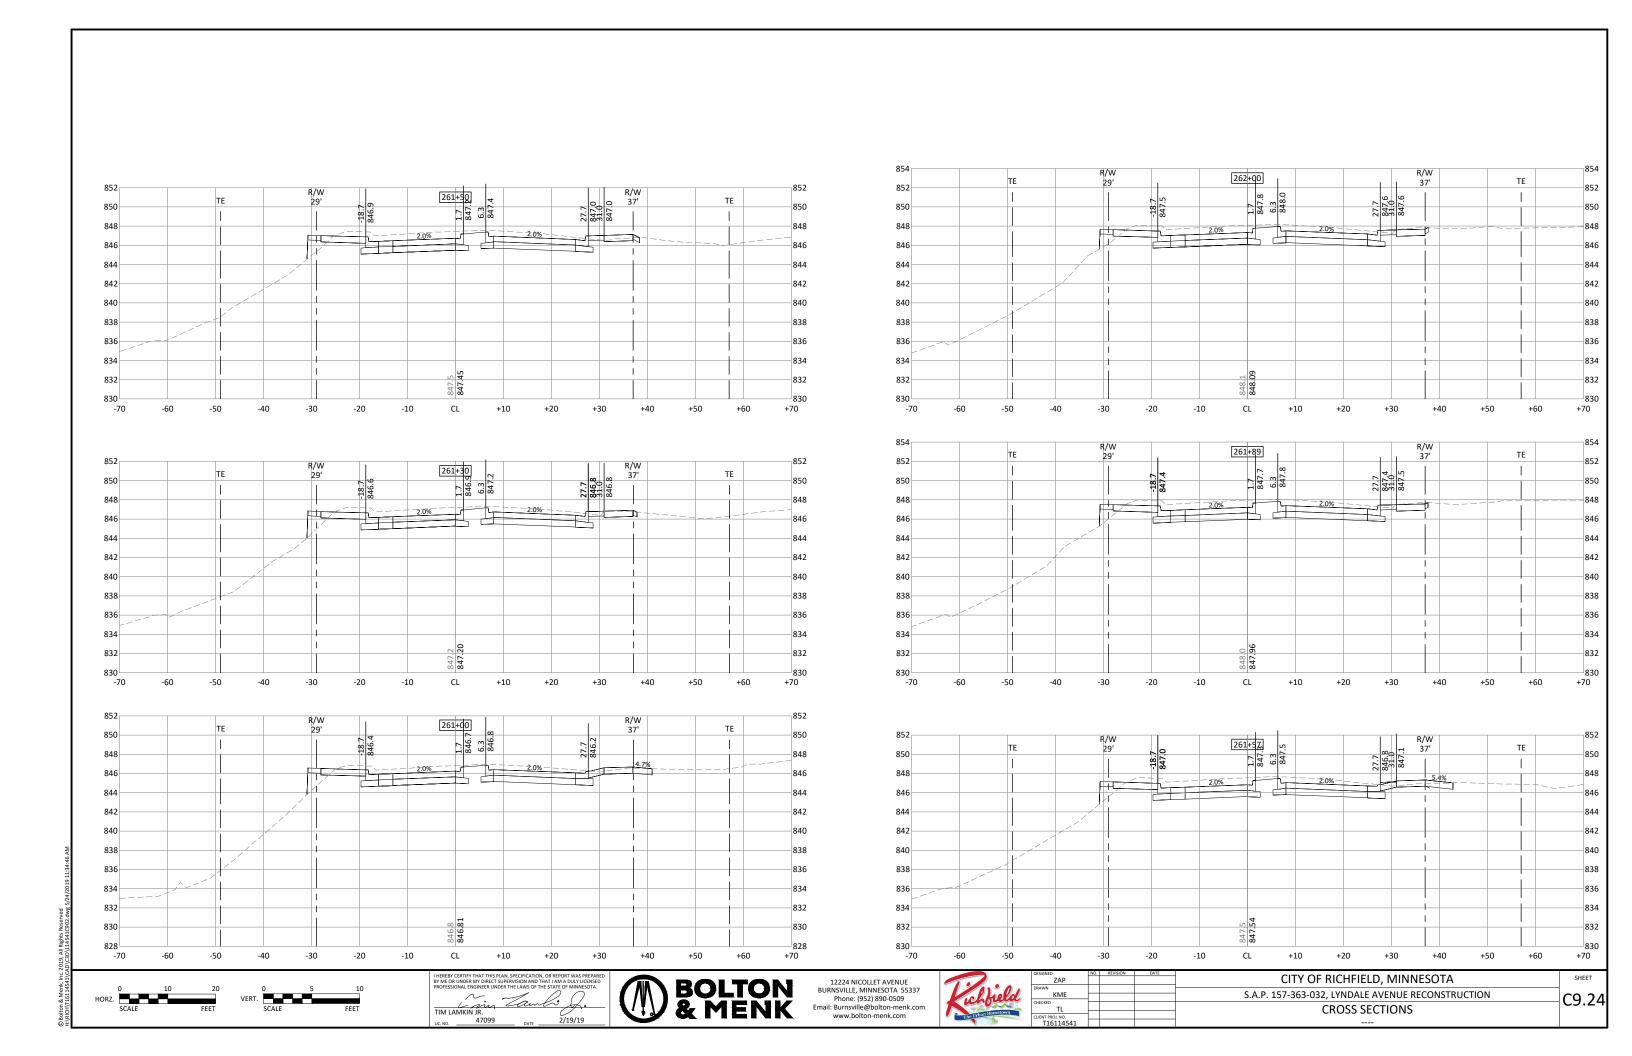


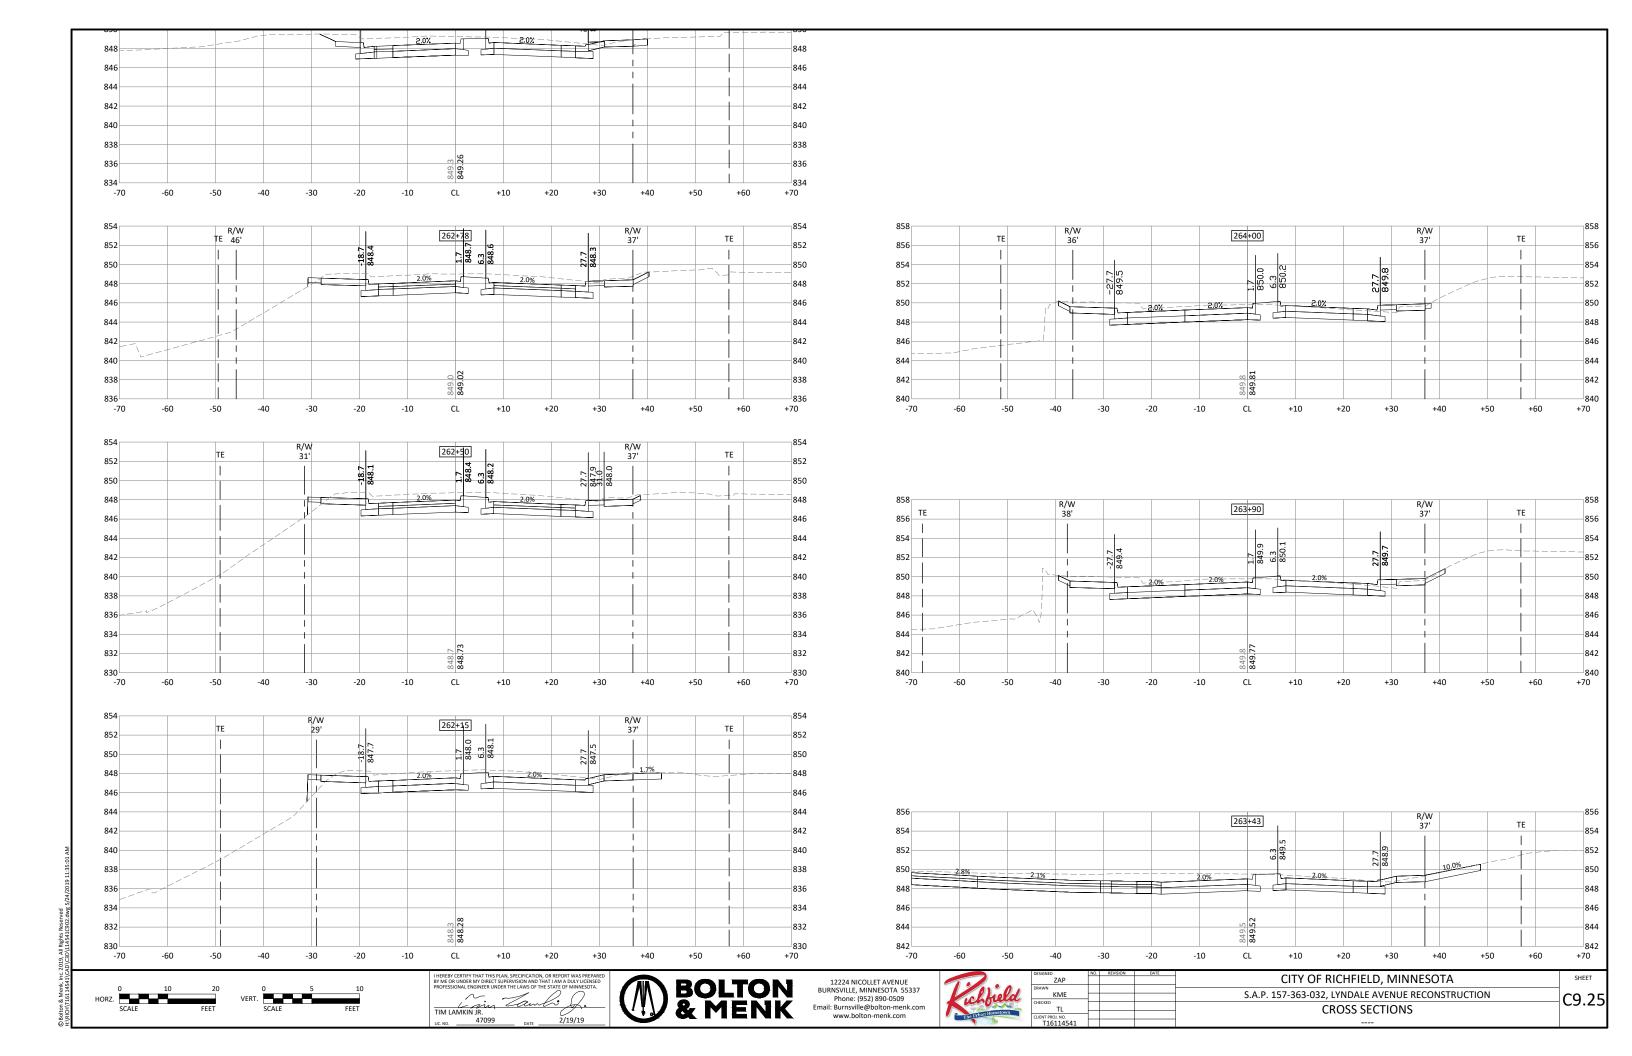

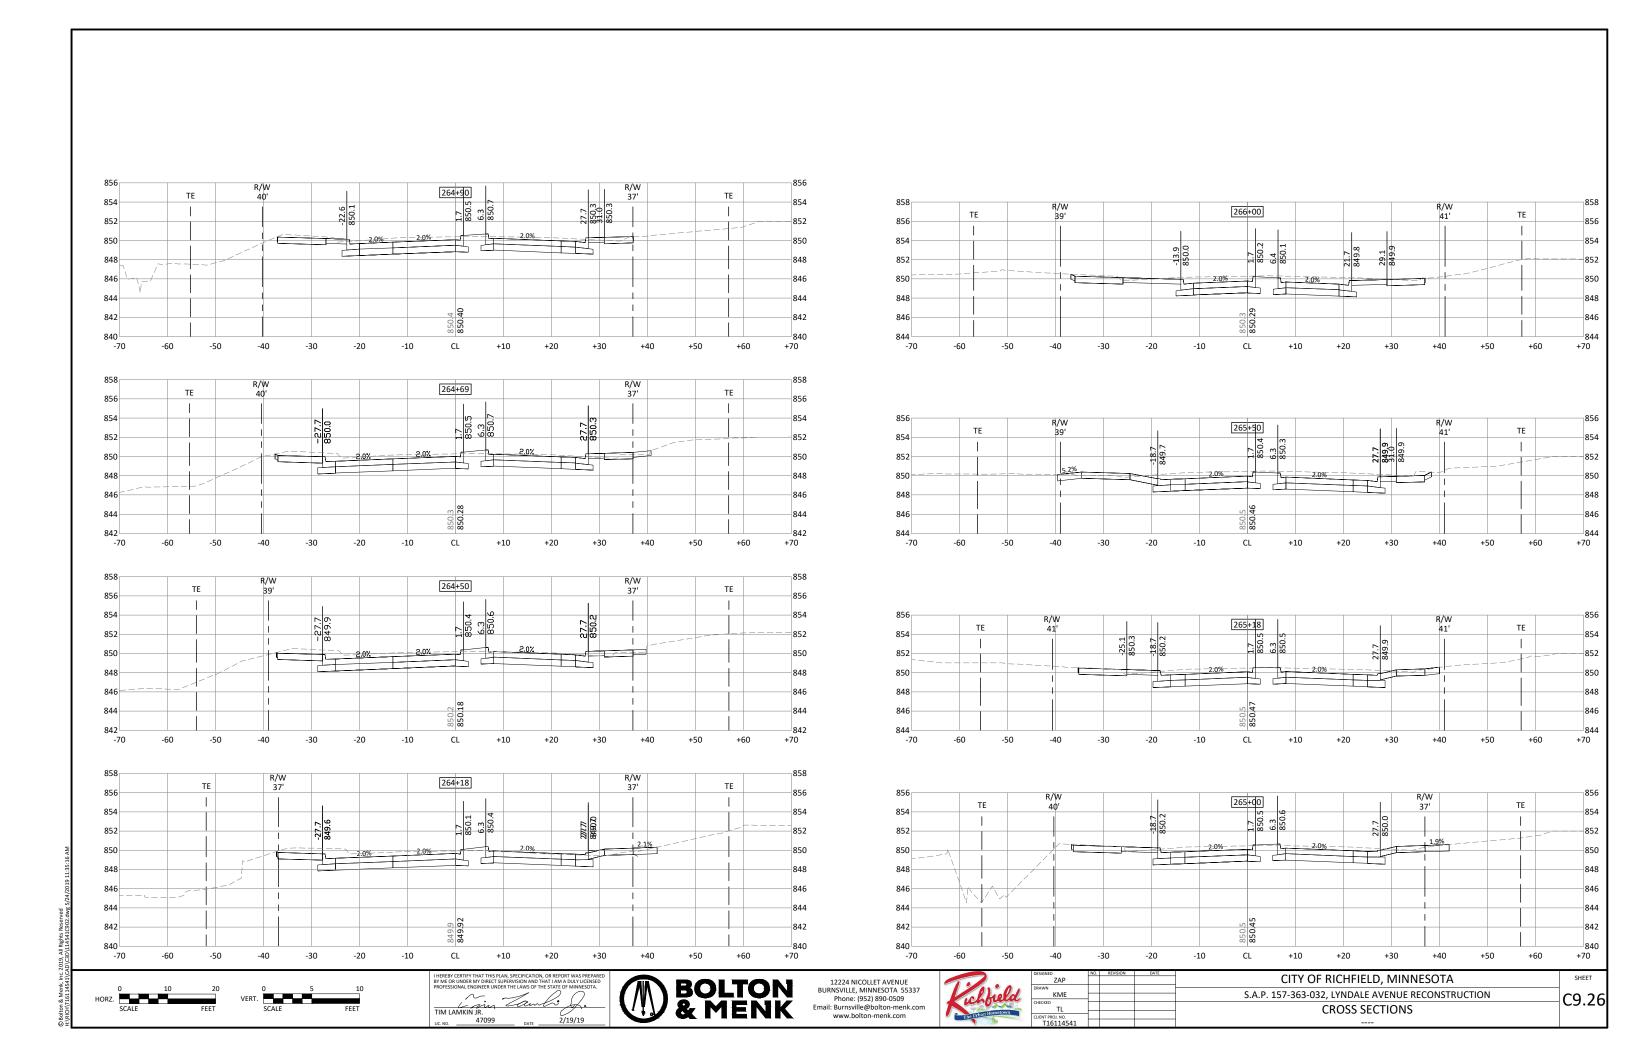

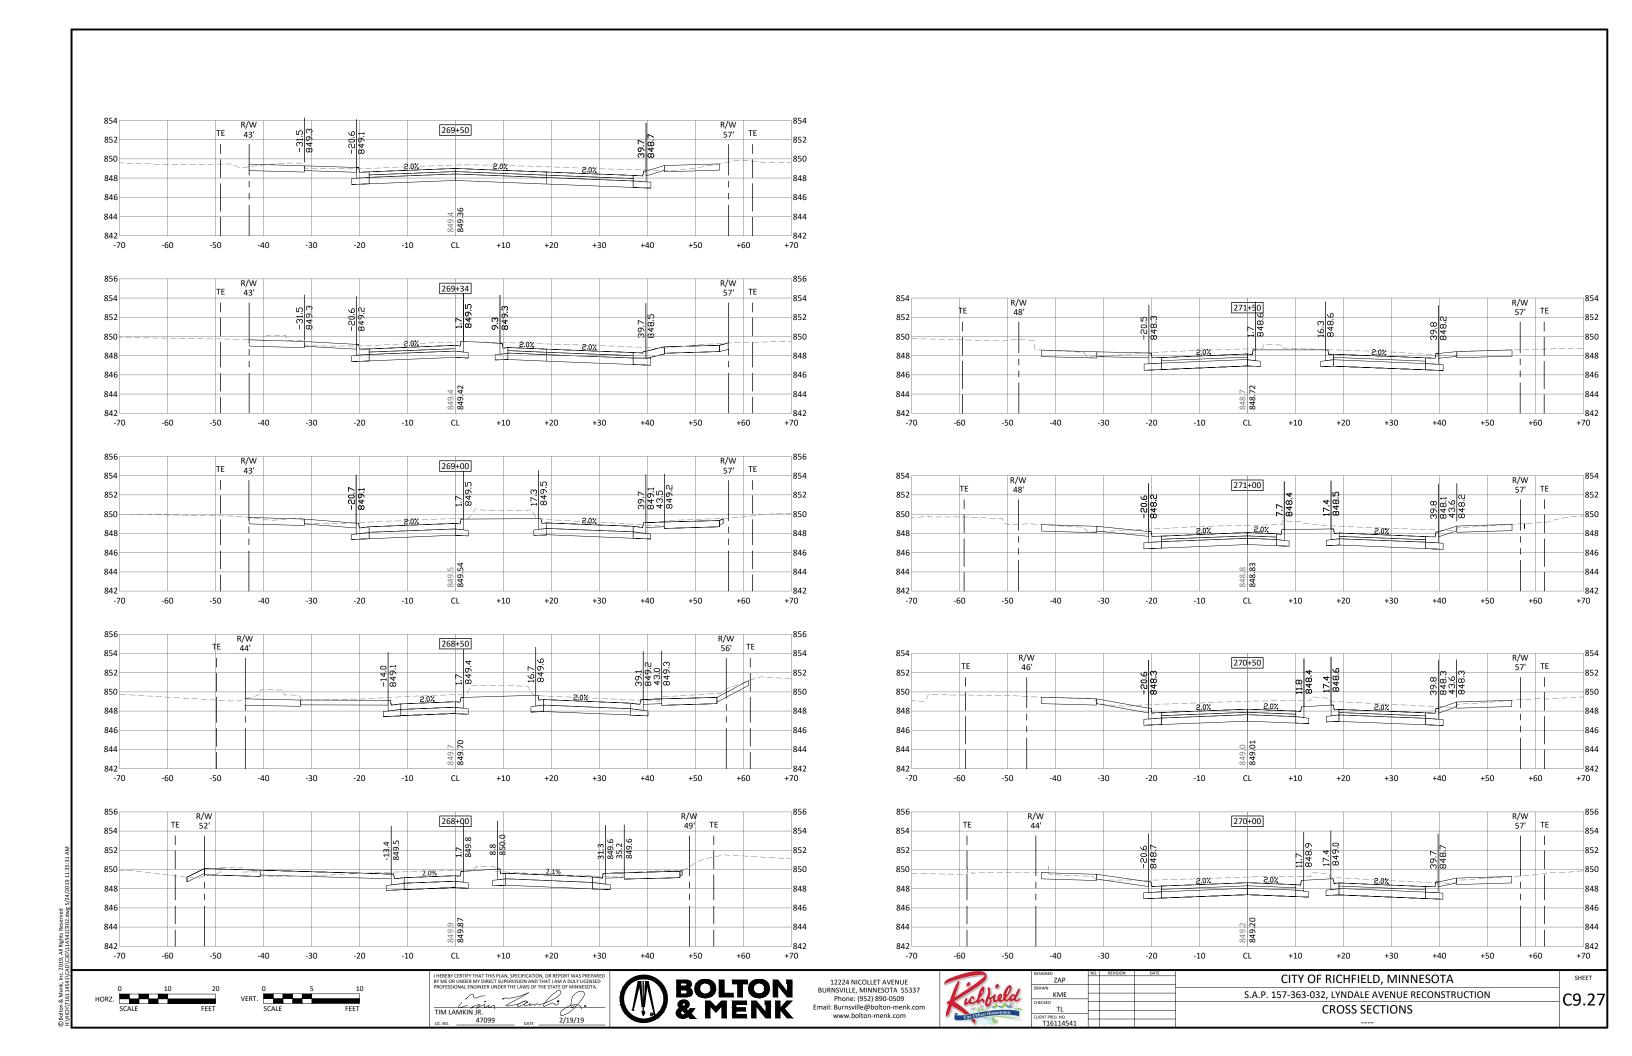

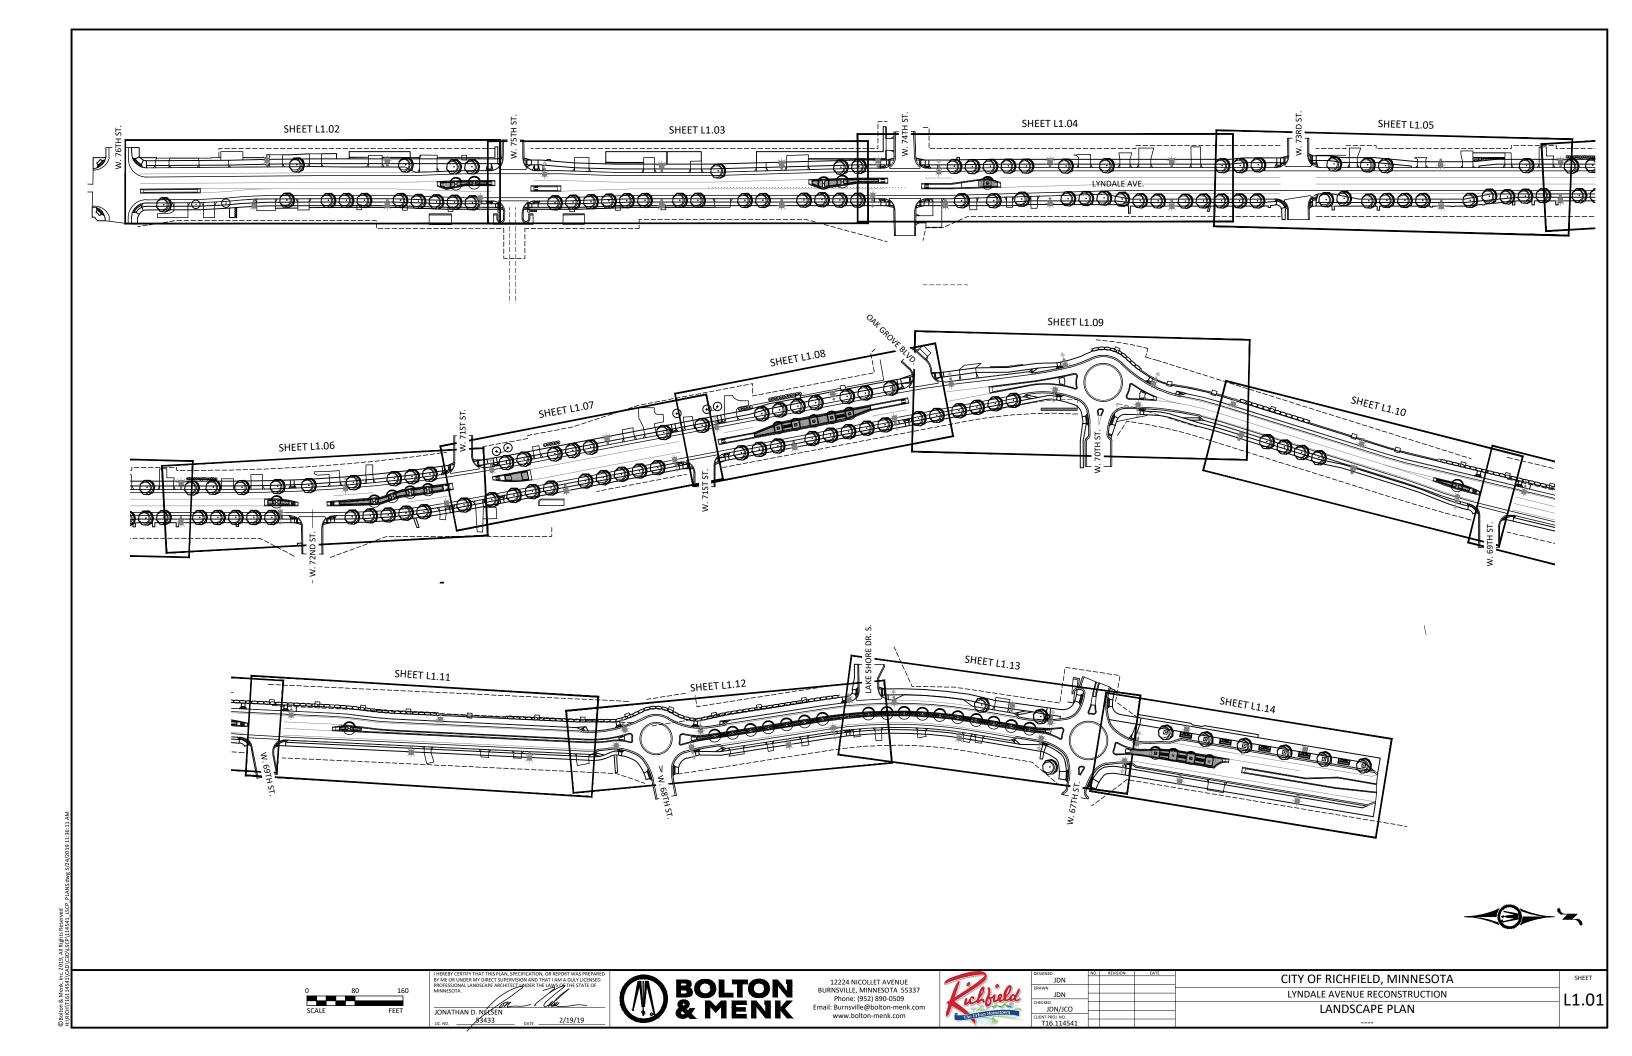

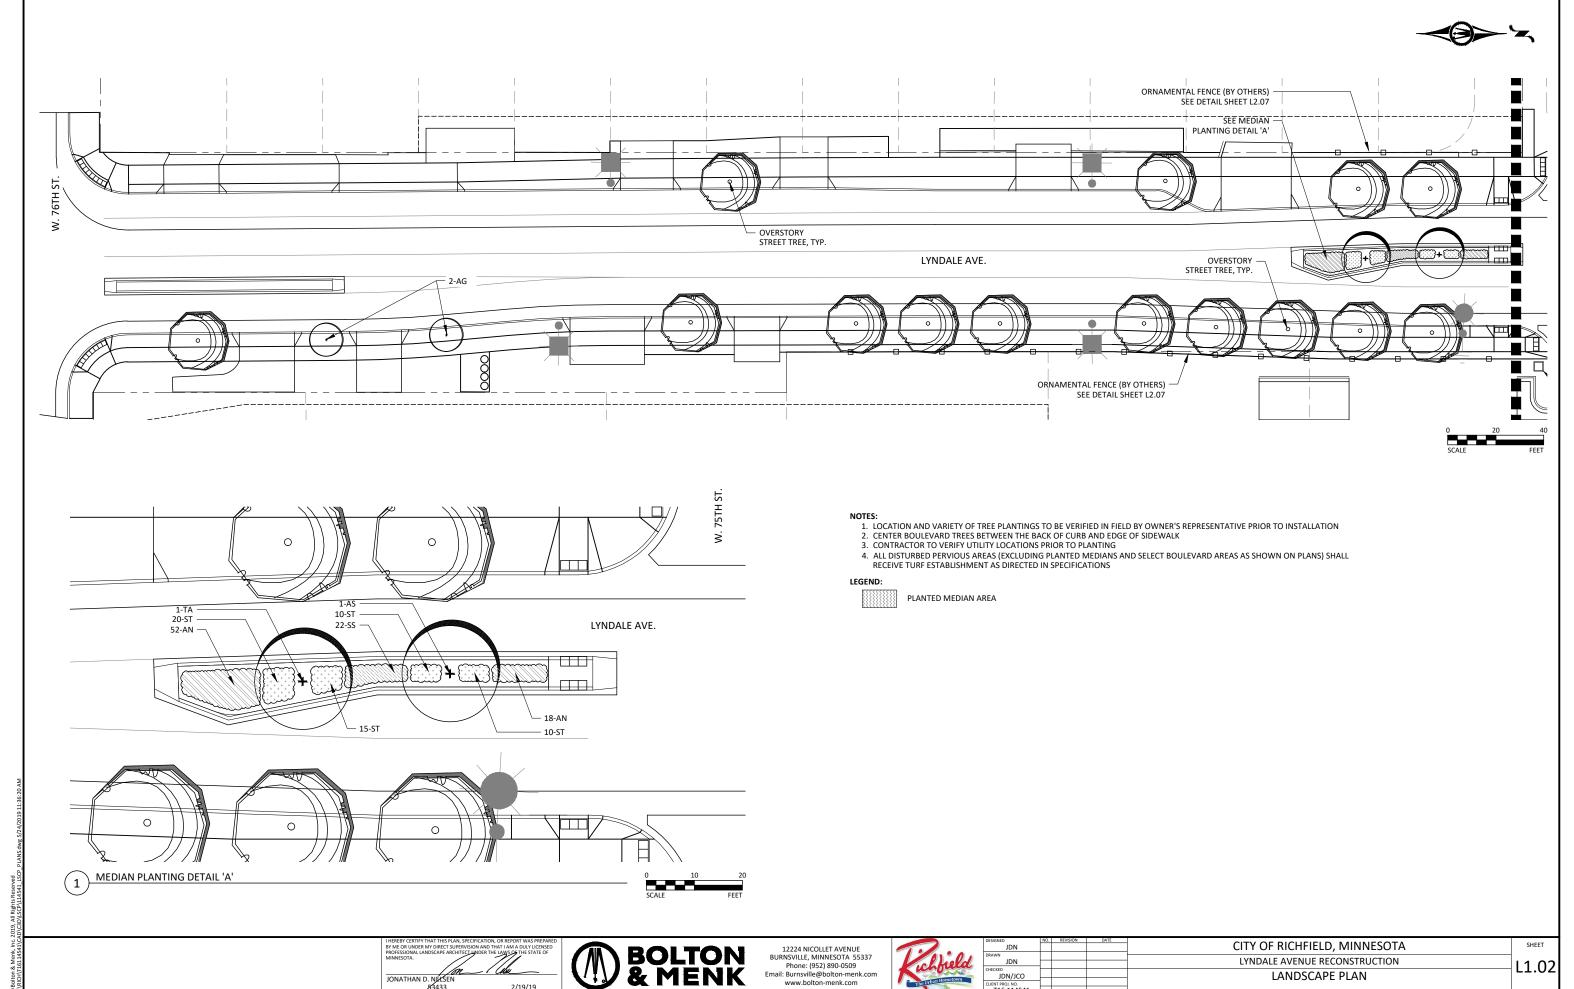



LYNDALE AVENUE RECONSTRUCTION


LANDSCAPE PLAN

JDN/JCO

L1.02

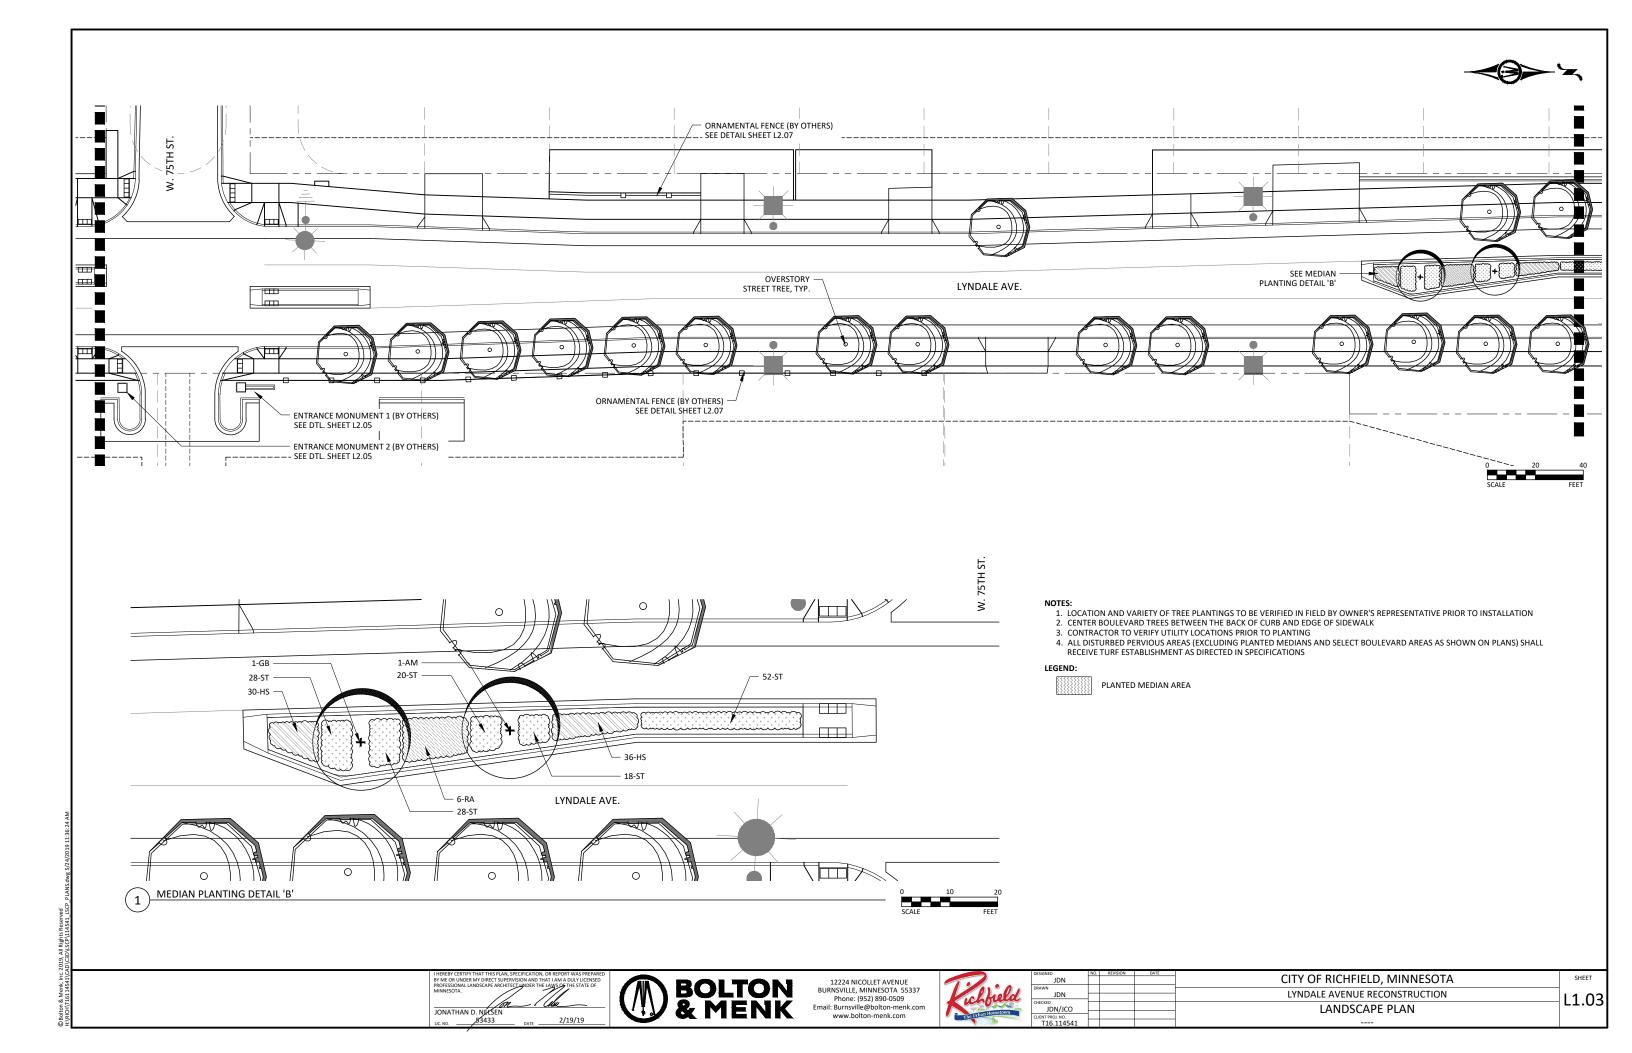

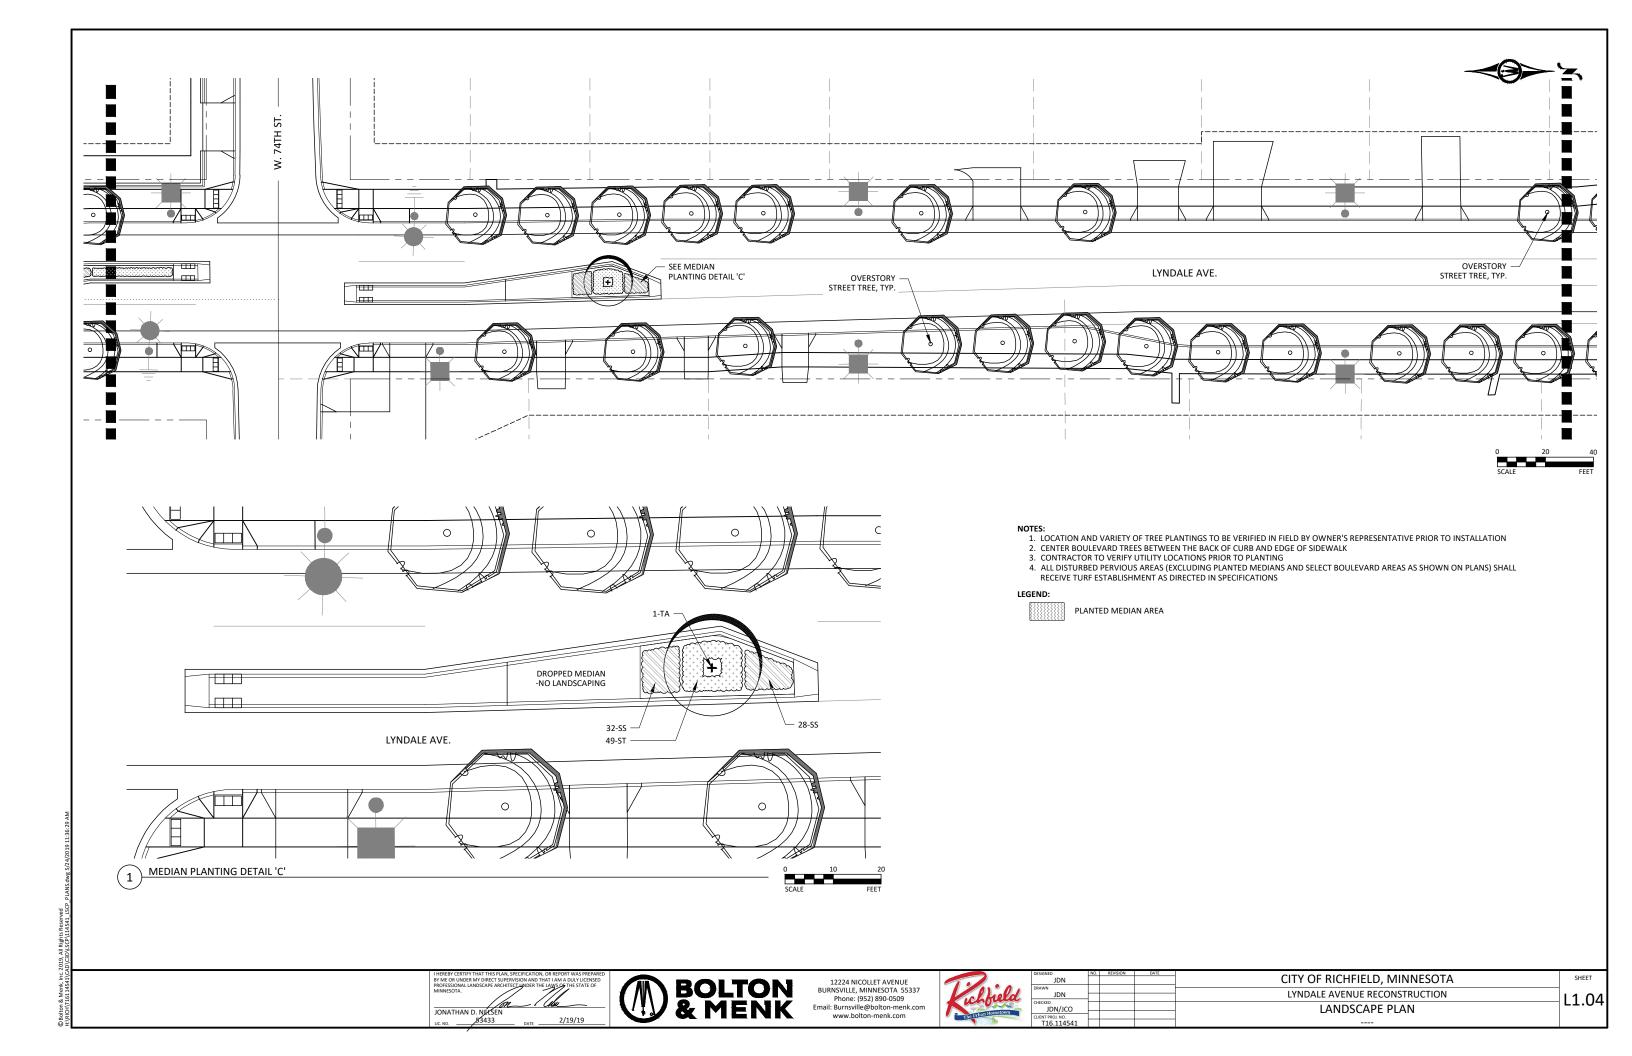

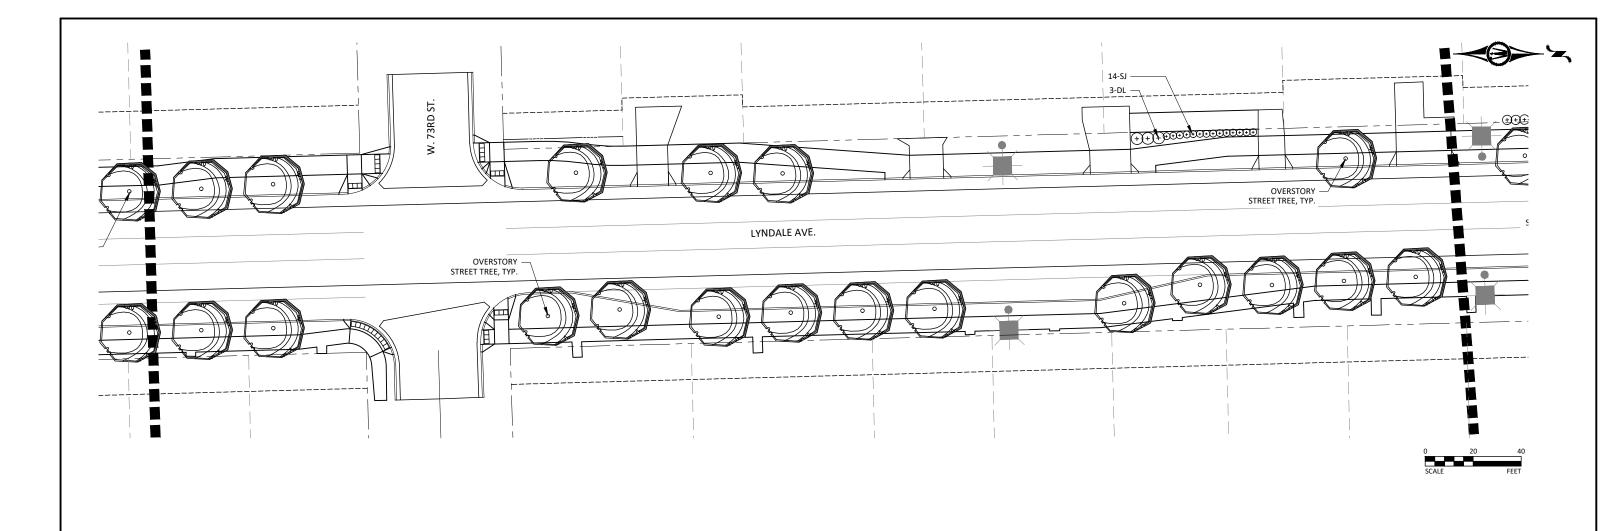

NOTES:


- 1. LOCATION AND VARIETY OF TREE PLANTINGS TO BE VERIFIED IN FIELD BY OWNER'S REPRESENTATIVE PRIOR TO INSTALLATION
 2. CENTER BOULEVARD TREES BETWEEN THE BACK OF CURB AND EDGE OF SIDEWALK
 3. CONTRACTOR TO VERIFY UTILITY LOCATIONS PRIOR TO PLANTING
 4. ALL DISTURBED PERVIOUS AREAS (EXCLUDING PLANTED MEDIANS AND SELECT BOULEVARD AREAS AS SHOWN ON PLANS) SHALL RECEIVE TURF ESTABLISHMENT AS DIRECTED IN SPECIFICATIONS

PLANTED MEDIAN AREA






DESIGNED	NO.	REVISION	DATE
JDN			
DRAWN			
JDN	\Box		
CHECKED	\neg		
JDN/JCO	\vdash		
CLIENT PROJ. NO.			
TAC AAAFAA			

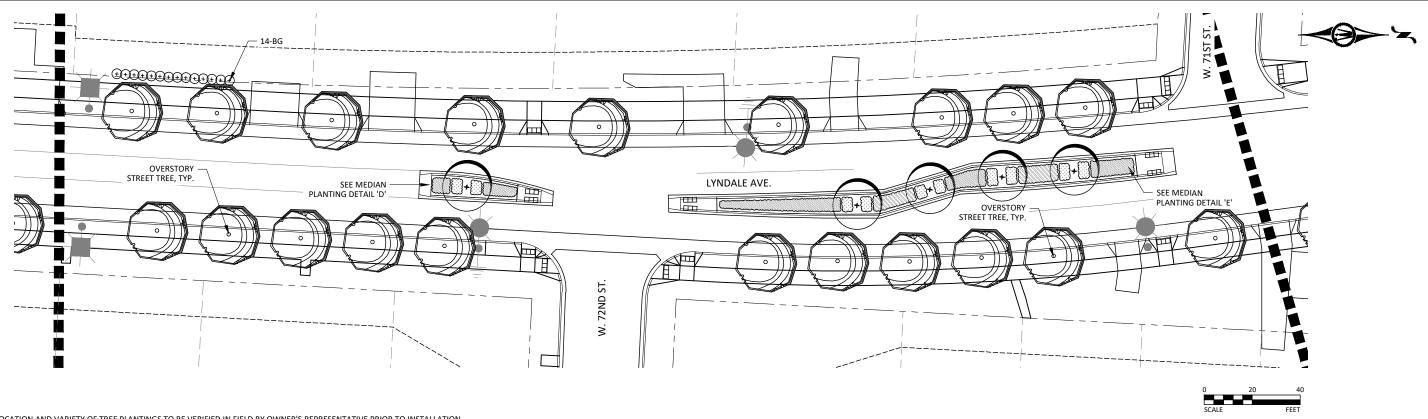

- 1. LOCATION AND VARIETY OF TREE PLANTINGS TO BE VERIFIED IN FIELD BY OWNER'S REPRESENTATIVE PRIOR TO INSTALLATION
 2. CENTER BOULEVARD TREES BETWEEN THE BACK OF CURB AND EDGE OF SIDEWALK
- 3. CONTRACTOR TO VERIFY UTILITY LOCATIONS PRIOR TO PLANTING
- 4. ALL DISTURBED PERVIOUS AREAS (EXCLUDING PLANTED MEDIANS AND SELECT BOULEVARD AREAS AS SHOWN ON PLANS) SHALL RECEIVE TURF ESTABLISHMENT AS DIRECTED IN SPECIFICATIONS



PLANTED MEDIAN AREA

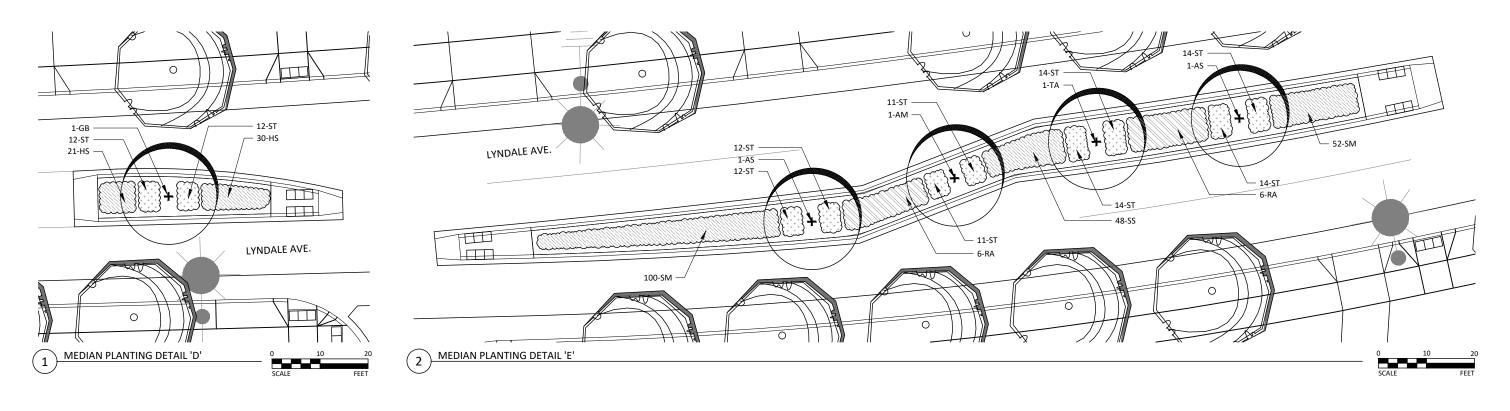


I HEREBY CERTIFY THAT THIS PLAN, SPE			
BY ME OR UNDER MY DIRECT SUPERVIS)
PROFESSIONAL LANDSCAPE ARCHITECT	LINDER T	THE LAWS OF THE STATE OF	
MINNESOTA.	/	-///	
//		///	
/m_	_ /	Clbu	
JONATHAN D. NELSEN		•	_
82/122		2/19/19	
LIC. NO	DATE	2/13/13	_




12224 NICOLLET AVENUE BURNSVILLE, MINNESOTA 55337 Phone: (952) 890-0509 Email: Burnsville@bolton-menk.com www.bolton-menk.com

DESIGNED	NO.	REVIS
JDN		
DRAWN		
JDN		
CHECKED		
JDN/JCO		
CLIENT PROJ. NO. T16 114541	\vdash	

CITY OF RICHFIELD, MINNESOTA LYNDALE AVENUE RECONSTRUCTION LANDSCAPE PLAN

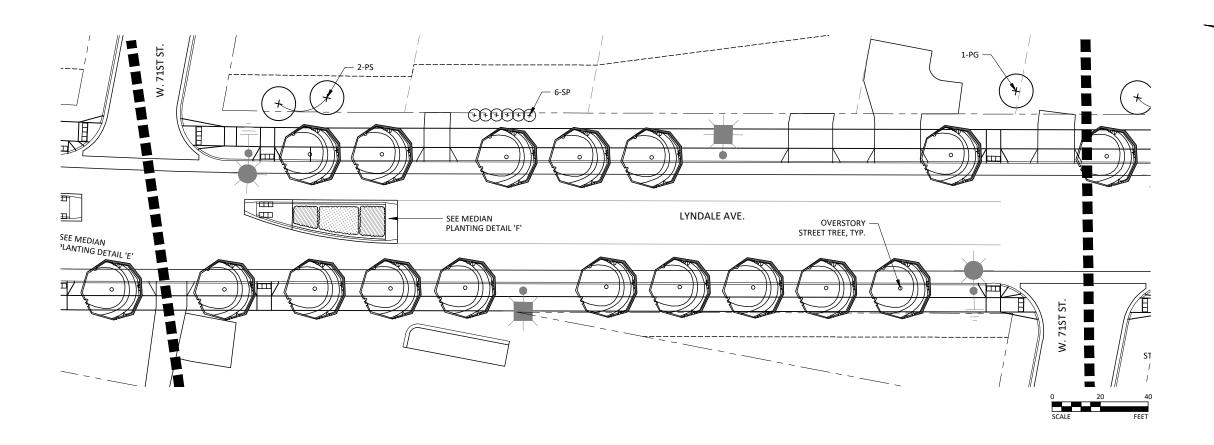

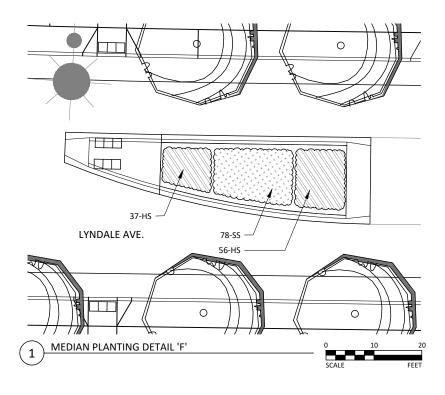

- 1. LOCATION AND VARIETY OF TREE PLANTINGS TO BE VERIFIED IN FIELD BY OWNER'S REPRESENTATIVE PRIOR TO INSTALLATION
 2. CENTER BOULEVARD TREES BETWEEN THE BACK OF CURB AND EDGE OF SIDEWALK
 3. CONTRACTOR TO VERIFY UTILITY LOCATIONS PRIOR TO PLANTING

- 4. ALL DISTURBED PERVIOUS AREAS (EXCLUDING PLANTED MEDIANS AND SELECT BOULEVARD AREAS AS SHOWN ON PLANS) SHALL RECEIVE TURF ESTABLISHMENT AS DIRECTED IN SPECIFICATIONS


PLANTED MEDIAN AREA








	DESIGNED
	JDN
0	DRAWN
101.	JDN
	CHECKED
WD	JDN/JCO
	CLIENT PROJ. NO.
	T16 114541

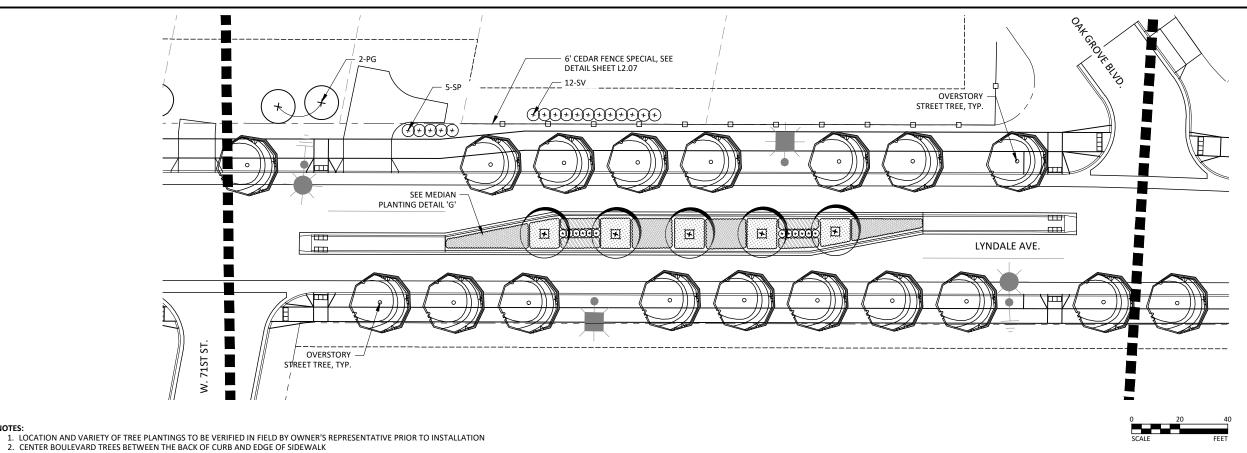

- 3. CONTRACTOR TO VERIFY UTILITY LOCATIONS PRIOR TO PLANTING
- 4. ALL DISTURBED PERVIOUS AREAS (EXCLUDING PLANTED MEDIANS AND SELECT BOULEVARD AREAS AS SHOWN ON PLANS) SHALL RECEIVE TURF ESTABLISHMENT AS DIRECTED IN SPECIFICATIONS

PLANTED MEDIAN AREA

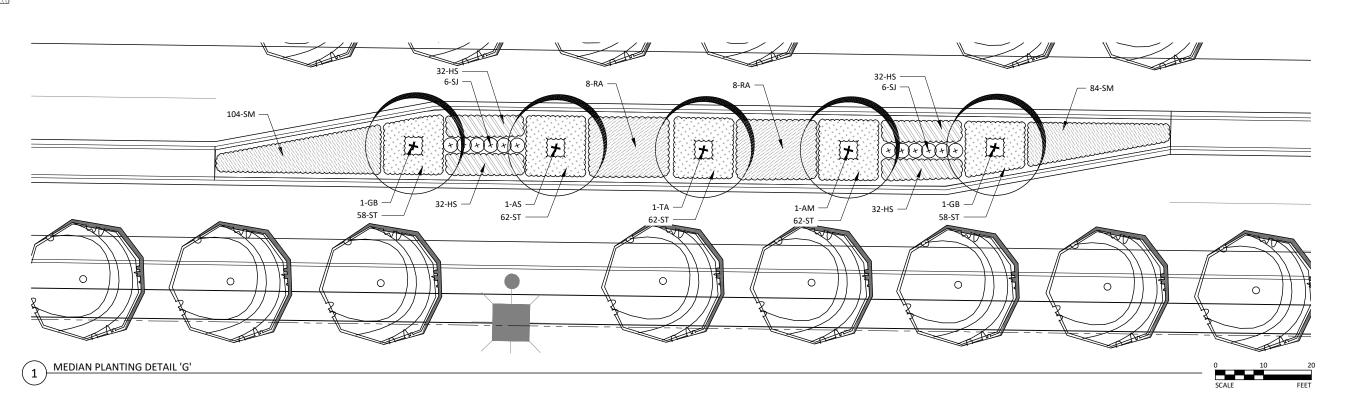


JONATHAN D. NECSEN



12224 NICOLLET AVENUE BURNSVILLE, MINNESOTA 55337 Phone: (952) 890-0509 Email: Burnsville@bolton-menk.com www.bolton-menk.com



ESIGNED	NO.	REVISION	DATE	
JDN				CITY OF RICHFIELD, MINNESOTA
RAWN				·
				LVNDALE AVENUE DECONSTRUCTION
JDN				LYNDALE AVENUE RECONSTRUCTION
HECKED				
JDN/JCO				LANDSCAPE PLAN
JENT PROJ. NO.			l	

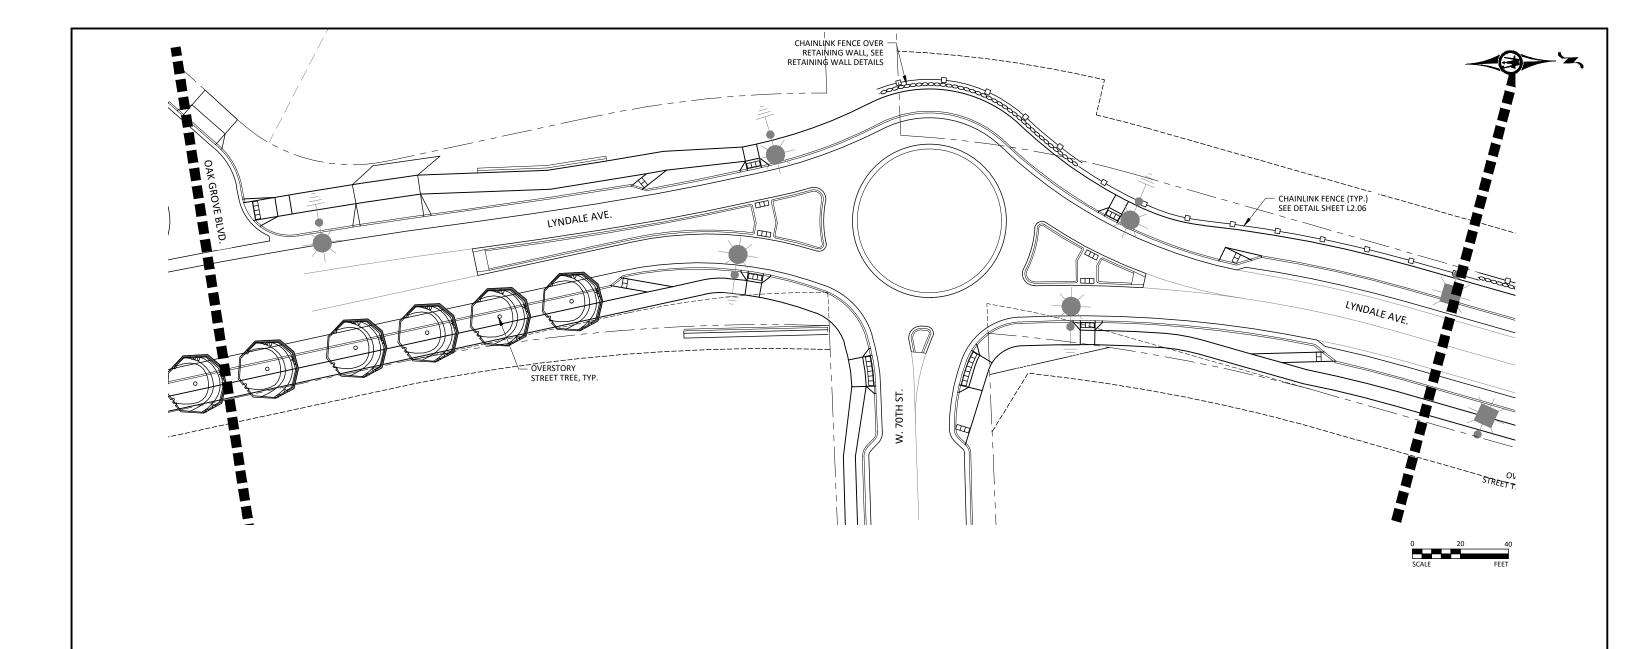

- NOTES:

 1. LOCATION AND VARIETY OF TREE PLANTINGS TO BE VERIFIED IN FIELD BY OWNER'S REPRESENTATIVE PRIOR TO INSTALLATION
 2. CENTER BOULEVARD TREES BETWEEN THE BACK OF CURB AND EDGE OF SIDEWALK
 3. CONTRACTOR TO VERIFY UTILITY LOCATIONS PRIOR TO PLANTING

 2. CENTER BOULEVARD AREA OF SHOWN ON PLANTING TO PLANTING THE PROPERTY OF THE PROPERTY OF THE PLANTING THE PROPERTY OF THE PLANTING THE PLAN
- 4. ALL DISTURBED PERVIOUS AREAS (EXCLUDING PLANTED MEDIANS AND SELECT BOULEVARD AREAS AS SHOWN ON PLANS) SHALL RECEIVE TURF ESTABLISHMENT AS DIRECTED IN SPECIFICATIONS

L1.09


LEGEND:


PLANTED MEDIAN AREA





	DESIGNED	NO.	REVISION	DATE	CITY OF BIGUESE B. MANNESCEA	
	JDN DRAWN				CITY OF RICHFIELD, MINNESOTA	
0 4					LANDALE ALEMAN DECOMPONICATION	
DRAWN JDN CHECKED JDN/JCO CLIENT PROJ. NO. T16.114541	JDN				LYNDALE AVENUE RECONSTRUCTION	
				LANDSCAPE PLAN		
	. , ,				LANDSCAPE PLAN	

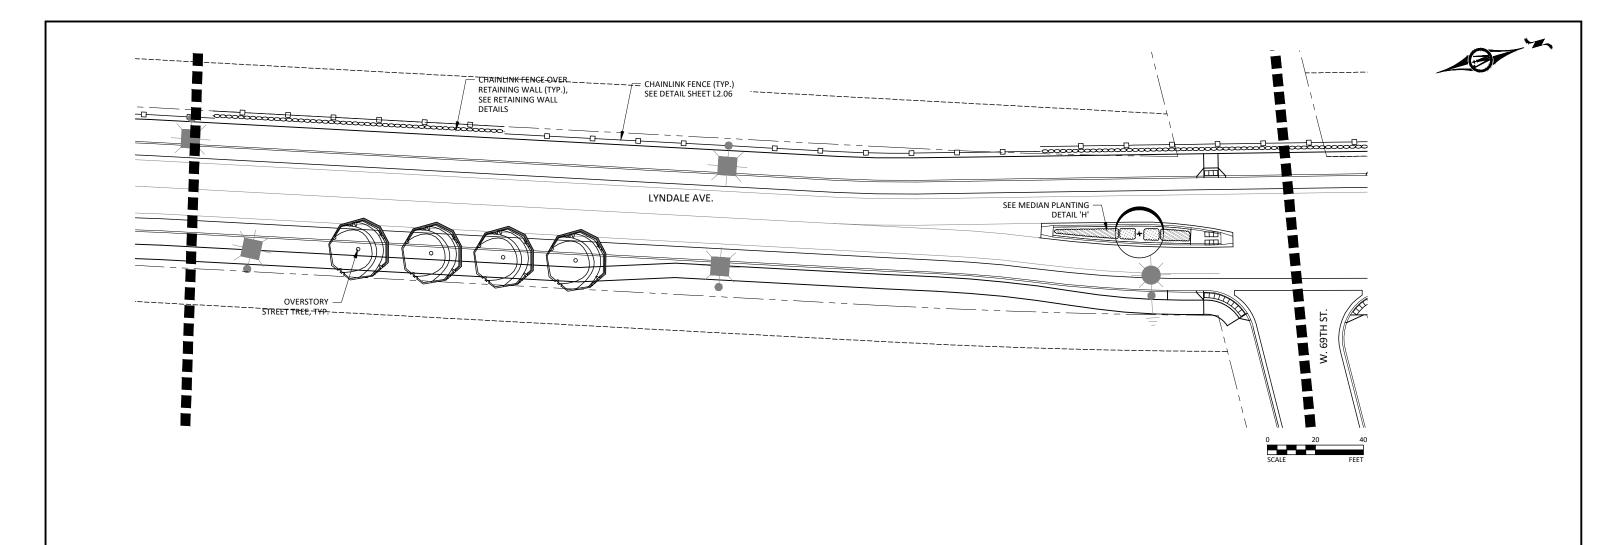

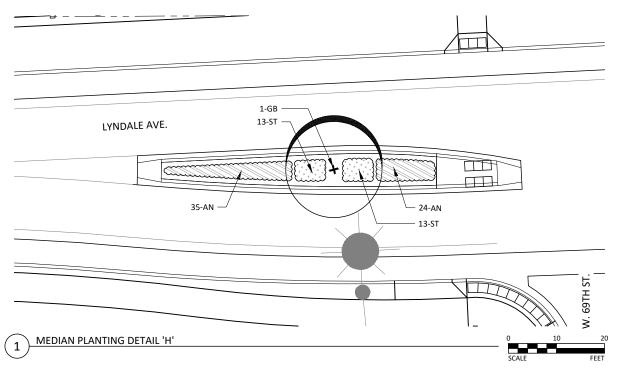

- NOTES:

 1. LOCATION AND VARIETY OF TREE PLANTINGS TO BE VERIFIED IN FIELD BY OWNER'S REPRESENTATIVE PRIOR TO INSTALLATION
 2. CENTER BOULEVARD TREES BETWEEN THE BACK OF CURB AND EDGE OF SIDEWALK
 3. CONTRACTOR TO VERIFY UTILITY LOCATIONS PRIOR TO PLANTING
 4. ALL DISTURBED PERVIOUS AREAS (EXCLUDING PLANTED MEDIANS AND SELECT BOULEVARD AREAS AS SHOWN ON PLANS) SHALL RECEIVE TURF ESTABLISHMENT AS DIRECTED IN SPECIFICATIONS

PLANTED MEDIAN AREA









	Porce
m	The Urban Hometown

DESIGNED	NO.	REVISION	DATE
JDN			
DRAWN			
JDN			
JDN/JCO			
	-		
LIENT PROJ. NO.	-		

CITY OF RICHFIELD, MINNESOTA LYNDALE AVENUE RECONSTRUCTION L1.10 LANDSCAPE PLAN

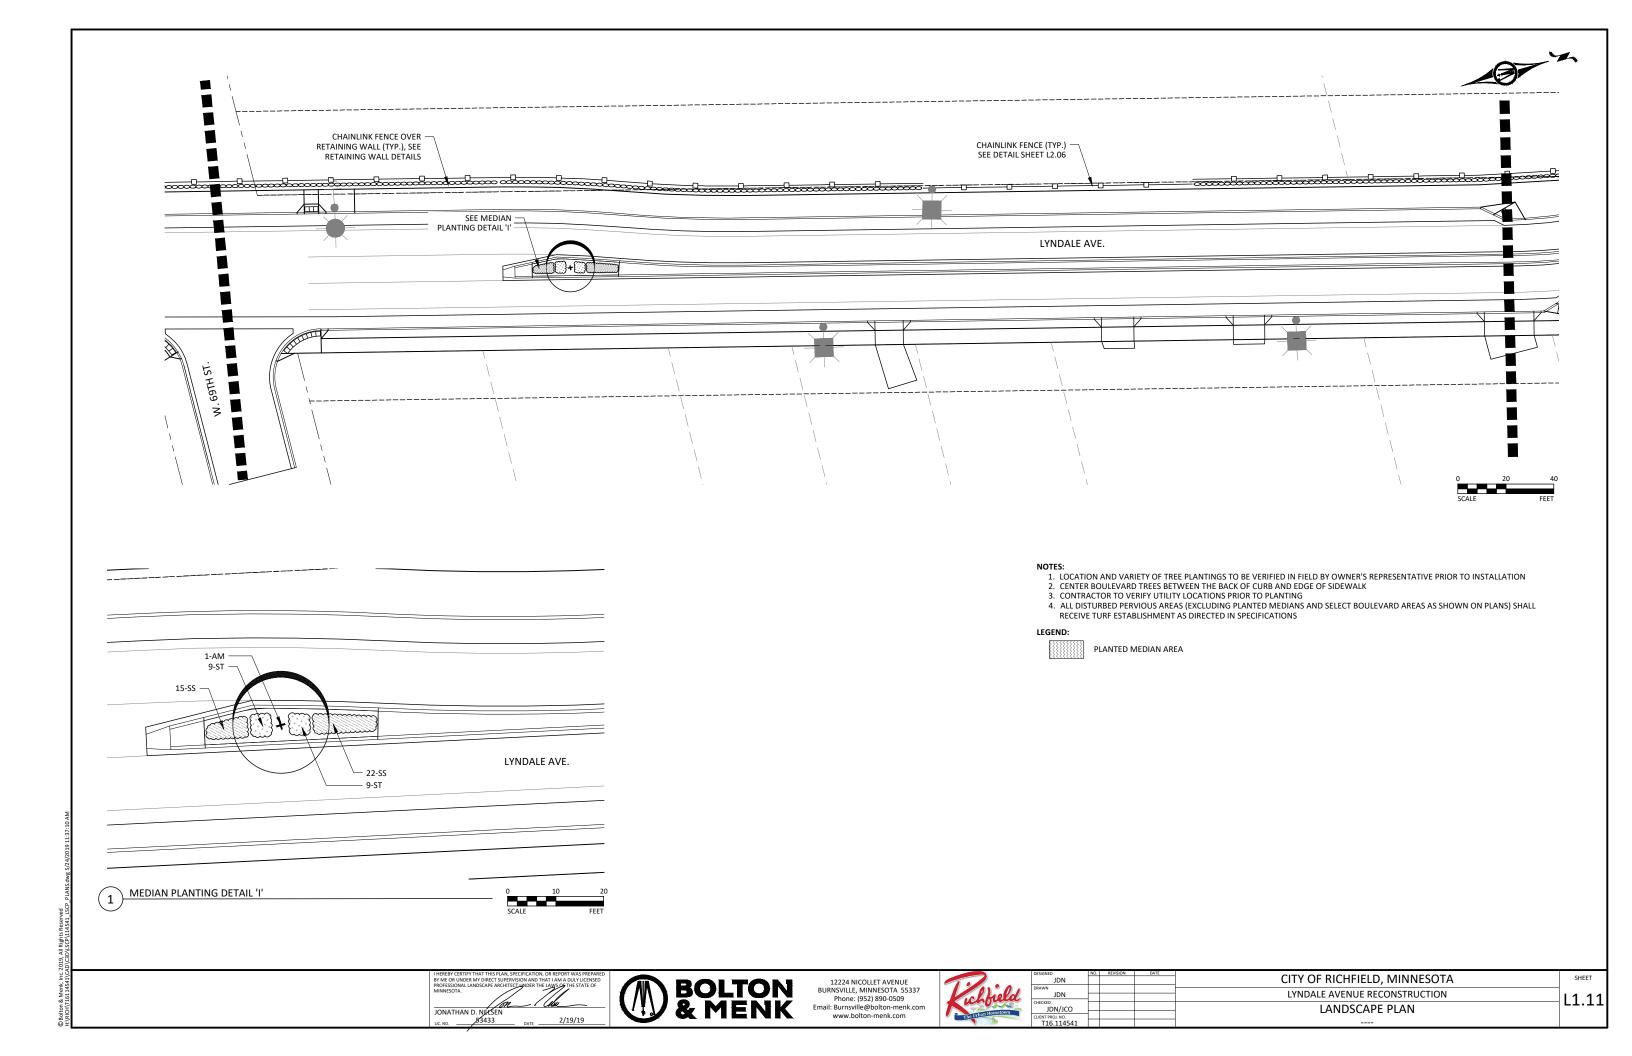

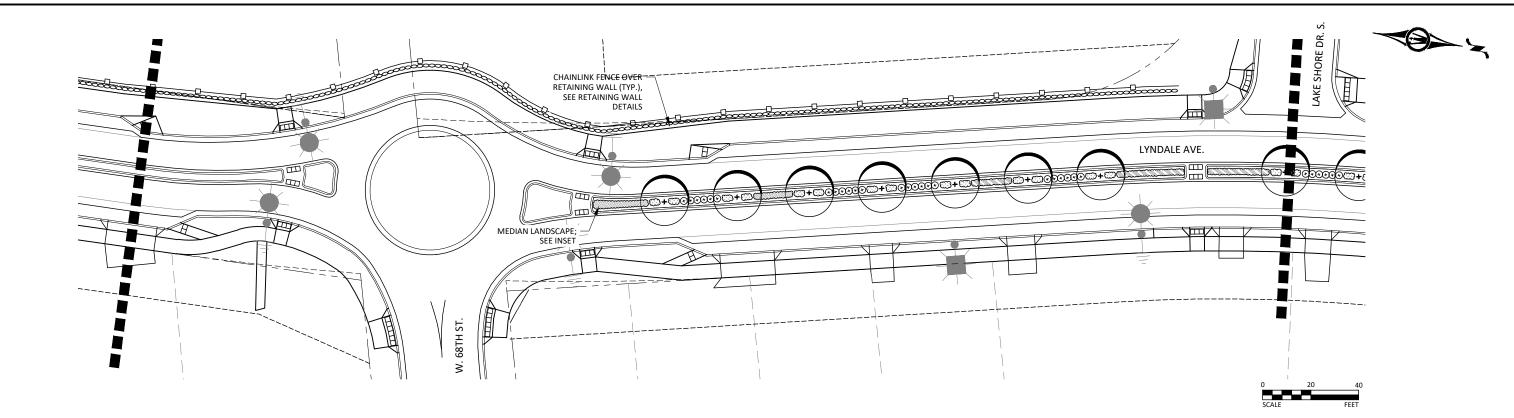

- CONTRACTOR TO VERIFY UTILITY LOCATIONS PRIOR TO PLANTING


 LOCATION AND VARIETY OF TREE PLANTINGS TO BE VERIFIED IN FIELD BY OWNER'S REPRESENTATIVE PRIOR TO INSTALLATION

 CENTER BOULEVARD TREES BETWEEN THE BACK OF CURB AND EDGE OF SIDEWALK

 CONTRACTOR TO VERIFY UTILITY LOCATIONS PRIOR TO PLANTING

- 4. ALL DISTURBED PERVIOUS AREAS (EXCLUDING PLANTED MEDIANS AND SELECT BOULEVARD AREAS AS SHOWN ON PLANS) SHALL RECEIVE TURF ESTABLISHMENT AS DIRECTED IN SPECIFICATIONS



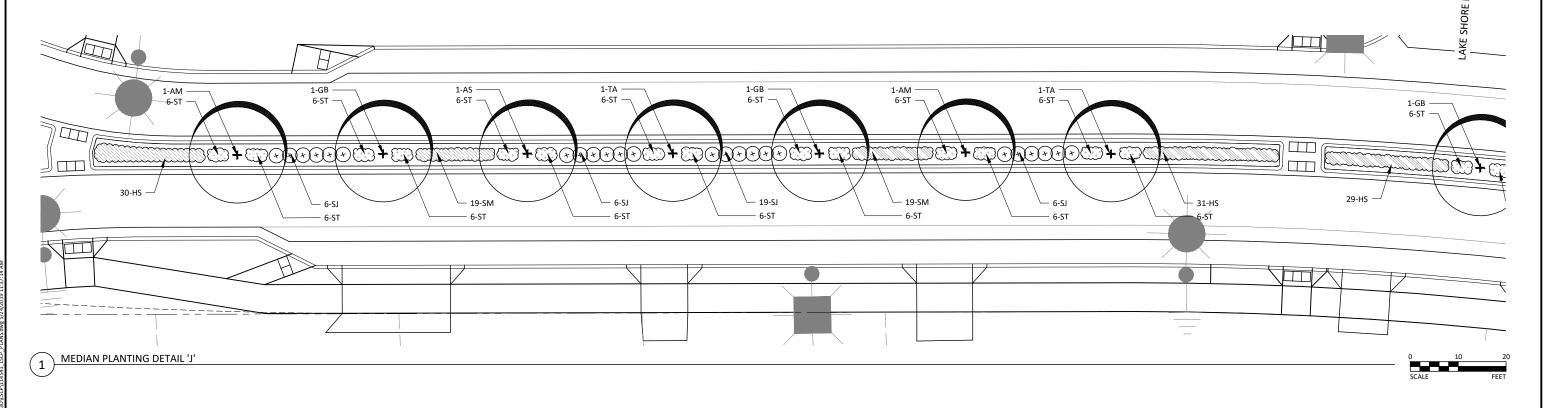





12224 NICOLLET AVENUE BURNSVILLE, MINNESOTA 55337 Phone: (952) 890-0509 Email: Burnsville@bolton-menk.com www.bolton-menk.com

DESIGNED	NU.	REVISION	DATE
JDN			
DRAWN			
JDN			
JDN/JCO			
CLIENT PROJ. NO.	1		
T16 11/5/11			

CITY OF RICHFIELD, MINNESOTA LYNDALE AVENUE RECONSTRUCTION LANDSCAPE PLAN

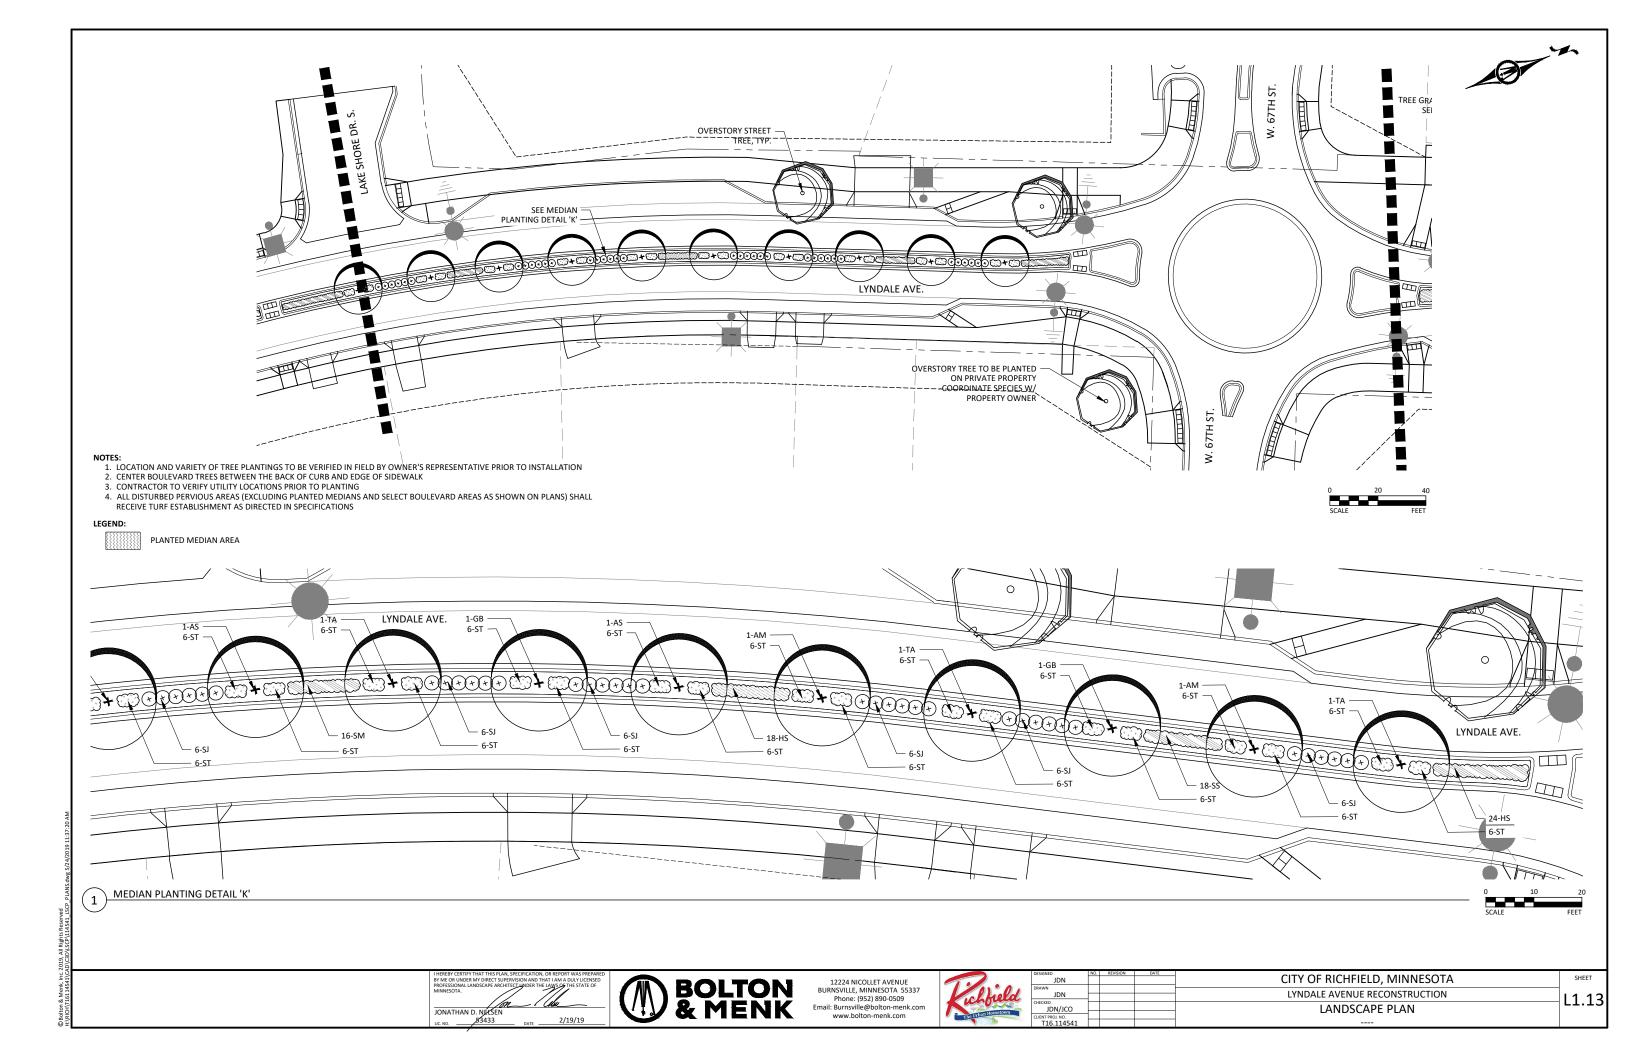

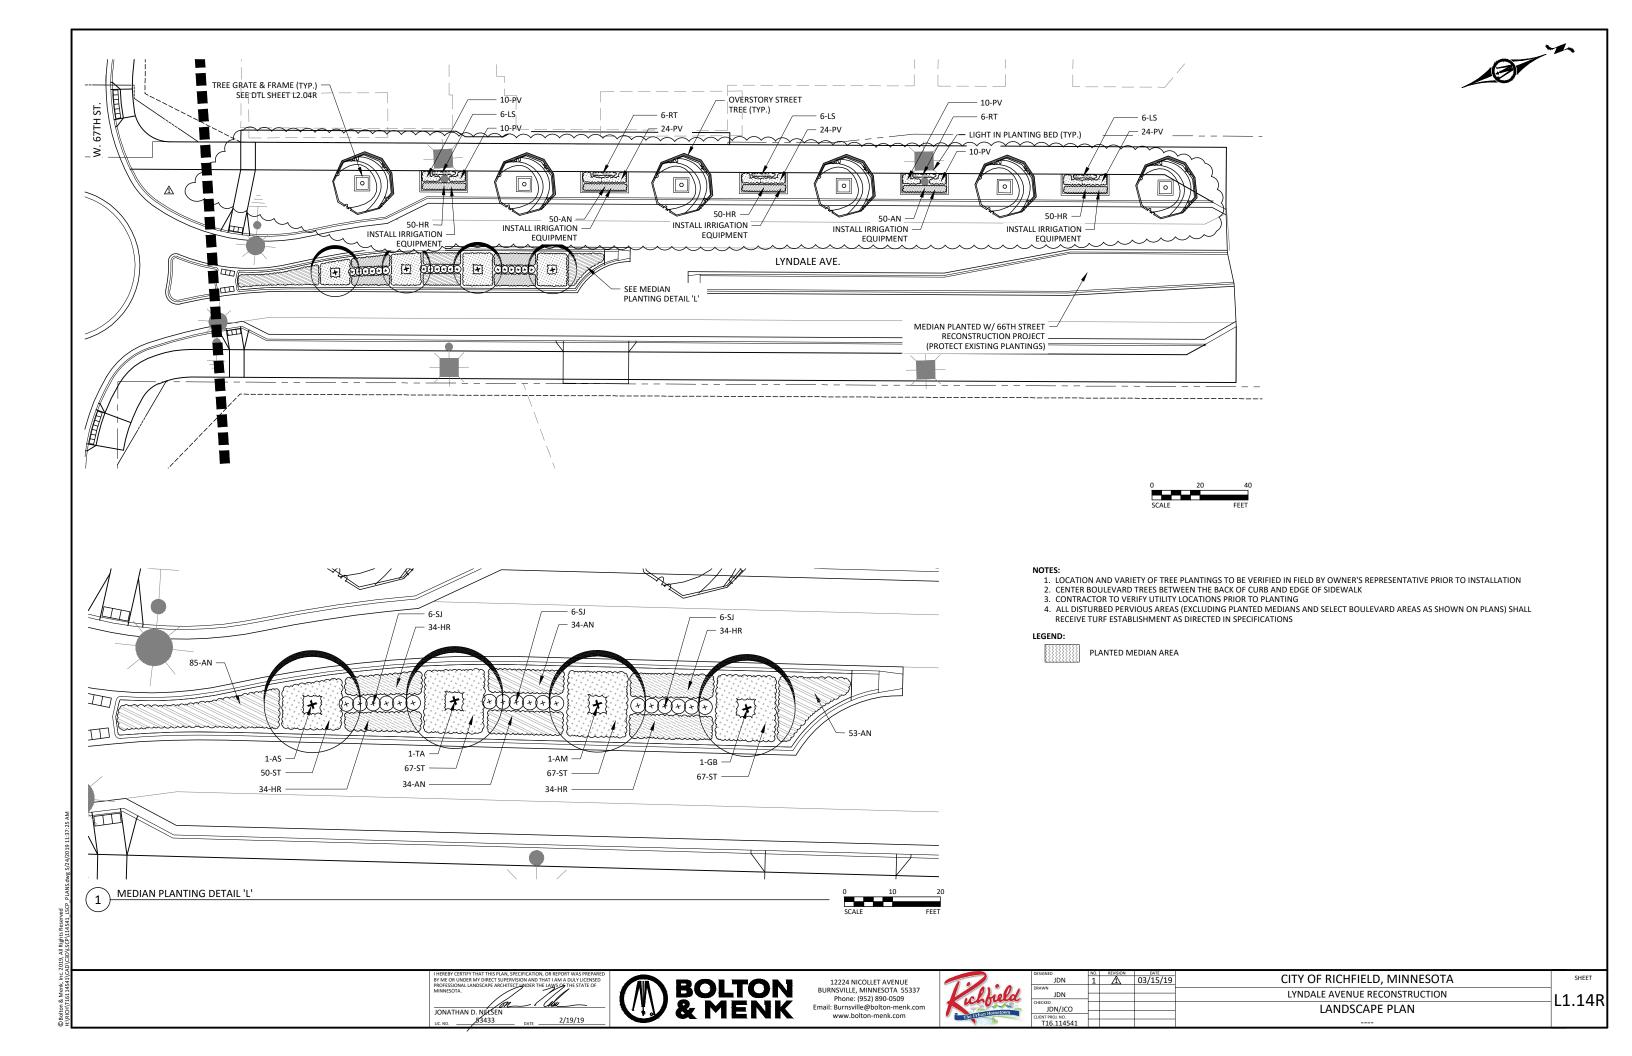

GENERAL NOTES

SEE SPECIAL PROVISIONS FOR SPECIFIC PROJECT REQUIREMENTS.

RODENT

REFER TO MnDOT SPECIFICATIONS 2571, 2572, 3861, FOR GENERAL REQUIREMENTS.

COMPLETE PREPARATORY WORK BEFORE STARTING INITIAL PLANTING OPERATIONS.

ACCEPT ALL PLANT STOCK IN ACCORDANCE WITH (MnDOT 3861) PRIOR TO PLANTING.

THE CONTRACTOR WILL DEMONSTRATE COMPETENCY FOR SOIL CULTIVATION OPERATIONS IN ACCORDANCE WITH (MnDOT 2571.3D.2)

THE CONTRACTOR WILL DEMONSTRATE COMPETENCY FOR ALL PLANT INSTALLATION OPERATIONS IN ACCORDANCE WITH (MnDOT 2571.3F1)


SEE SPECIAL PROVISIONS AND STANDARD PLANTING DETAILS (3 OF

PROTECTION	3)
FERTILIZER	SEE SPECIAL PROVISIONS
COMPOST	MnDOT 3890 COMPOST GRADE 2 UNLESS OTHERWISE SPECIFIED.
MULCH MATERIAL	MnDOT 3882 MULCH MATERIAL TYPE 6 UNLESS OTHERWISE SPECIFIED.
MASS PLANTING BEDS	PREPARE MASS PLANTING BEDS FOR PLANTS PLACED AT 15' OR LESS, UNLESS OTHERWISE SPECIFIED ON SHEETS. PLANT BEDS IN STAGGERED ROWS ON THE PERIMETER FIRST, THEN UNIFORMLY FILL IN WITH REMAINING PLANTS. USE TRIANGULAR SPACING, UNLESS SPECIFIED OTHERWISE. PROVIDE 5' RADIUS CLEAR OF SHRUBS AROUND EACH DECIDUOUS TREE AND 8' CLEAR RADIUS AROUND EACH CONIFER TREE. RADIUS WILL BE MEASURED FROM THE CENTER OF THE TREE TO THE CENTER OF THE SHRUB. NOTIFY ENGINEER OF GROSS PLANT QUANTITY SURPLUS OR DEFICIENCY IMMEDIATELY. MULCH ENTIRE MASS PLANTING BED. SEE STANDARD PLANTING DETAILS (3 OF 3)

PLANTING PLAN	STATED	DIMENSIONS	CLIDEDCEDE	SCALING	EDOM	DLAN
DIMENSIONS	STATED	DIMENSIONS	SUPERCEDE	SCALING	FROIVI	FLAIN.

REQUIREMENTS.

07 2571.3G)	PLANT TYPE	AVERAGE GALLONS OF WATER PER APPLICATION	
	MACHINE TRANSPLANTED TREES	50–100	
	BALLED AND BURLAPPED 20		
(Мпрот	BARE ROOT AND CONTAINER TREES	15	
GUIDELINES	BALLED AND BURLAPPED SHRUBS	10	
	BARE ROOT AND CONTAINER SHRUBS	7	
BOUIL	WOODY SEEDLINGS	4	
WATERING	PERENNIALS AND VINES	3	
	IT IS THE CONTRACTOR'S RESPONSIBILITY TO MONITOR AND MAINTAIN SOIL MOISTURE AT ADEQUATE BUT NOT EXCESSIVE LEVELS. THE AMOUNTS LISTED ABOVE ARE GUIDELINES, NOT		

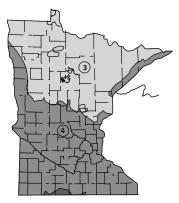

- BARE ROOT PERENNIALS MUST BE PLACED IN THE SPRING NO LATER THAN JUNE 1ST OR FOLLOW THE FALL DECIDUOUS
- ISTITUTE TO LATER THAN JUNE
 IST OR FOLLOW THE FALL DECIDUOUS
 PLANTING DATES.

 2. ACTUAL DATES MAY CHANGE DEPENDING
 UPON SEASONAL CONDITIONS, AS
 DETERMINED BY THE ENGINEER.

 3. FALL PLANTING IS NOT ALLOWED FOR
 BARE ROOT FORM OF THE FOLLOWING
 SPECIES: HAWTHORN, DOGWOOD,
 POPLAR, HACKBERRY, LINDEN, IRONWOOD,
 HONEYLOCUST, BIRCH, MOUNTAIN ASH,
 MAPLE, WILLOW, CRABAPPLE,
 PLUMCHERRY, OAKS, AND SUMAC.

 4. ALL REPLACEMENT PLANTS MUST BE
 PLACED DURING THE MONTH OF MAY
 (SPRING PLANTING) AND SEPTEMBER (FALL
 PLANTING) DURING THE FIRST YEAR OF
 THE PLANT ESTABLISHMENT PERIOD.

THE PLANT ESTABLISHMENT PERIOD.

5. MACHINE MOVED PLANTING DATES WILL
BE SPECIFIED IN THE SPECIAL PROVISIONS.

PL/	AN.	TING DA	ATES BY	ZONE
			3	4
	BARE ROOT CONTAINER B&B		APRIL 21 TO JUNE 1	APRIL 7 TO JUNE 1
G	DECID	CONTAINER B&B	APRIL 21 TO JUNE 30	APRIL 7 TO JUNE 30
SPRING	cc	ONIFEROUS	APRIL 21 TO JUNE 1	APRIL 7 TO MAY 17
S	PE	RENNIALS	MAY 1 TO JUNE 30	MAY 1 TO JUNE 30
	s	EEDLINGS	APRIL 21 TO JUNE 1	APRIL 7 TO JUNE 1
	S BARE ROOT		OCT. 1 TO NOV. 1	OCT. 10 TO NOV. 15
Ⅎ	DECIDUOUS	CONTAINER B&B	AUG. 25 TO OCT. 15	AUG. 25 TO NOV. 1
FALL	cc	NIFEROUS	AUG. 25 TO SEPT. 15	AUG. 25 TO SEPT. 15
	PE	ERENNIALS	AUG. 25 TO SEPT. 15	AUG. 25 TO SEPT. 15

DI ANITINIO DATEC DV

LIVE BRANCH BRANCH BARK RIDGE DEAD BRANCH **BRANCH COLLAR**

BRANCHES PRUNED AT TRUNK

PRUNING	CLOSE	LONG	SLANTED
CUT	A		LIVE BUD

BRANCHES PRUNED TO LIVE BUD

PRUNING

STEPS TO PRUNING WITH PRUNING SAW.

- 1. CUT PART WAY THROUGH THE BRANCH AT POINT A.
- 2. CUT COMPLETELY THROUGH
- BRANCH FROM POINT B TO A. 3. AT BRANCH COLLAR CUT FROM POINT C TO D.


INCORRECT CUT FROM POINT C TO X (TOO CLOSE) WILL RESULT IN DISCONTINUOUS CALLUS FORMATION AFTER ONE SEASON OF GROWTH.

CORRECT CUT FROM POINT C TO D (LEAVING BRANCH COLLAR BUT NOT THE STUB FROM POINT B TO A) WILL RESULT IN CONTINUOUS **DOUGHNUT SHAPED CALLUS** FORMATION AFTER ONE SEASON OF GROWTH.

PRUNING NOTES:

- 1. PRUNE USING CLEAN AND SHARP SCISSOR-TYPE PRUNER OR PRUNING SAW.
- 2. THE BEST TIME TO PRUNE IS LATE DORMANT SEASON OR EARLY SPRING.
- 3. AVOID PRUNING OAKS IN APRIL MAY, JUNE OR JULY.
- 4. IF PRUNING IS NECESSARY OR IF WOUNDS OCCUR TO OAK TREES IN APRIL, MAY, JUNE OR JULY, IMMEDIATELY PAINT CUT SURFACE OR WOUND WITH LATEX PAINT OR SHELLAC.


(MnDOT 2571.3E.1 and 2571.3K.2.a(9))

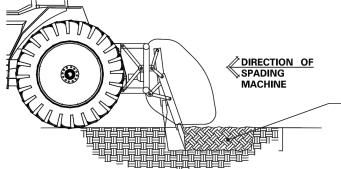

CULTIVATED INPLACE SOIL **DEPTH**

(MnDOT 2571.3D.2)

PRIMARY TILLAGE - PASS 1

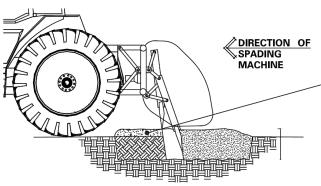


4 INCHES OF GRADE 2 COMPOST AND OTHER SPECIFIED ADDITIVES THOROUGHLY MIXED WITH INPLACE CULTIVATED SOILS

INCORPORATION TILLAGE - PASS 2

PLANTING SOIL

PLANT INSTALLATION PERIOD

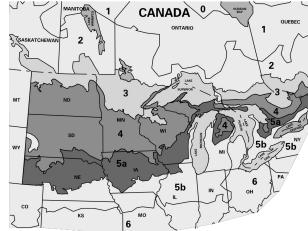

ACCE	PTABLE	ZONES
ZONES	LEGEND	MIN. TEN
3		−34.4° TO −40
4		-28.9° TO -34.4
5a		-26.1°TO -28.9
UNA	CCEPTAB	LE ZONES
	CCEPTAB LEGEND	LE ZONES

FOR ALL PLANT STOCK, DOCUMENT ACCEPTABILITY FOR HARDINESS IN THE MINNESOTA ZONE WHERE THE PROJECT SITE IS LOCATED, AS FOLLOWS:

A. PLANT STOCK CONTINUOUSLY GROWN FOR AT LEAST THE LAST TWO YEARS WITHIN THE ACCEPTABLE LIMITS SHOWN.

B. PLANT STOCK, GROWN OUTSIDE THE ACCEPTABLE GROWING RANGE LIMITS, HAVING SEED SOURCE OR ROOT AND GRAFT STOCK ORIGINATING FROM THE ACCEPTABLE LIMITS SHOWN.

ACCEPTABLE PLANT STOCK GROWING RANGE LIMITS

SOURCE: USDA PLANT HARDINESS ZONE MAP

(MnDOT 3861.2C)

IONATHAN D. NEISEI



12224 NICOLLET AVENUE BURNSVILLE, MINNESOTA 55337 Phone: (952) 890-0509 www.bolton-menk.com

MOVO.
0
1 Hometown


	DESIGNED	NO.	ı
L	JDN		ı
	DRAWN		
	JDN		ŀ
	CHECKED		ŀ
	JDN/JCO		ļ
	CLIENT PROJ. NO.		
	T16.114541		ľ

	NO.	REVISION	DATE	CITY OF DICHEIL D. MAININECOTA
N				CITY OF RICHFIELD, MINNESOTA
N.				LYNDALE AVENUE RECONSTRUCTION
אוע	-			LYNDALE AVENUE RECONSTRUCTION
/JCO				LANDSCAPE DETAILS
7300	-			LANDSCAFE DETAILS


(MnDOT 2571.3D)

HOLE DEPTH FOR B&B AND CONTAINER PLANTS SHALL NOT EXCEED MEASUREMENT FROM ROOT FLAIR TO BOTTOM OF SOIL BALL. PLANT SIZE UP TO (A) MINIMUM HOLE (B) APPROXIMATE AND INCLUDING WIDTH HOLE DEPTH 5' B.R. 7' B.R 0.75" B.R 1.25" B.R. 1.5 B.R. 1.75" B.R **DECIDUOUS &** 4' B.B. ORNAMENTAL TREES 5′ B.B. 6' B.B. 8' B.B. 1.25" B.B 1.75" B.B. 2.5" B.B. 3.5" B.B 12" B.R. **DECIDUOUS** 18" B.R. SHRUBS, ROSES AND PERENNIALS 3' B.R. 4' B.B. 5' B.R PERENNIAL HOLE DEPTH AND WIDTH SHALL BE BASED UPON ON-CENTER SPACING IN A 18" B.B. 2' B.B. 3' B.B. 4' B.B.

PLANTING HOLE DIMENSIONS

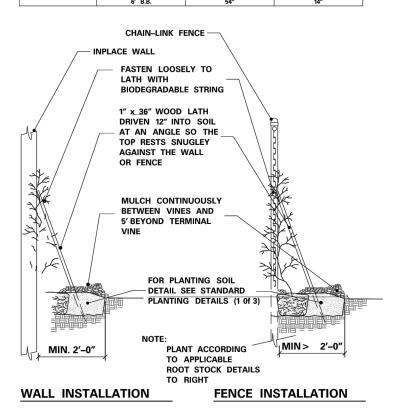


INSTALLATION OF VINES

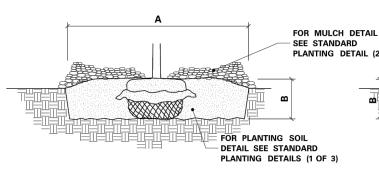

- 1. SCARIFY SIDES AND BOTTOM OF HOLE.
- PROCEED WITH CORRECTIVE PRUNING.
- 3. SET PLANT ON UNDISTURBED NATIVE SOIL OR THOROUGHLY COMPACTED PLANTING SOIL. PLACE PLANT SO THE ROOT FLARE IS AT OR UP TO 2" ABOVE THE FINISHED GRADE WITH BURLAP AND WIRE BASKET, (IF USED), INTACT.
- 4. SLIT REMAINING TREATED BURLAP AT 6" INTERVALS.
- 5. BACKFILL TO WITHIN APPROXIMATELY 12" OF THE TOP OF THE ROOTBALL, THEN WATER PLANT.
- 6. REMOVE THE TOP 1/3 OF THE BASKET OR THE TOP TWO HORIZONTAL RINGS WHICHEVER IS GREATER. REMOVE ALL BURLAP AND NAILS FROM THE TOP 1/3 OF THE BALL. REMOVE ALL TWINE. REMOVE OR CORRECT STEM GIRDLING
- 7. PLUMB AND BACKFILL WITH PLANTING SOIL.
- 8. WATER THOROUGHLY WITHIN 2 HOURS TO SETTLE PLANTS AND FILL VOIDS
- BACK FILL VOIDS AND WATER A SECOND TIME.
- 10. PLACE MULCH WITHIN 48 HOURS OF THE SECOND WATERING UNLESS SOIL MOISTURE IS EXCESSIVE.


BALLED & BURLAPPED STOCK

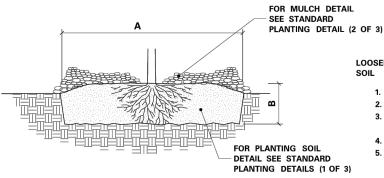

- 1. SOAK ROOTS IN WATER FOR AT LEAST ONE HOUR BUT NOT MORE THAN 24 HOURS PRIOR TO PLANTING.
- 2. SCARIFY SIDES AND BOTTOM OF HOLE.
- 3. PROCEED WITH CORRECTIVE PRUNING OF THE TOP AND
- 4. TRANSFER PLANT DIRECTLY FROM WATER TO HOLE. SET PLANT SO THE ROOT FLARE IS AT THE FINISHED SOIL FLEVATION. SPREAD BOOTS OUT EVENLY. PLUMB AND IMMEDIATELY BACKFILL WITH PLANTING SOIL
- 5. WATER THOROUGHLY WITHIN 2 HOURS TO SETTLE PLANTS AND FILL VOIDS.
- 6. BACK FILL VOIDS AND WATER A SECOND TIME.
- 7. PLACE MULCH WITHIN 48 HOURS OF THE SECOND WATERING UNLESS SOIL MOISTURE IS EXCESSIVE.


BARE ROOT STOCK

INSTALLATION OF PLANTS

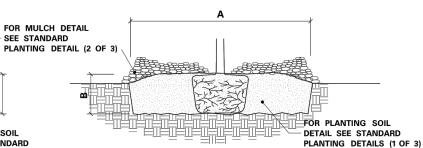

- 1. SCARIFY SIDES AND BOTTOM OF HOLE.
- 2. PROCEED WITH CORRECTIVE PRUNING OF TOP AND ROOT.
- 3. REMOVE CONTAINER AND SCORE OUTSIDE OF SOIL MASS TO REDIRECT AND PREVENT CIRCLING FIBROUS ROOTS. REMOVE OR CORRECT STEM GIRDLING ROOTS.
- 4. SET PLANT ON UNDISTURBED NATIVE SOIL OR THOROUGHLY COMPACTED PLANTING SOIL. INSTALL PLANT SO THE TOP OF THE ROOT FLARE IS AT OR UP TO 2" ABOVE THE FINISHED GRADE.
- 5. PLUMB AND BACKFILL WITH PLANTING SOIL.
- 6. WATER THOROUGHLY WITHIN 2 HOURS TO SETTLE PLANT AND FILL VOIDS.
- 7. BACK FILL VOIDS AND WATER A SECOND TIME.
- 8. PLACE MULCH WITHIN 48 HOURS OF THE SECOND WATERING UNLESS SOIL MOISTURE IS EXCESSIVE.

CONTAINER STOCK

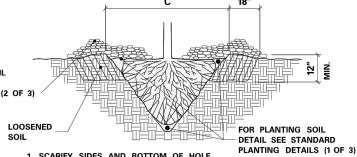

- 1. SCARIFY SIDES AND BOTTOM OF HOLE.
- 2. PROCEED WITH CORRECTIVE PRUNING.
- 3. SET PLANT ON NATIVE SOIL AT SAME DEPTH AS IT WAS PREVIOUSLY GROWN
- 4. PLUMB AND BACKFILL WITH PLANTING SOIL.
- 5. AFTER PLANTING, LOOSEN THE SOIL IMMEDIATELY ADJACENT TO THE ROOT BALL TO A MINIMUM DISTANCE OF 18" AND A MINIMUM DEPTH OF 12".
- 6. WATER THOROUGHLY WITHIN 2 HOURS TO SETTLE PLANT AND FILL VOIDS.
- 7. BACK FILL VOIDS AND WATER A SECOND TIME.
- 8. PLACE MULCH WITHIN 48 HOURS OF THE SECOND WATERING UNLESS SOIL MOISTURE IS EXCESSIVE.

MINIMUM	TREE SPADE	SIZE REQU	IREMENTS
(C) SPADE DIAMETER SIZE	OAK TREE, CALIPER	DECIDUOUS / ORNAMENTAL TREE,CALIPER	CONIFEROUS TREE, HEIGHT
42"	1" to 1.5"	2" to 3"	5' to 7'
60"	1.5" to 2.5"	3" to 4"	7' to 9'
78″	2.5" to 3.5"	4" to 6"	9' to 14'
85"	3.5" to 5"	6" to 8"	14' to 18'

MACHINE MOVED STOCK

(MnDOT 2571.3F)

HOLE DEPTH FOR B&B AND CONTAINER PLANTS SHALL NOT EXCEED MEASUREMENT FROM ROOT FLAIR TO BOTTOM OF SOIL BALL. PLANT SIZE UP TO (A) MINIMUM HOLE (B) APPROXIMATE AND INCLUDING WIDTH HOLE DEPTH 6' B.B CONIFER BRANCHES WILL CONTAIN TERMINAL BUDS 8' B.B CONIFEROUS SHRUBS CONIFEROUS 18" SPR B.B. SHRURS 2' SPR B.B. CELLPACKS / PLUGS 2.25" CONT 3.5" CONT. 4.5" CON 6"/1 QT CONT CONTAINER 2# CON **GROWN PLANTS** 15# CON 20# CONT 25# CON 6" SEEDLING

12" SEEDLING

18" SEEDLING

2' SEEDLING

1 YR. MED B.R.

1 YR. NO. 1 B.R. 2 YR. MED. B.R.

2 YR. NO. 1 B.F

PLANTING HOLE DIMENSIONS

		MULCH ARE	A CALCULATOR
		TYPE OF PLANT	SQ. FT. PER PLANT
		CONIFEROUS TREES	$\left[\left(\frac{3/5 \times \text{HEIGHT}}{2}\right) + 3\right]^2 X \uparrow \uparrow$
		DECIDUOUS AND ORNAMENTAL TREES	3 ² x ↑ ↑
1		CONIFEROUS AND DECIDUOUS SHRUBS, ROSE BUSHS, PERENNIALS, ORNAMENTAL GRASS	SPACING x SPACING
		VINES	SPACING x 2
		MACHINE-MOVED TREES OR SHRUBS	$\left[\left(\frac{\text{SPADE DIAMETER}}{2}\right) + 1\right]^2 X \uparrow \uparrow$
∏ HEIGHT	CONIFEROUS TREE (R. DECIDUOUS TREE (3 CONIFEROUS AND DECIDUOUS SHRUB TRANSPLANT (RADIU	(3'min.) (3'min.) (S+2' min.)	T = 3.1416 PULL MULCH BACK NO LESS THAN 3" AND NO MORE THAN 6" FROM TREES AND SHRUBS AT THE TRUNK OR MAIN STEM. SUBSIDING OR DETERIORATING MULCH IS ACCEPTABLE THROUGHOUT THE ESTABLISHED PERIOD IF THE MULCH DEPTH IS MAINTAINED AT A MINIMUM 3" DEPTH. ADD MULCH WHEN BELOW THE 3" MINIMUM DEPTH; DO NOT EXCEED THE 6" MAXIMUM DEPTH. MULCH CONTAMINATED WITH SOIL MUST BE REMOVED AND REPLACED.
М	III CH		

MULCH

(MnDOT 2571.3H)



BURNSVILLE, MINNESOTA 55337 Phone: (952) 890-0509 www.bolton-menk.com



DESIGNED	N
JDN	
DRAWN	Г
JDN	Т
CHECKED	Н
JDN/JCO	L
CLIENT PROJ. NO.	


CITY OF RICHFIELD. MINNESOTA LYNDALE AVENUE RECONSTRUCTION LANDSCAPE DETAILS

SEEDLINGS

- 1. EXCAVATE HOLE OR BED TO ALLOW PLACING THE TOP OF ROOT MASS 1"-3" HIGHER THAN FINISHED GRADE.
- 2. AUGER 8" DIAMETER HOLES ENTIRELY THROUGH IMPERVIOUS OR POORLY DRAINED HARD PAN SOIL LAYER TO ADEQUATELY DRAIN SUBSOIL.


 3. TEST FOR POSITIVE DRAINAGE. RE-AUGER AN ADDITIONAL 8" IF NECESSARY FOR POSITIVE
- 4. THOROUGHLY BACKFILL AUGER HOLES WITH A UNIFORM INCORPORATED MIXTURE OF 50% SAND AND 50% INPLACE SOIL.
- 5. COMPLETE PLANTING ACCORDING TO ROOT TYPE. SEE STANDARD PLANTING DETAILS (2 OF 3).

GRANULAR FILTER

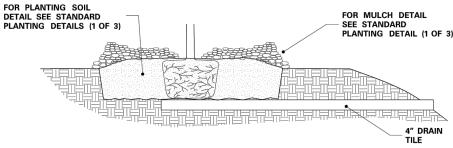

- 1. EXCAVATE HOLE OR BED TO ALLOW PLACING THE TOP OF THE ROOT MASS 1"-3" HIGHER THAN FINISHED GRADE.
- 2. INSTALL 4" MINIMUM DIAMETER DRAIN TILE DAYLIGHTING AT A LOWER GRADE.
- 3. COMPLETE PLANTING ACCORDING TO ROOT TYPE. SEE STANDARD PLANTING DETAILS (2 OF 3).

TILE DRAINAGE

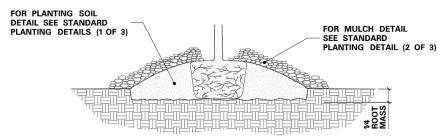

- 1. EXCAVATE HOLE OR BED 1/4 THE DEPTH OF THE ROOT MASS
- 2. SET ROOT MASS IN HOLE.
- 3. CONSTRUCT BERM WITH PLANTING SOIL. EXTEND THE BERM BASE TO A WIDTH OF 3 TIMES
- 4. COMPLETE PLANTING ACCORDING ROOT TYPE. SEE STANDARD PLANTING DETAILS (2 OF 3).

MINI-BERM


1. THE NEED FOR USING PLANTING DETAILS FOR POORLY DRAINED SOILS AND WHICH TYPE TO USE ARE DETERMINED BY THE CONTRACTOR, SUBJECT TO ENGINEER APPROVAL.

PLANTING DETAIL FOR POORLY DRAINED SOILS

(MnDOT 2571.3D.2(8))

EXISTING GRADE FOR MULCH DETAIL SEE STANDARD CUT AREA **UPHILL HALF** PLANTING DETAIL (2 OF 3) WATER BASIN SOIL RIDGE TO HOLD WATER IN BASIN. DOWN HILL HALF WATER BASIN PLANT ACCORDING TO ROOT TYPE. SEE STANDARD PLANTING DETAILS (2 OF 3) 1. ON 1:2 SLOPES OR GREATER, DO NOT CONSTRUCT THE UPHILL HALF OF THE WATERING BASIN. FOR PLANTING SOIL **DETAIL SEE STANDARD** PLANTING DETAILS (1 OF 3)

PLANTING ON SLOPES

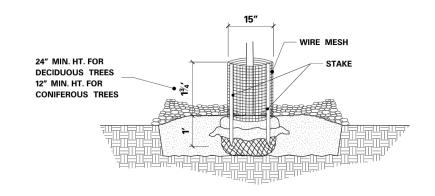

- 1. FORM A DOUBLE-LAYERED CYLINDER USING 0.25" GRID GALVANIZED WELDED WIRE MESH (HARDWARE
- 2. DRIVE TWO 1" x 1" OPPOSING HEARTWOOD WHITE OAK STAKES INTO THE GROUND, 7" FROM THE CENTER OF THE TREE STEM.
- 3. SECURE THE MESH CYLINDER TO THE OUTSIDE OF THE STAKES USING EITHER, SCREWS AND WASHERS OR CABLE-TIES ALONG THE OVERLAP. SPACE APPROXIMATELY 4" ON CENTER ALONG THE OVERLAP. a. SCREWS SHALL BE ROUND HEAD GALVANIZED 18" DIA. x 3/4" LONG WITH WASHERS.
- b. CABLE-TIES SHALL BE NYLON, AT LEAST 8" LONG AND BETWEEN 75LB TO 120LB TENSILE
- 4. EMBED THE LOWER EDGE OF THE MESH CYLINDER 1" BELOW THE SOIL SURFACE WITHOUT DISTURBING THE TREE ROOTS.
- 5. CUT EDGES WILL NOT BE PERMITTED AT THE TOP OF THE CYLINDER. STAKE WILL BE FLUSH WITH THE TOP OF THE CYLINDER.
- 6. MULCH WITHIN THE CYLINDER SHALL NOT EXCEED 3" DEPTH AND SHALL BE PULLED BACK FROM THE TRUNK AS SPECIFIED IN MULCH PLACEMENT DETAIL.

 7. THE BOTTOM WHORL OF PINE AND LARCH BRANCHES MAY HAVE TO BE REMOVED TO PERMIT
- 8. INSTALL ON ALL DECIDUOUS, PINE AND LARCH TREES, DO NOT PLACE ON SPRUCE TREES.

RODENT PROTECTION

USE SEAMLESS, EXTRUDED, TWIN-WALL, RIGID AND SEMI TRANSLUCENT POLYPROPYLENE TUBES WITH A LASER LINE PERFORATION AND AN OUTWARD-FLARED TOP RIM.

SECURE SHELTER WITH NYLON CABLE-TIES ATTACHED TO A 1' x 1" WHITE OAK STAKE TO PREVENT DISLODGING OR

EMBED THE BOTTOM OF THE TUBE A MINIMUM OF 1" BELOW THE SOIL SURFACE WITHOUT DISTURBING THE TREE ROOTS.

PLACE A PLASTIC PHOTODEGRADABLE NETTING COVER AND SLEEVE OVER THE NETTING DOWN AS SHOWN

PREVAILING WIND **NETTING** LASER LINE PERFORATION TUBE SHELTER STAKE (LENGTH VARIES) CABLE-TIE TO SECURE STAKE IN RECESS


SEEDLING TREE SHELTER

(MnDOT 2571.3I.4)

(MnDOT 2571.31.2)

HOLE EXCAVATION WIDTH IN ACCORDANCE WITH MINIMUMS FROM THE PLANTING HOLE DIMENSIONS CHART ON STANDARD PLANTING DETAILS (2 OF 3) FOR MULCH DETAIL FOR PLANTING SOIL SEE STANDARD DETAIL SEE STANDARD PLANTING DETAIL PLANTING DETAILS (1 OF 3) (2 OF 3) 5' FOR DECIDUOUS TREES 8' FOR CONIFEROUS TREES

PLANT SPACING IN MASS BEDS

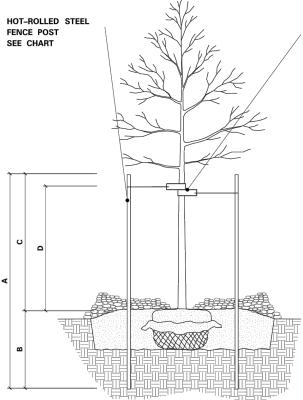

16" LONG POLYROPYLENE OR POLYETHYLENE, 40 MIL THICK AND 1.5" WIDE STRAPS. ATTACH WITH 10 ga WIRE.

- 1. STEEL POSTS TO BE NOTCHED OR DRILLED TO RETAIN GUY WIRES. PLACE OUTSIDE OF ROOT BALL. DRIVE PLUMB REGARDLESS OF GROUND SLOPE
- 2. REQUESTS TO SUBSTITUTE RUBBER HOSE AND WIRE **GUYING SYSTEMS WILL NOT** BE APPROVED.
- 3. TREE STAKING IS NOT REQUIRED UNLESS SPECIFIED OR NECESSARY TO MAINTAIN TREES IN A PLUMB CONDITION WHERE VANDALISM, SOIL, OR WIND CONDITIONS ARE A PROBLEM, OR AS DIRECTED BY THE ENGINEER.
- 4. REMOVE WITHIN ONE YEAR.

STEEL POST SIZING						
CALIPER	STEEL POST TYPE	Α	В	С	D	
LESS THAN 4 INCHES	HOT-ROLLED STEEL FENCE POST (Mi/DOT 3403) OR APPROVED EQUAL.	7′-0″	3'-0" MIN.	4′-0″	3′-0″	
GREATER THAN 4 INCHES	10', 2.2 LB. FLANGED CHANNEL SIGN POST (Mn/DOT 3401) OR APPROVED EQUAL.	10′–0″	4'-0" MIN.	6′-0″	5′–0″	

STAKING AND GUYING

(MnDOT 2571.3I.1)

JONATHAN D. NEKSFI



BURNSVILLE, MINNESOTA 55337 Phone: (952) 890-0509 mail: Burnsville@bolton-menk.com www.bolton-menk.com




DESIGNED			
JDN			
DRAWN			
JDN			
CHECKED			
JDN/JCO			
CLIENT PROJ. NO.			

CITY OF RICHFIELD. MINNESOTA LYNDALE AVENUE RECONSTRUCTION LANDSCAPE DETAILS

MASTER PLANT SCHEDULE								
QTY.	SYM.	SCIENTIFIC NAME	COMMON NAME	SIZE	HABIT/FORM	SPREAD	HEIGHT	NOTES
		DECIDUOUS MEDIAN TREES						
9	AM	ACER MIYABE 'MORTON'	STATE STREET MAPLE	2.5" CAL. B&B	UPRIGHT/OVAL	15'-20'	40'	YELLOW FALL COLOR
8	AS	ACER SACCHARUM 'BARRETT COLE'	APOLLO SUGAR MAPLE	2.5" CAL. B&B	UPRIGHT/OVAL	10'-15'	25'	ORANGE FALL COLOR
11	GB	GINKGO BILOBA 'PRINCETON SENTRY'	PRINCETON SENTRY GINKGO	2.5" CAL. B&B	UPRIGHT/OVAL	15'-20'	60'	YELLOW FALL COLOR
10	TA	TILIA AMERICANA 'MCKSENTRY'	AMERICAN SENTRY LINDEN	2.5" CAL. B&B	UPRIGHT/OVAL	15'-20'	40'	YELLOW FALL COLOR
		DECIDUOUS BOULEVARD TREES						
17	AF	ACER X FREEMANII 'AF #1'	FIREFALL MAPLE*	2.5" CAL. B&B	UPRIGHT/OVAL	25'-35'	45'	ORANGE/RED FALL COLOR
18	со	CELTIS OCCIDENTALIS	COMMON HACKBERRY	2.5" CAL. B&B	BROAD/UPRIGHT	40'-50'	50'	YELLOW FALL COLOR
18	GD	GYMNOCLADUS DIOICUS	ESPRESSO KENTUCKY COFFEETREE	2.5" CAL. B&B	BROAD/UPRIGHT	40'-50'	50'	GREEN FALL COLOR
17	GT	GLEDITISIA TRIACANTHOS VAR. INERMIS 'SKYCOLE'	SKYLINE HONEYLOCUST*	2.5" CAL. B&B	BROAD/UPRIGHT	30'-35'	45'	GOLD FALL COLOR
17	GT	GLEDITISIA TRIACANTHOS VAR. INERMIS 'SUNCOLE'	SUNBURST HONEYLOCUST*	2.5" CAL. B&B	BROAD/UPRIGHT	30'-35'	40'	YELLOW FALL COLOR
18	QB	QUERCUS BICOLOR	SWAMP WHITE OAK	2.5" CAL. B&B	BROAD/UPRIGHT			ORANGE FALL COLOR
18	QR	QUERCUS RUBRA	RED OAK*	2.5" CAL. B&B	BROAD/UPRIGHT	40'-50'	70'	RED FALL COLOR
17	TF	TILIA X FLAVESCENS 'GLENLEVEN'	GLENLEVEN LINDEN*	2.5" CAL. B&B	BROAD/UPRIGHT	25'-35'	60'	YELLOW FALL COLOR
		ORNAMENTAL TREES						
		AMELANCHIER X GRANDIFOLORA 'AUTUMN			UPRIGHT/ROUND			
2	AG	BRILLIANCE'	AUTUMN BRILLIANCE SERVICEBERRY	2.5" CAL. B&B	ED	15'	20'	WHITE FLOWERS IN SPRING
		EVERGREEN TREES		-1				
3	PG	PICEA GLAUCA VAR. DENSATA	BLACK HILLS SPRUCE	6' HT. B&B	-	15'	30'	
2	PS	PS PINUS STROBUS WHITE PINE 6' HT. B&B -		-	30'	60'		
		CHANGE						
44	- nc	SHRUBS	CHICAGOLAND CREEN DOWNOOD	#F CONT		21	21	EVENCEEN
14	BG	BUXUS 'GLENCOE'	CHICAGOLAND GREEN BOXWOOD	#5 CONT.	-	3' 5'	3'	EVERGREEN
3	DL	DIERVILLA LONICERA	DWARF BUSH HONEYSUCKLE	#5 CONT.	-		3'-4'	RED FALL COLOR
44	RA	RHUS AROMATICA 'GRO-LOW' GRO-LOW FRAGRANT SUM SEVEN SA A ROCKES A SUM SECONDO SECONDO SECONDO SECONDO SECONDO SECONDO SECONDO SECONDO SECONDO SECONDO SECONDO SECONDO SECONDO SECONDO SECONDO SECONDO SECONDO SECONDO SEC		#5 CONT.	-	4'	2'-3'	ORANGE FALL COLOR
117	SJ	SPIRAEA JAPONICA 'LITTLE PRINCESS' LITTLE PRINCESS SPIREA		#5 CONT.	-	3'	2'	BRONZE FALL COLOR
11	SP	SYRINGA PATULA 'MISS KIM'	MISS KIM LILAC	#5 CONT.	-	6'	6'	PINK FLOWERS (MANY)
12	SV	SYRINGA VULGARIS 'ALBA'	COMMON WHITE LILAC	#5 CONT.	-	6'-8'	8'-10'	WHITE FLOWERS (MAY)
		PERENNIALS					4.50	PURPLE FLOWER (FALL)
449	AN	ASTER NOVAE-ANGLIAEA 'PURPLE DOME'	PURPLE DOME ASTER	#1 CONT.	-	2'	15"	<u> </u>
286	HR	HEMEROCALLIS 'RUBY STELLA'	RUBY STELLA DAYLILY*	#1 CONT.	-	18"	24"	RED FLOWER (SUMMER)
470	HS	HEMEROCALLIS 'STELLA DE ORO'	STELLA DE ORO DAYLILY	#1 CONT.	-	18"	12"	YELLOW FLOWER (SUMMER/FALL)
18	LS			#1 CONT.	-	24"	2'-4'	PURPLE FLOWER (SUMMER)
12		RT RUDBECKIA TRILOBA BROWN EYED SUSAN #1 CONT 2'			2'-3'	YELLOW FLOWER		
394	SM	SALVIA 'MAY NIGHT'	MAY NIGHT SALVIA	#1 CONT.	-	18"	18"	PURPLE FLOWER (SPRING/SUMMER)
263	SS	S SEDUM SPECTABILE 'AUTUMN FIRE' AUTUMN FIRE SEDUM		#1 CONT.	-	18"	30"	PINK FLOWER (FALL)
		ORNAMENTAL GRASSES						
102	PV	PANICUM VIRGATUM 'SHENANDOAH'	SHENANDOAH SWITCHGRASS	#1 CONT.	-	36"	3'-4'	YELLOW/ORANGE FALL COLOR
1185	ST	SPOROBOLUS HETEROLEPIS 'TARA'	TARA PRAIRIE DROPSEED	#1 CONT.	-	18"	12"	

PLANT MATERIAL NOTES

- MASTER PLANT SCHEDULE: ALL TREES, SHRUBS AND PERENNIALS ARE LISTED IN THE MASTER PLANT SCHEDULE. IF THERE IS A CONFLICT BETWEEN THE QUANTITIES SHOWN ON THE DRAWING AND THE QUANTITIES SHOWN IN THE PLANT SCHEDULE, THE PLAN QUANTITIES SHALL PREVAIL.
- 2. ALL TREE LOCATIONS AND SPECIES TO BE STAKED IN THE FIELD BY OWNER'S REPRESENTATIVE PRIOR TO
- 3. PLANTING LAYOUT: CONTRACTOR TO STAKE A TYPICAL SHRUB AND PERENNIAL BED LAYOUT, AND OBTAIN APPROVAL OF THE LANDSCAPE ARCHITECT PRIOR TO PLANTING.
- 4. SHRUB AND PERENNIAL GROUPINGS SHALL BE PLANTED AND MULCHED IN ONE CONTINUOUSLY MULCHED BED, TREES SHALL BE MULCHED TO 18 INCHES FROM TRUNK IN ALL DIRECTIONS.
- CONTRACTOR TO PRESERVE AND PROTECT EXISTING PLANT MATERIAL OTHER THAN THOSE INDICATED FOR REMOVAL ON REMOVAL PLANS. PLANT MATERIAL THAT IS DAMAGED SHALL BE REPLACED AT CONTRACTOR'S

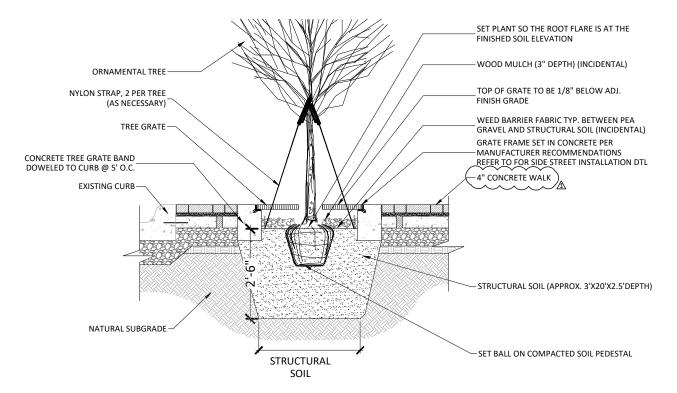


TREE GRATE PLANTING NOTES:


- 1. TREE GRATE NEENAH METROPOLITAN COLLECTION R-8707 TREE GRATE AND FRAME OR APPROVED (5'X5') EQUAL
- 2. CAST IRON / NATURAL FINISH
- NO OPENINGS GREATER THAN 1/4"
 REFER TO MANUFACTURERS SPECIFICATIONS FOR INSTALLATION DETAILS CONTRACTOR TO USE CONCRETE IMBEDDED "L" FRAME ON ALL SIDES OF GRATE
- ADJACENT TO CONCRETE. SECURE PER MANUFACTURER RECOMMENDATIONS
- 6. EACH NEW TREE PIT SHALL CONTAIN APPROXIMATELY 9.5 CY OF STRUCTURAL SOIL (10'x10'x2.5' DEEP)



JDN

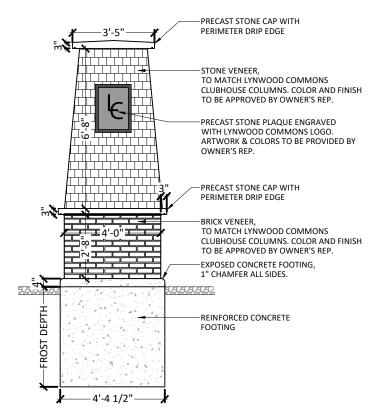


ENTRY MONUMENT AND COLUMN NOTES: FOOTING DESIGN IS FOR BIDDING PURPOSES ONLY ALL HARDWARE AND FASTENERS SHALL BE STAINLESS STEEL
SIGNED STRUCTURAL ENGINEERED FOOTING DRAWINGS
ARE TO BE PROVIDED BY CONTRACTOR FOR
CONSTRUCTION
ALL REBAR TO BE EPOXY COATED
SUBMIT SHOP DRAWINGS FOR ALL MONUMENT AND
COLUMN COMPONENTS FOR REVIEW

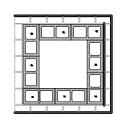

PLAN: ENTRY COLUMN CMU CORE

1 ELEVATION: LYNWOOD COMMONS ENTRY COLUMN
SCALF: N T C SCALE: N.T.S.

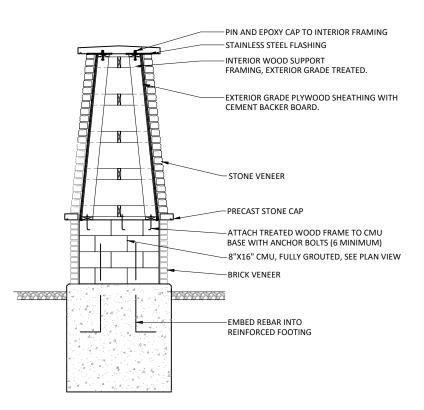

2 SECTION/ELEVATION: LYNWOOD COMMONS ENTRY MONUMENT SCALE: N.T.S.

ENTRY MONUMENT AND COLUMN NOTES: FOOTING DESIGN IS FOR BIDDING PURPOSES ONLY ALL HARDWARE AND FASTENERS SHALL BE STAINLESS STEEL SIGNED STRUCTURAL ENGINEERED FOOTING DRAWINGS
ARE TO BE PROVIDED BY CONTRACTOR FOR
CONSTRUCTION

SUBMIT SHOP DRAWINGS FOR ALL MONUMENT AND COLUMN COMPONENTS FOR REVIEW

OWNER'S REP.

PRECAST STONE PLAQUE ENGRAVED

WITH LYNWOOD COMMONS LOGO.
ARTWORK & COLORS TO BE PROVIDED BY

12'-0"

LETTERING TO BE 8"

SELECTED BY OWNER)

LYNWOOD COMMONS **APARTMENTS**


8" (W) X 3'-3" (HT) CAST STONE SIGN-

PANEL WITH PIN MOUNTED LETTERS (COLORS, FINISH AND FONT TO BE

MINIMUM HEIGHT

ALL REBAR TO BE EPOXY COATED

DEPTH

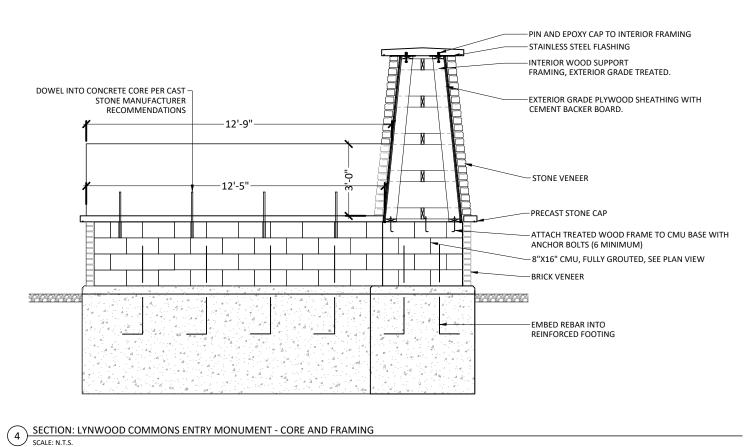

3 SECTION: LYNWOOD COMMONS ENTRY COLUMN SCALE: N.T.S.

JONATHAN D. NELSEN

12224 NICOLLET AVENUE BURNSVILLE, MINNESOTA 55337 Phone: (952) 890-0509 Email: Burnsville@bolton-menk.com www.bolton-menk.com



DESIGNED	NO.	REVISION	DATE	ī
JDN				
DRAWN				ŕ
JDN				
CHECKED				ř
JDN/JCO	_			
CLIENT PROJ. NO.				

CITY OF RICHFIELD. MINNESOTA LYNDALE AVENUE RECONSTRUCTION L2.05 LANDSCAPE DETAILS

PRECAST STONE CAP WITH

PRECAST STONE CAP WITH

EXPOSED CONCRETE FOOTING,

1" CHAMFER ALL SIDES.

-REINFORCED CONCRETE


TO MATCH LYNWOOD COMMONS CLUBHOUSE COLUMNS. COLOR AND FINISH TO BE APPROVED BY OWNER'S REP.

PERIMETER DRIP EDGE

TO MATCH LYNWOOD COMMONS CLUBHOUSE COLUMNS. COLOR AND FINISH TO BE APPROVED BY OWNER'S REP.

PERIMETER DRIP EDGE


STONE VENEER,

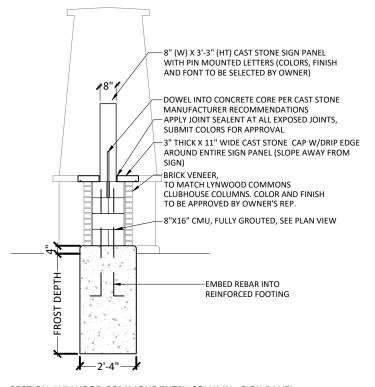


BRICK VENEER, SIZE AND COLOR AS SPECIFIED -8"X16" CMU BLOCK BASE, FULLY GROUTED, TYP. PLAN: ENTRY MONUMENT CMU CORE -#4 REBAR EMBED 24" INTO CONCRETE BASE

1 SECTION: LYNWOOD COMMONS ENTRY COLUMN - SIGN PANEL SCALE: N.T.S.

PLAN: LYNWOOD COMMONS ENTRY COLUMN SCALE: N.T.S.

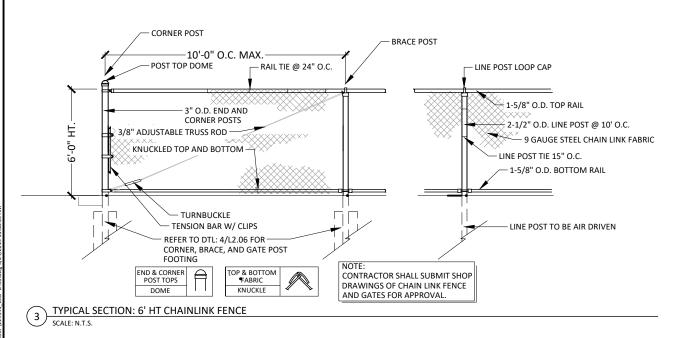

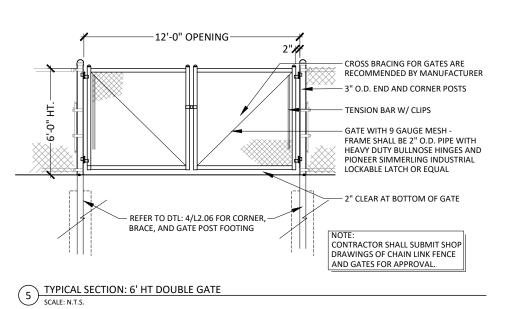

TYPICAL SECTION: CORNER, BRACE, AND GATE POSTS AND FOOTINGS
SCALE: N.T.S. SCALE: N.T.S.

THE RESTRICTION OF THE PROPERTY AND A STATE OF THE PROPERT

BOLTON & MENK

12224 NICOLLET AVENUE BURNSVILLE, MINNESOTA 55337 Phone: (952) 890-0509 Email: Burnsville@bolton-menk.com www.bolton-menk.com



	NO.	REVISION	DATE				
IDN				CITY OF RICHFIELD, MINNESOTA			
1041				LVAIDALE AVENUE DECONSTRUCTION			
IDN				LYNDALE AVENUE RECONSTRUCT			
N/JCO				LANDSCAPE DETAILS			
J. NO.				E/ (1105C) (1 E DE 17 (1E5			
J. NO.							

L2.06

-FENCE POST

FINISH GRADE

CONDITION VARIES,

12" DIA. CONCRETE FOOTING FOR CORNER, BRACE, AND GATE POSTS

ONLY, USE OF FULL

DEPTH SONO-TUBE


FENCE POSTS TO BE

REQUIRED. ALL OTHER MID


AIR DRIVEN.

SURFACE


SEE PLAN

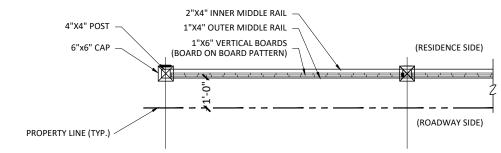

2 TYPICAL PLAN: WOODEN FENCE SCALE: N.T.S.

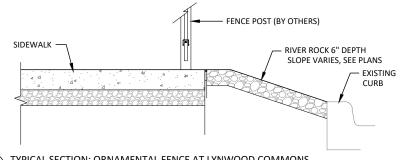

4 TYPICAL SECTION: ORNAMENTAL FENCE AT LYNWOOD COMMONS SCALE: N.T.S.

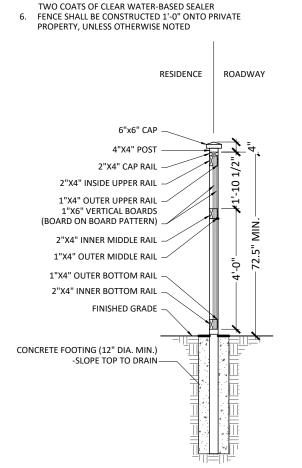

NOTES:

1. ALL FINAL FENCING DETAILS, DIMENSIONS AND COORDINATED

THE ADJACENT HOME OWNER AND CITY

REPRESENTATIVE


CITY REPRESENTATIVE


STAKING SHALL BE VERIFIED AND COORDINATED WITH

CONTRACTOR SHALL PROVIDE SHOP DRAWINGS FOR THE TYPICAL FENCE AND GATE DETAILS, INCLUDING HARDWARE TYPES AND SIZES ALL LUMBER SHALL BE GRADE 'A' CEDAR LUMBER

FENCE SHALL BE STAINED. COLOR TO BE APPROVED BY

CEDAR FENCE SHALL BE SEALED WITH A MINIMUM OF

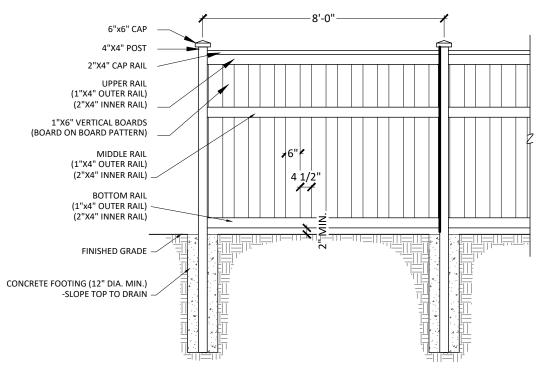

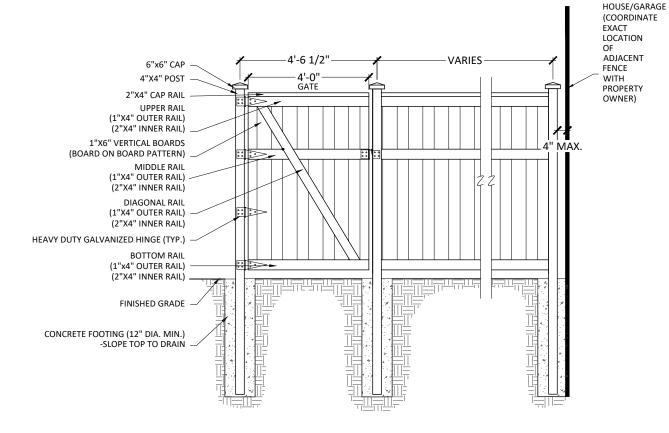

TYPICAL SECTION: WOODEN FENCE POST SCALE: N.T.S.

3 TYPICAL SECTION: WOODEN FENCE SCALE: N.T.S.

TYPICAL SECTION: WOODEN GATE SCALE: N.T.S.



12224 NICOLLET AVENUE BURNSVILLE, MINNESOTA 55337 Phone: (952) 890-0509 Email: Burnsville@bolton-menk.com www.bolton-menk.com



	NO.	REVISION	DATE	CITY OF BUOUFIELD ANNUESCES			
DN				CITY OF RICHFIELD, MINNESOTA			
D. 1.				LVAIDALE AVENUE DECONCEDUCTION			
DN				LYNDALE AVENUE RECONSTRUCTION			
	-						
N/JCO				LANDSCAPE DETAILS			
		LANDSCAFE DE	LANDSCALE DETAILS				
J. NO.	-						

L2.07